



50+80


STA 50+80.00 LT (AB #1)
 END GRUBBING MATERIAL
 BEGIN CONCRETE NOT REMOVED AT TOE

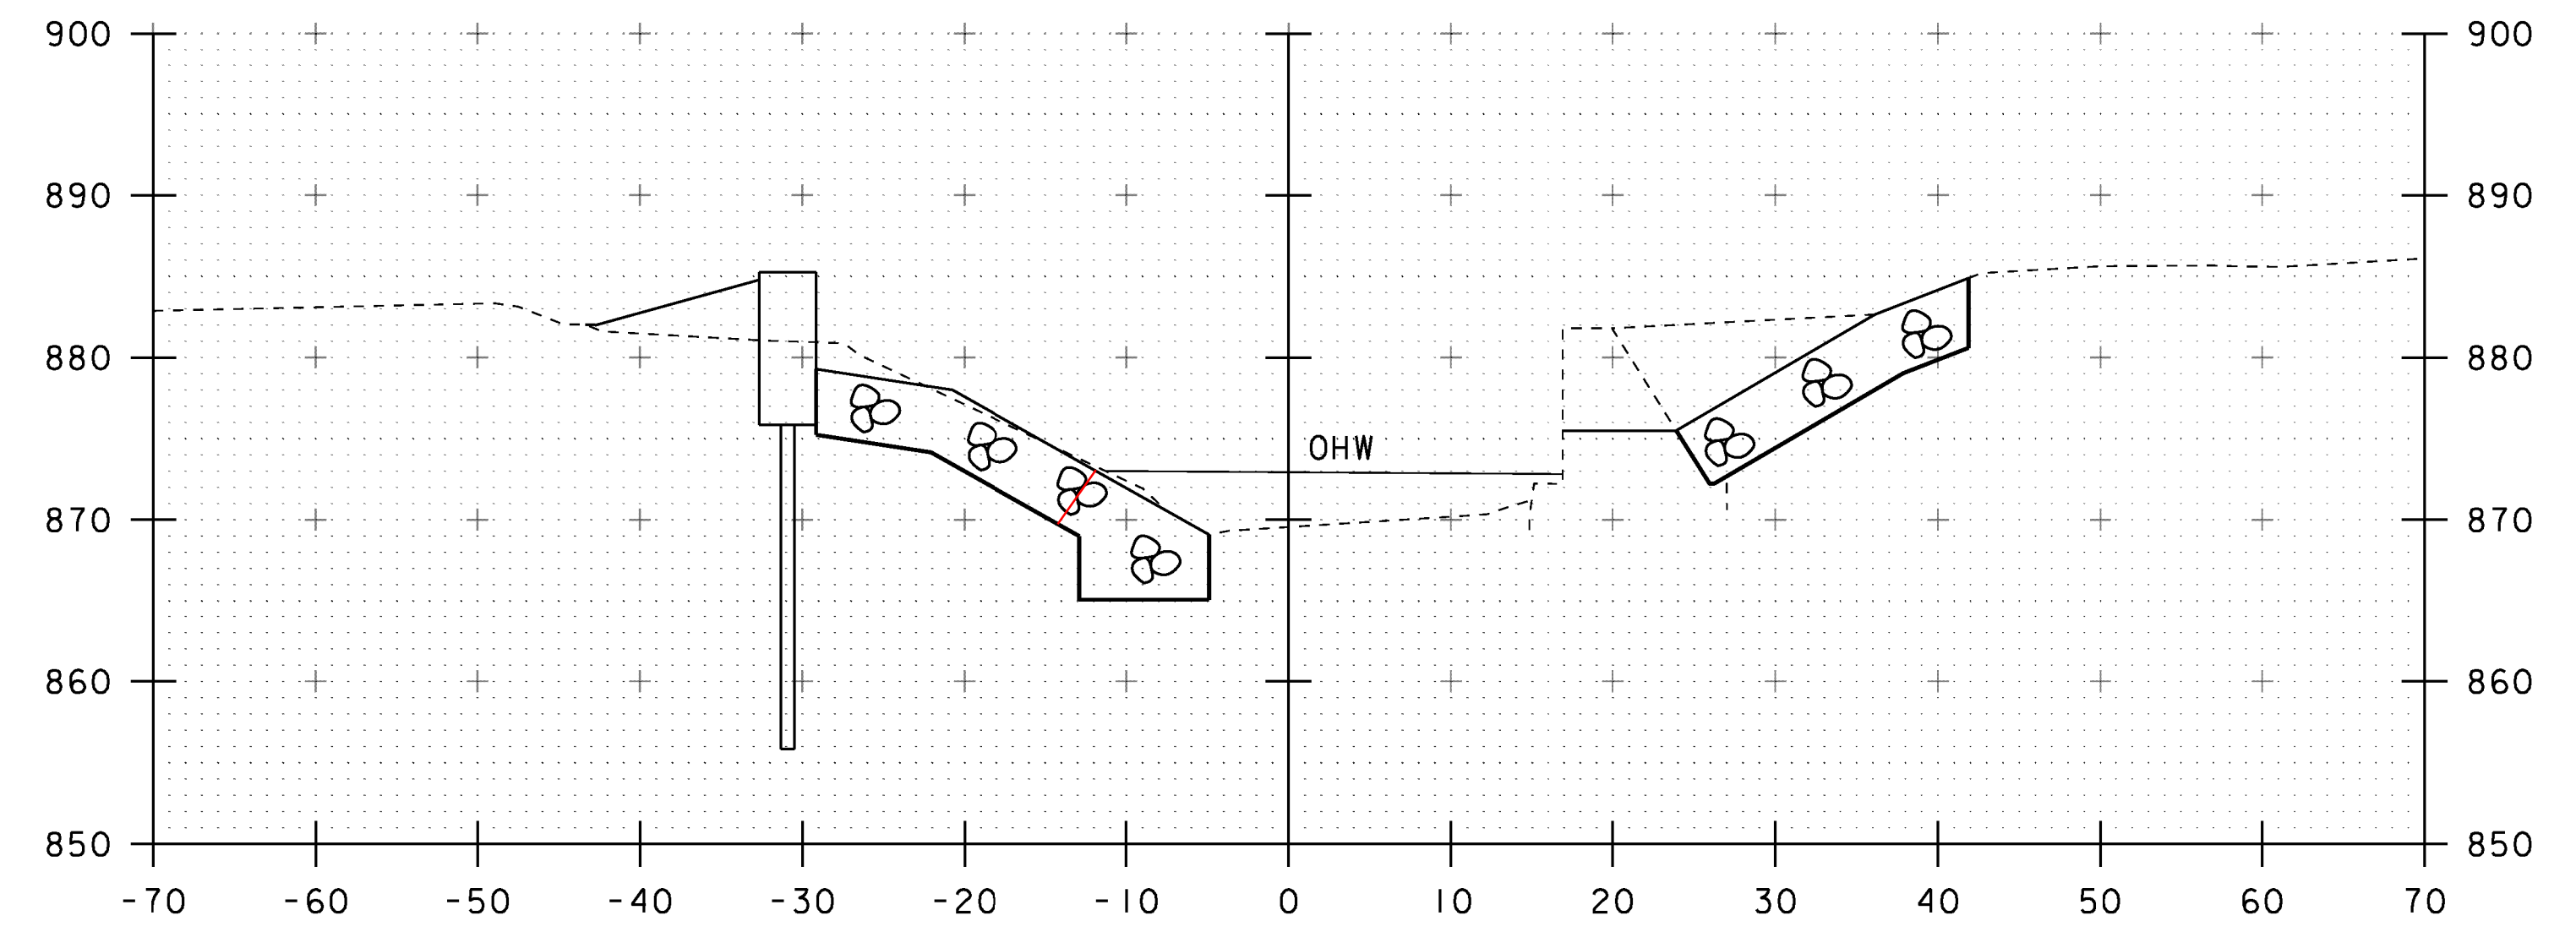

51+00

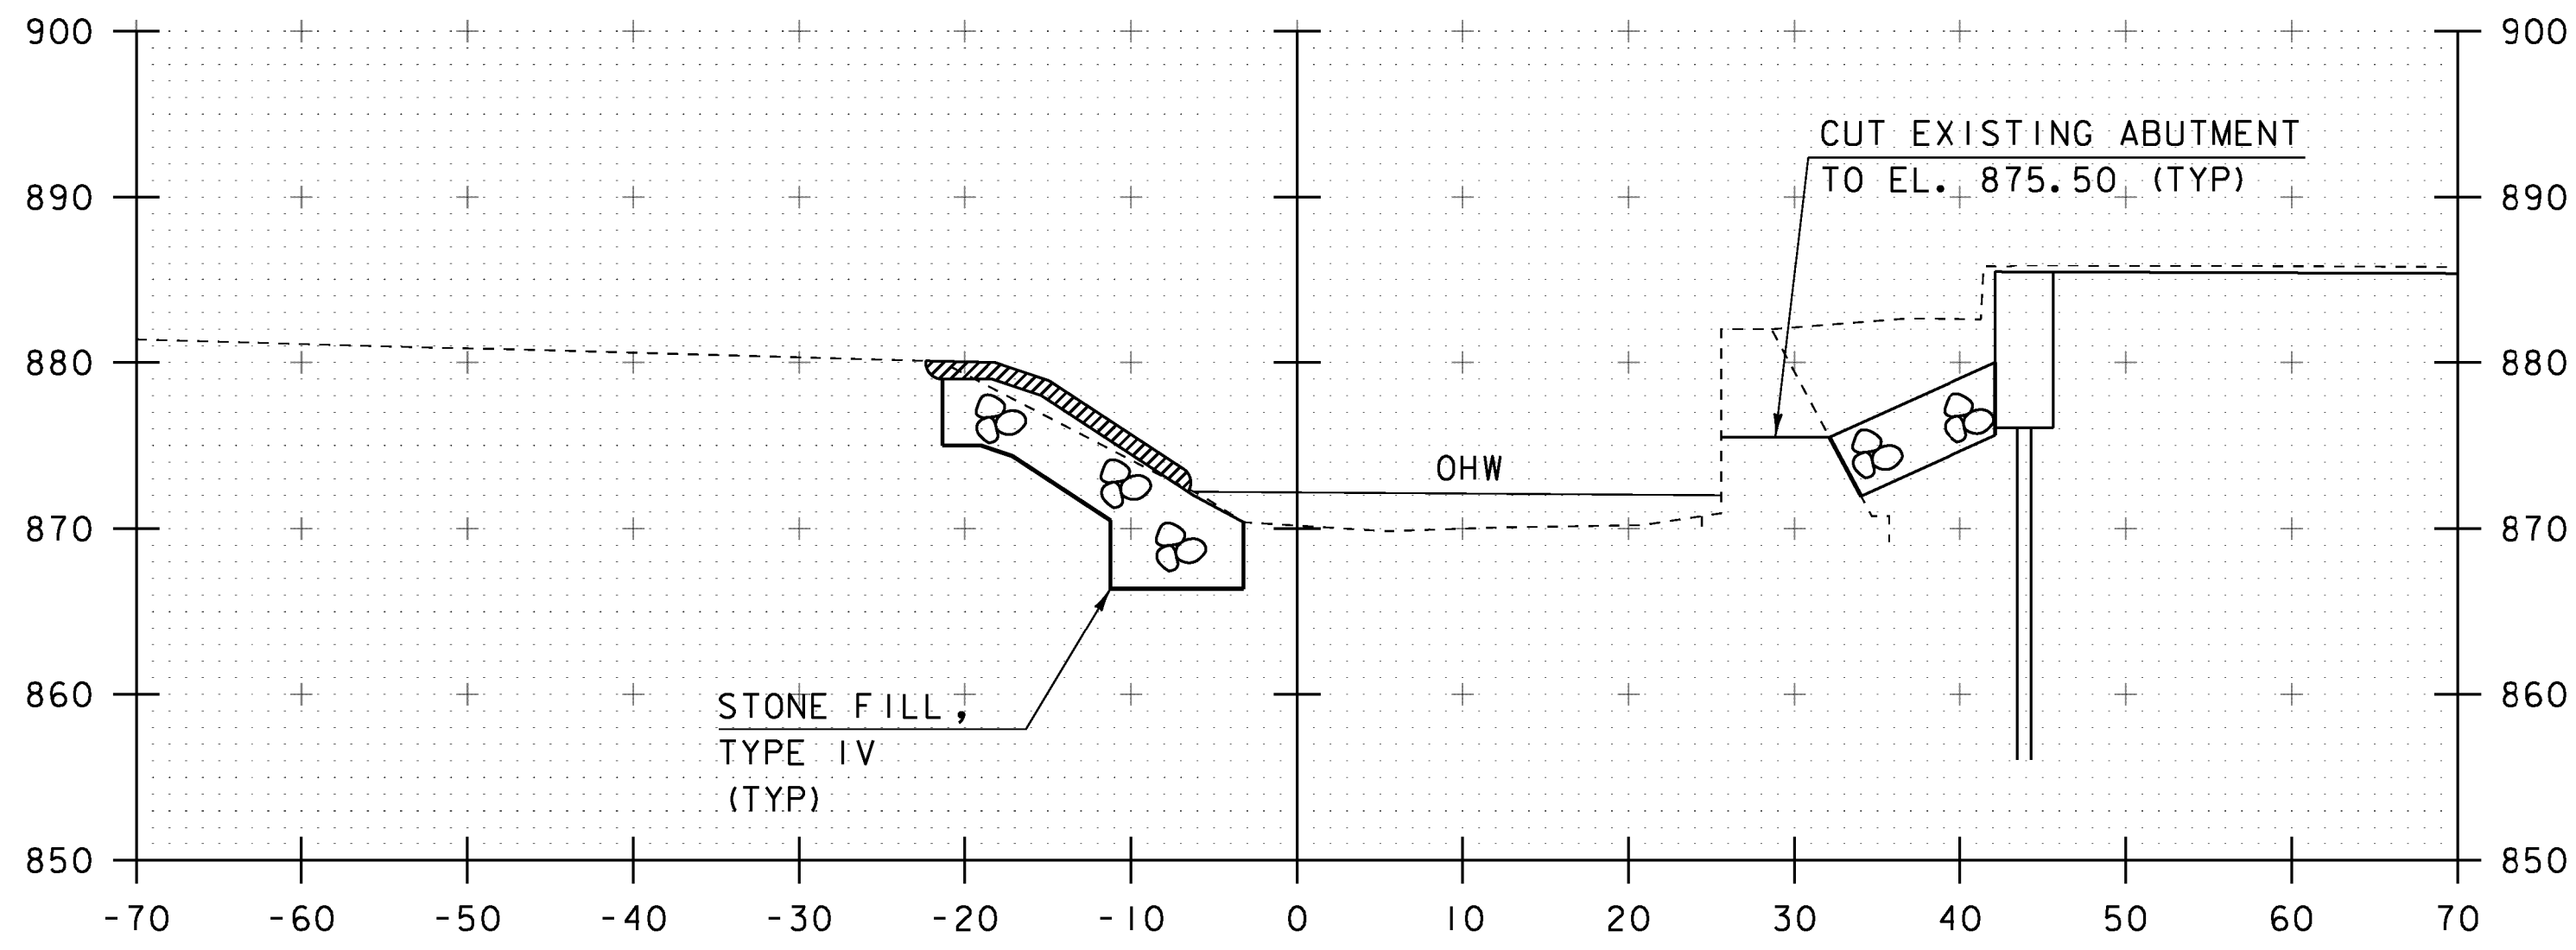

50+70

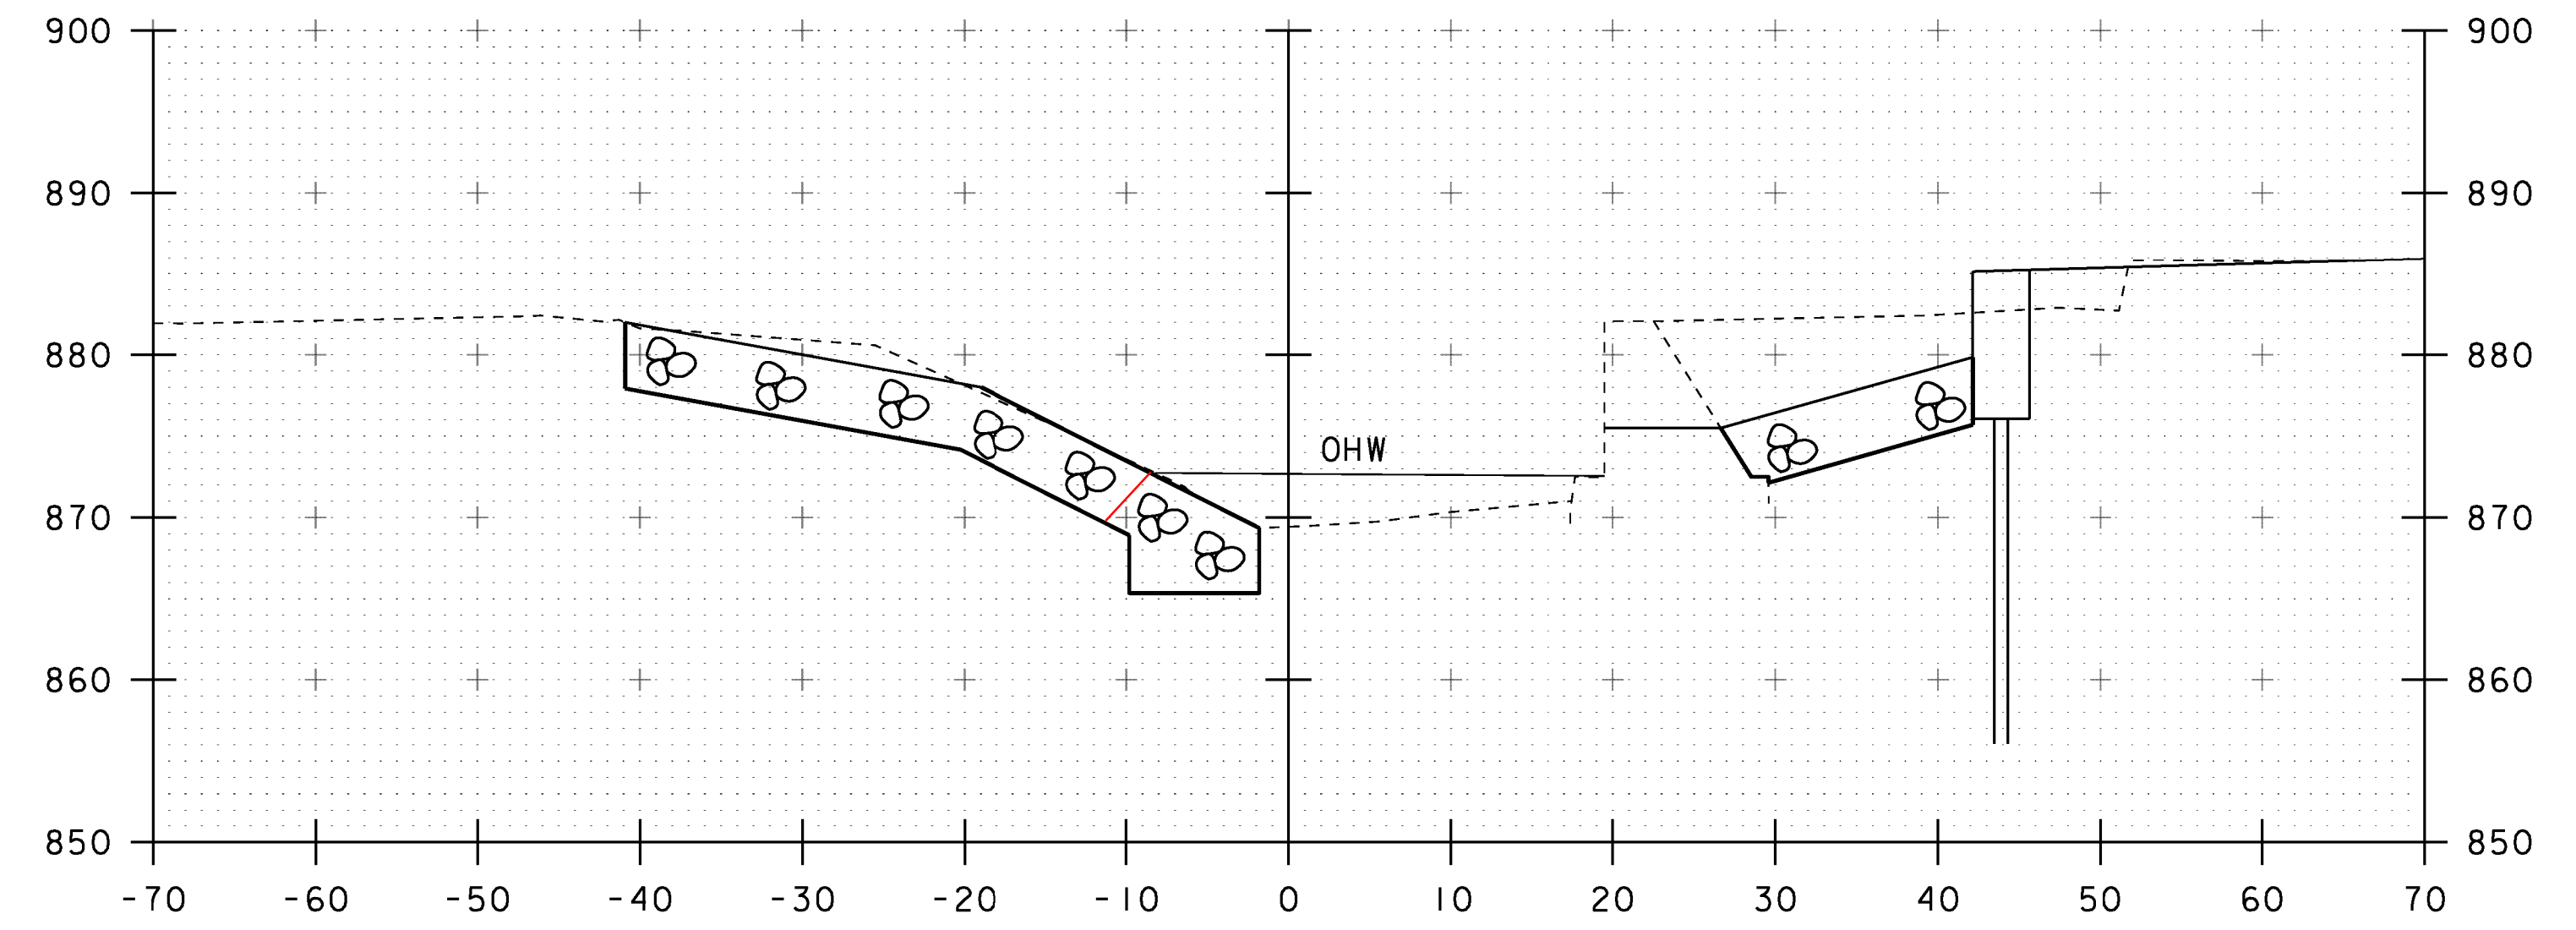

50+90

STA. 50+70 TO STA. 51+00

PROJECT NAME:	BARNARD	PLOT DATE:	29-AUG-2013
PROJECT NUMBER:	ER BRF 024I(39)	DRAWN BY:	J. GRIGAS
FILE NAME:	sl0c410xsl.dgn	DESIGNED BY:	W. LAMMER
PROJECT LEADER:	K. HIGGINS	CHECKED BY:	J. SALVATORI
CHANNEL SECTIONS		SHEET	37 OF 39