



51+20

STA 51+20.00 RT (AB #2)
BEGIN GRUBBING MATERIAL

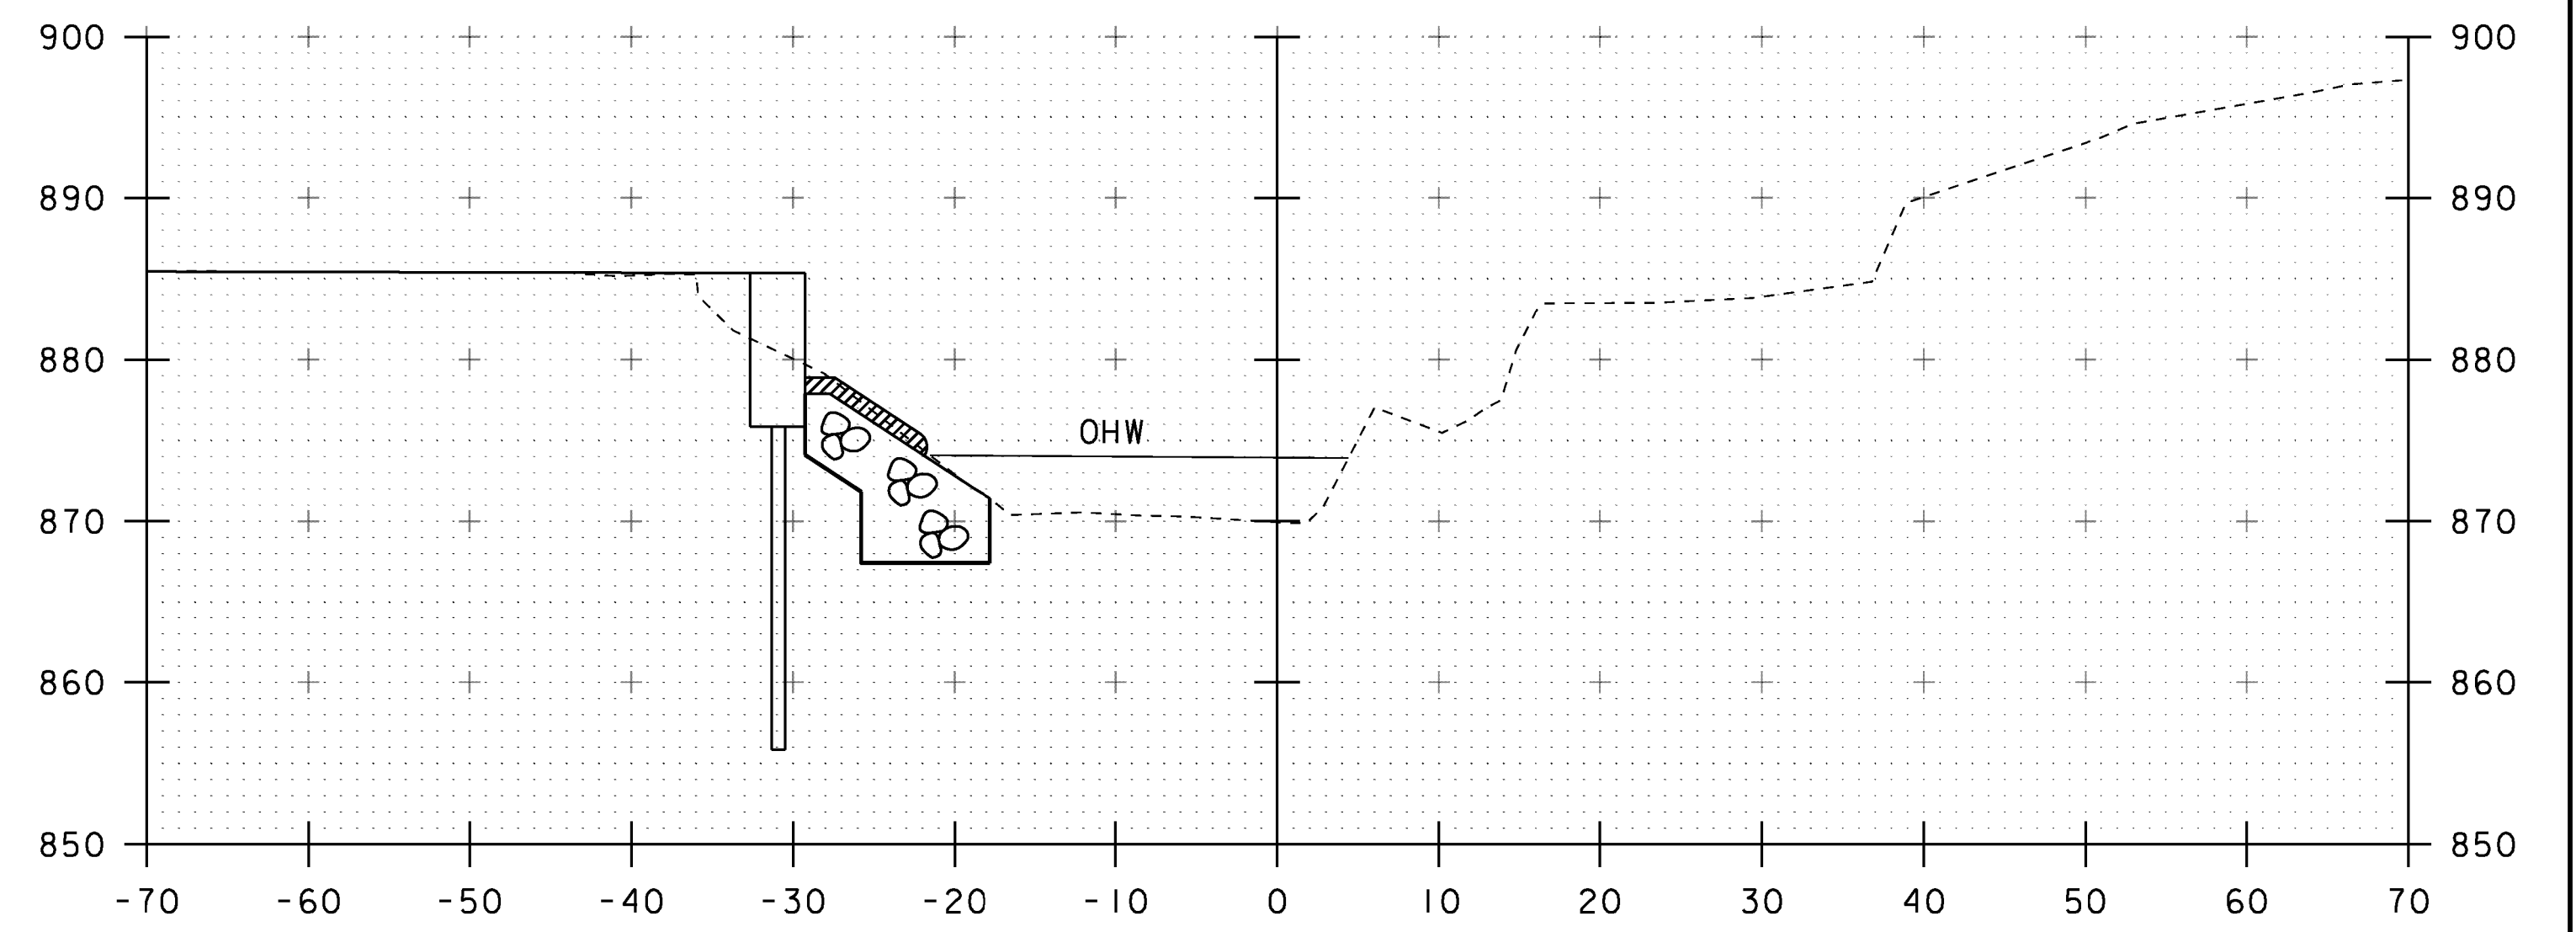


51+40

STA 51+36.00 LT (AB #1)
BEGIN GRUBBING MATERIAL
END CONCRETE NOT REMOVED AT TOE

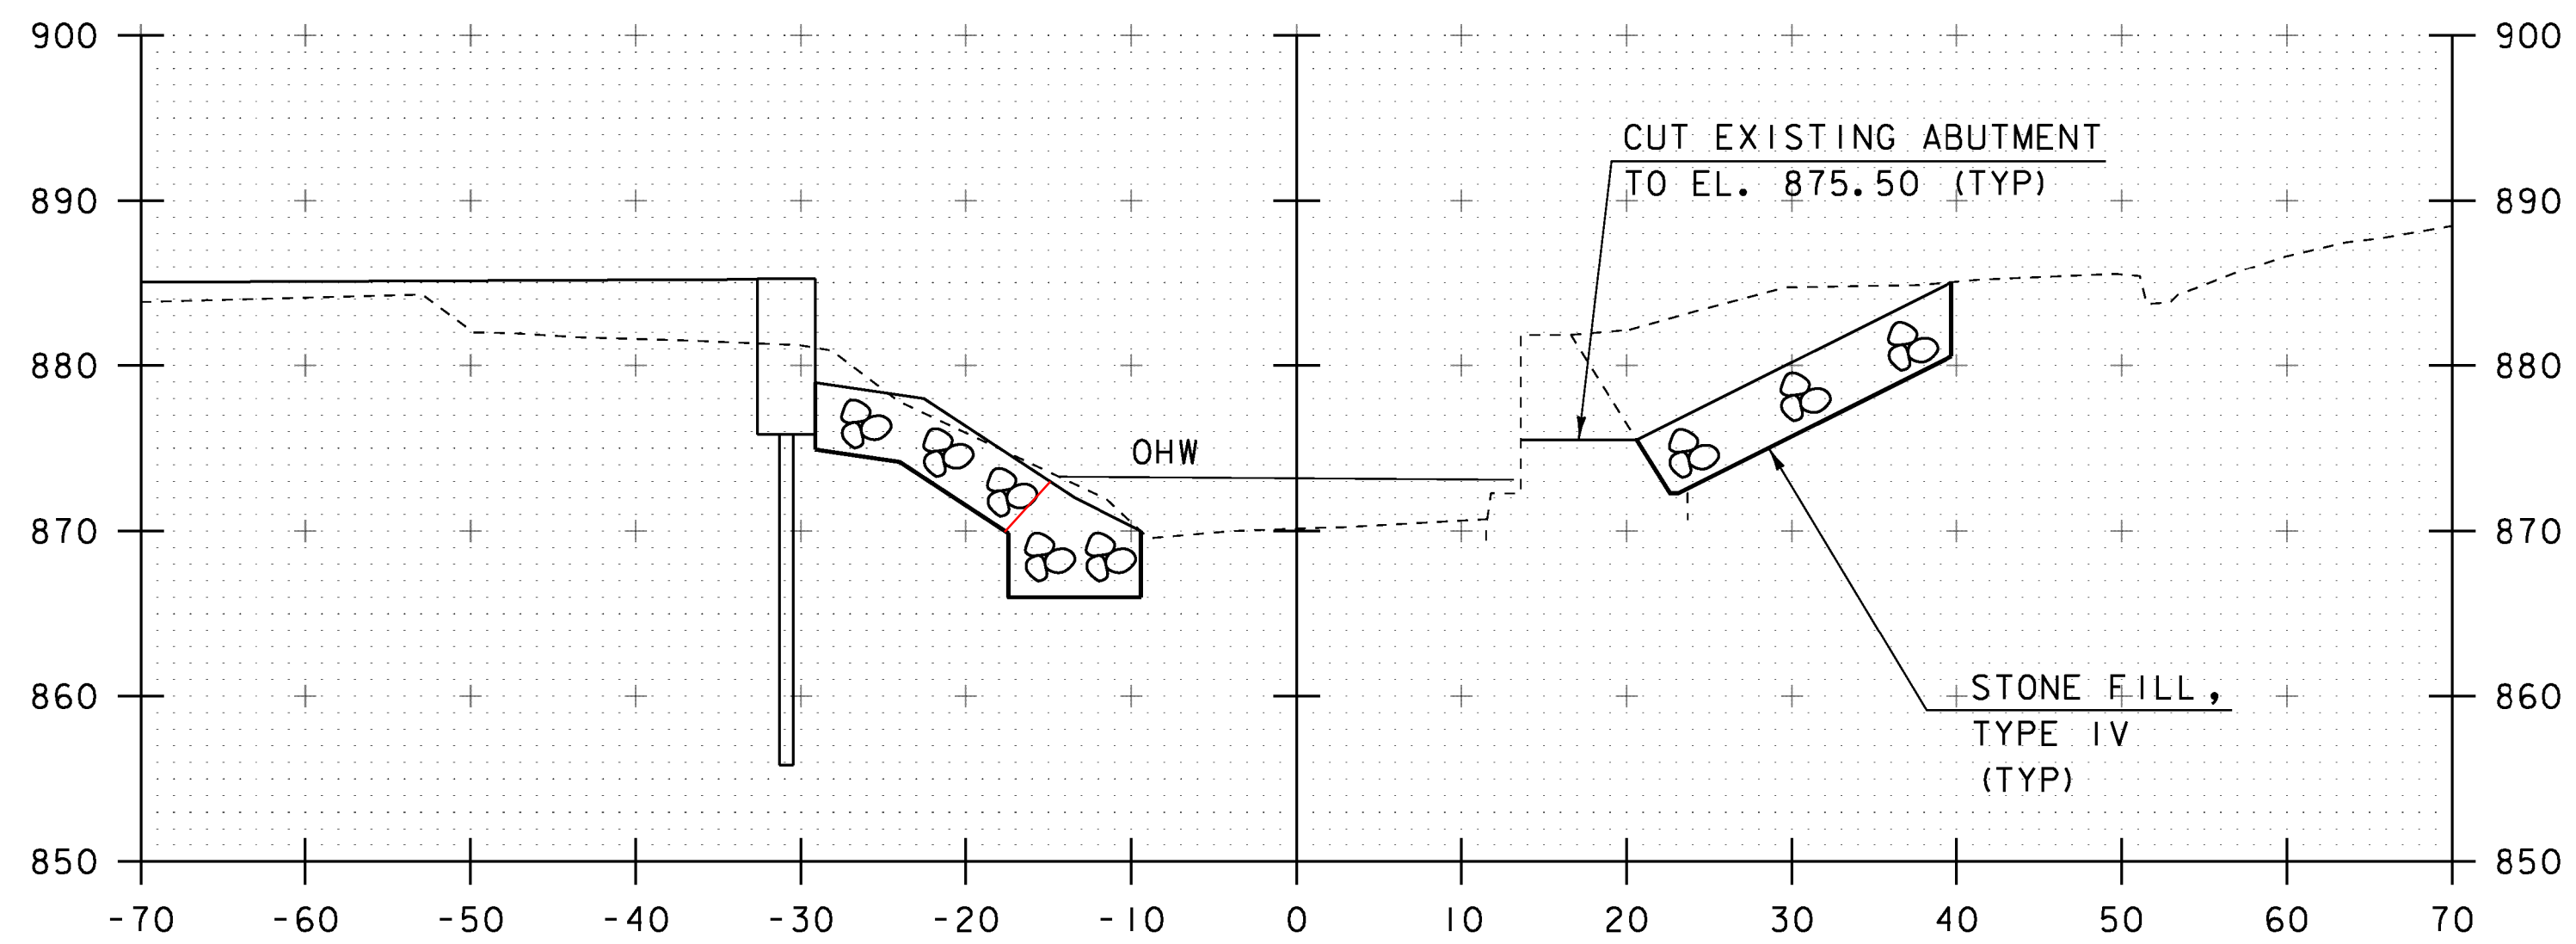

51+10

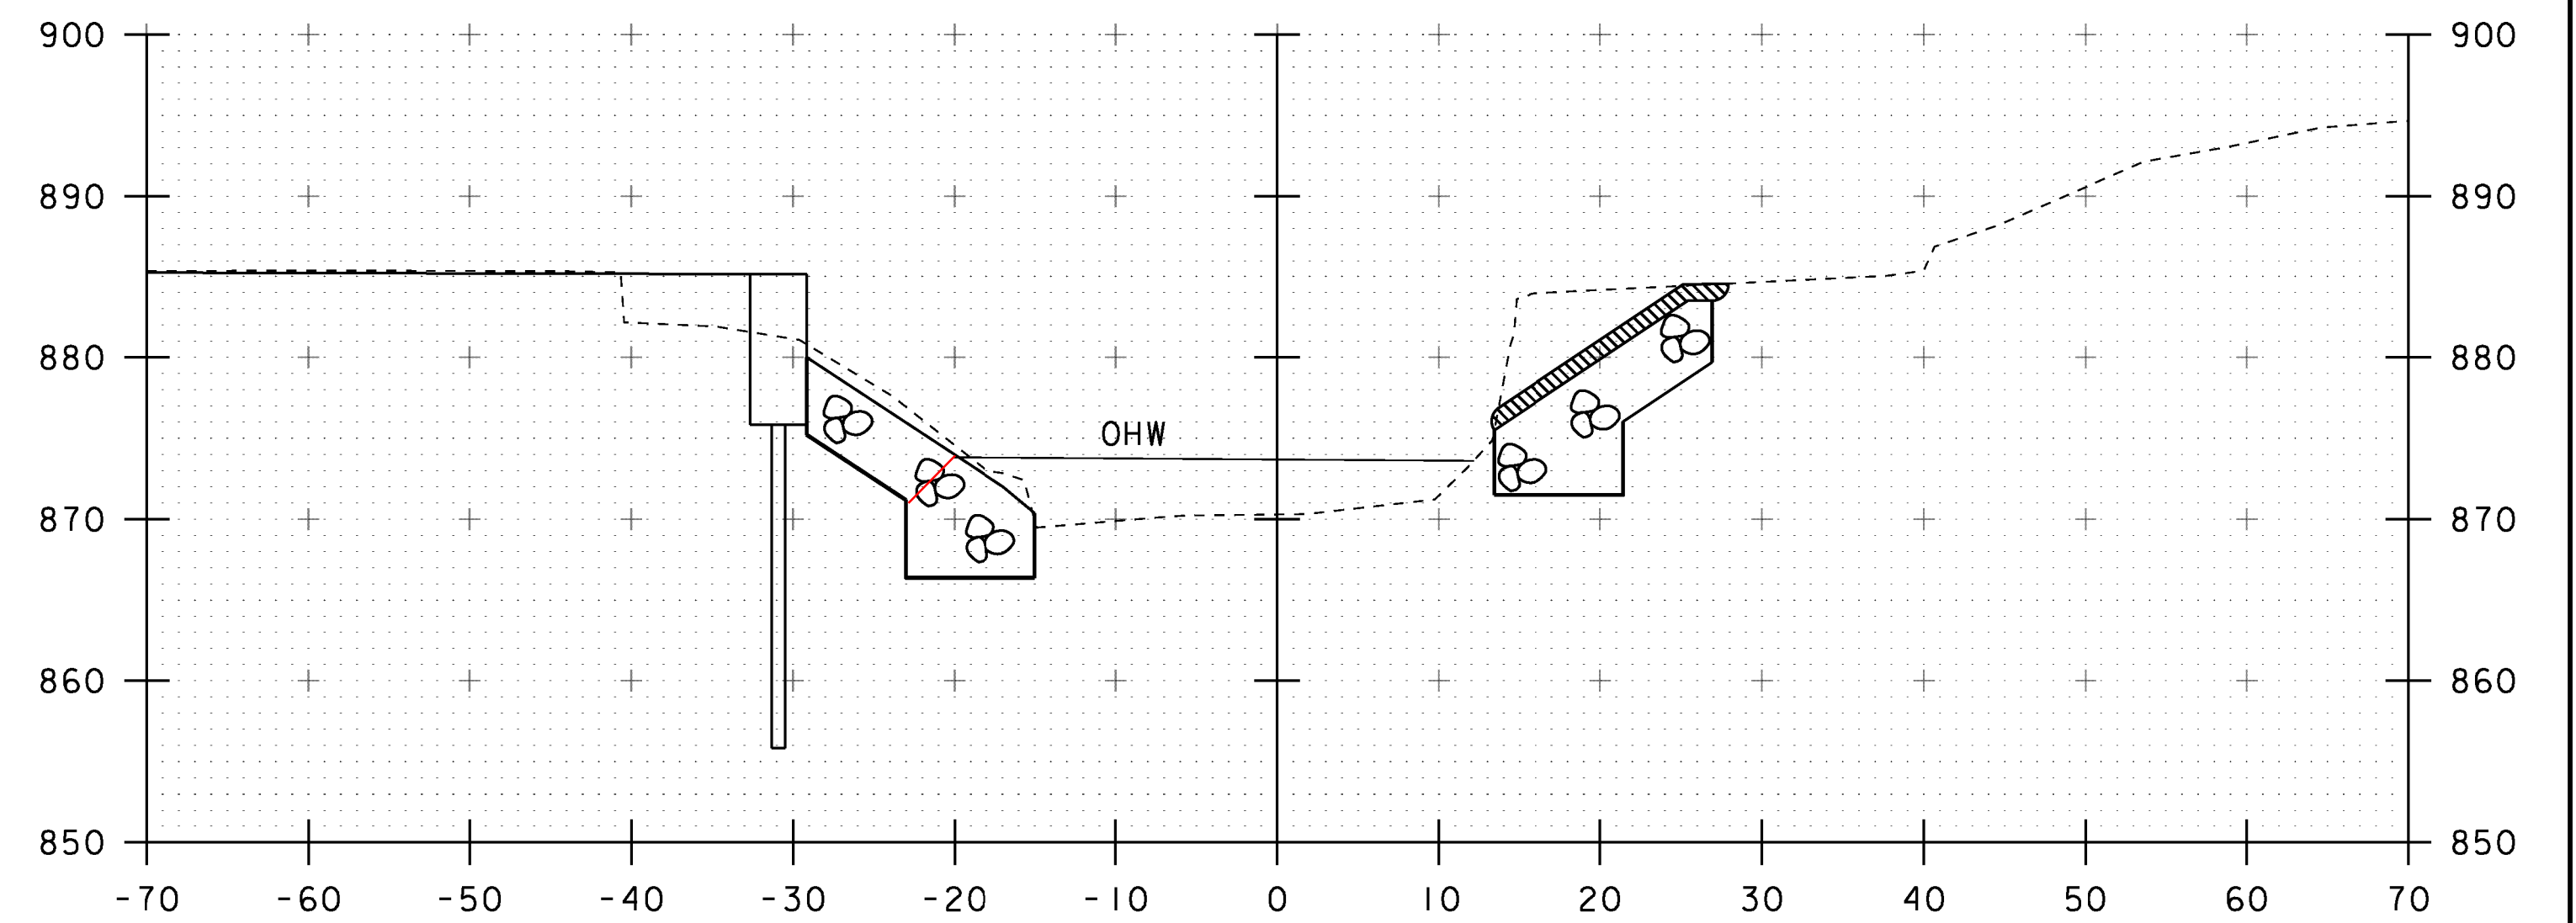

51+30

STA 51+30.00 RT (AB #2)
END UNCLASSIFIED CHANNEL EXCAVATION
GEOTEXTILE UNDER STONE FILL
STONEFILL, TYPE IV
GRUBBING MATERIAL

PROJECT NAME: BARNARD
PROJECT NUMBER: ER BRF 024I(39)

FILE NAME: sl0c410xsl.dgn
PROJECT LEADER: K. HIGGINS
DESIGNED BY: W. LAMMER
CHANNEL SECTIONS

PLOT DATE: 29-AUG-2013
DRAWN BY: J. GRIGAS
CHECKED BY: J. SALVATORI
SHEET 38 OF 39

STA. 51+10 TO STA. 51+40