



51+75

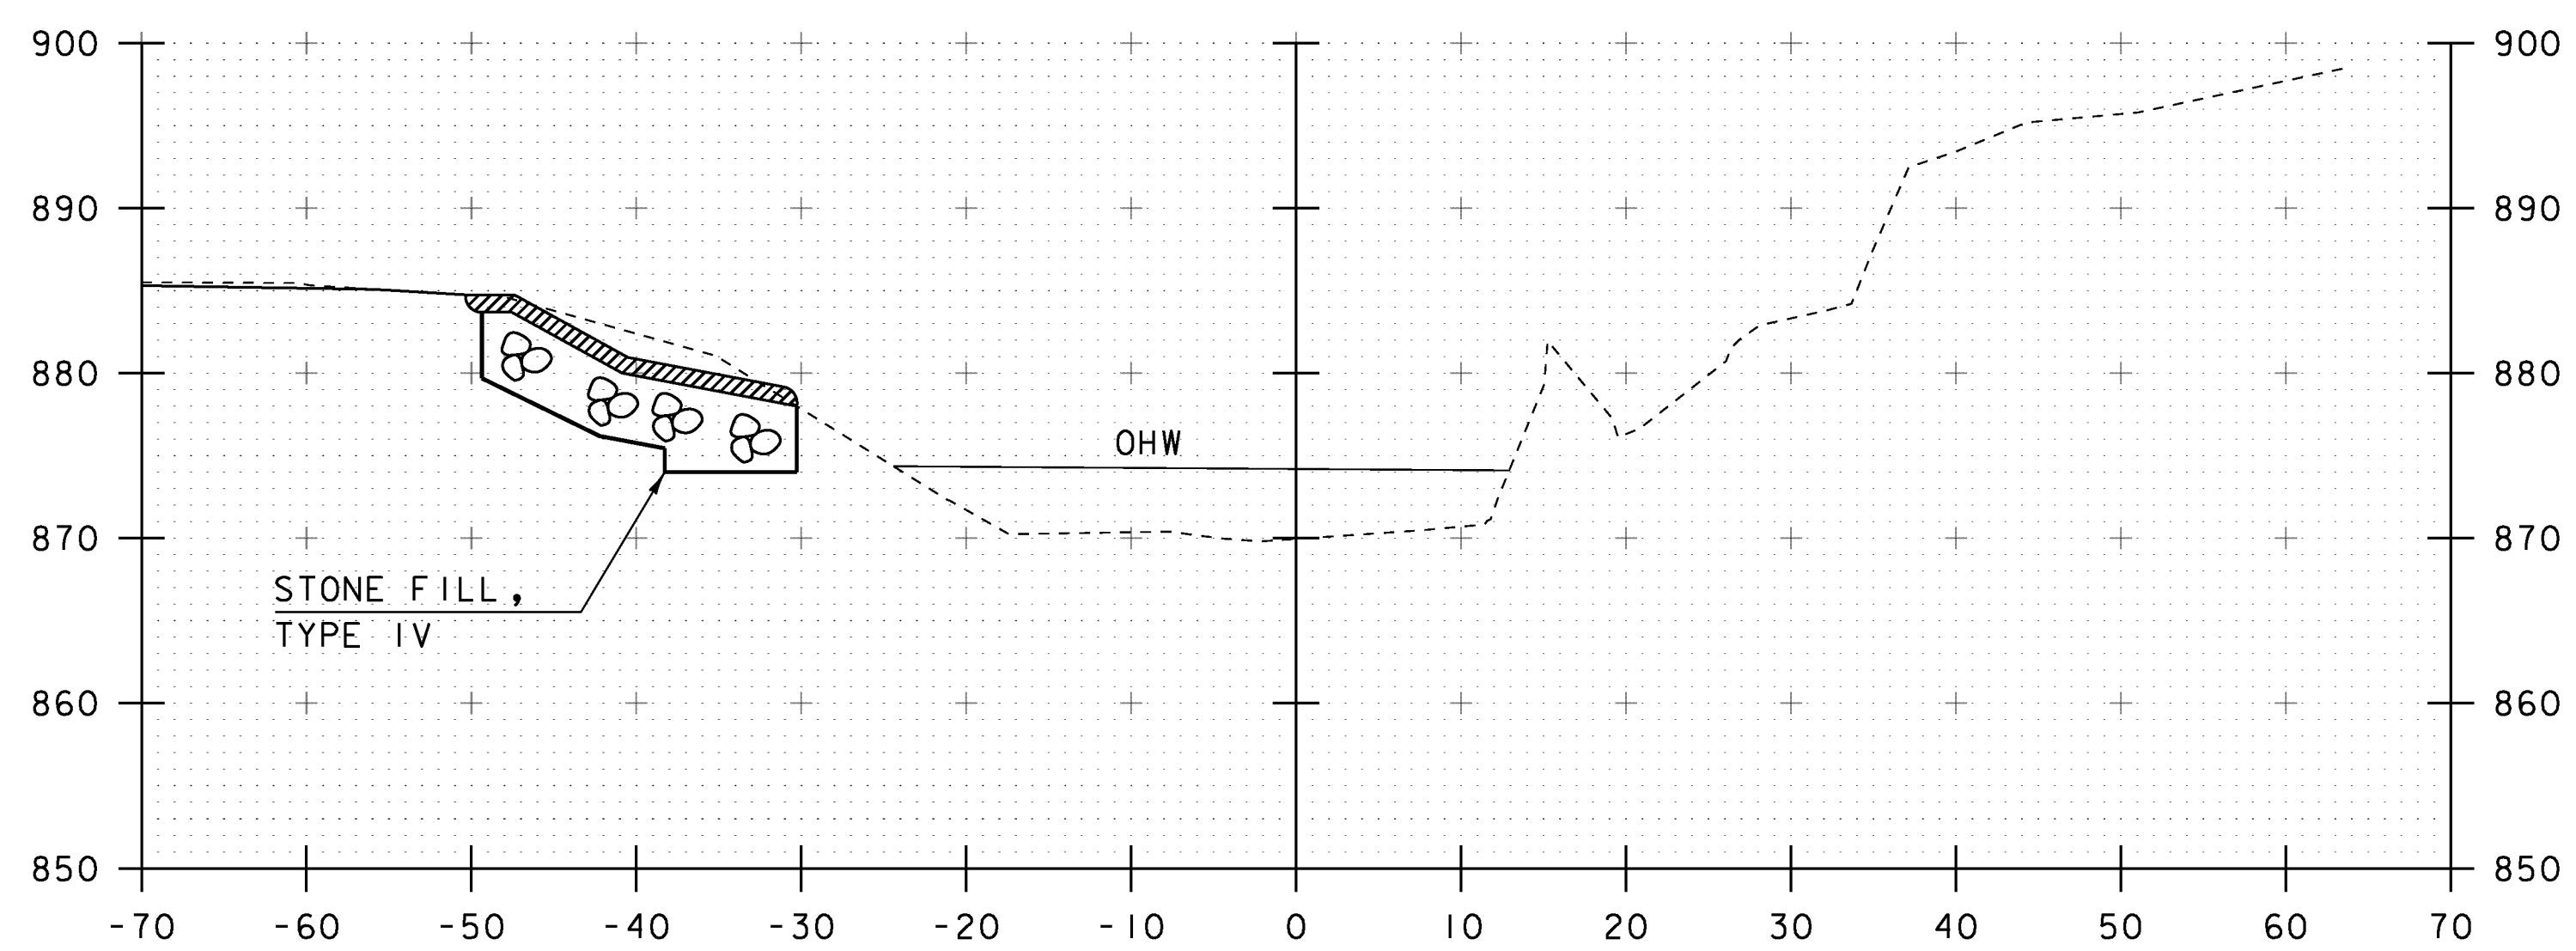

51+50

STA 51+50.00 LT (AB #1)
 END UNCLASSIFIED CHANNEL EXCAVATION
 GEOTEXTILE UNDER STONE FILL
 STONE FILL, TYPE IV
 GRUBBING MATERIAL

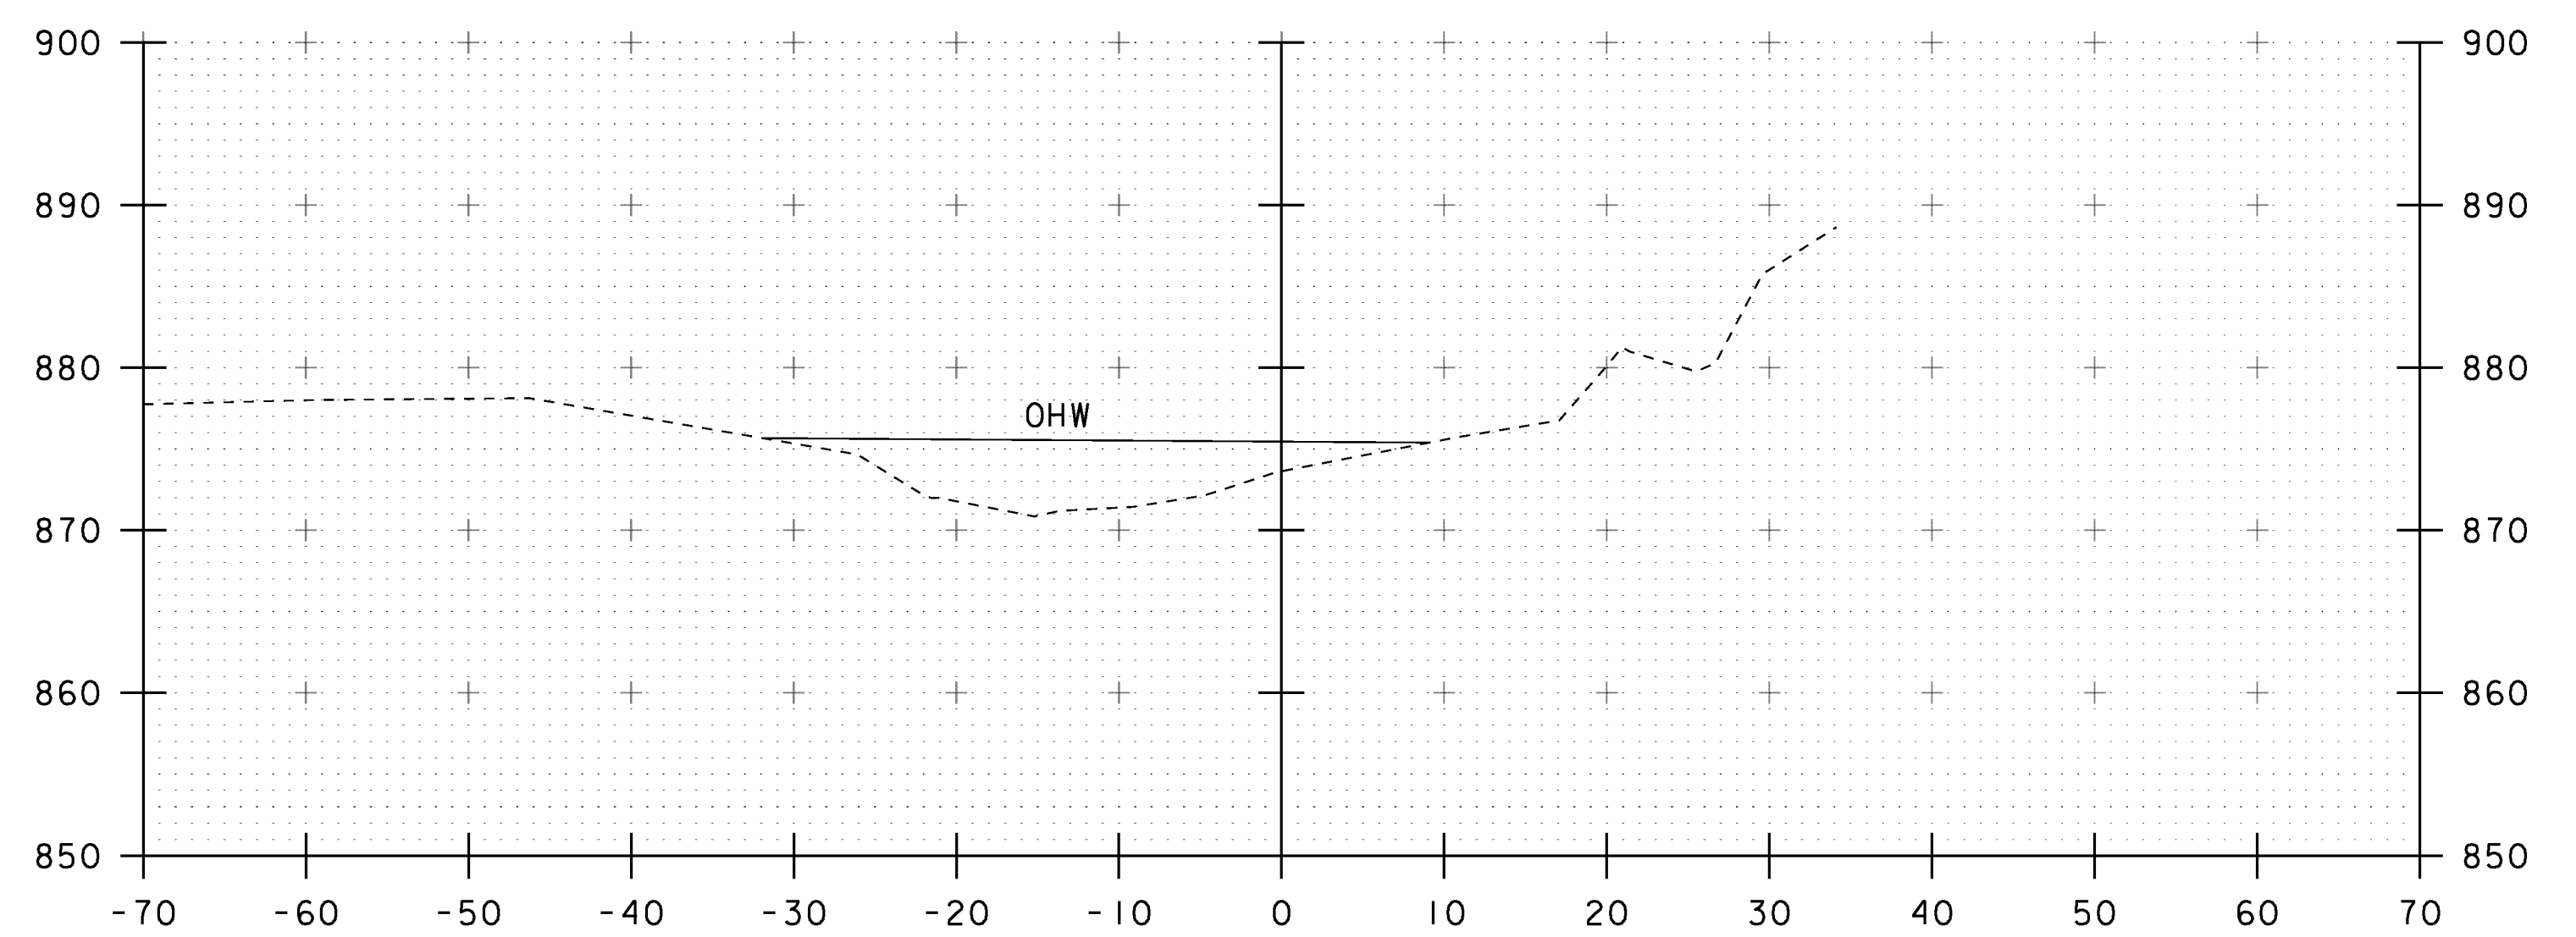

52+00

STA. 51+50 TO STA. 52+00

PROJECT NAME: BARNARD	
PROJECT NUMBER: ER BRF 0241(39)	
FILE NAME: sl0c410xsl.dgn	PLOT DATE: 29-AUG-2013
PROJECT LEADER: K. HIGGINS	DRAWN BY: J. GRIGAS
DESIGNED BY: W. LAMMER	CHECKED BY: J. SALVATORI
CHANNEL SECTIONS	SHEET 39 OF 39