


1 PRECAST CONCRETE ABUTMENT & WING WALL LAYOUT  
 1/8" = 1'-0"

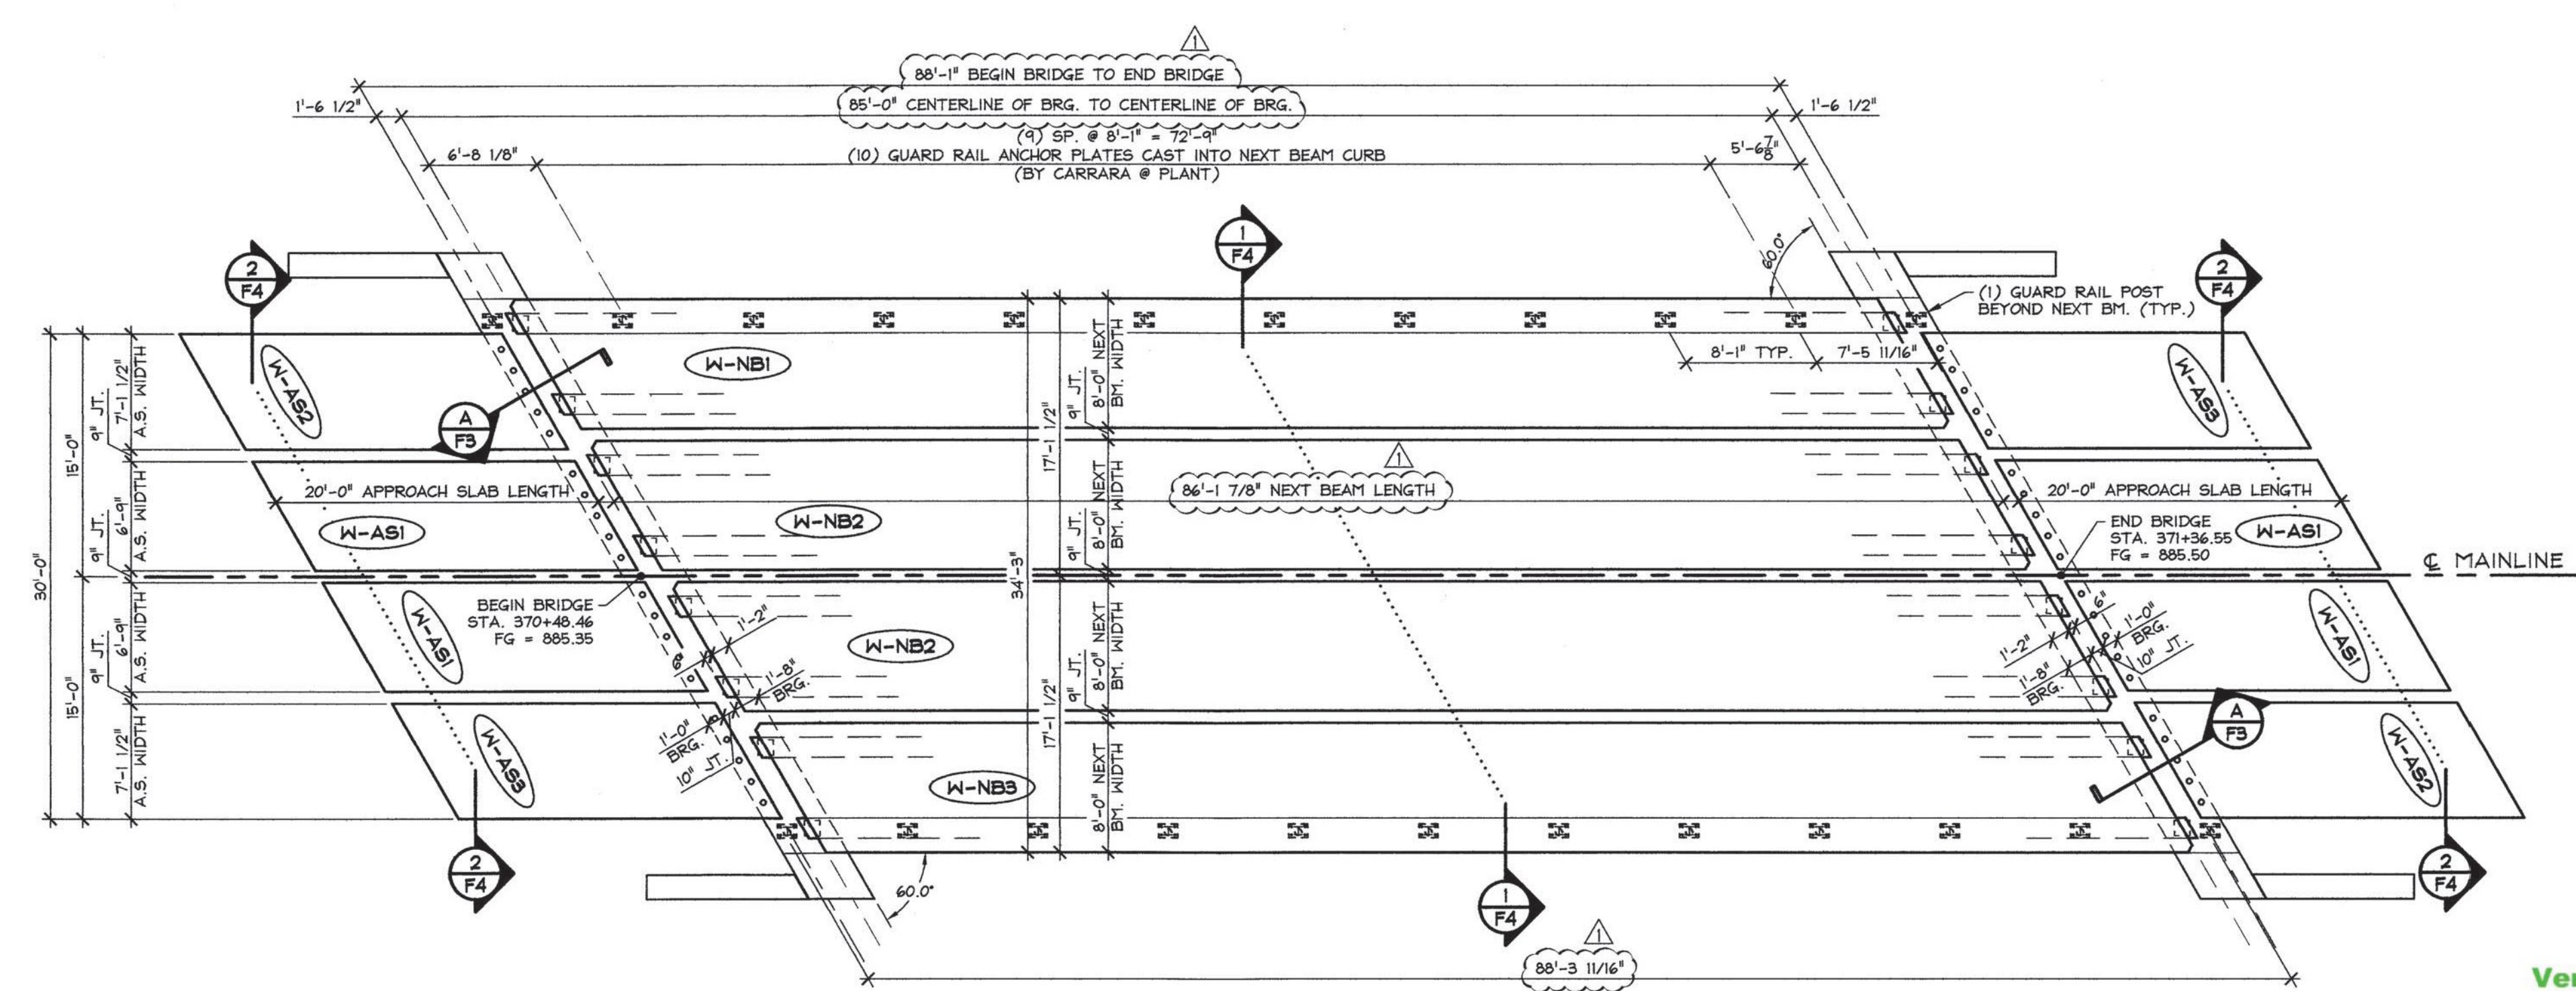

2 PRESTRESSED APPROACH SLAB & NEXT BEAM LAYOUT  
 1/8" = 1'-0"

1-16-14 REVISED AS NOTED

APPROVAL STAMP:

Vermont Agency of Transportation  
**RECEIVED**

CK'D BY JDG/JW OK'D BY WDL

January 27, 2014

RESUBMIT No Approved  
 BY KMH DATE 02/10/2014

J.P. CARRARA & SONS INC. MILLER CONSTRUCTION, INC.  
 Precast & Prestress Manufacturer CONTRACTOR  
 2464 ODE STR., MIDDLEBURY, VERMONT 05753 Phone: (802)388-6361 Fax: (802)388-9010 BARNARD, VERMONT

STATE OF VERMONT AGENCY OF TRANSPORTATION COUNTY OF WINDSOR DATE: DEC. 18, 2013  
 SCALE: NOTED

TOWN OF BARNARD VT ROUTE 12, MAJOR COLLECTOR DFTM: B.L.  
 BRIDGE NO.: 25 PROJECT NO.: ER BRF 0241(39) JOB NO: 23413-013

SUPERSTRUCTURE PLANS DWG. NO: F1