



1 ABUTMENT #1 & #2 ELEVATION
 F2 3/8" = 1'-0"

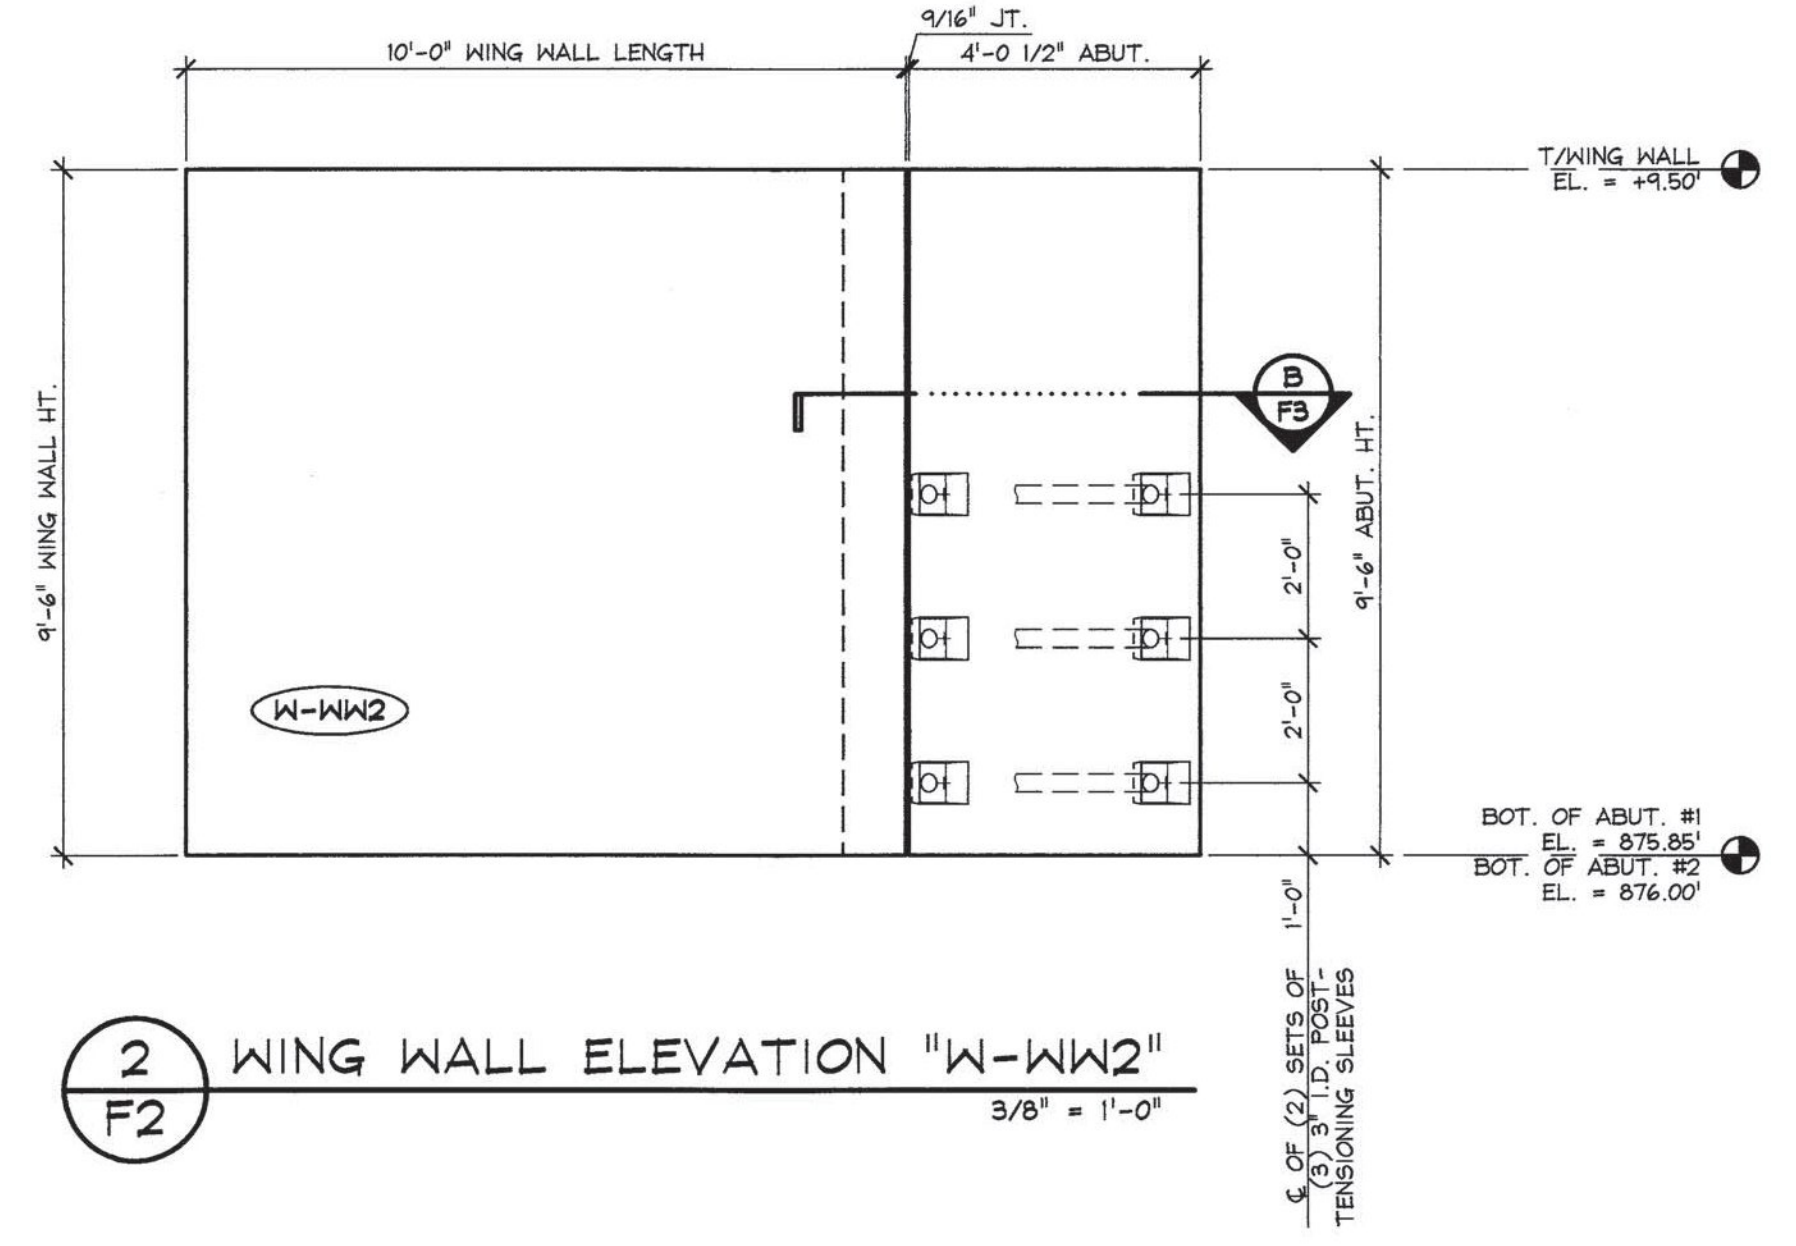

2 WING WALL ELEVATION "W-WW2"
 F2 3/8" = 1'-0"

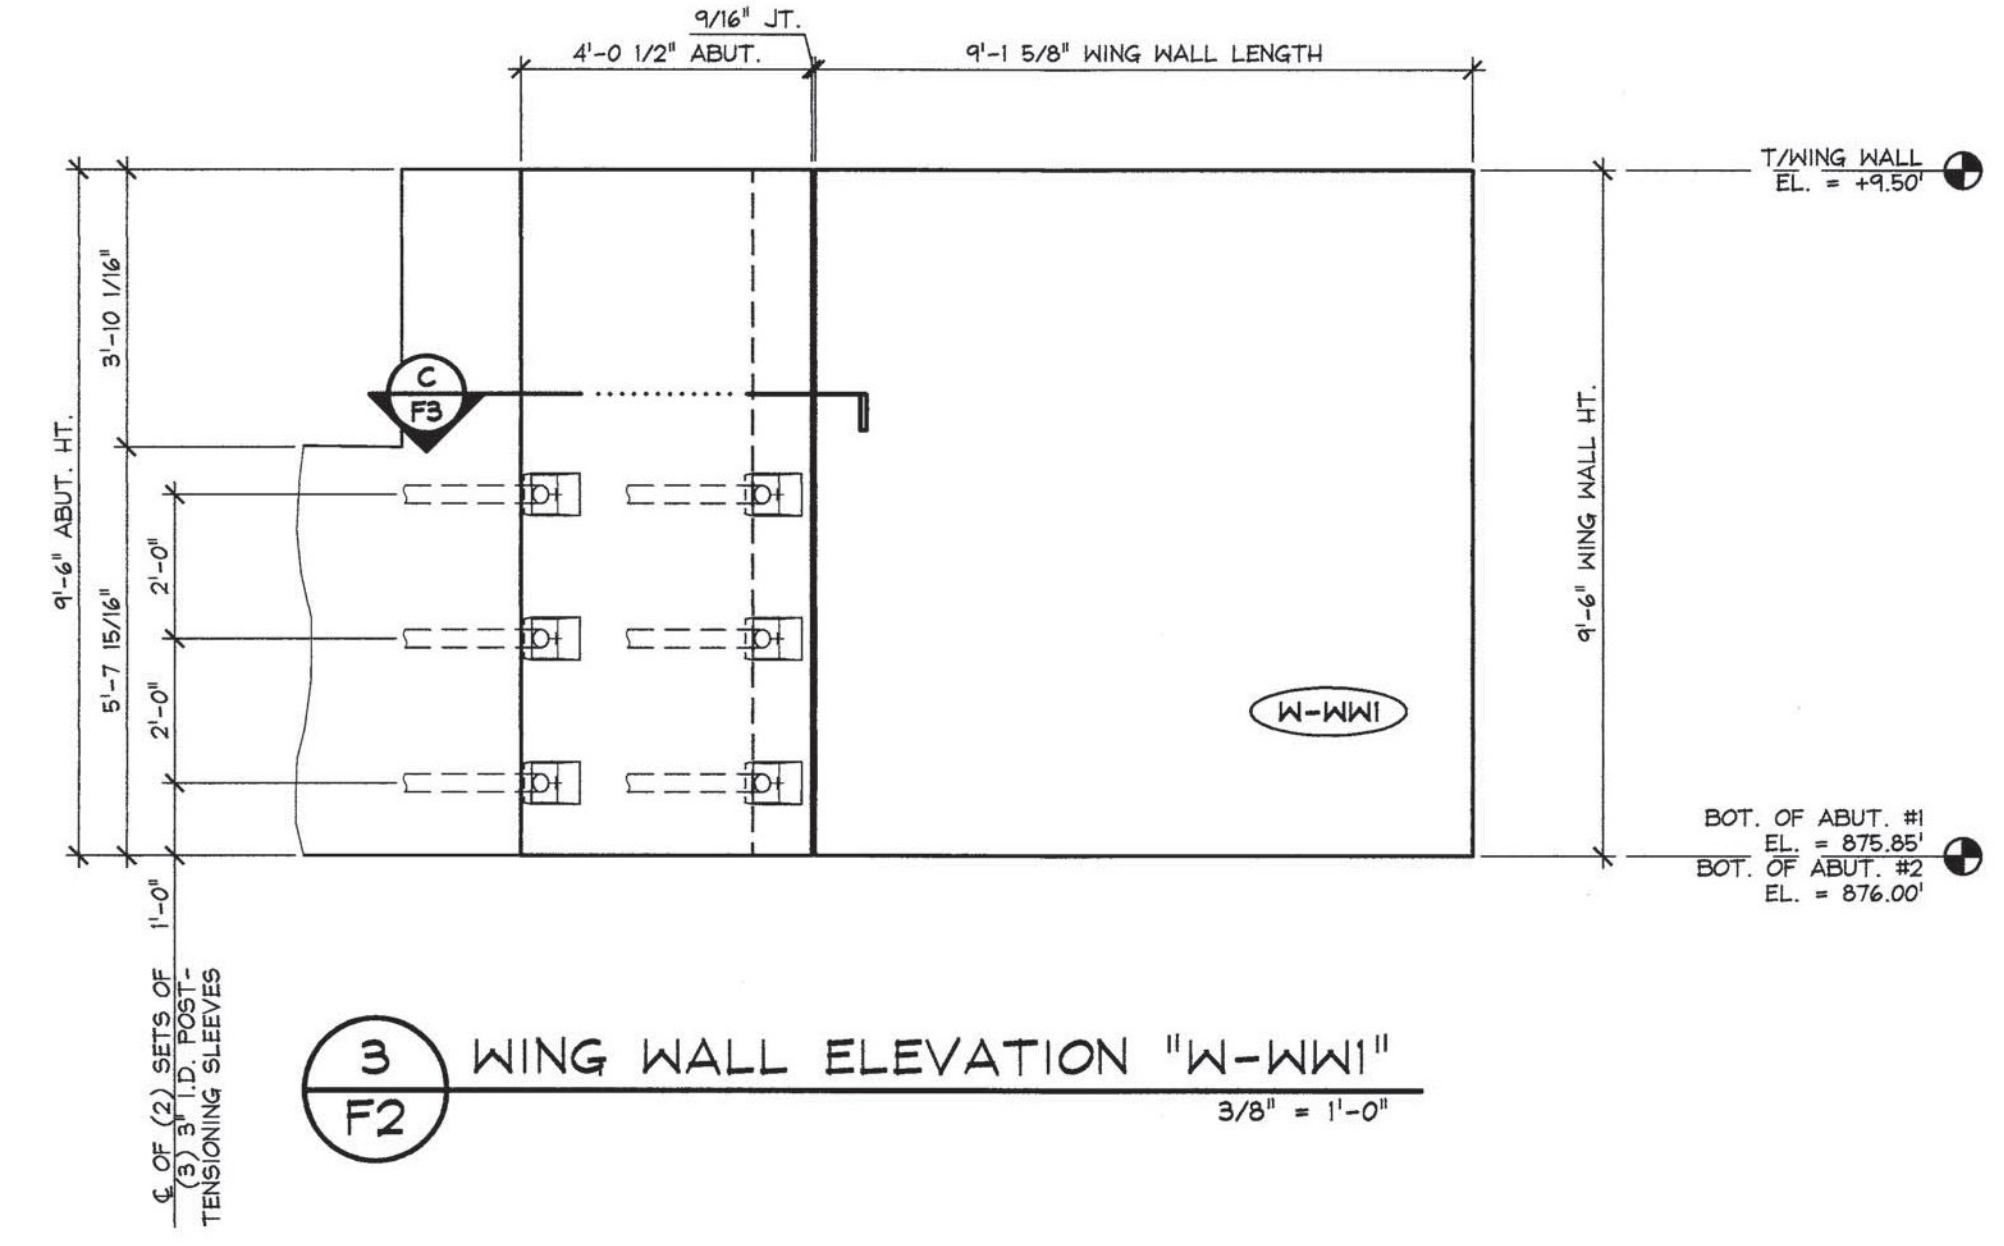

3 WING WALL ELEVATION "W-WW1"
 F2 3/8" = 1'-0"

APPROVAL STAMP:

Vermont Agency of Transportation
RECEIVED
 CK'D BY JDG/JW OK'D BY WDL
 January 27, 2014
 RESUBMIT No Approved
 BY KMH DATE 02/10/2014

J.P. CARRARA & SONS INC. Precast & Prestress Manufacturer <small>2464 GAGE STR., WOODBURY, VERMONT 05753 Phone: (802)388-6361 Fax: (802)388-9010</small>		MILLER CONSTRUCTION, INC. CONTRACTOR BARNARD, VERMONT	
STATE OF VERMONT AGENCY OF TRANSPORTATION COUNTY OF WINDSOR		DATE: DEC. 18, 2013 SCALE: NOTED	
TOWN OF BARNARD VT ROUTE 12, MAJOR COLLECTOR BRIDGE NO.: 25 PROJECT NO.: ER BRF 0241(39)		CHKD: - DFTM: B.L. JOB NO: 23413-013	
ABUTMENT ELEVATIONS		DWG. NO: F2	