


85'

PARRARD (39)
WOL 11/07/13

Bearing $11 \frac{1}{2}'' \times 11 \frac{1}{2}''$
 $\div 2$
 $5 \frac{3}{4}''$

Calc:
 $\cos 30 = \frac{\sqrt{3}}{2}$
 $\cos 30 = 0.866$
 $6'' \div \cos 30 = 6.9282''$
 $= 6 \frac{15}{16}''$
 $6 \cos 30 = 5.196$
 $= 5 \frac{3}{16}''$

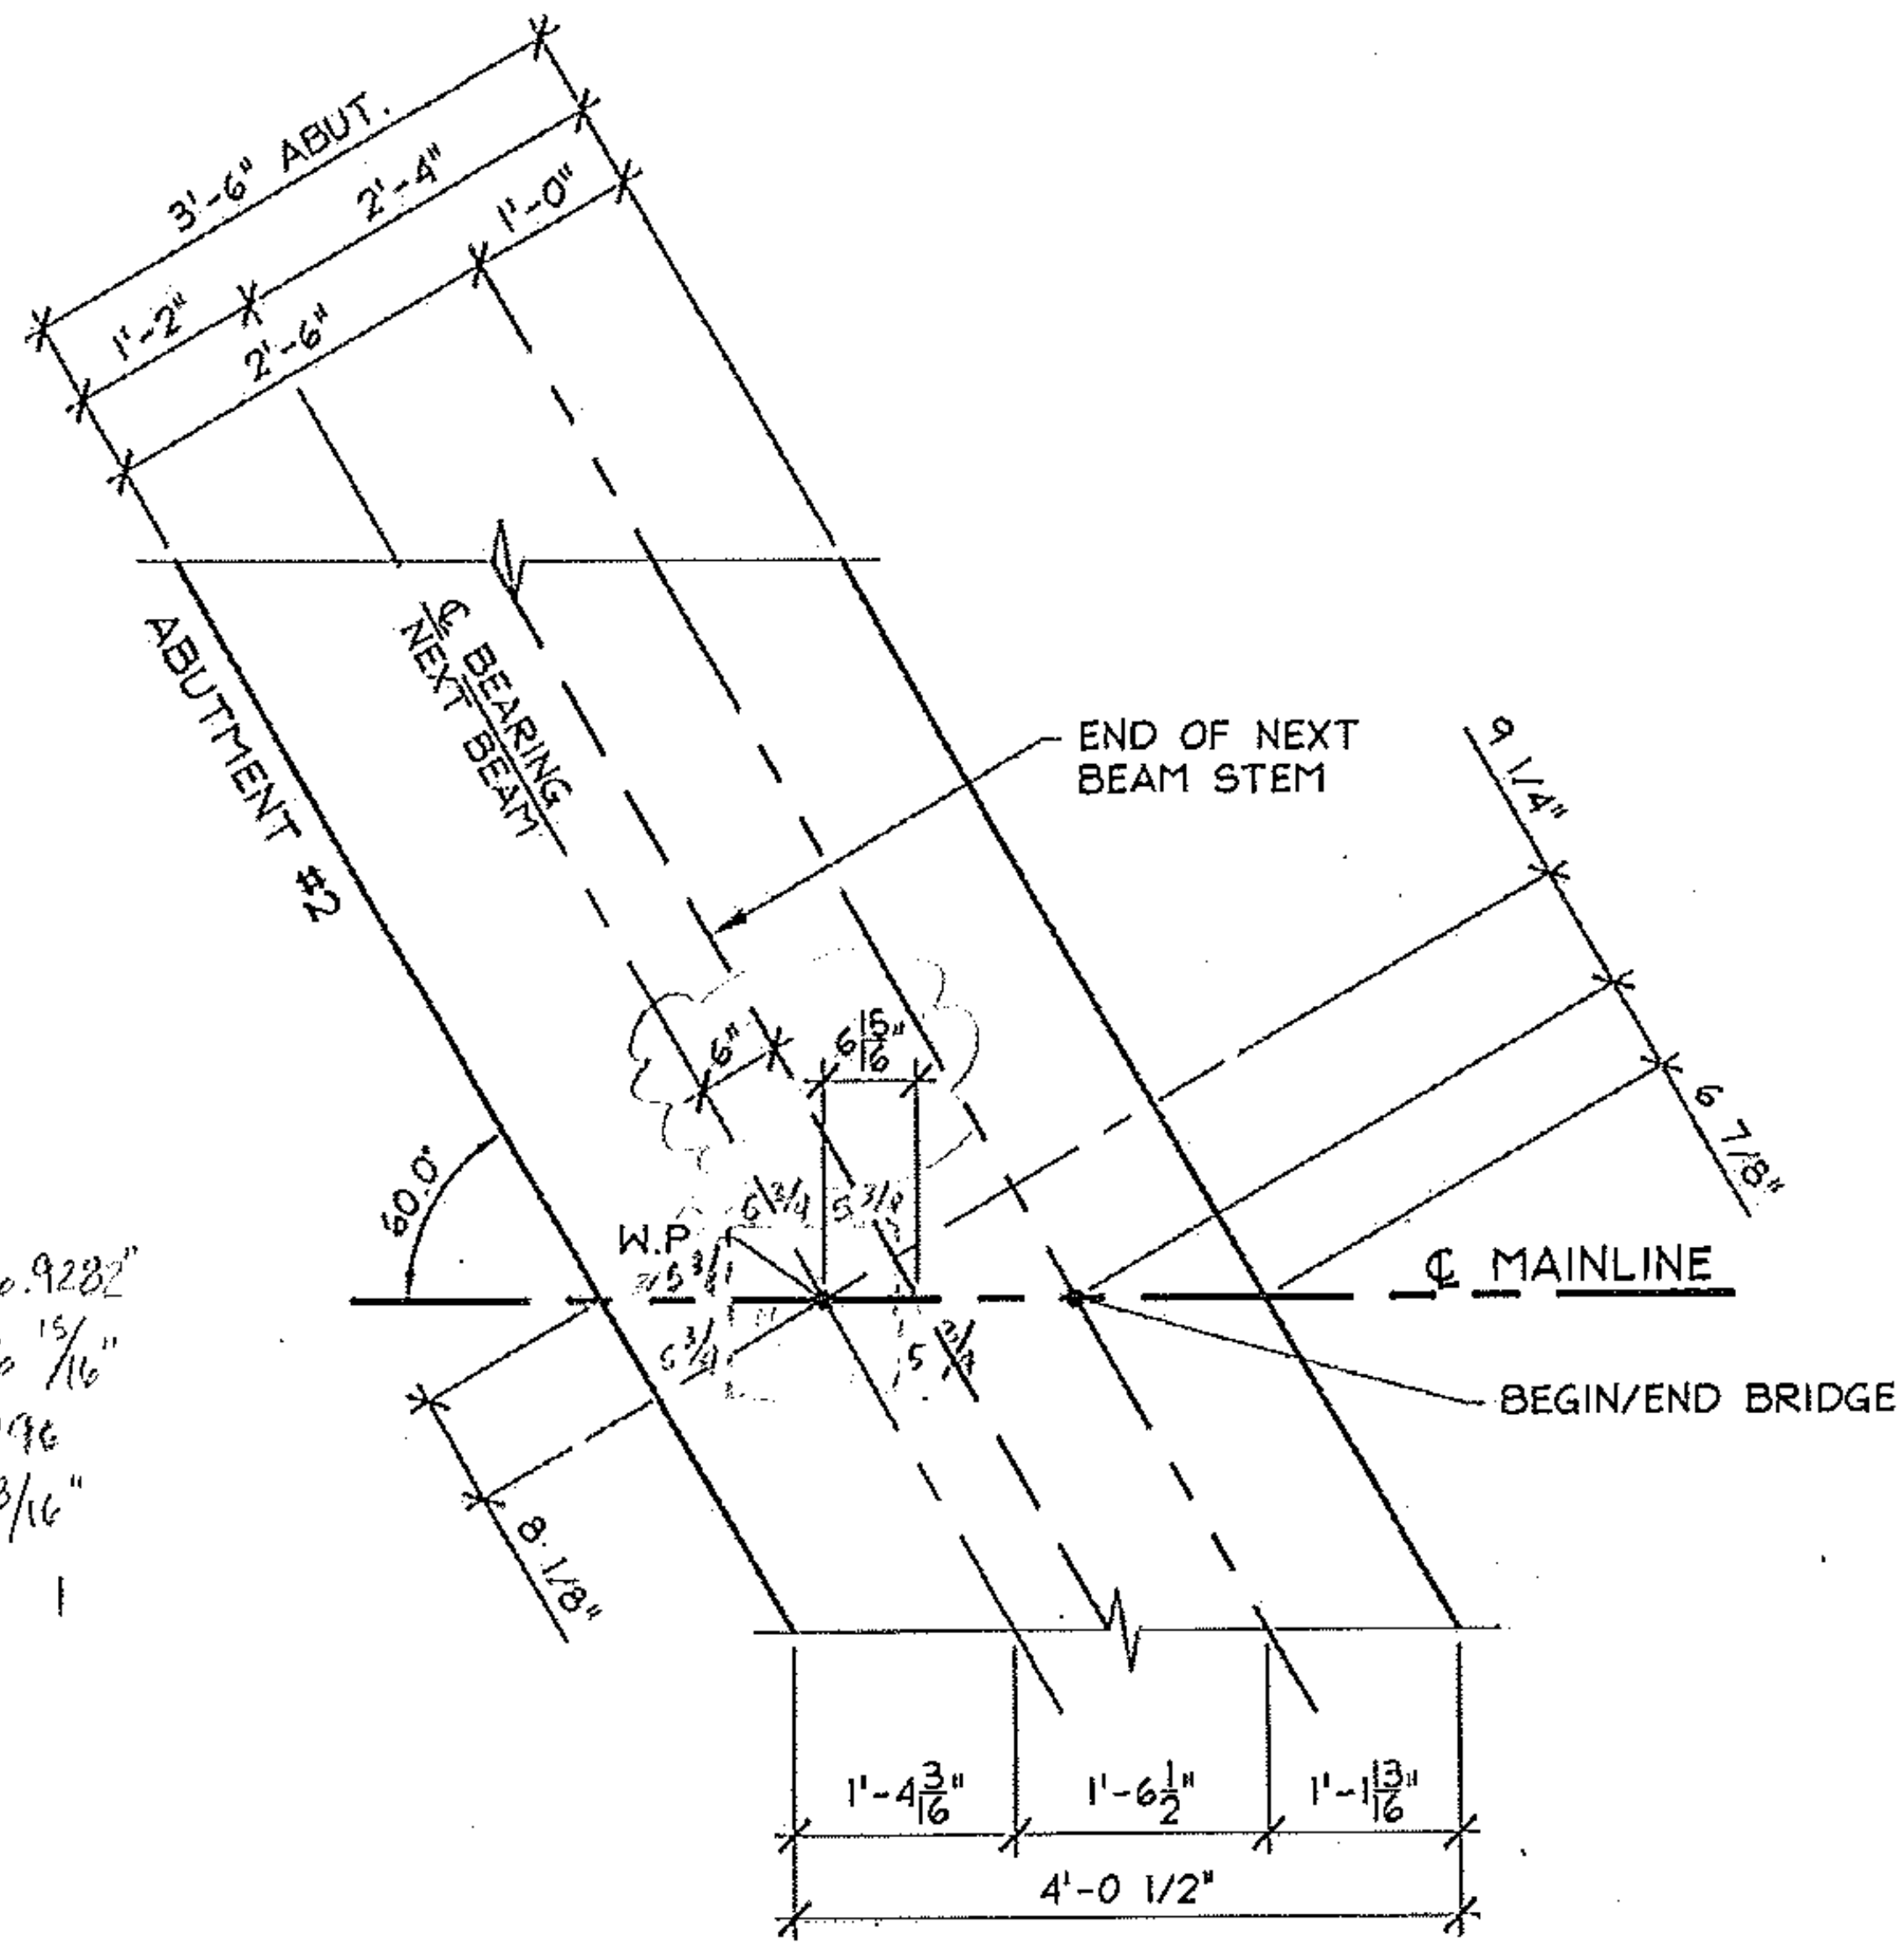

ENLARGED PLAN

1/2" = 1'-0"

$\frac{15}{16} \times 2 = \frac{30}{16} = 1 \frac{14}{16} = 1 \frac{7}{8}''$