

STATE OF VERMONT AGENCY OF TRANSPORTATION



PROPOSED IMPROVEMENT BRIDGE PROJECT TOWN OF BURKE COUNTY OF CALEDONIA

VT ROUTE 114 (MAJOR COLLECTOR) BRIDGE NO. 13

PROJECT LOCATION: LOCATED IN THE TOWN OF BURKE, ON VT ROUTE 114, APPROXIMATELY 0.47 MILE EASTERLY OF THE LYNDON/BURKE TOWN LINE AND EXTENDING EASTERLY FOR 190 FEET.

PROJECT DESCRIPTION: WORK TO BE PERFORMED UNDER THIS PROJECT INCLUDES REPLACEMENT OF THE EXISTING STRUCTURE WITH A NEW STRUCTURE INCLUDING RELATED ROADWAY AND CHANNEL WORK.

LENGTH OF ROADWAY: 131.15 FEET
 LENGTH OF STRUCTURE: 58.85 FEET
 LENGTH OF PROJECT: 190.00 FEET

VT 114 STA 25+10.00 (MM 0.475)
 END APPROACH
 BEGIN PROJECT

VT 114 STA 24+00.00 (MM 0.455)
 BEGIN APPROACH



VT 114 STA 27+00.00 (MM 0.511)
 END PROJECT
 BEGIN APPROACH

VT 114 STA 28+00.00 (MM 0.530)
 END APPROACH

VT 114 STA 26+22.91
 END BRIDGE

VT 114 STA 25+64.06
 BEGIN BRIDGE


TH 52 STA 1+15.00
 LIMIT OF WORK

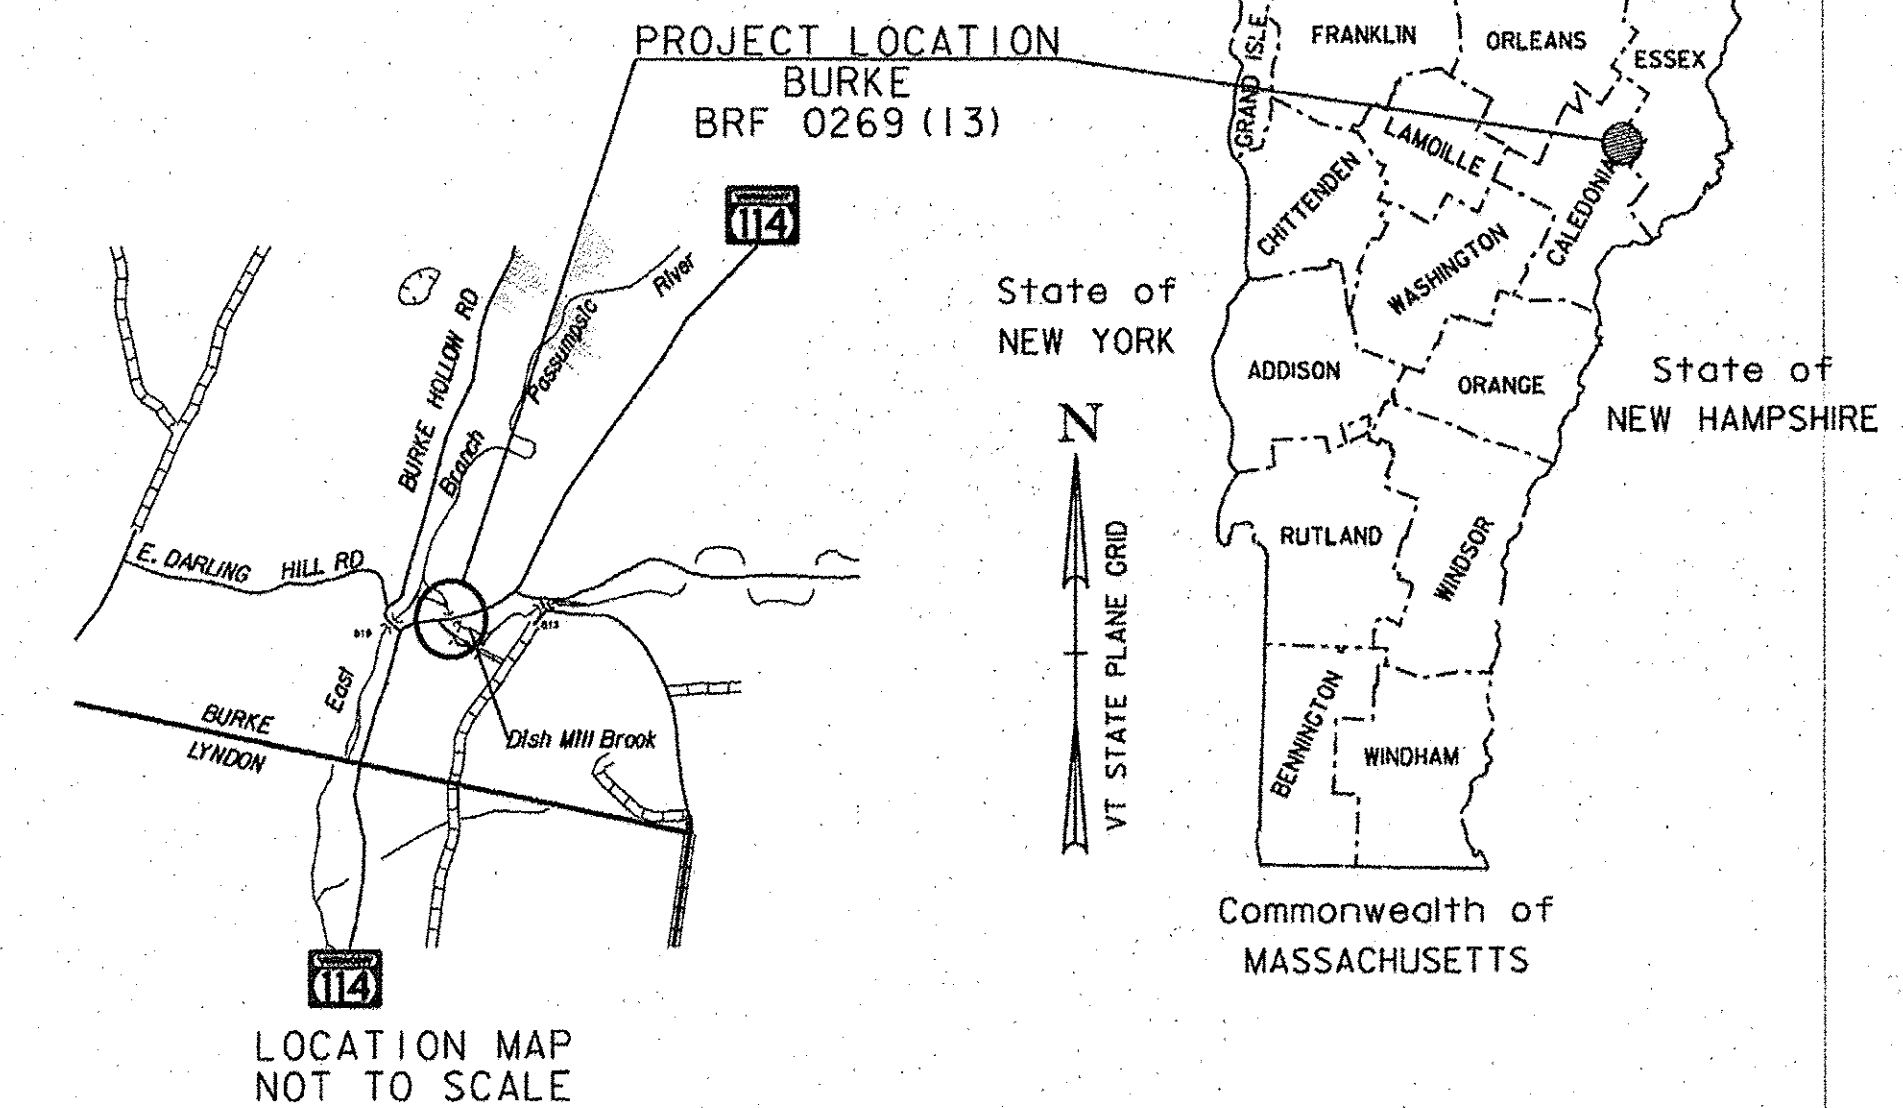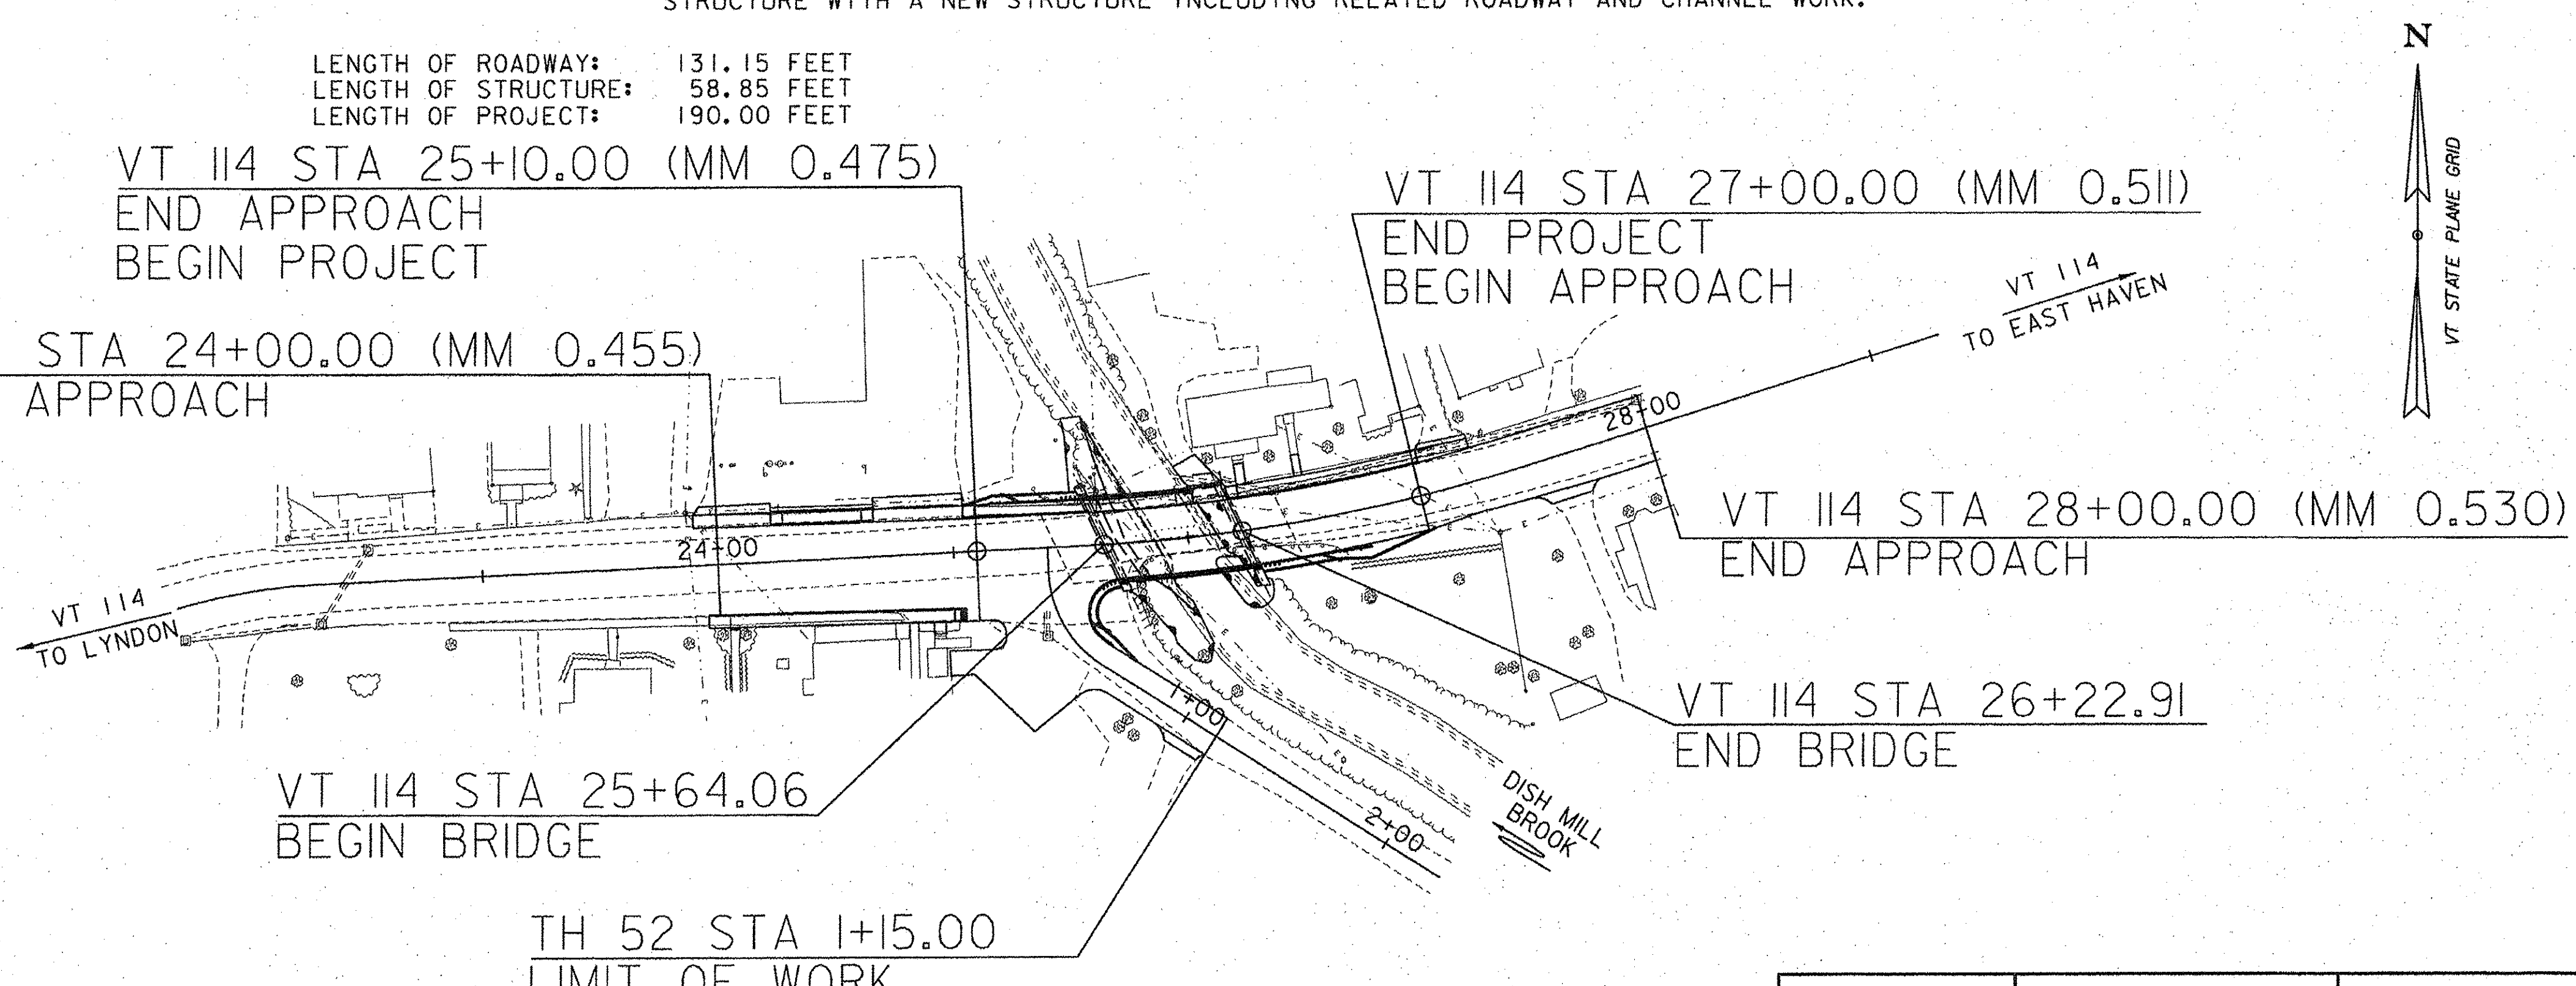

RECORD PLANS	
CONTRACTOR:	T. BUCK CONSTRUCTION INC. - AUBURN, ME.
RESIDENT ENGINEER:	KEVIN MCCLURE
CONSTRUCTION BEGAN:	APRIL 20, 2015
CONSTRUCTION COMPLETE:	JULY 17, 2015
RECORD PLANS BY:	KEVIN MCCLURE & KEVIN KING
I HEREBY CERTIFY THAT ALL THE CONSTRUCTION REQUIRED BY THIS SET OF DRAWINGS HAS BEEN ACCOMPLISHED AS INDICATED HEREIN.	
BY	<i>Kevin McClure</i> RESIDENT ENGINEER
DATE	8-22-16
NOTE: Any further information concerning final quantities, amounts or other details relative to this project may be found at Central Files in the electronic archives.	

CONSTRUCTION IS TO BE CARRIED ON IN ACCORDANCE WITH THESE PLANS AND THE STANDARD SPECIFICATIONS FOR CONSTRUCTION DATED 2011, AS APPROVED BY THE FEDERAL HIGHWAY ADMINISTRATION ON JULY 20, 2011 FOR USE ON THIS PROJECT, INCLUDING ALL SUBSEQUENT REVISIONS AND SUCH REVISED SPECIFICATIONS AND SPECIAL PROVISIONS AS ARE INCORPORATED IN THESE PLANS.

QUALITY ASSURANCE PROGRAM : LEVEL 2
SURVEYED BY : VTRANS
SURVEYED DATE : 04/27/2011
DATUM
VERTICAL NAVD 88
HORIZONTAL NAD 83 (96)

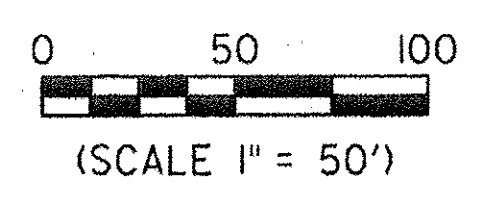

	<p>540 Commercial Street Manchester, NH 03101 (603) 668-8223 www.cldengineers.com</p>	DIRECTOR OF PROJECT DELIVERY
		APPROVED <i>[Signature]</i> DATE 10/22/2014
		PROJECT MANAGER : ROB YOUNG, P. E.
		PROJECT NAME : BURKE
		PROJECT NUMBER : BRF 0269(13)
		SHEET 1 OF 73 SHEETS