


TYPICAL BRIDGE SECTION
SCALE: 3/8" = 1'-0"

SPECIAL PROVISION (HIGH PERFORMANCE CONCRETE, RAPID SET) (FPQ) (TYP.)

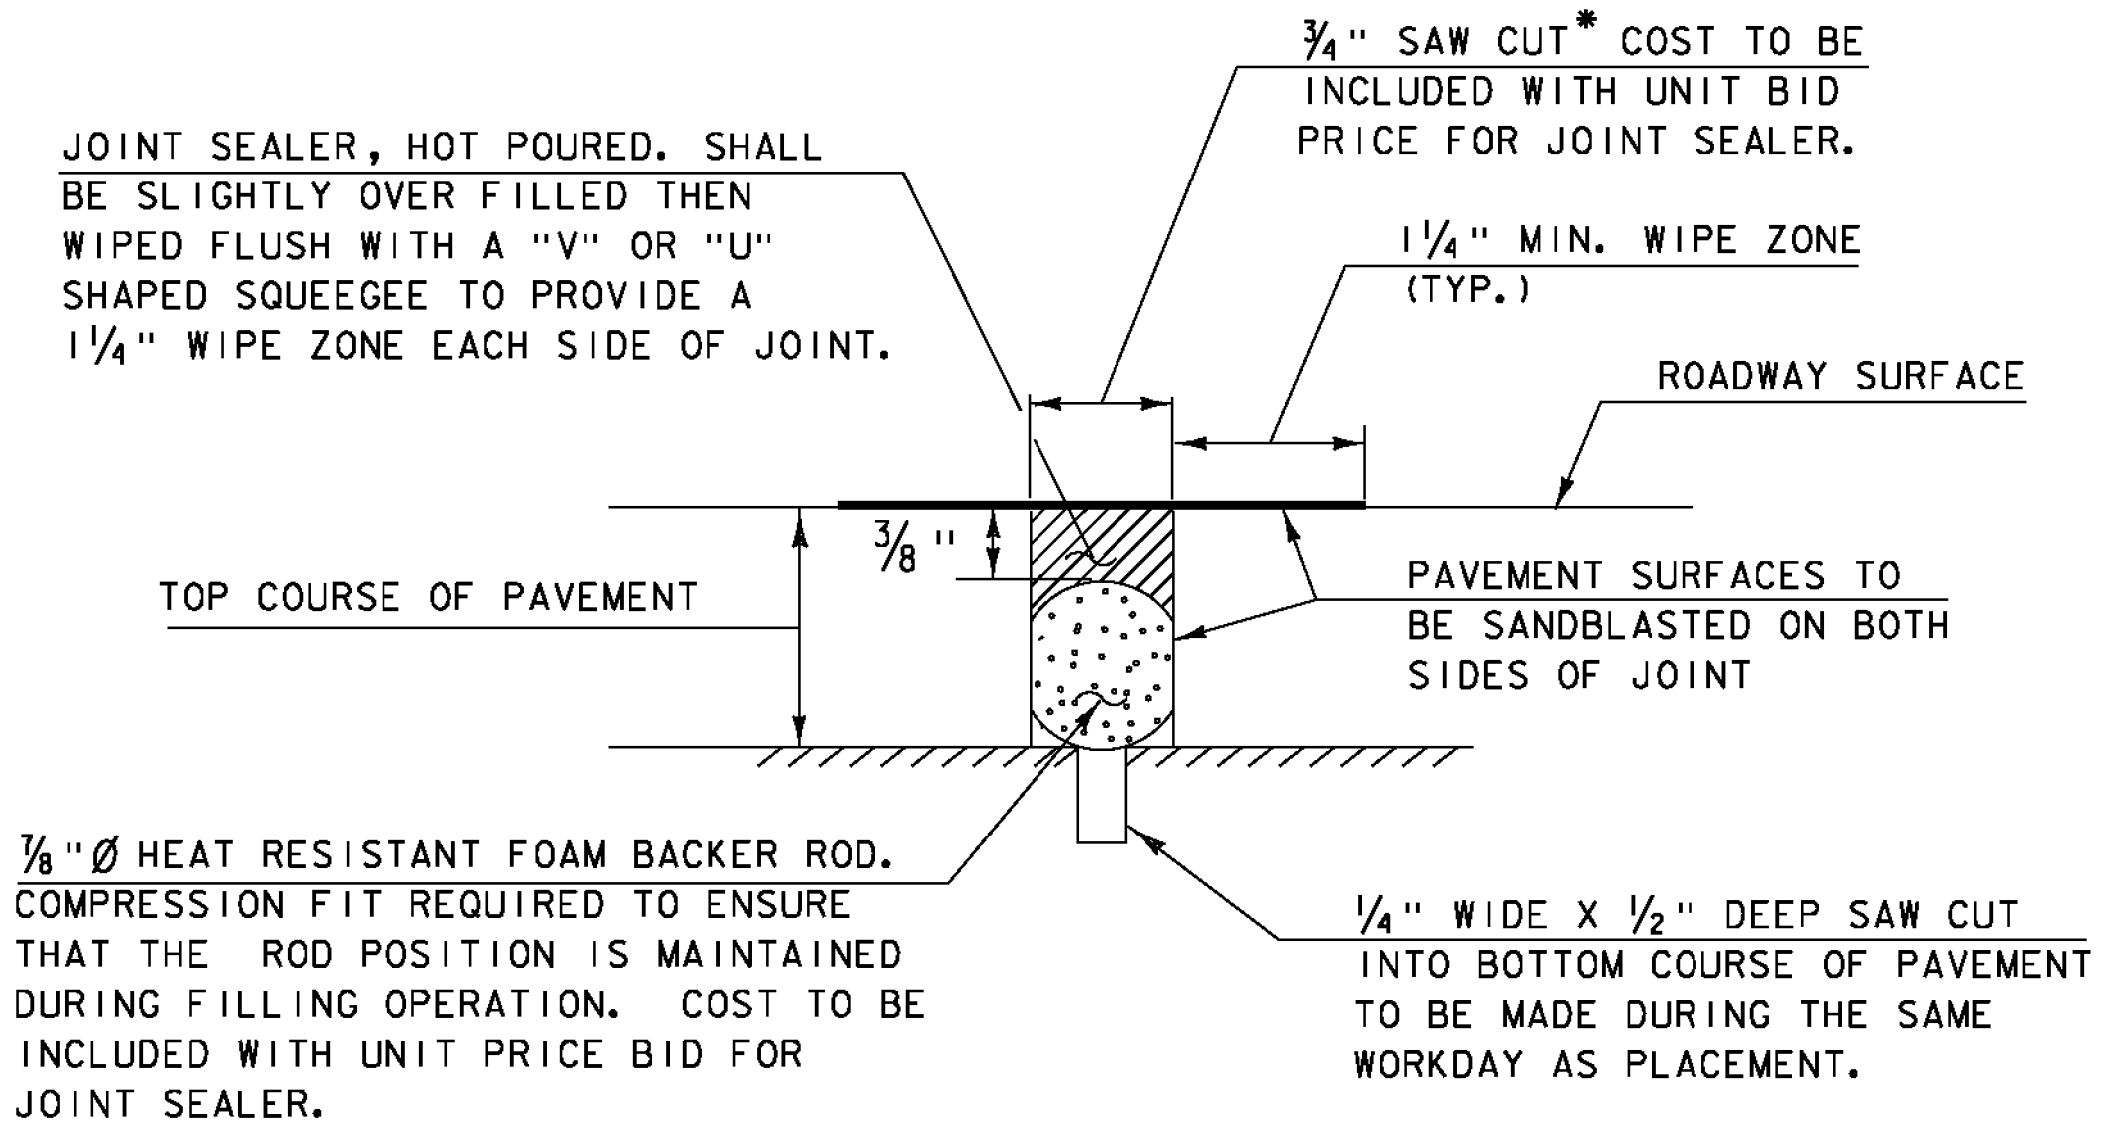

SAWED PAVEMENT JOINT DETAIL
(NOT TO SCALE)

* JOINT IS TO BE LOCATED ACCURATELY BY STRING LINING, OR OTHER MEANS, PRIOR TO PAVING, SO THAT THE SAW CUT WILL BE MADE DIRECTLY OVER THE END OF CONCRETE DECK. JOINT SHALL BE CUT DRY IN A SINGLE PASS AND BE SEALED WITHIN 24 HOURS OR PRIOR TO EXPOSURE TO TRAFFIC. JOINT SHALL BE CLEANED PRIOR TO APPLYING THE JOINT SEALER. ALL WORK SHALL BE PAID UNDER ITEM 524.11, "JOINT SEALER, HOT Poured".

BUILT AS DESIGNED

PROJECT NAME:	BURKE
PROJECT NUMBER:	BRF 0269(13)
FILE NAME:	z10c412sup.dgn
PROJECT LEADER:	J. BYATT
DESIGNED BY:	S. BEAUMONT
TYPICAL BRIDGE SECTION	
PLOT DATE:	11/19/2014
DRAWN BY:	M. SMITH
CHECKED BY:	J. BYATT
SHEET	3 OF 73

