

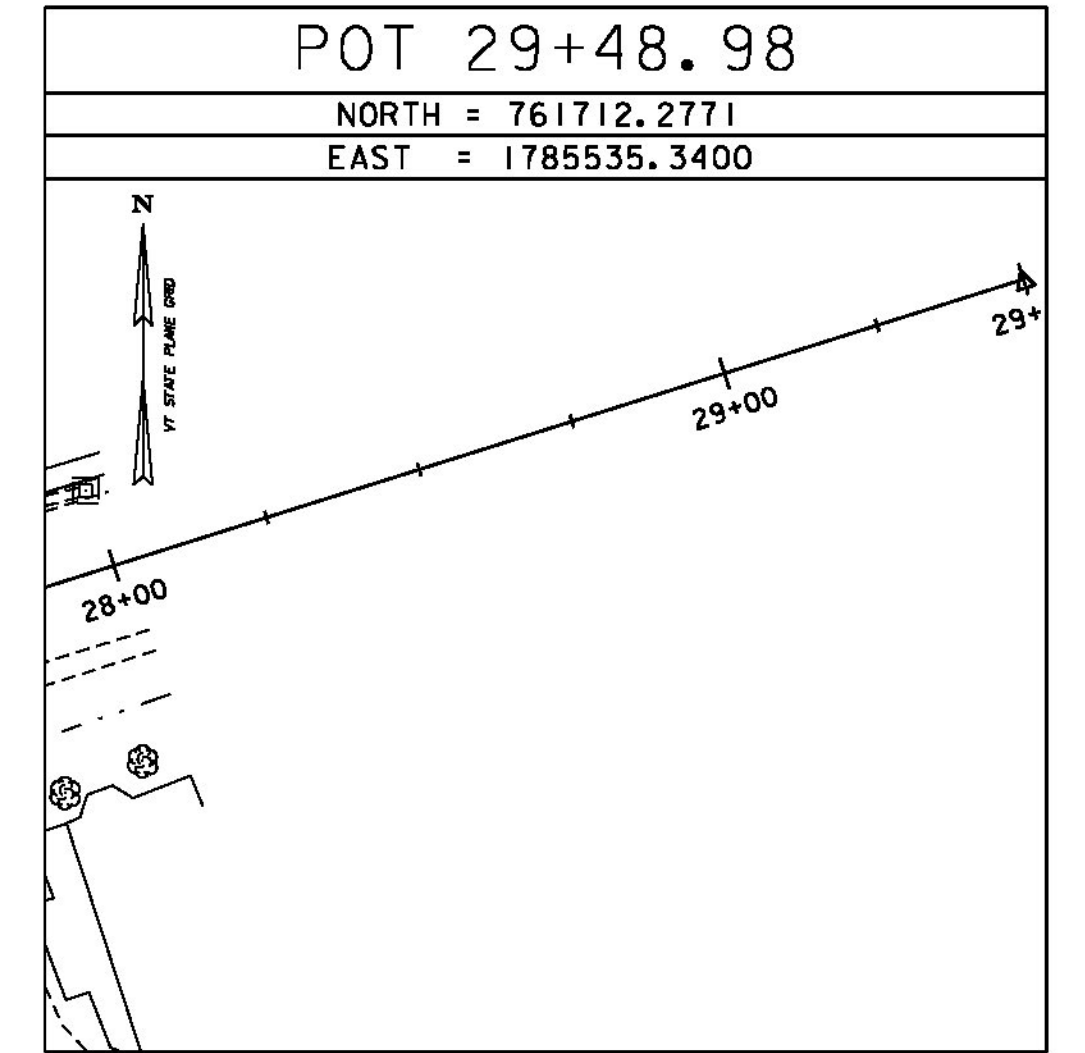
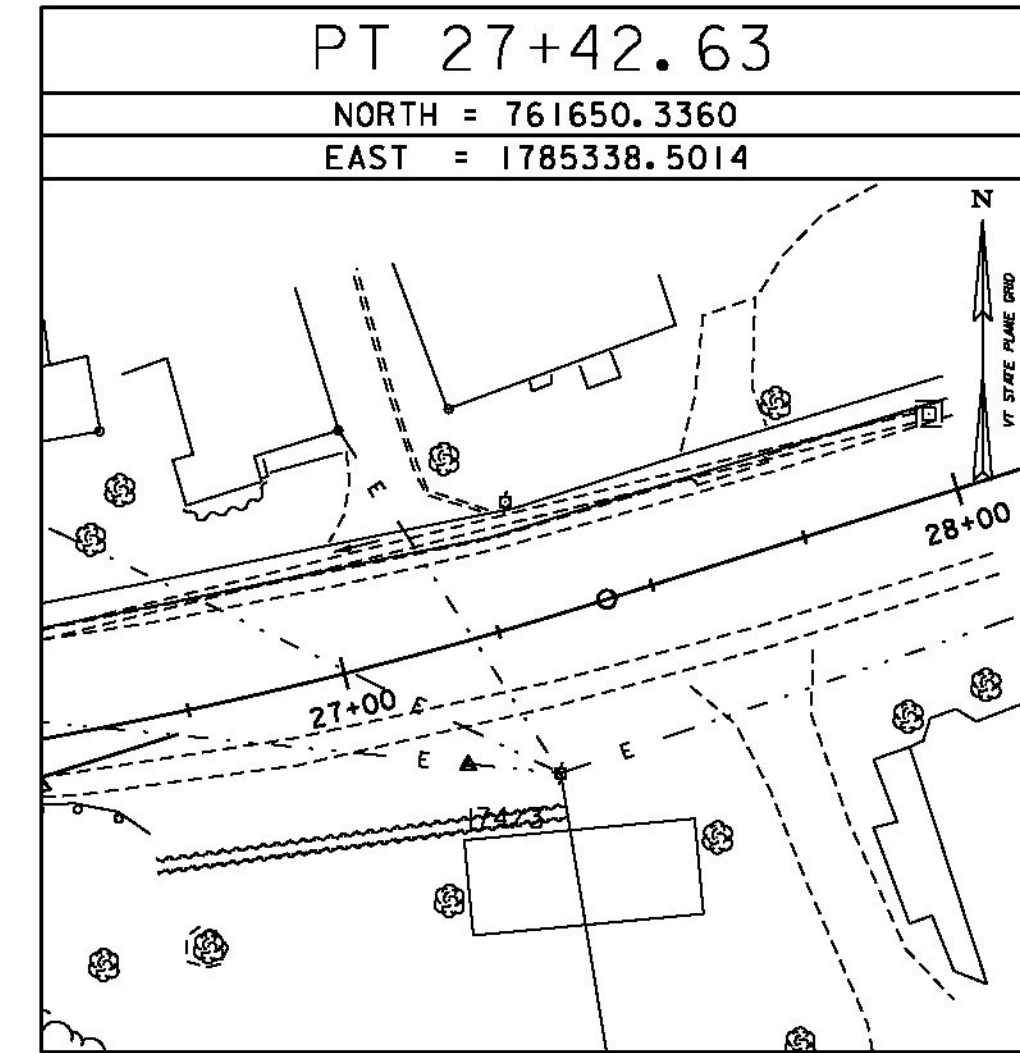
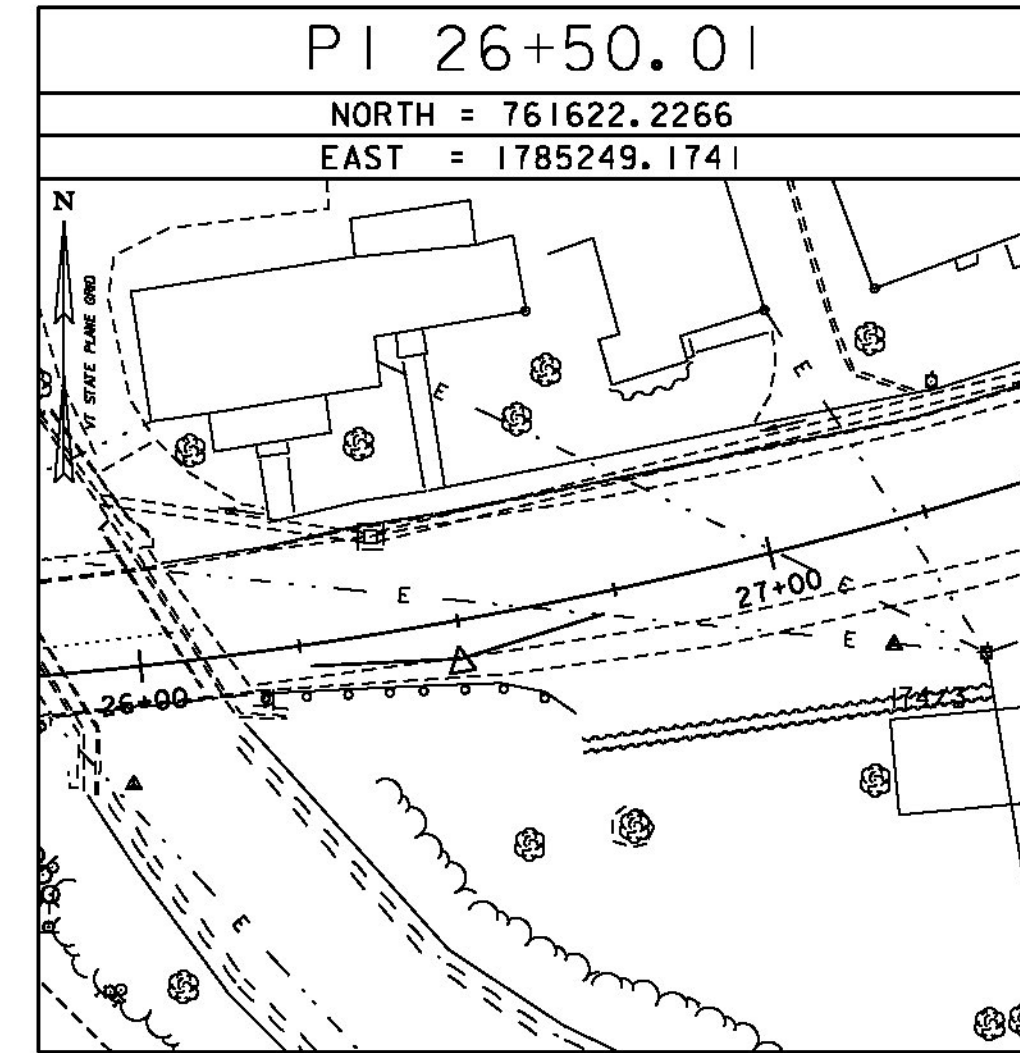
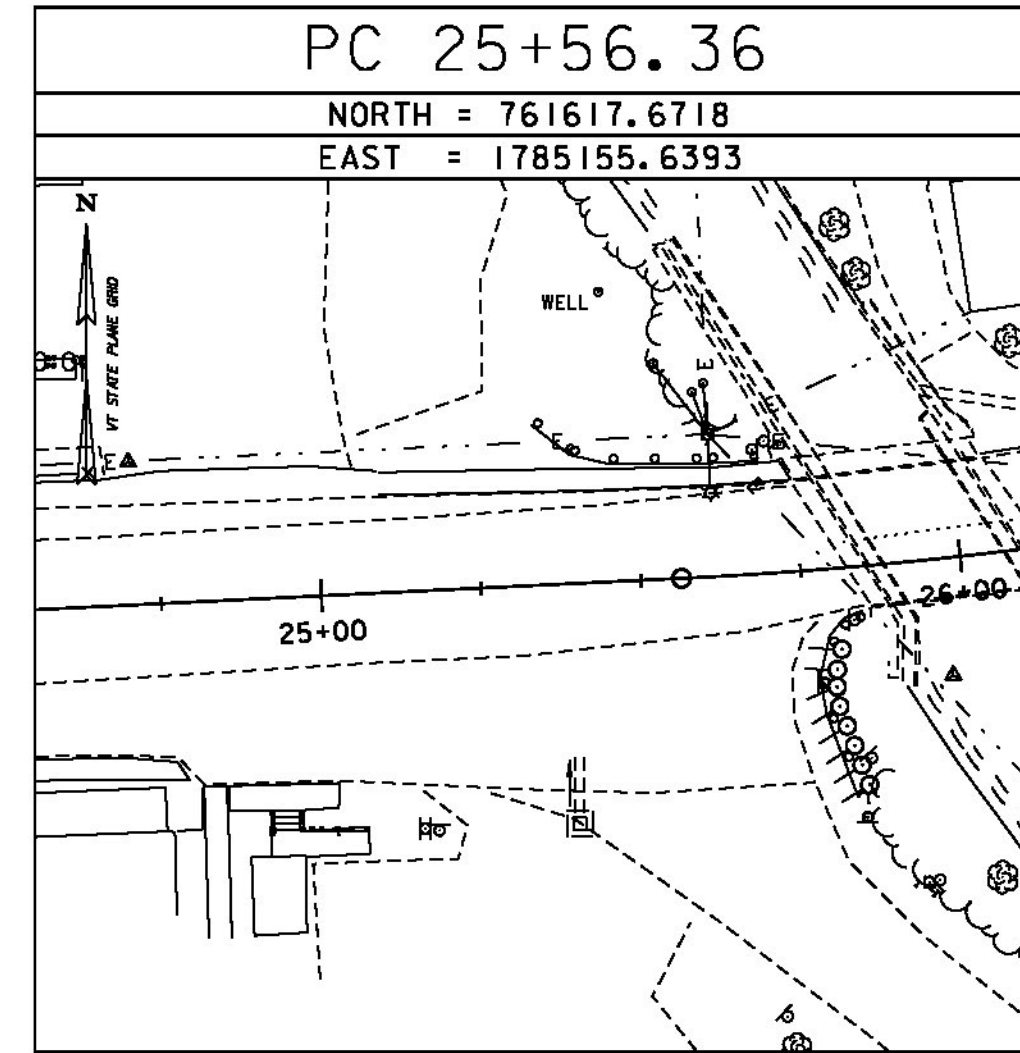
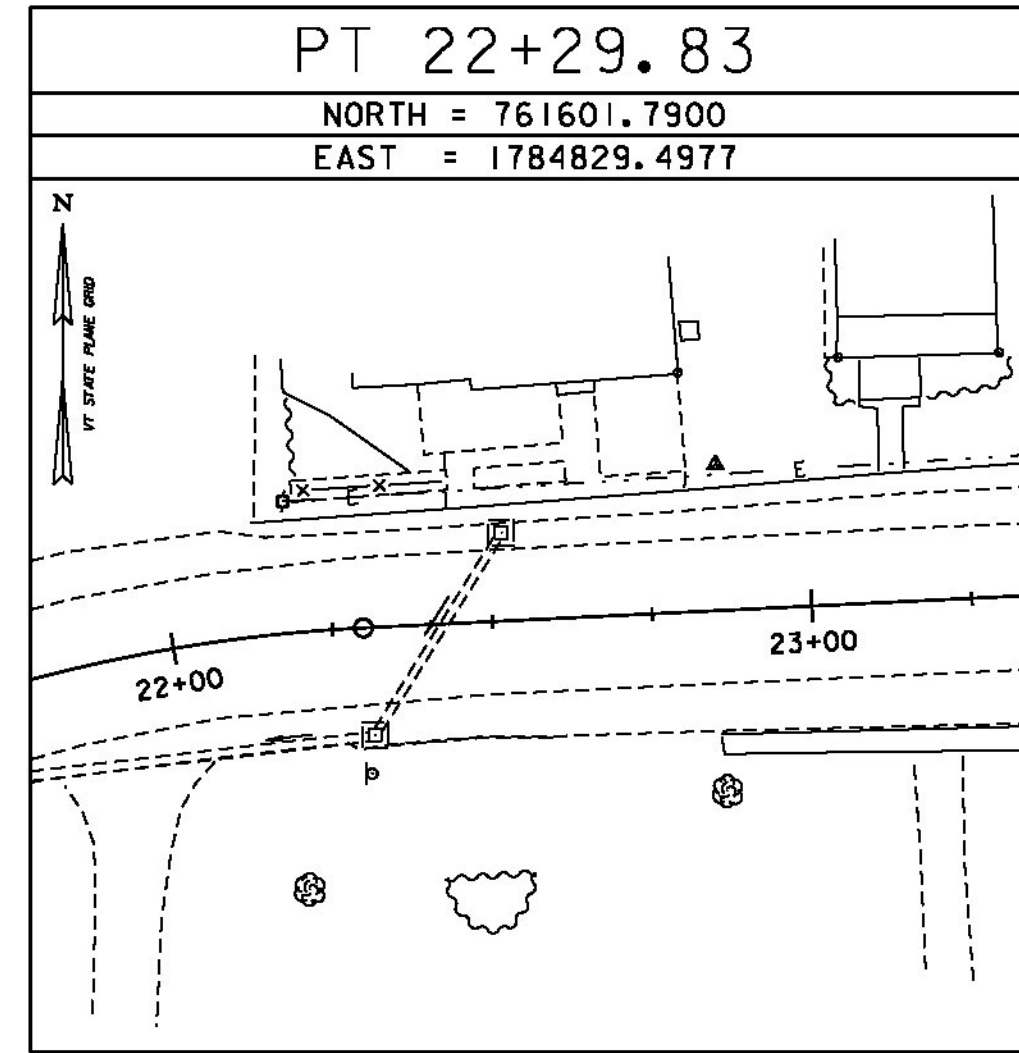
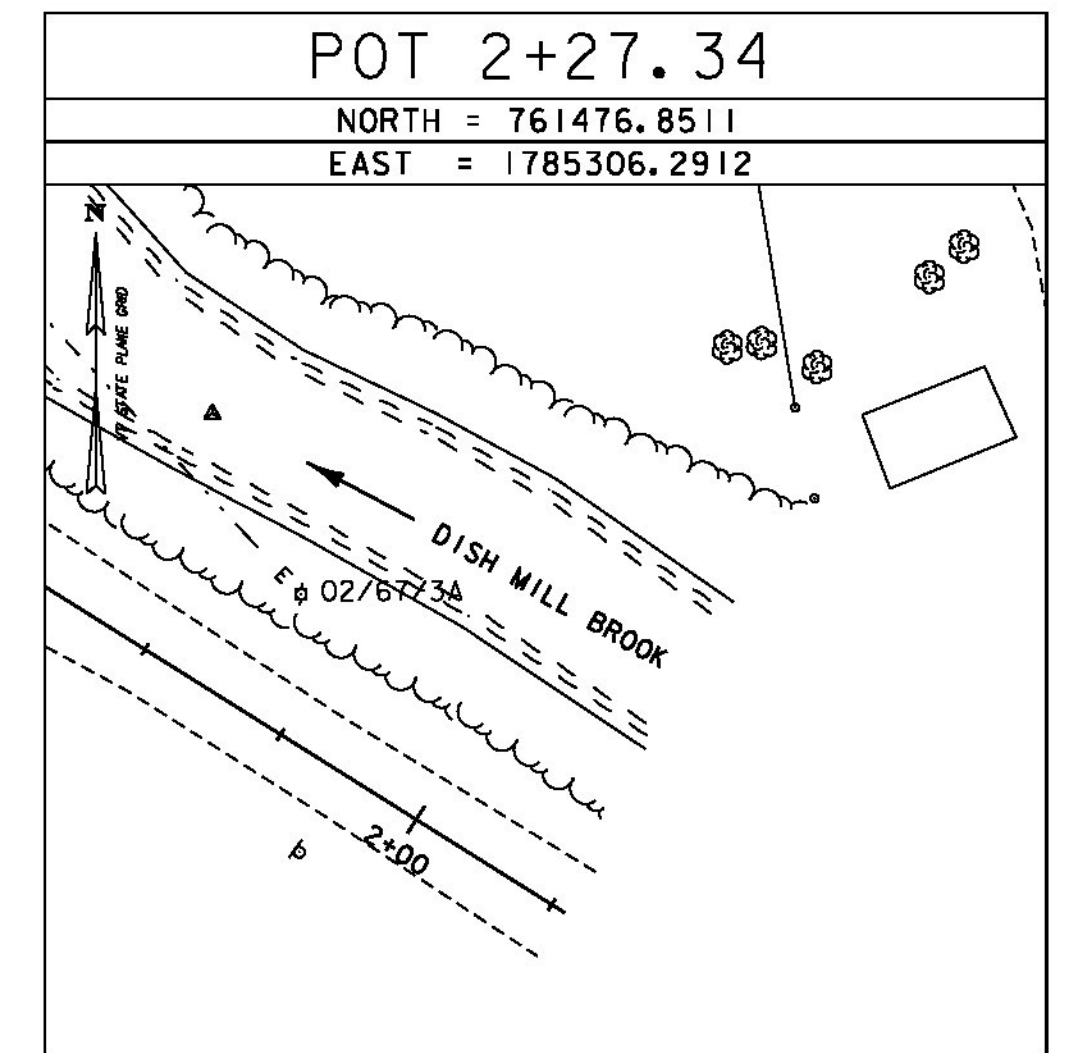
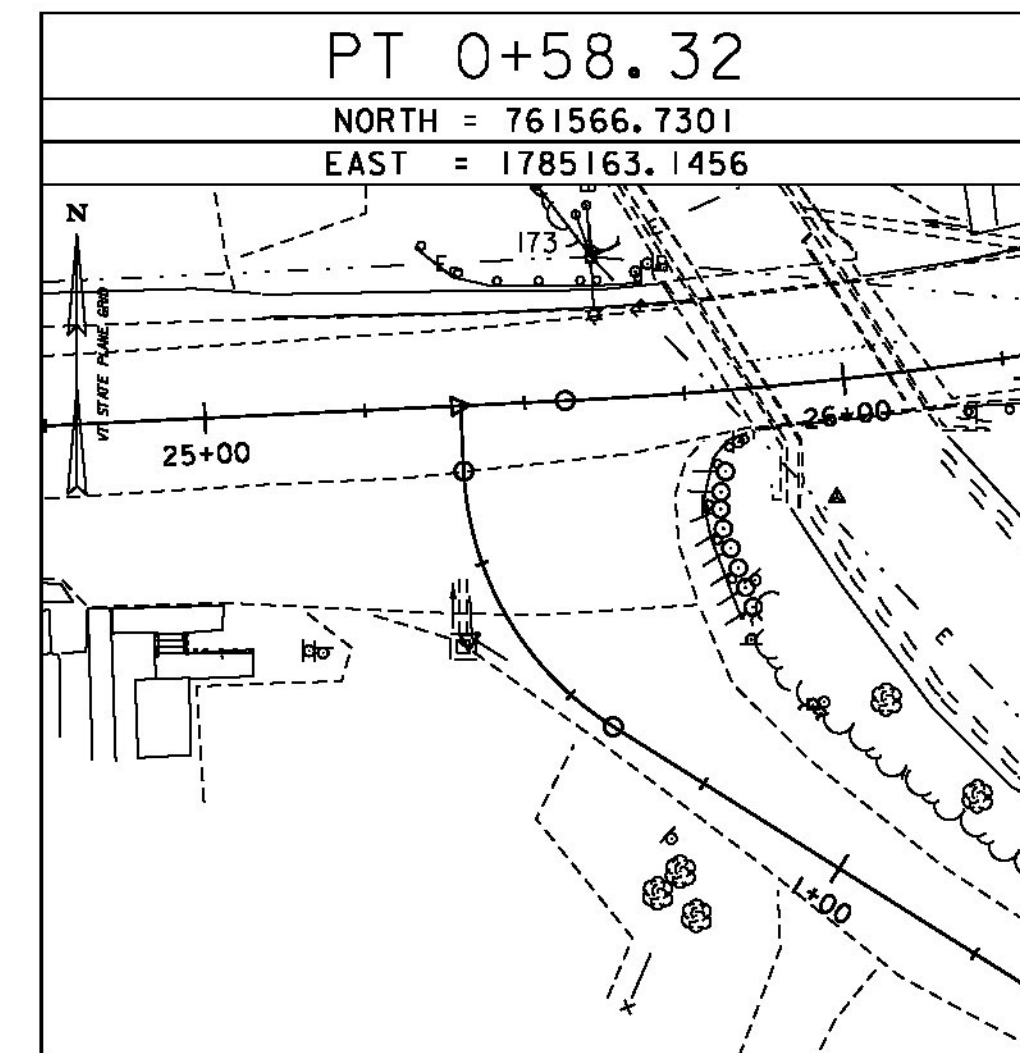
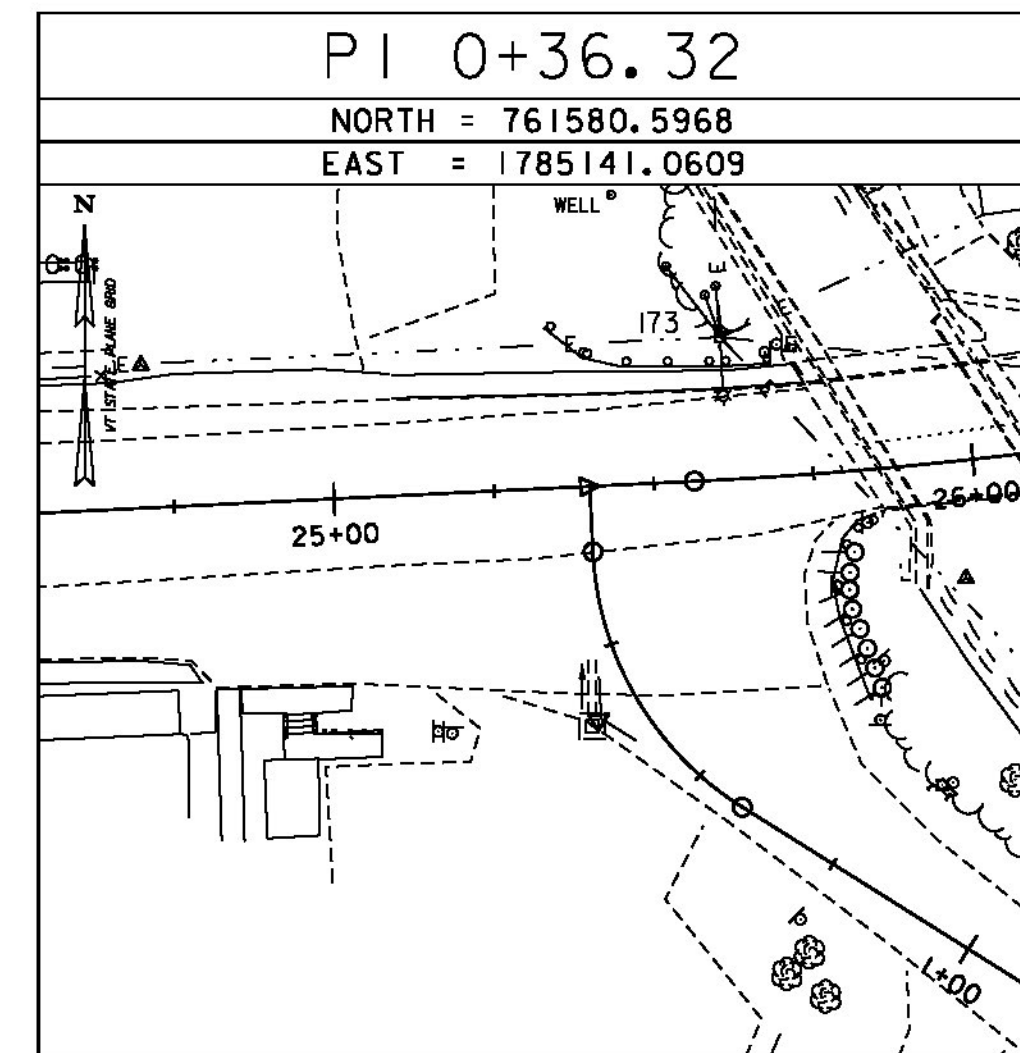


ALIGNMENT TIES

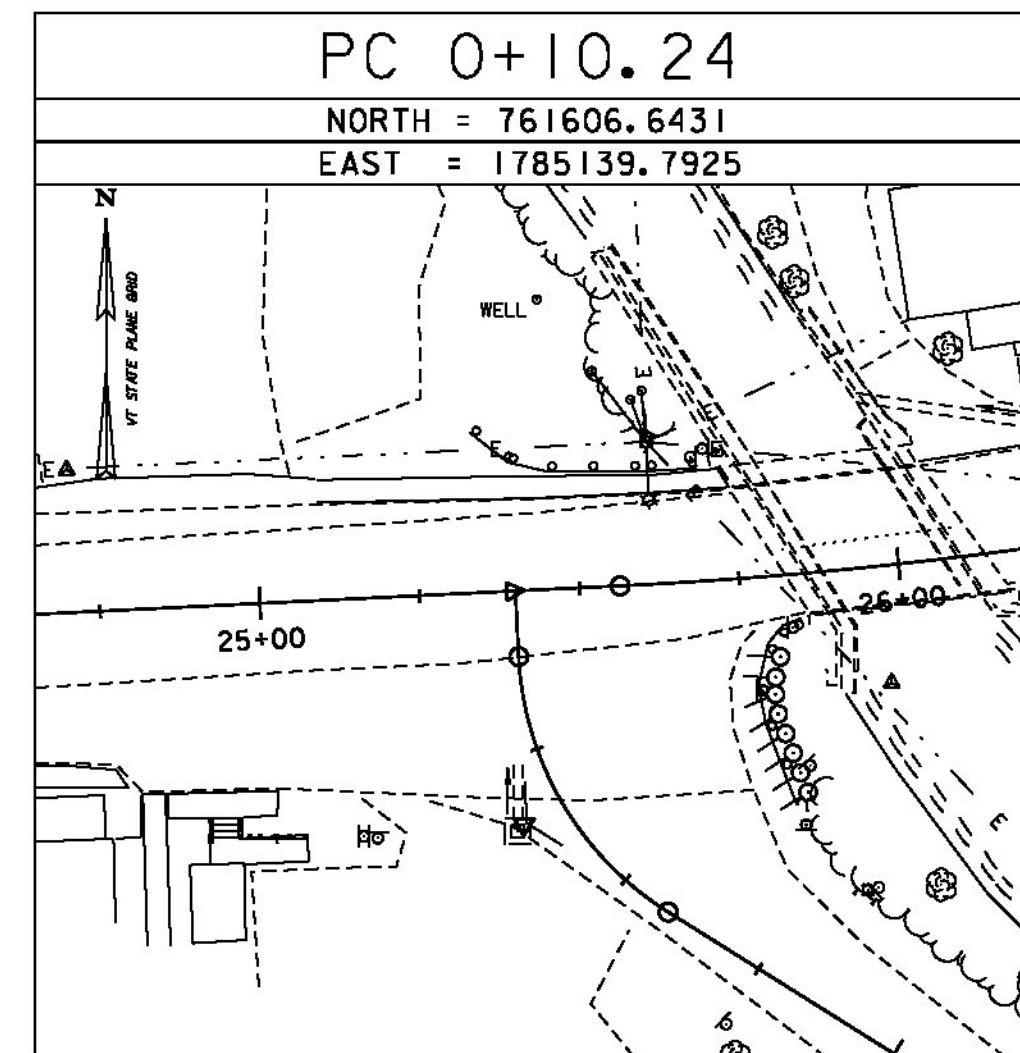

ALIGNMENT TIES

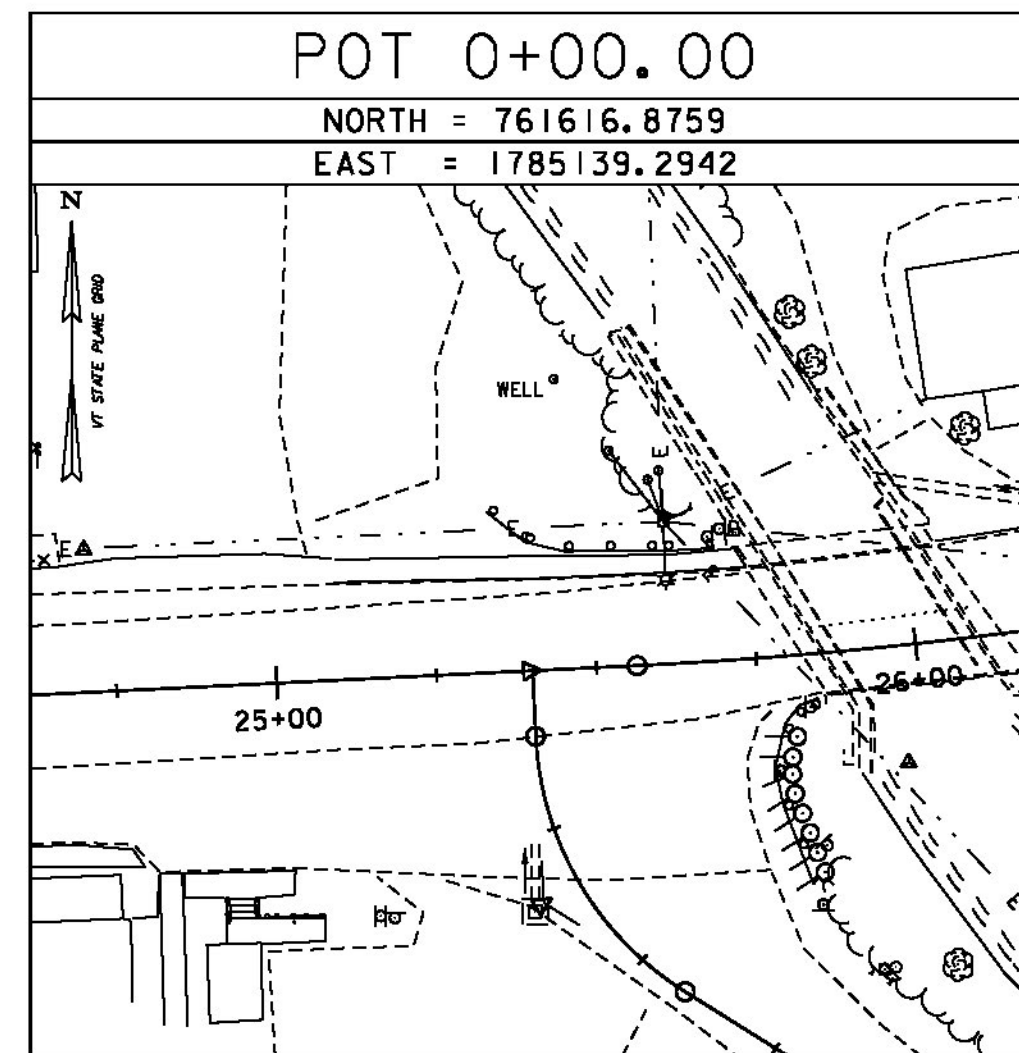

PROJECT NAME: BURKE  
 PROJECT NUMBER: BRF 0269(13)

FILE NAME: I0c412/cos/z10c412+1e.dgn  
 PROJECT LEADER: J. BYATT  
 DESIGNED BY: M. HALEY  
 TIE SHEET 2

PLOT DATE: 10/14/2014  
 DRAWN BY: M. HALEY  
 CHECKED BY: P. SHEDD  
 SHEET 16 OF 73