




INTERSECTION 1
US 5 AND VT 16

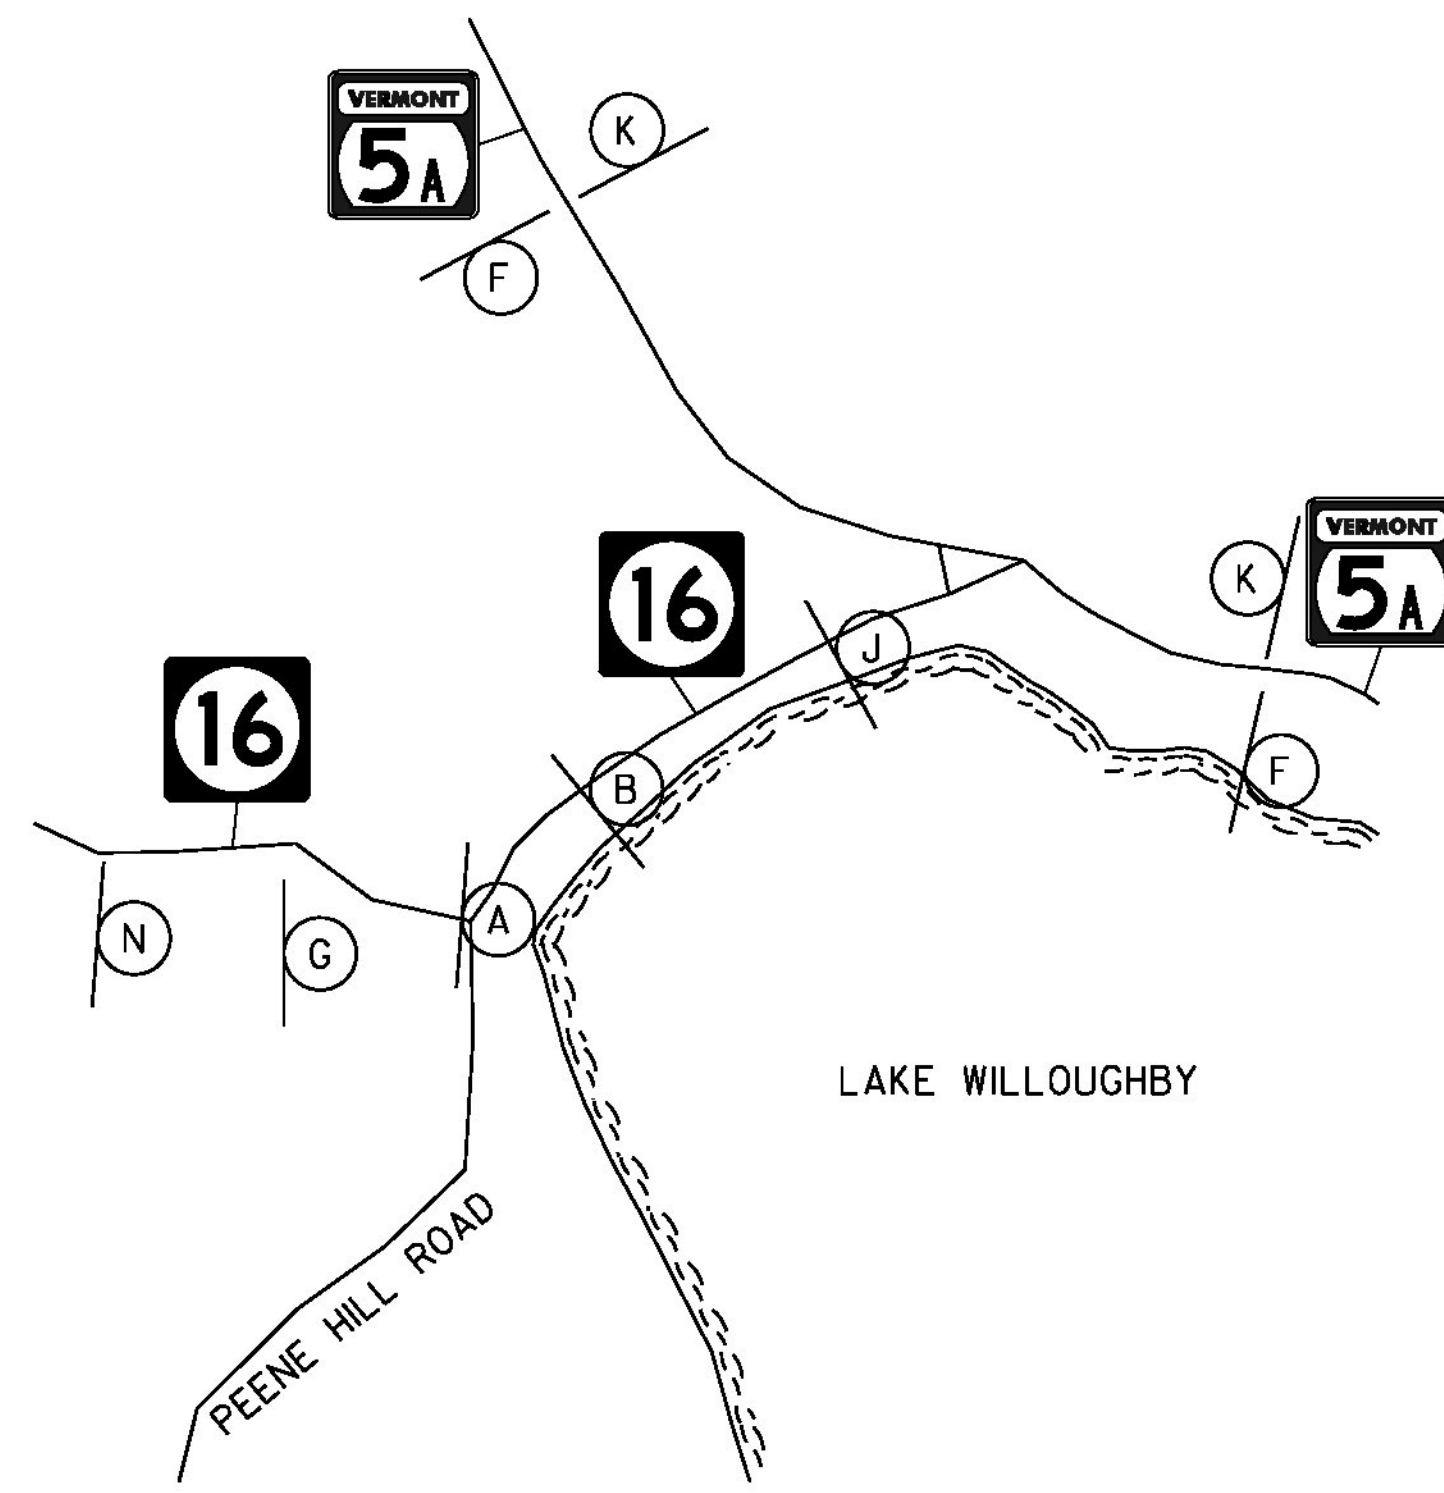


INTERSECTION 2
VT 16 AND VT 5A

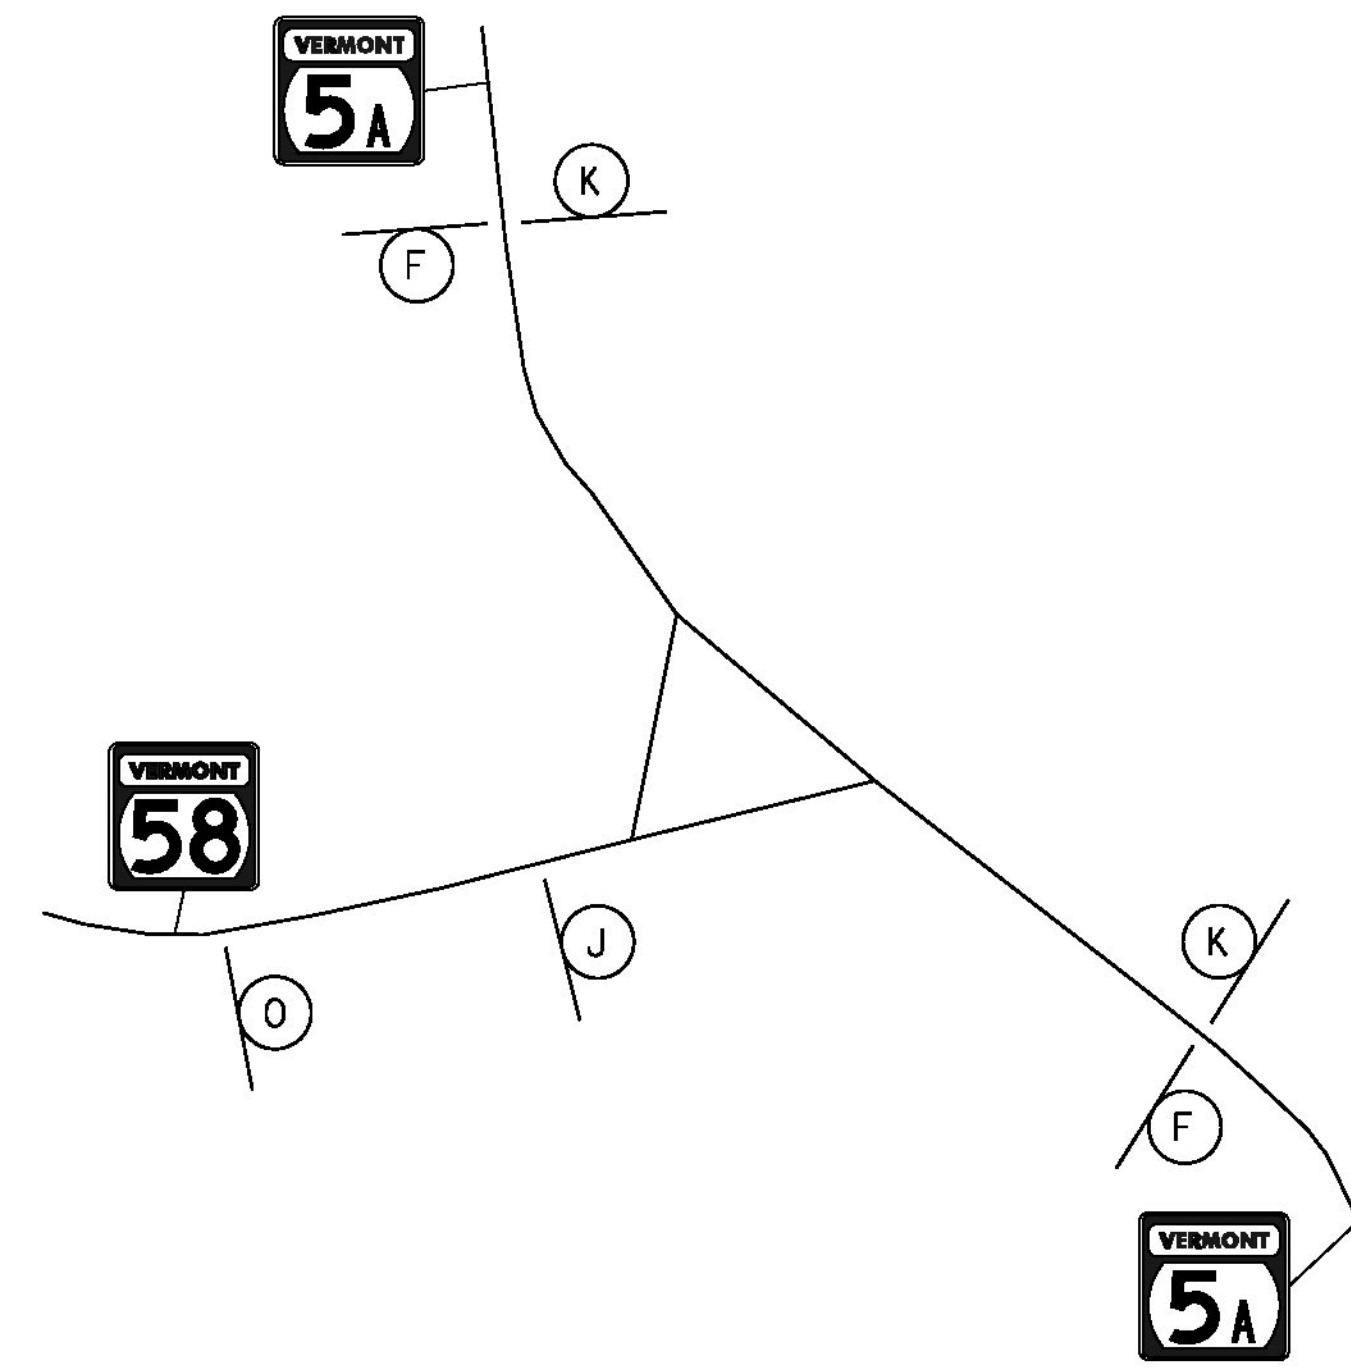


INTERSECTION 3
VT 5A AND VT 58

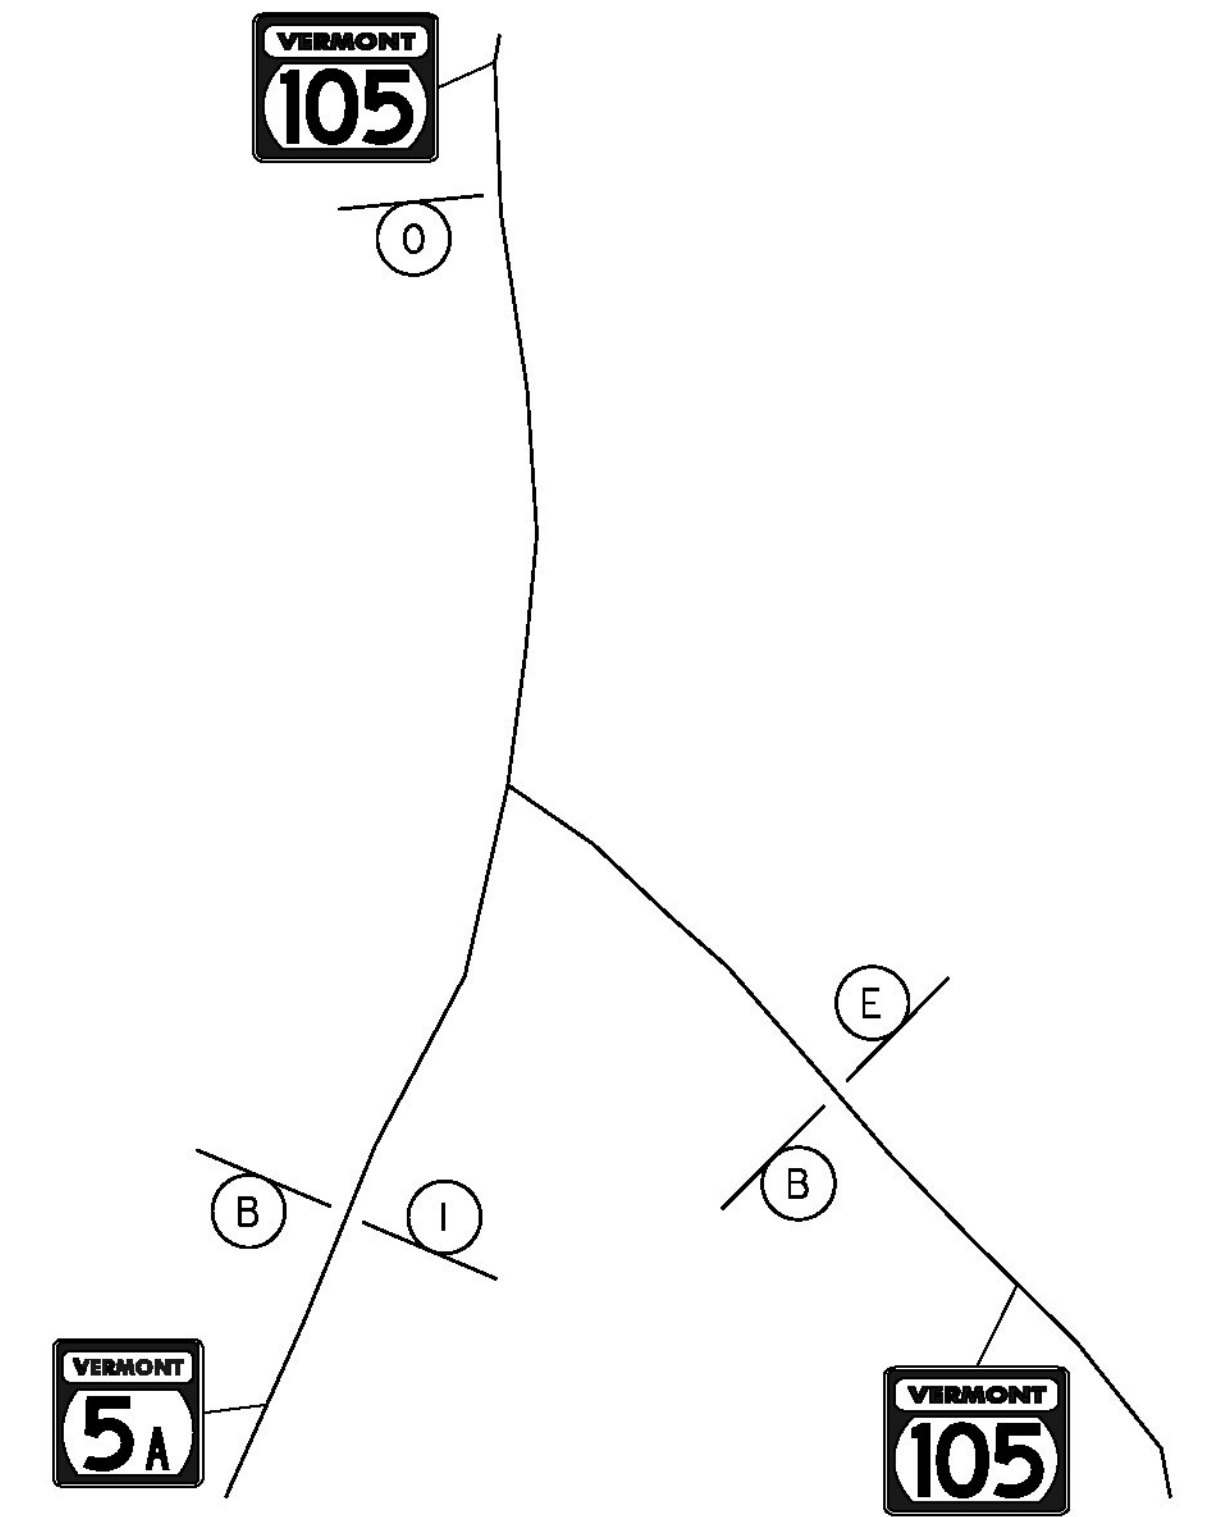


INTERSECTION 4
VT 5A AND VT 105

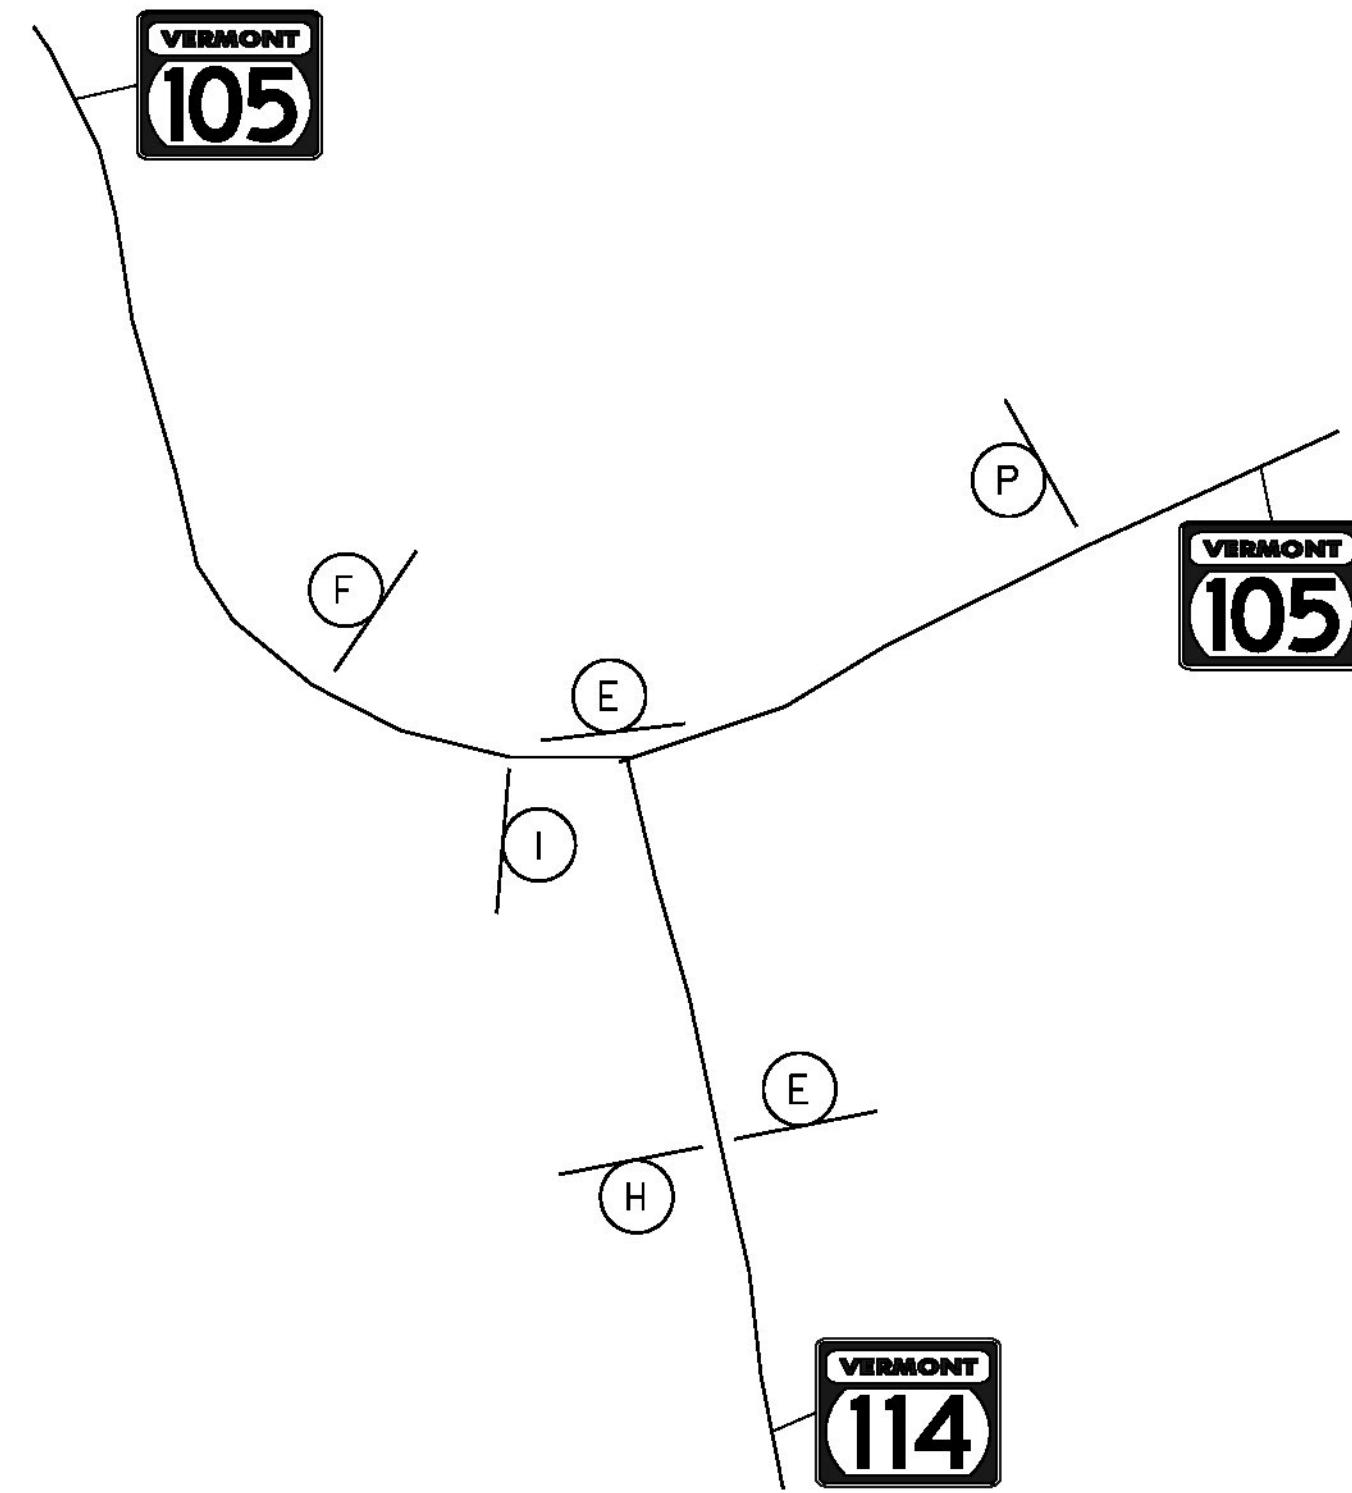


INTERSECTION 5
VT 105 AND VT 114

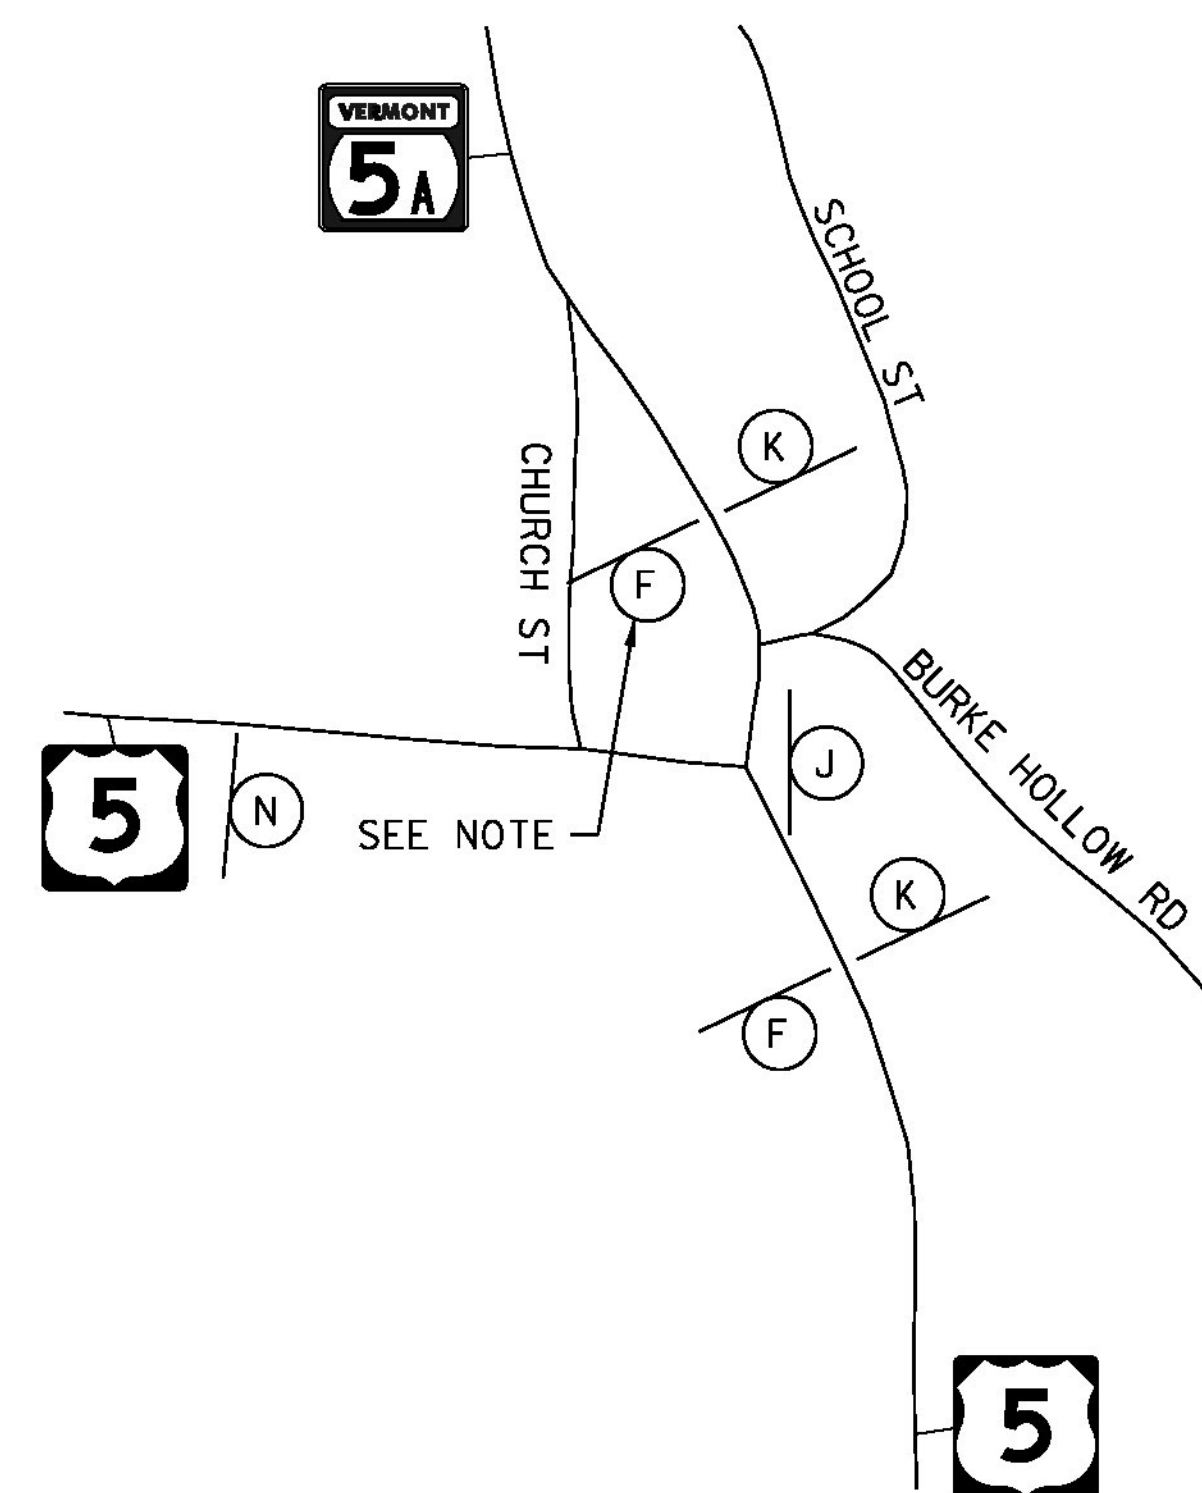

INTERSECTION 6
US 5 AND VT 5A

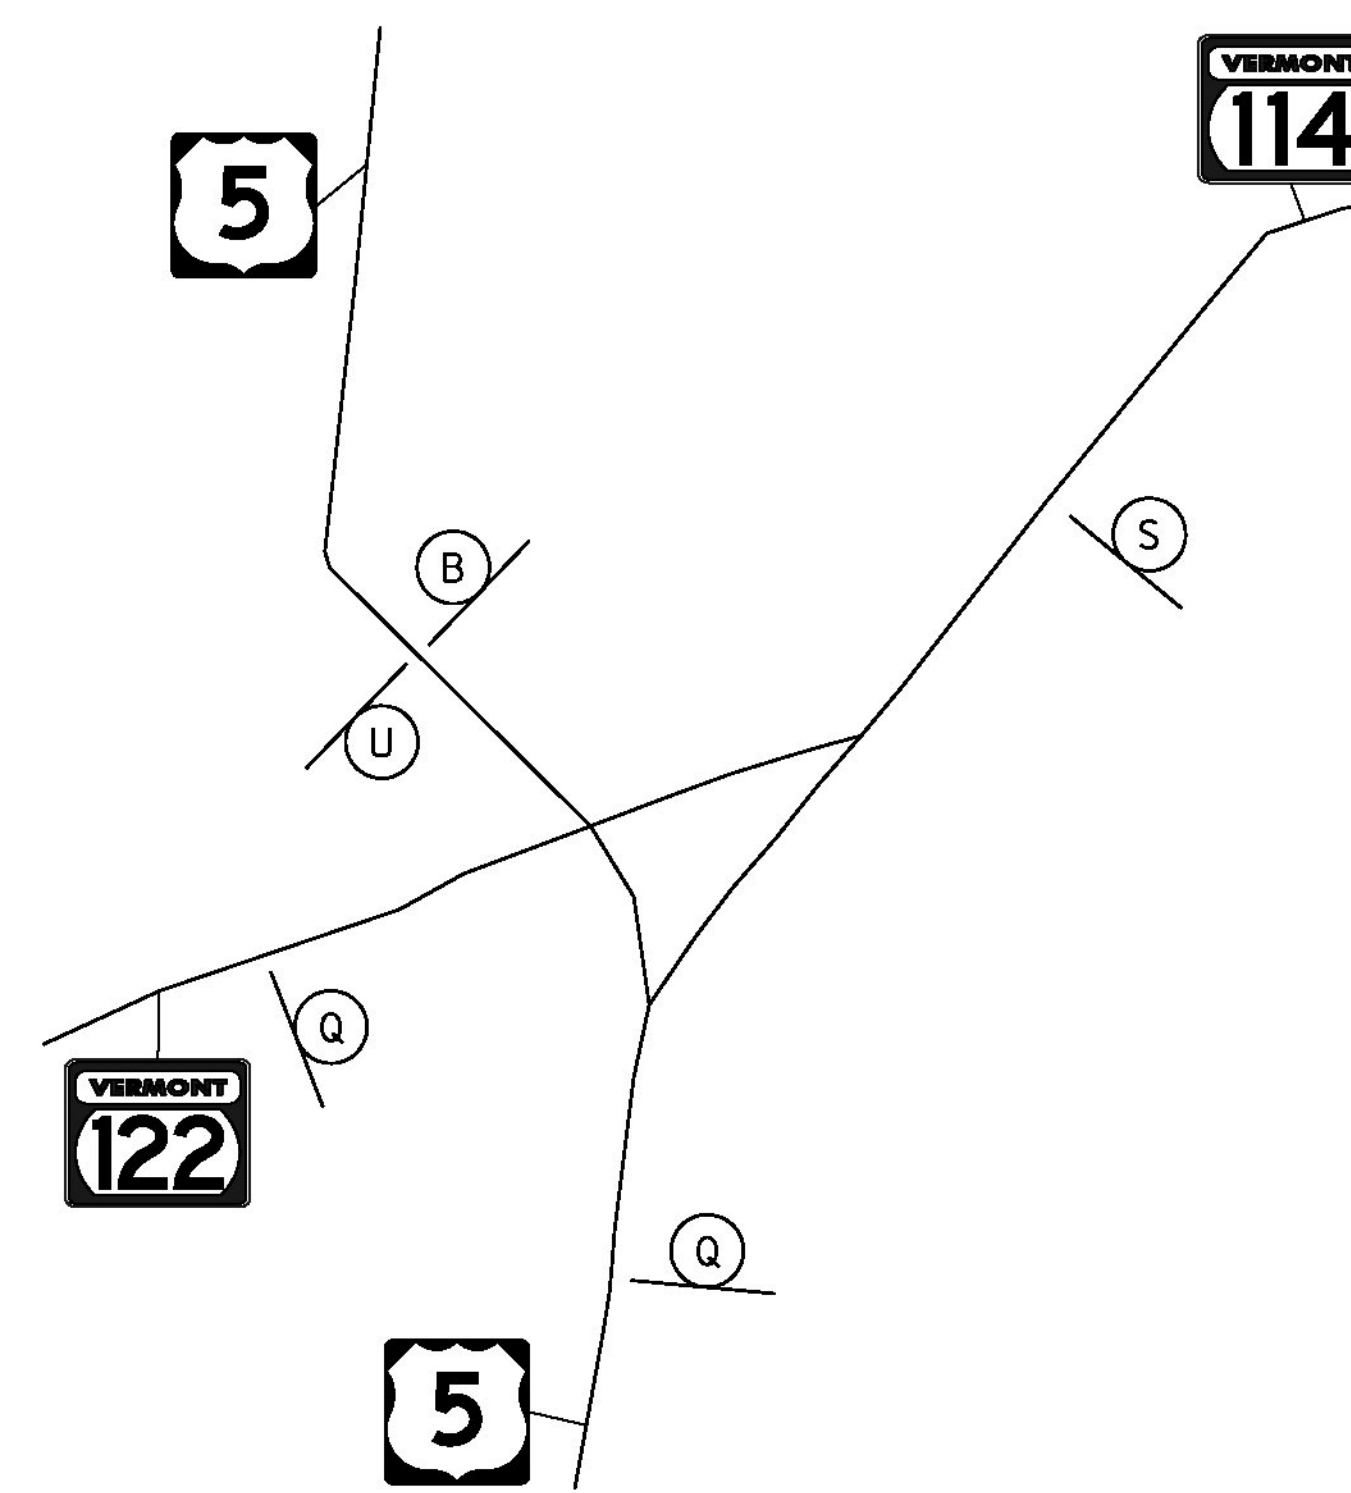

INTERSECTION 7
US 5 AND VT 114

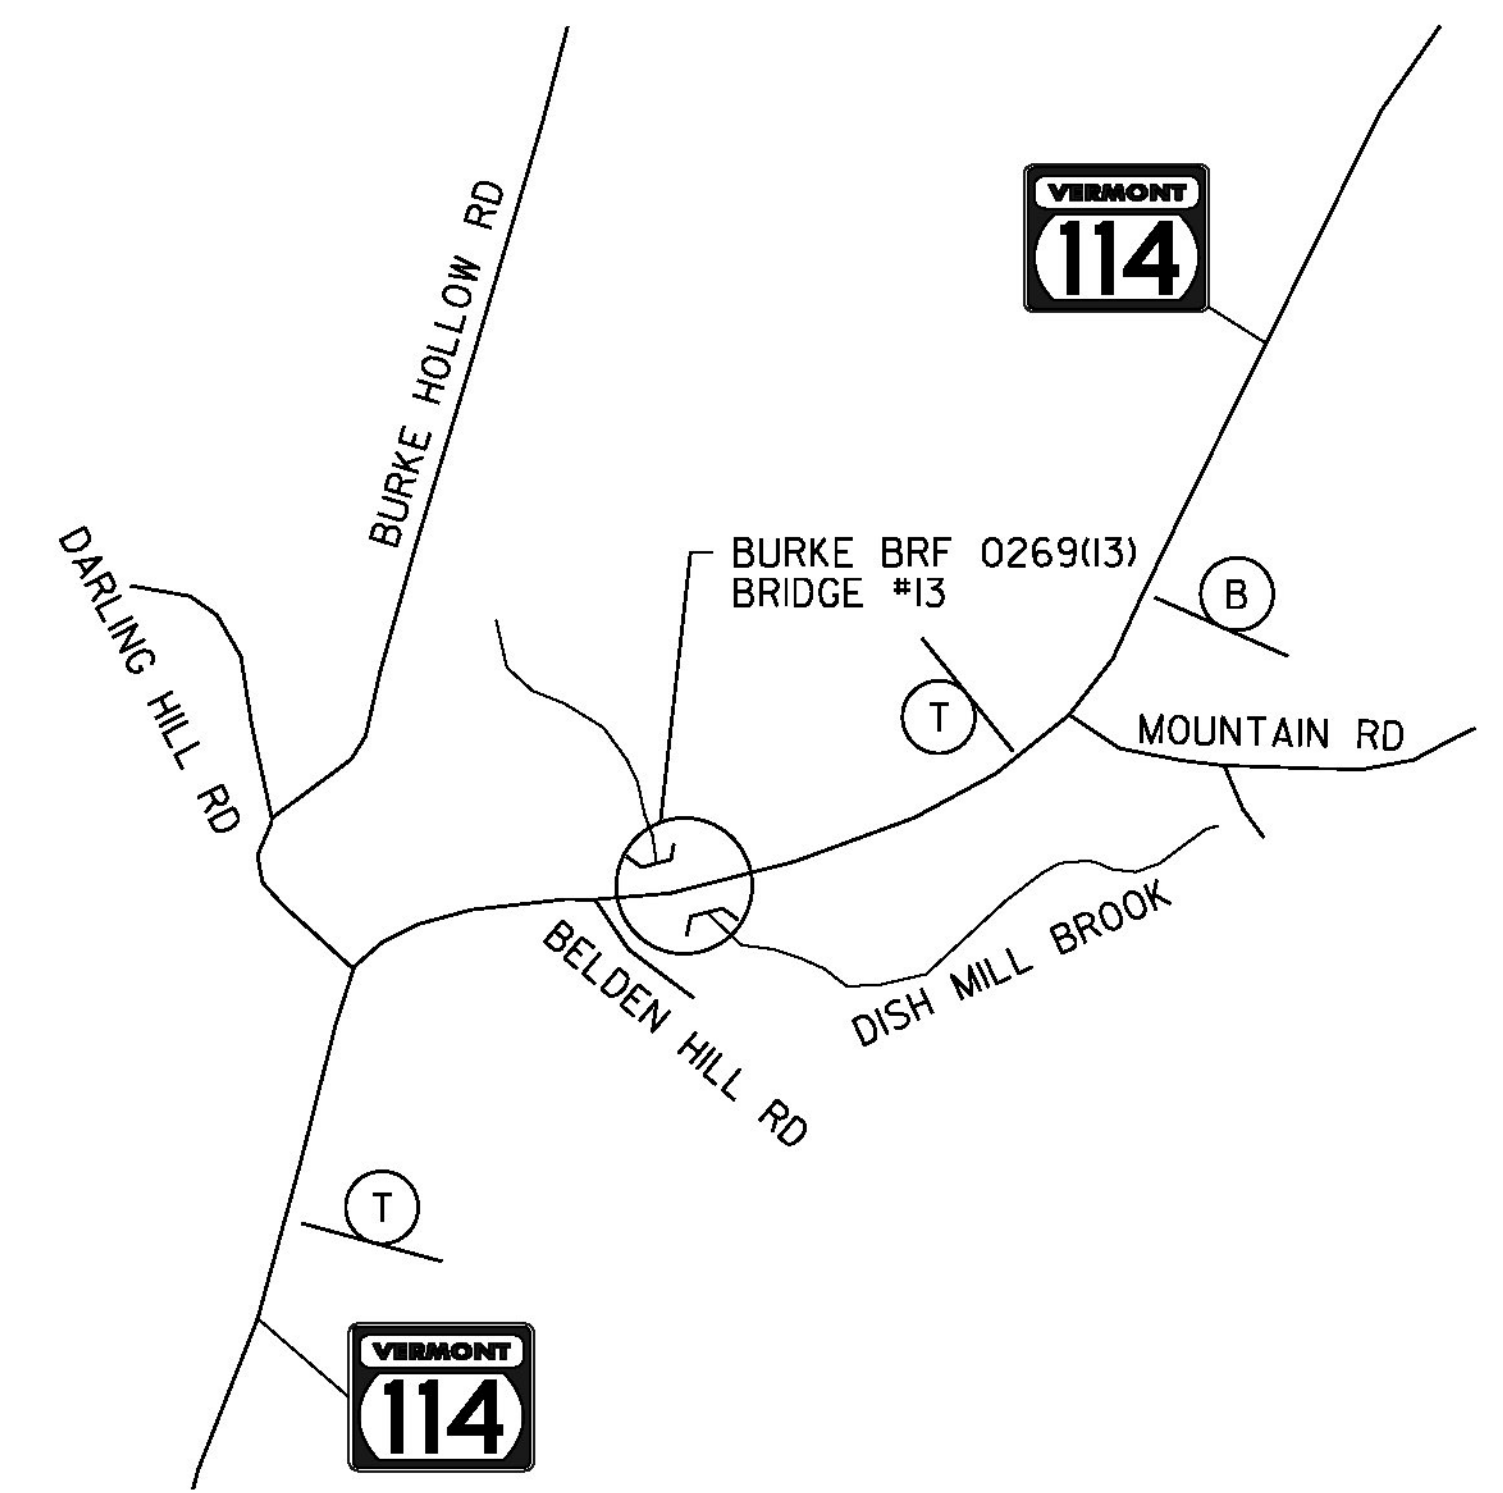

INTERSECTION 8
VT 114 AND MOUNTAIN ROAD

NOTE
CONTRACTOR TO COVER EXISTING DIRECTIONAL SIGN
TO EAST BURKE AT THIS LOCATION

CLD 12-0121 MODEL: L02



PROJECT NAME: BURKE
PROJECT NUMBER: BRF 0269(13)

FILE NAME: I0c412/cos/z10c412regdtr.dgn PLOT DATE: 10/14/2014
PROJECT LEADER: J. BYATT DRAWN BY: W. GORDON
DESIGNED BY: M. HALEY CHECKED BY: P. SHEDD
DETOUR DETAILS SHEET 22 OF 73