



RAIL LAYOUT PLAN  
SCALE: 1" = 10'-0"

NOTES:

- I. SEE STANDARDS G-1b AND BRIDGE AND APPROACH RAIL DETAIL SHEETS 51 THROUGH 55.

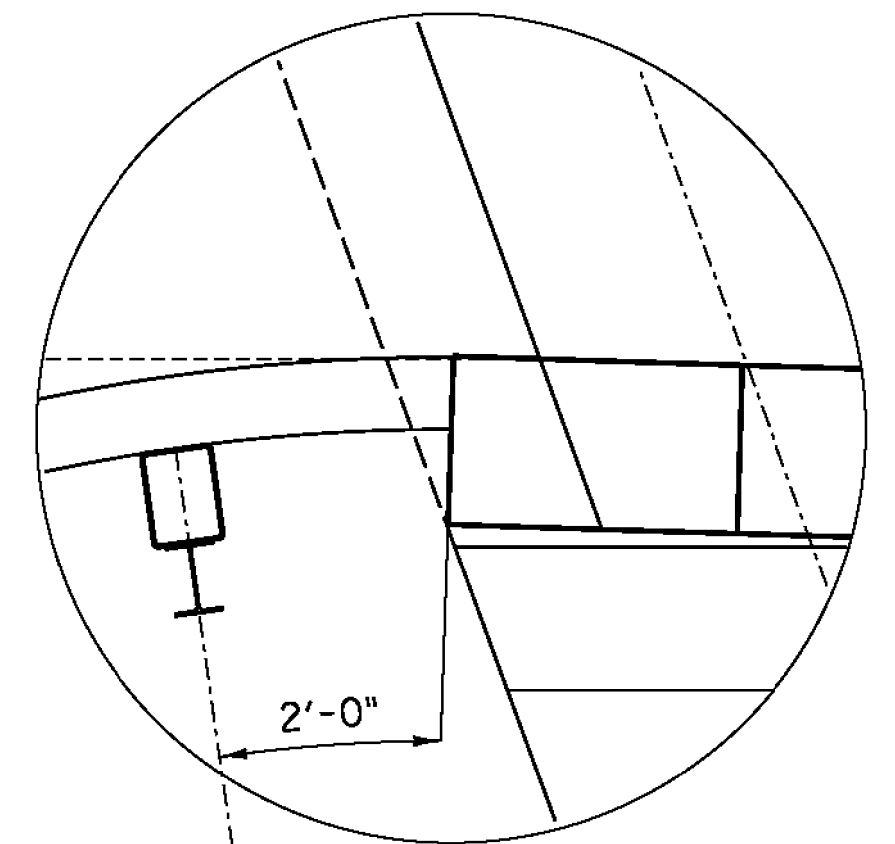

DETAIL "A"  
SCALE: 1/2" = 1'-0"

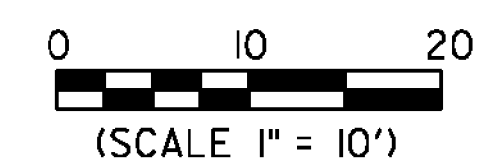

PROJECT NAME: BURKE	PLOT DATE: 10/14/2014
PROJECT NUMBER: BRF 0269(13)	DRAWN BY: M. SMITH
FILE NAME: 10c412/cos/z10c412rall.dgn	CHECKED BY: J. BYATT
PROJECT LEADER: J. BYATT	DESIGNED BY: S. BEAUMONT
RAIL LAYOUT SHEET	SHEET 50 OF 73

MODEL: Rdl100  
C.L.D. 12-0121 z10c412rall.dgn