


THE COST OF THIS POST TO BE INCLUDED IN THE UNIT PRICE BID FOR GUARDRAIL APPROACH SECTION

\* SEE STD. G1-B FOR POST CONNECTION DETAILS

APPROACH RAIL PLAN  
NOT TO SCALE

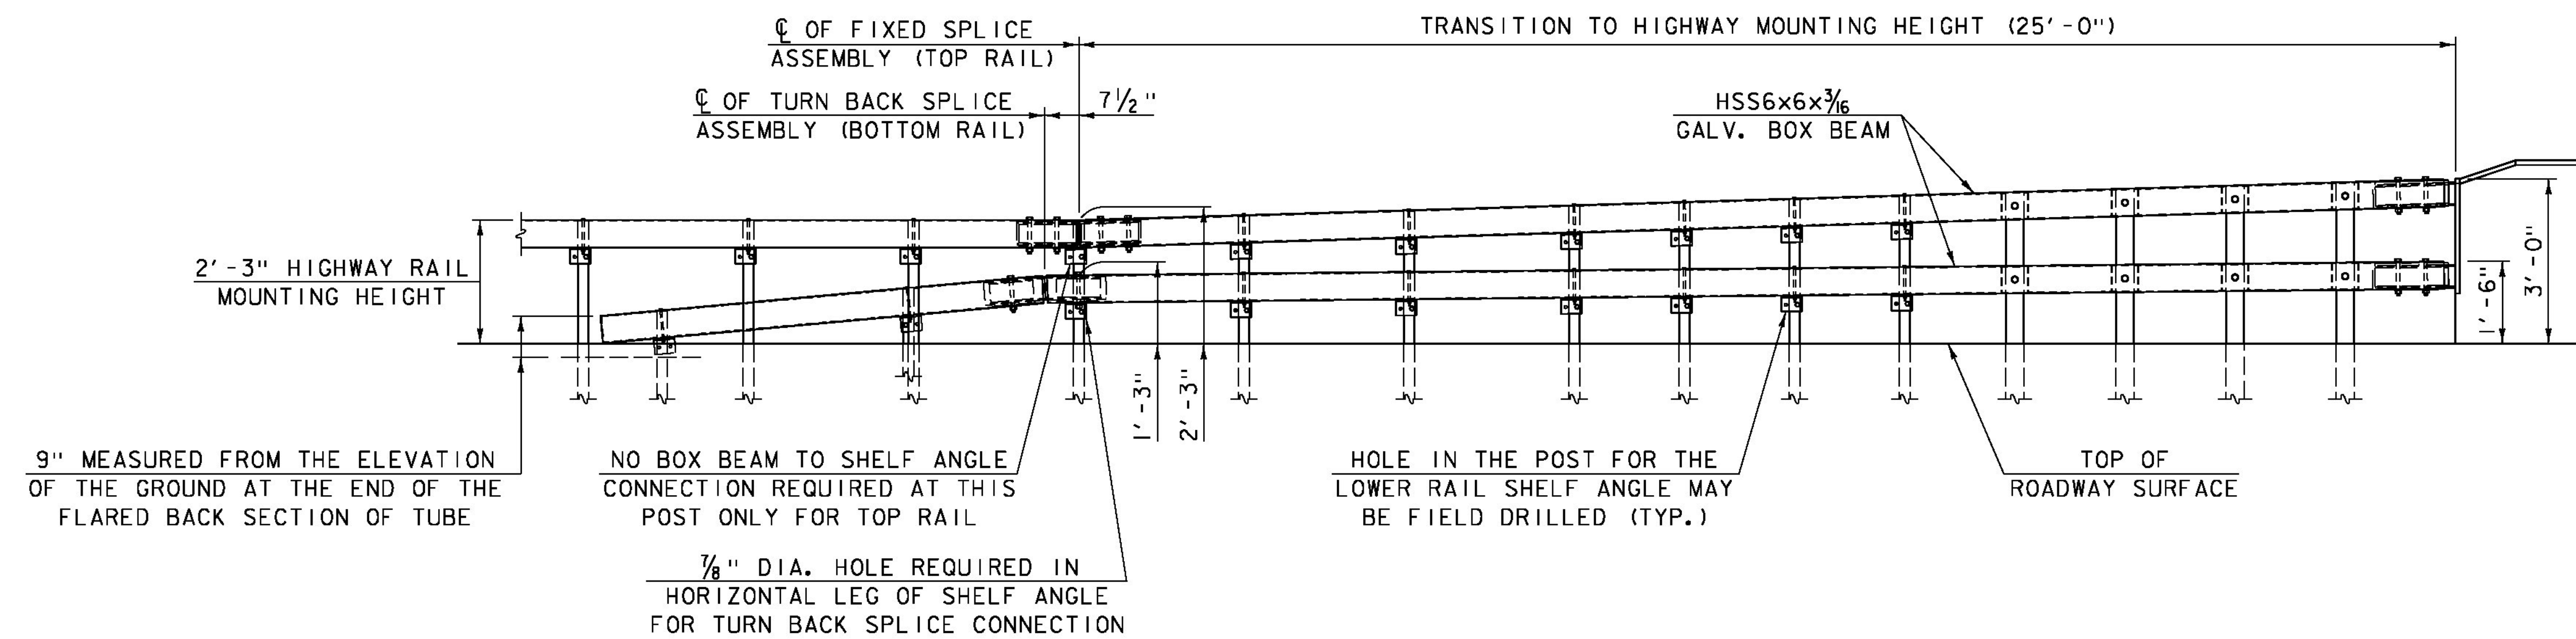

APPROACH RAIL ELEVATION  
NOT TO SCALE

CLD 12-0121 MODEL-Rgt102

PROJECT NAME: BURKE	PLOT DATE: 10/14/2014
PROJECT NUMBER: BRF 0269(13)	DRAWN BY: M. SMITH
FILE NAME: z10c412rall.dgn	CHECKED BY: J. BYATT
PROJECT LEADER: J. BYATT	SHEET 52 OF 73
DESIGNED BY: S. BEAUMONT	
APPROACH RAIL DETAILS (1 OF 4)	

