




CLD 12-0121 MODEL: XSO1

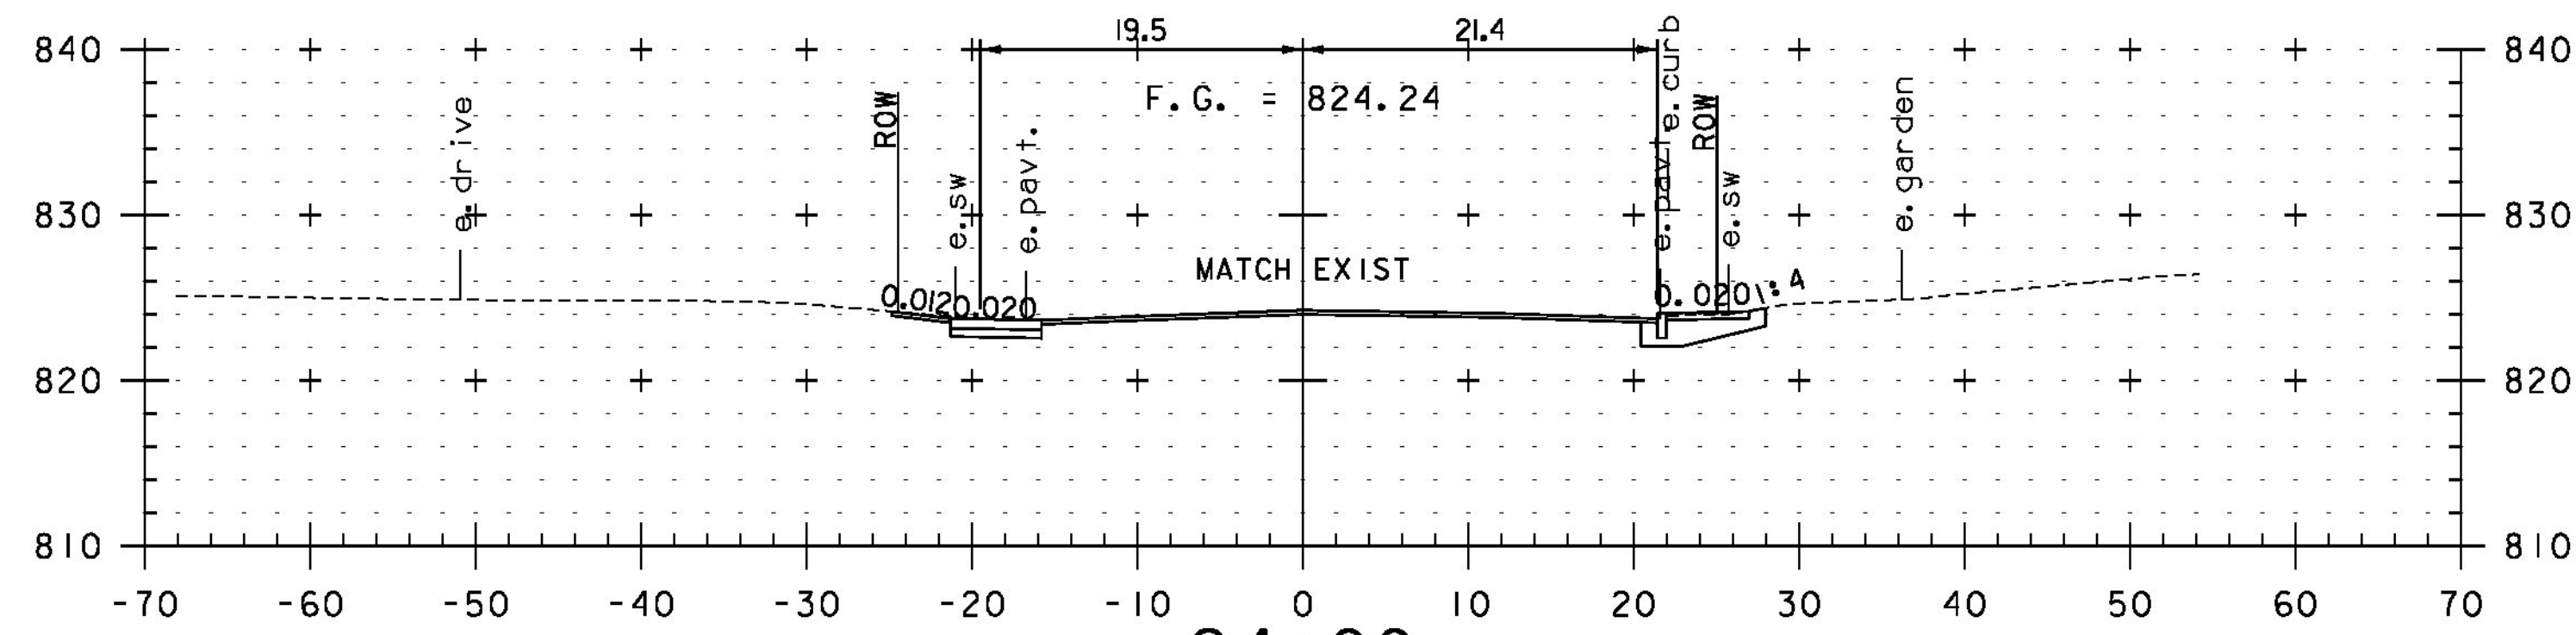


24+00
DRIVE LT
BEGIN APPROACH

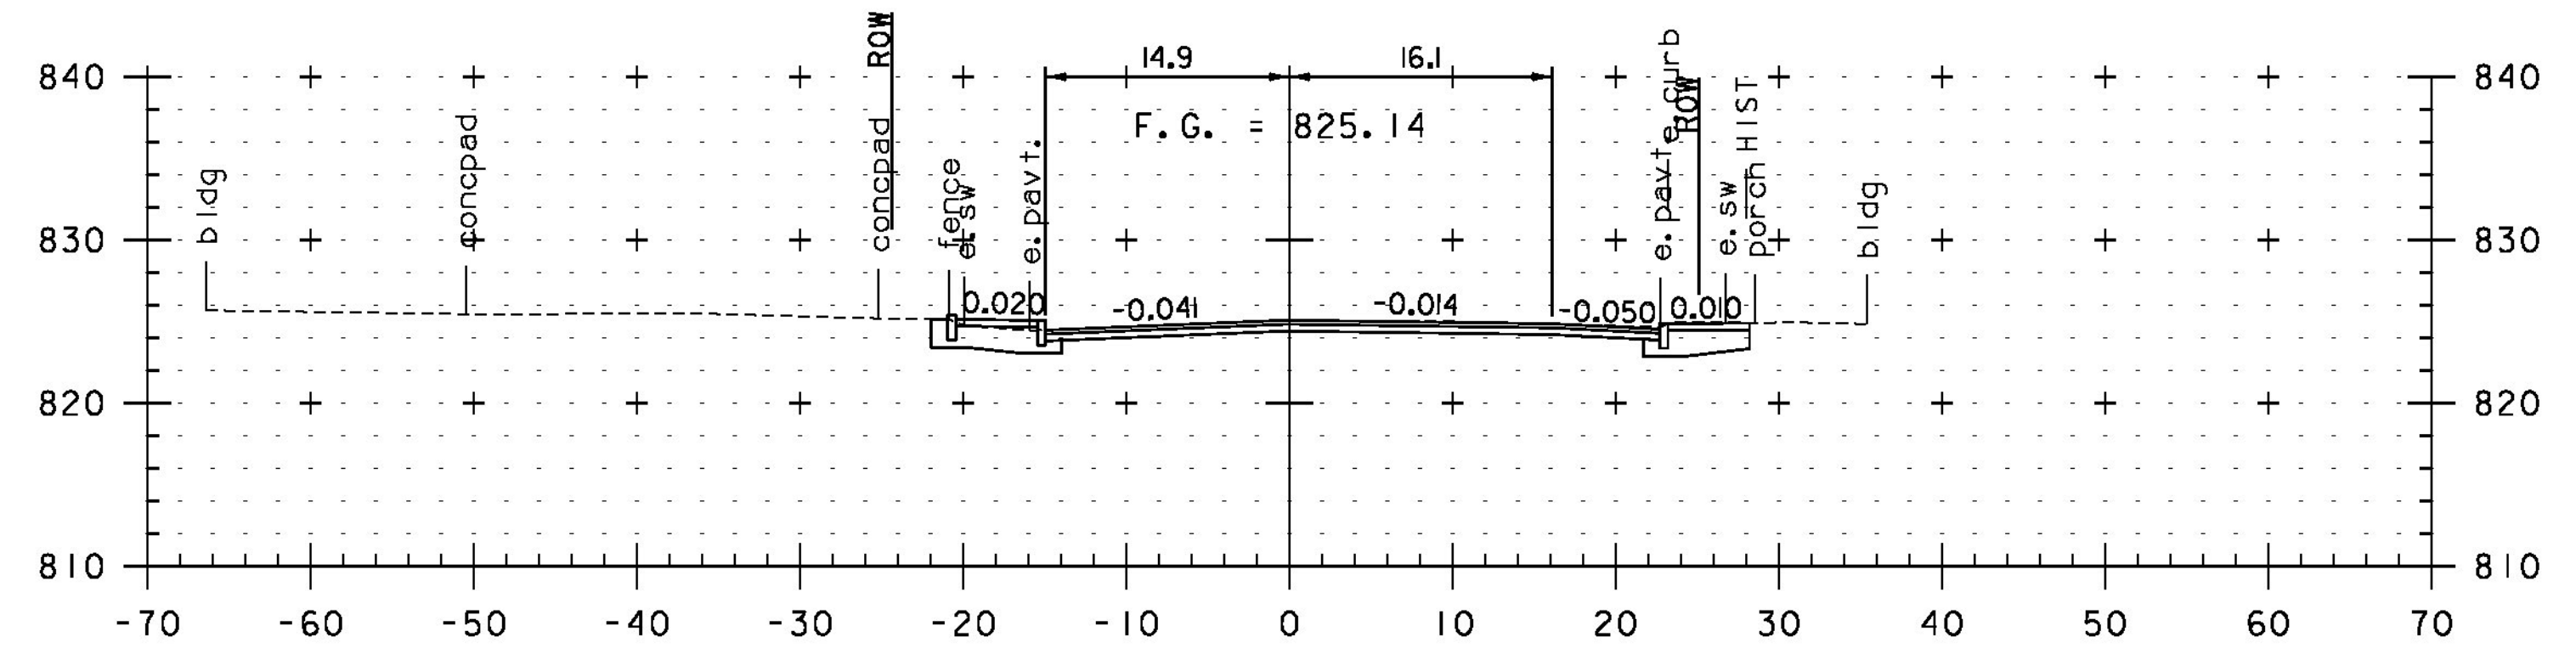


24+50

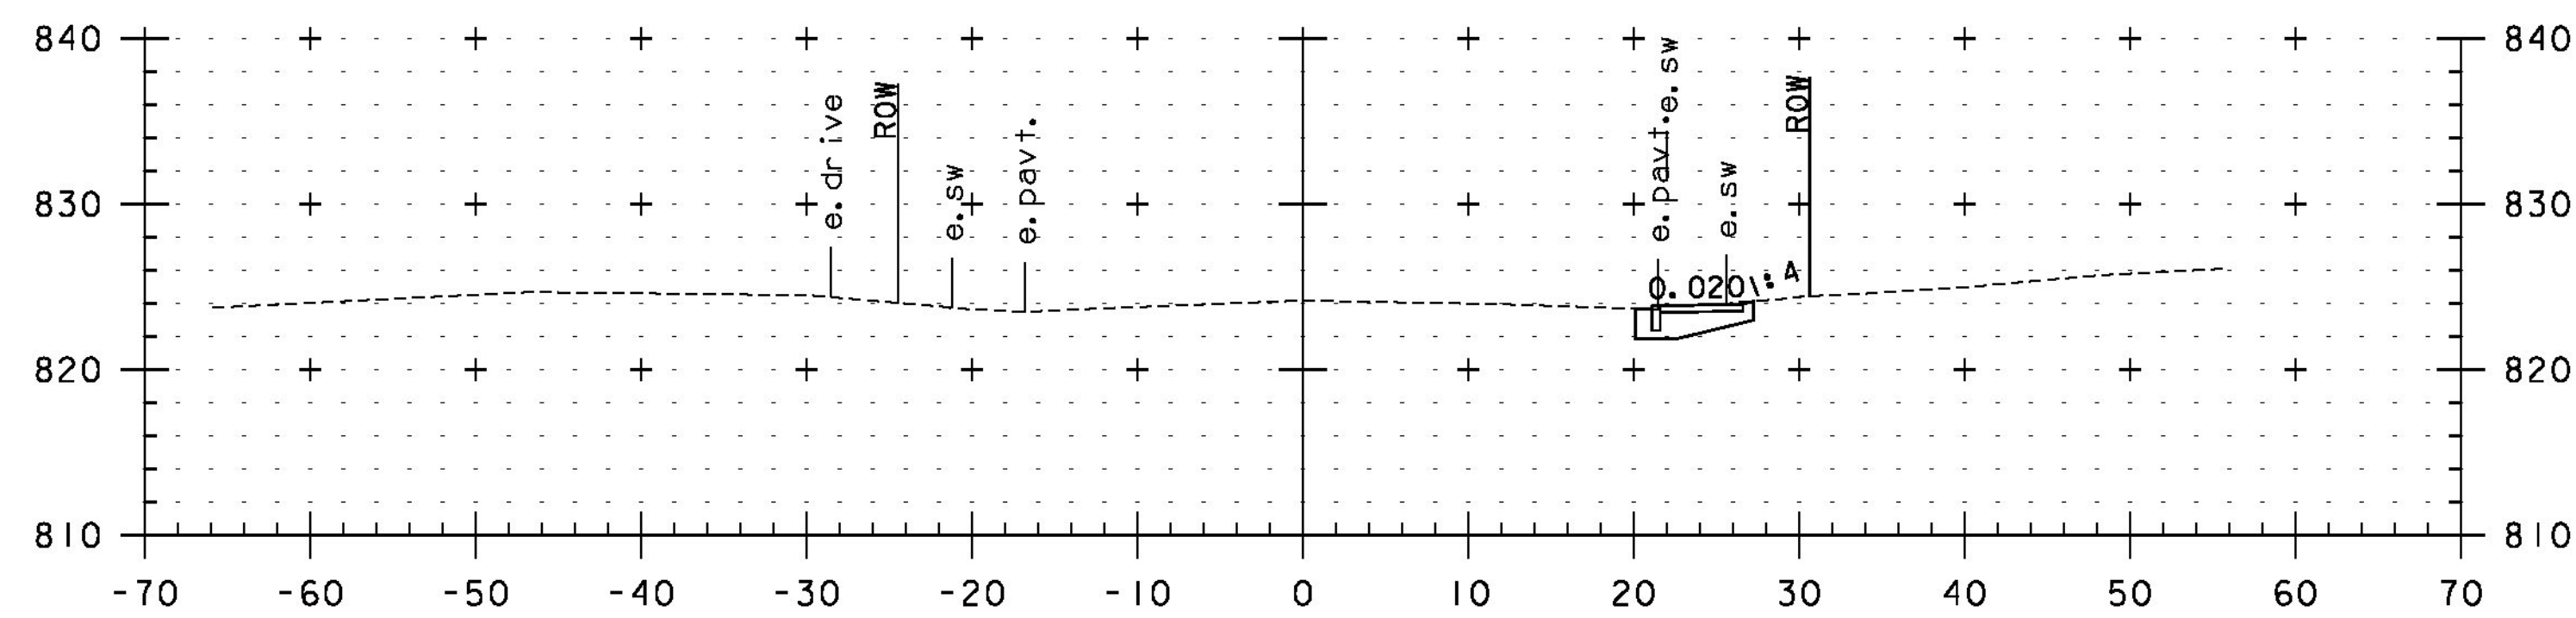


23+95
BEGIN SIDEWALK

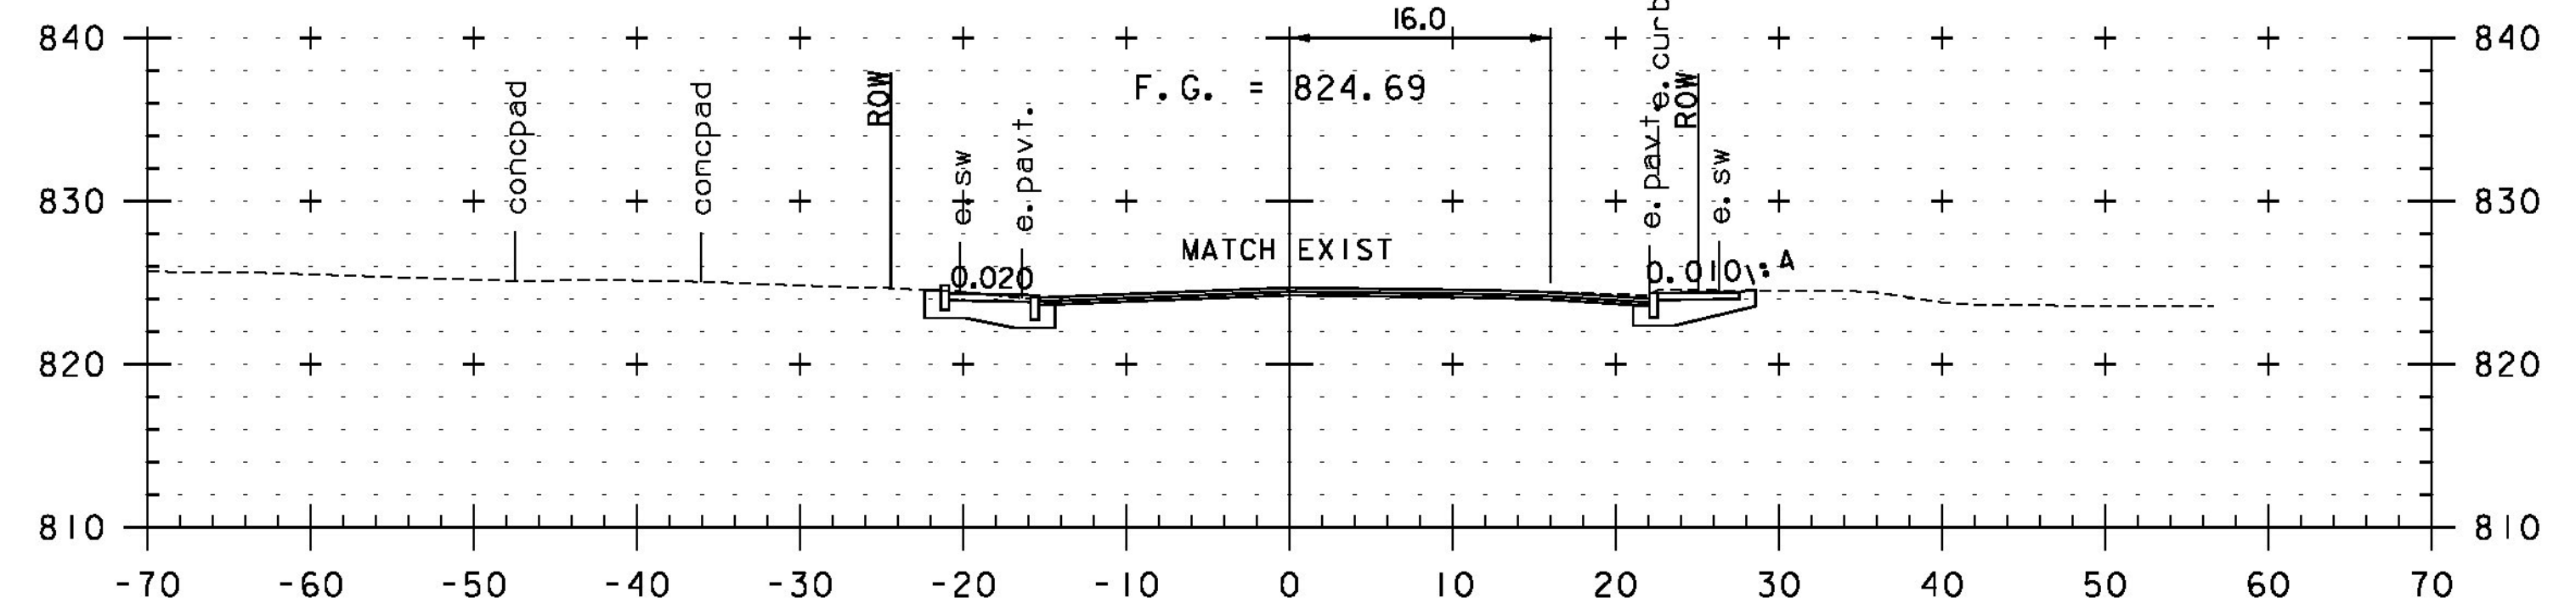

24+25

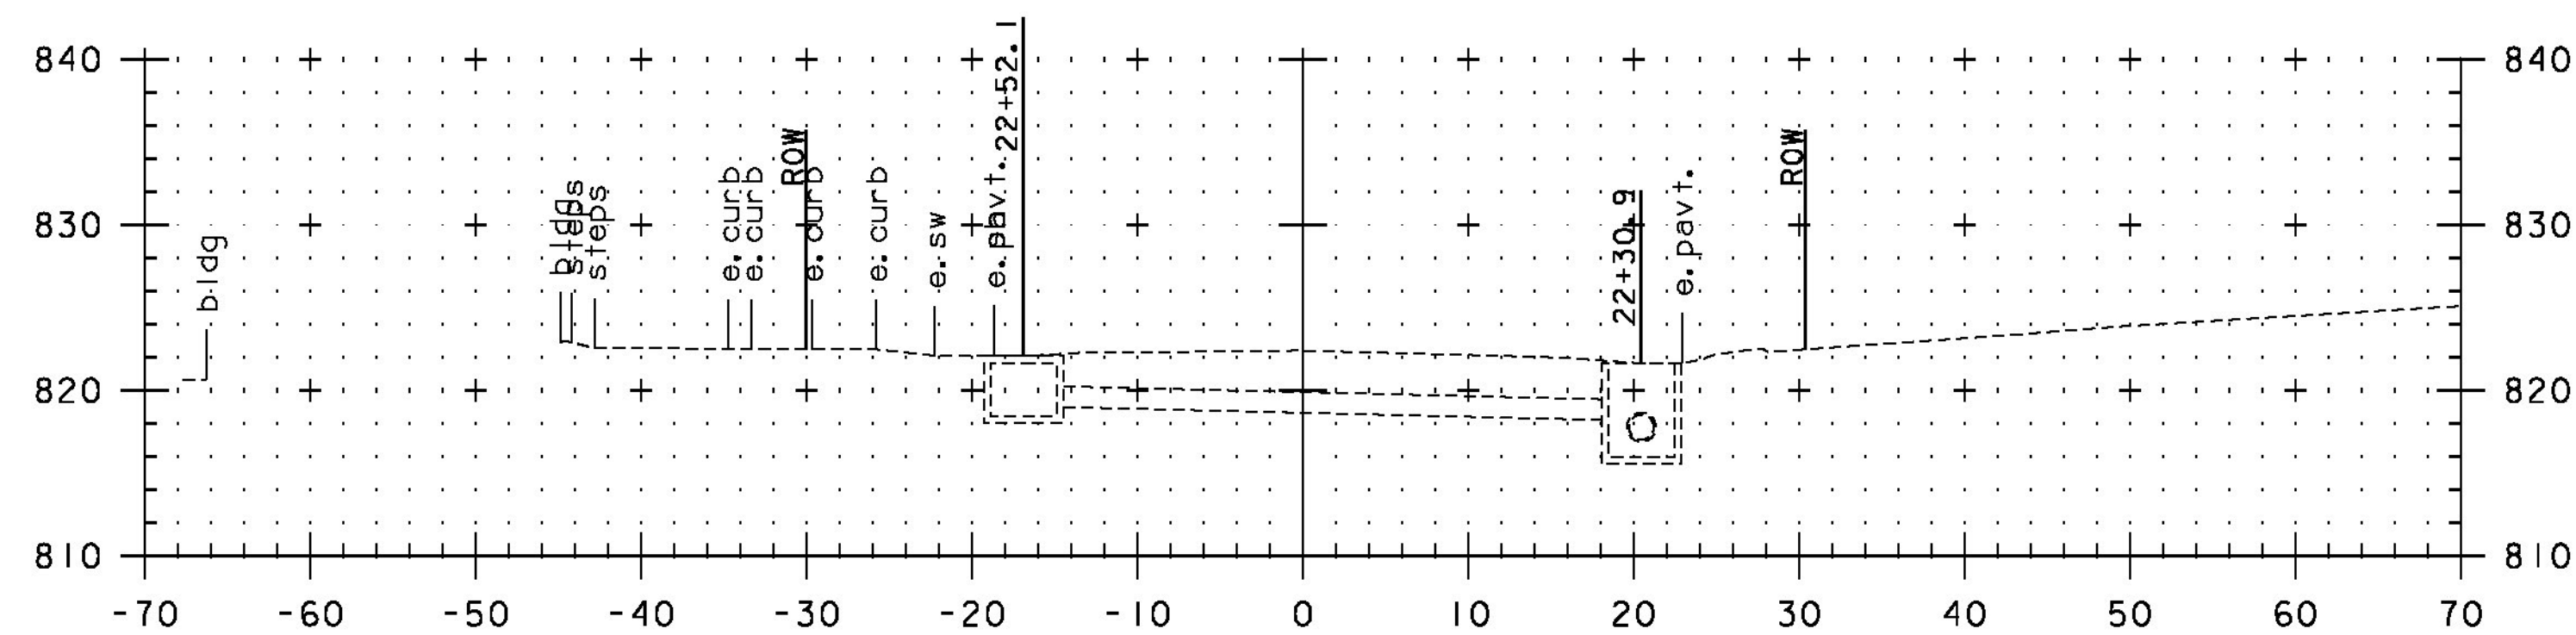


22+43
ASKEW

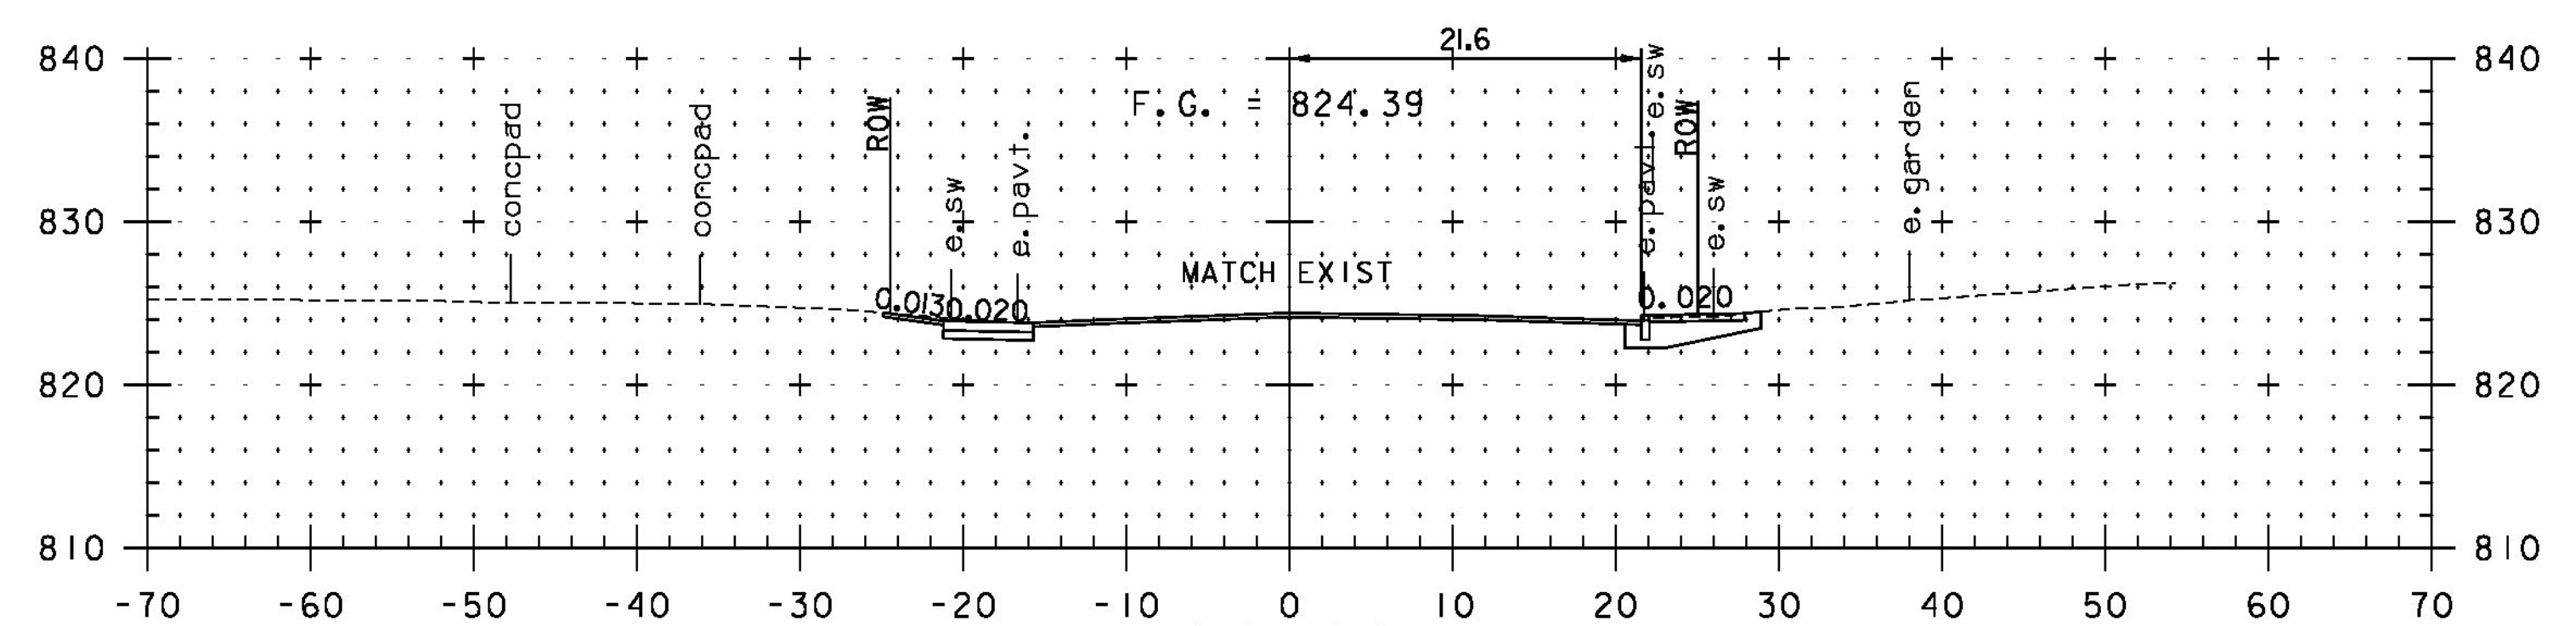

24+06
WALKWAY RT

STA. 22+43 TO STA. 24+50

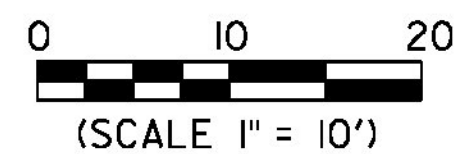

PROJECT NAME: BURKE
 PROJECT NUMBER: BRF 0269(13)

FILE NAME: I0c412/cos/z10c412xsl.dgn
 PROJECT LEADER: J. BYATT
 DESIGNED BY: M. HALEY
 VT #4 CROSS SECTIONS I

PLOT DATE: 10/14/2014
 DRAWN BY: M. HALEY
 CHECKED BY: P. SHEDD
 SHEET 57 OF 73