


STA. 25+50 TO STA. 26+75

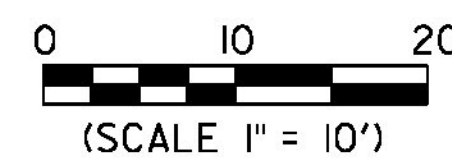

PROJECT NAME: BURKE
PROJECT NUMBER: BRF 0269(13)

FILE NAME: I0c412/cos/z10c412xsl.dgn
PROJECT LEADER: J. BYATT
DESIGNED BY: M. HALEY
VT 114 CROSS SECTIONS 3

PLOT DATE: 10/14/2014
DRAWN BY: M. HALEY
CHECKED BY: P. SHEDD
SHEET 59 OF 73