


CLD 12-0121 MODEL: XS04

STA. 27+00 TO STA. 28+00

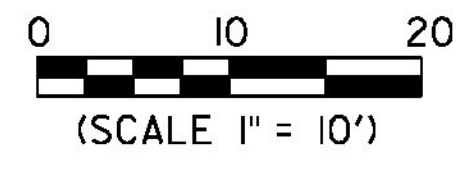

PROJECT NAME:	BURKE	FILE NAME:	I0c412/cos/z10c412xsl.dgn	PLOT DATE:	10/14/2014
PROJECT NUMBER:	BRF 0269(13)	PROJECT LEADER:	J. BYATT	DRAWN BY:	M. HALEY
		DESIGNED BY:	M. HALEY	CHECKED BY:	P. SHEDD
		VT 114 CROSS SECTIONS 4		SHEET	60 OF 73