


STA. 0+00 TO STA. 0+70

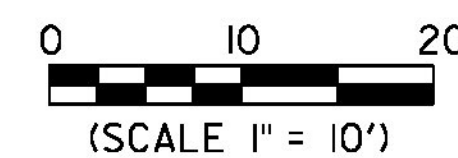

PROJECT NAME:	BURKE	PLOT DATE:	10/14/2014
PROJECT NUMBER:	BRF 0269(13)	DRAWN BY:	M. HALEY
FILE NAME:	I0c412/cos/z10c412xslth52.dgn	CHECKED BY:	P. SHEDD
PROJECT LEADER:	J. BYATT	TH 52 CROSS SECTIONS I	SHEET 61 OF 73
DESIGNED BY:	M. HALEY		