


STA. 0+75 TO STA. 1+50

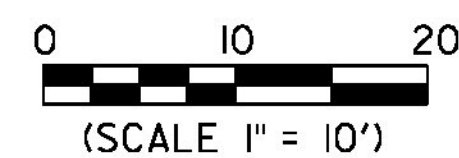

PROJECT NAME: BURKE
PROJECT NUMBER: BRF 0269(13)

FILE NAME: I0c412/cos/z10c412xslth52.dgn PLOT DATE: 10/14/2014
PROJECT LEADER: J. BYATT DRAWN BY: M. HALEY
DESIGNED BY: M. HALEY CHECKED BY: P. SHEDD
TH 52 CROSS SECTIONS 2 SHEET 62 OF 73