



10+40

STA. 10+31 RT
 BEGIN UNCLASSIFIED CHANNEL EXCAVATION
 STONE FILL, TYPE III
 GEOTEXTILE UNDER STONE FILL
 GRUBBING MATERIAL

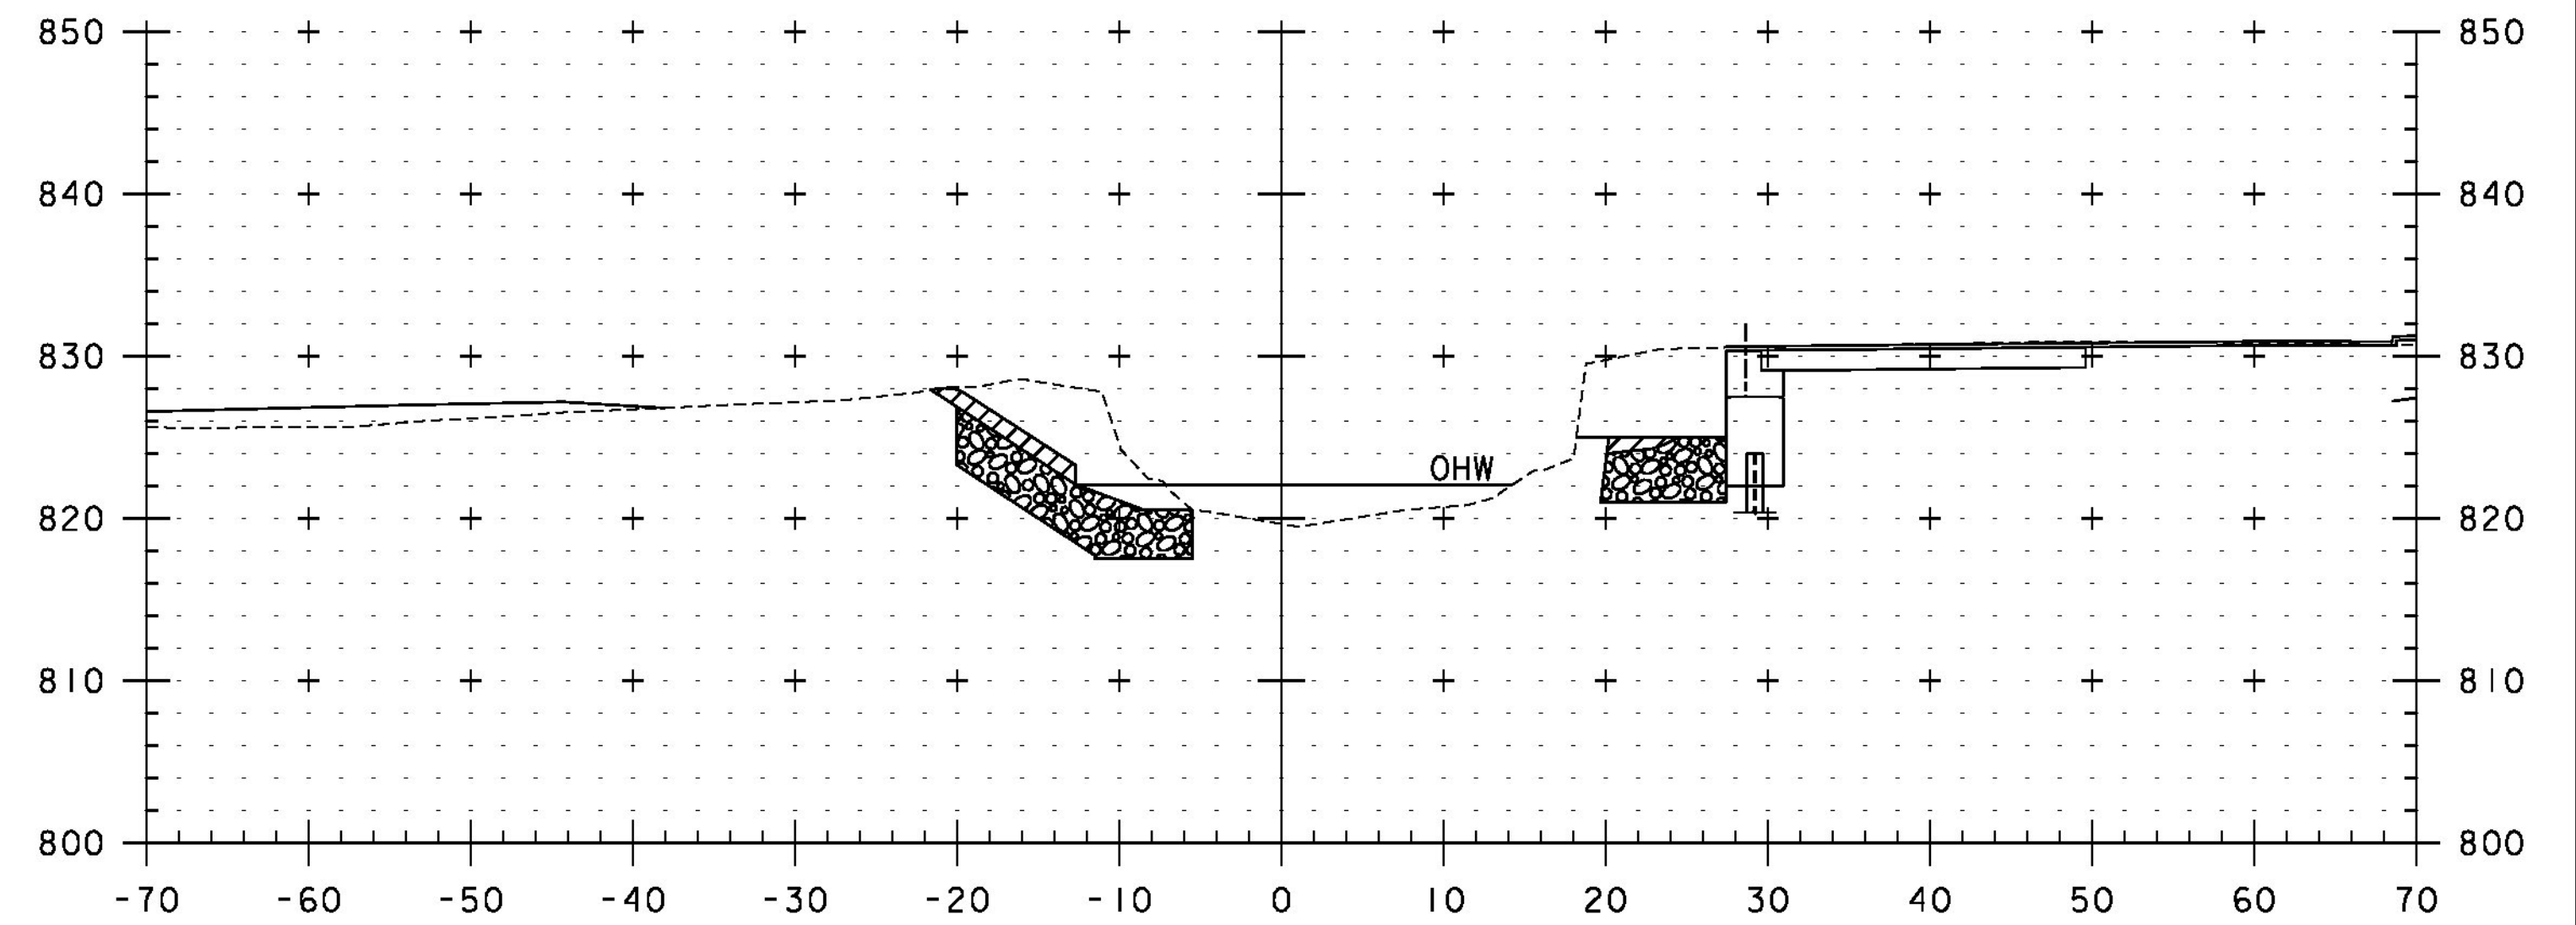


10+60

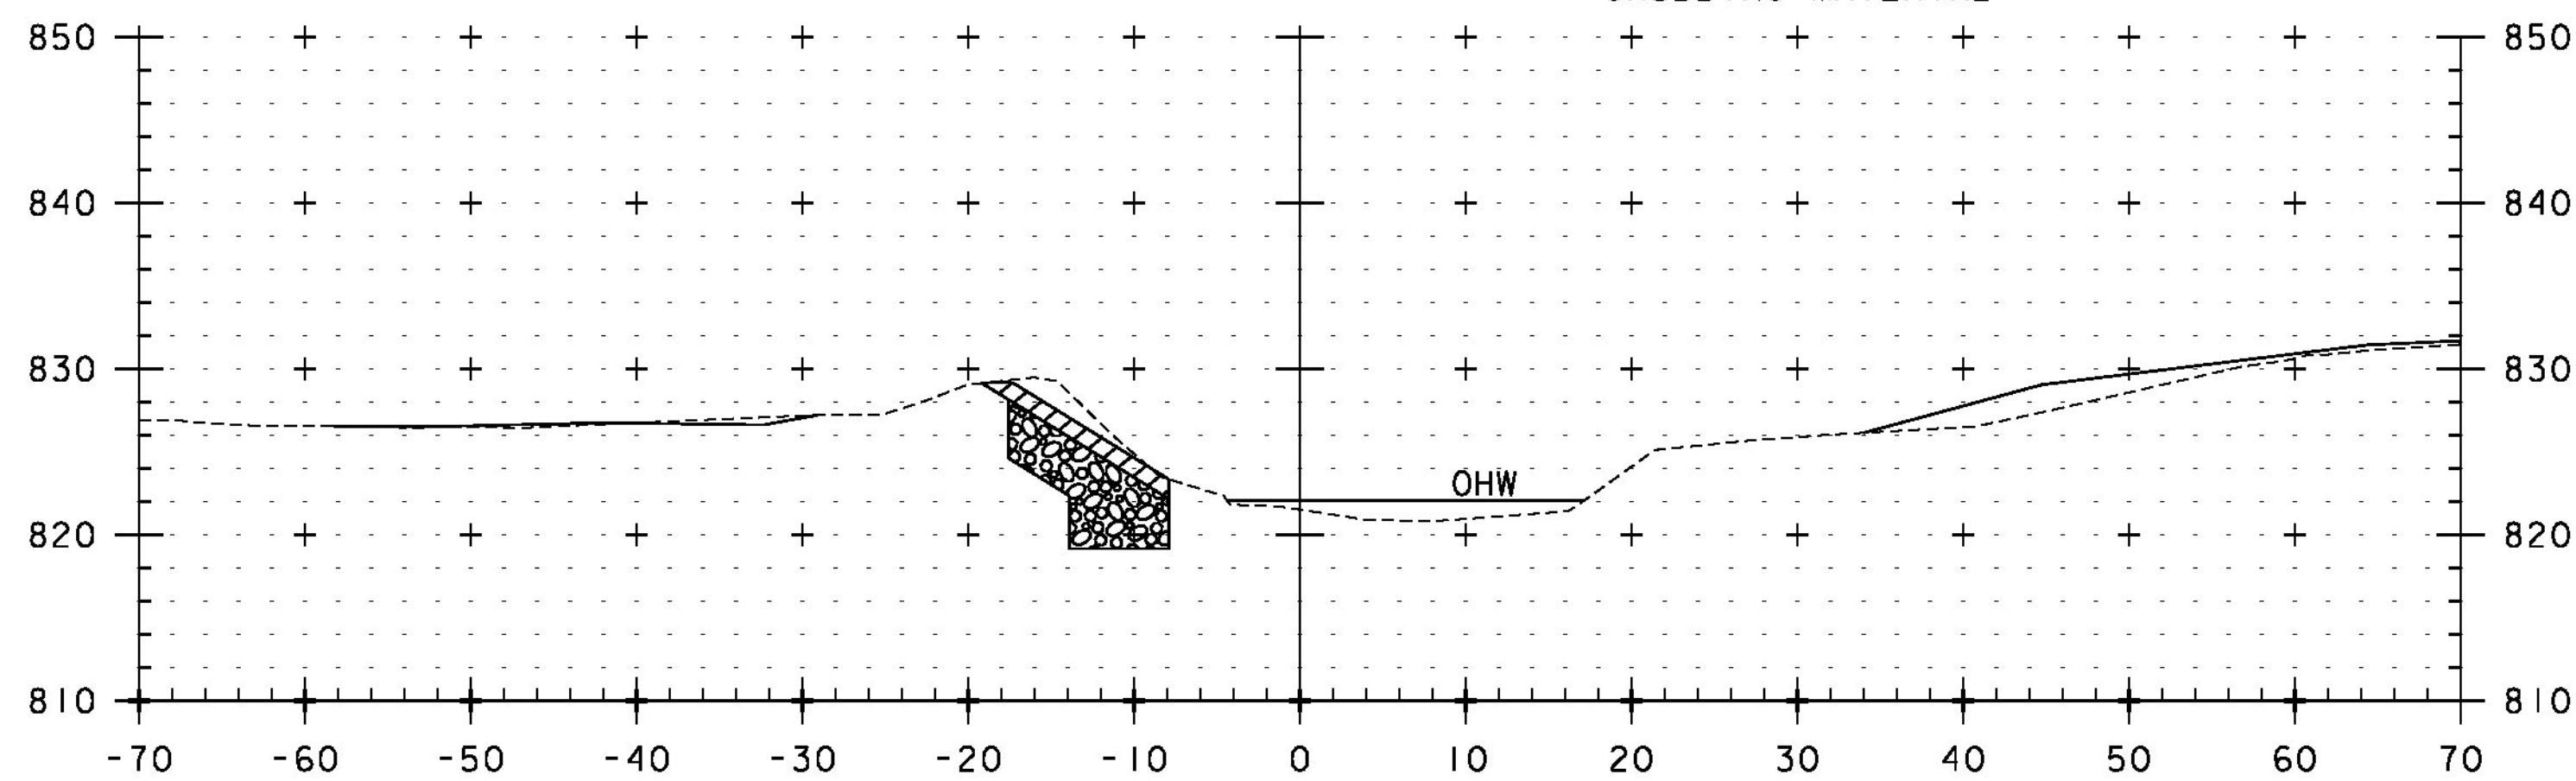


10+30

STA. 10+26 LT
 BEGIN UNCLASSIFIED CHANNEL EXCAVATION
 STONE FILL, TYPE III
 GEOTEXTILE UNDER STONE FILL
 GRUBBING MATERIAL

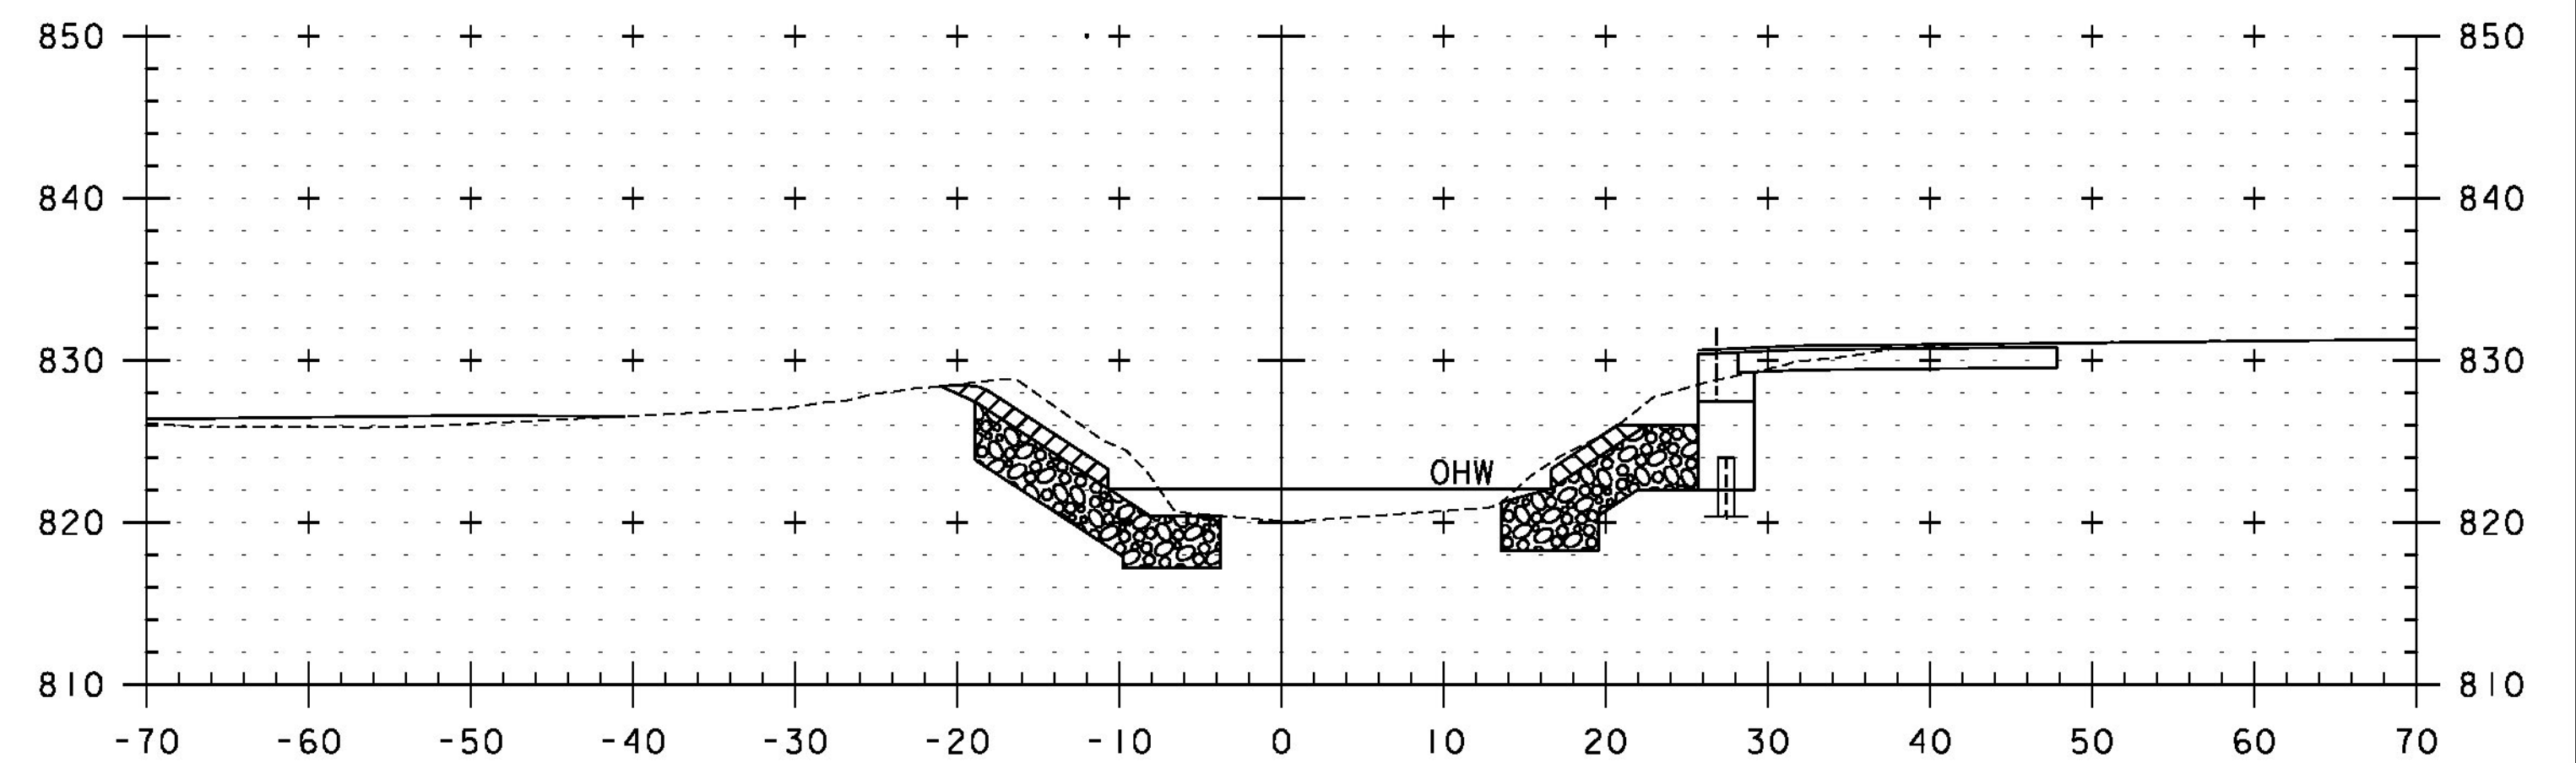

10+50

STA. 10+30 TO STA. 10+60

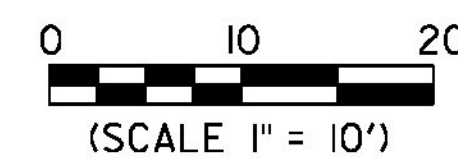

PROJECT NAME: BURKE
 PROJECT NUMBER: BRF 0269(13)

FILE NAME: I0c412/cos/z10c412xs1chan.dgn PLOT DATE: 10/14/2014
 PROJECT LEADER: J. BYATT DRAWN BY: M. SMITH
 DESIGNED BY: S. BEAUMONT CHECKED BY: J. BYATT
 CHANNEL CROSS SECTIONS I SHEET 63 OF 73