


STA. 10+86 RT
 END UNCLASSIFIED CHANNEL EXCAVATION

STA. 10+90 RT
 END STONE FILL, TYPE III
 GEOTEXTILE UNDER STONE FILL

STA. 10+70 TO STA. 11+00

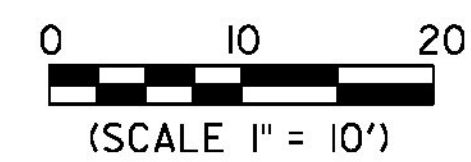

PROJECT NAME: BURKE	PLOT DATE: 10/14/2014
PROJECT NUMBER: BRF 0269(13)	DRAWN BY: M. SMITH
FILE NAME: I0c412/cos/z10c412xs1chan.dgn	CHECKED BY: J. BYATT
PROJECT LEADER: J. BYATT	SHEET 64 OF 73
DESIGNED BY: S. BEAUMONT	
CHANNEL CROSS SECTIONS 2	