

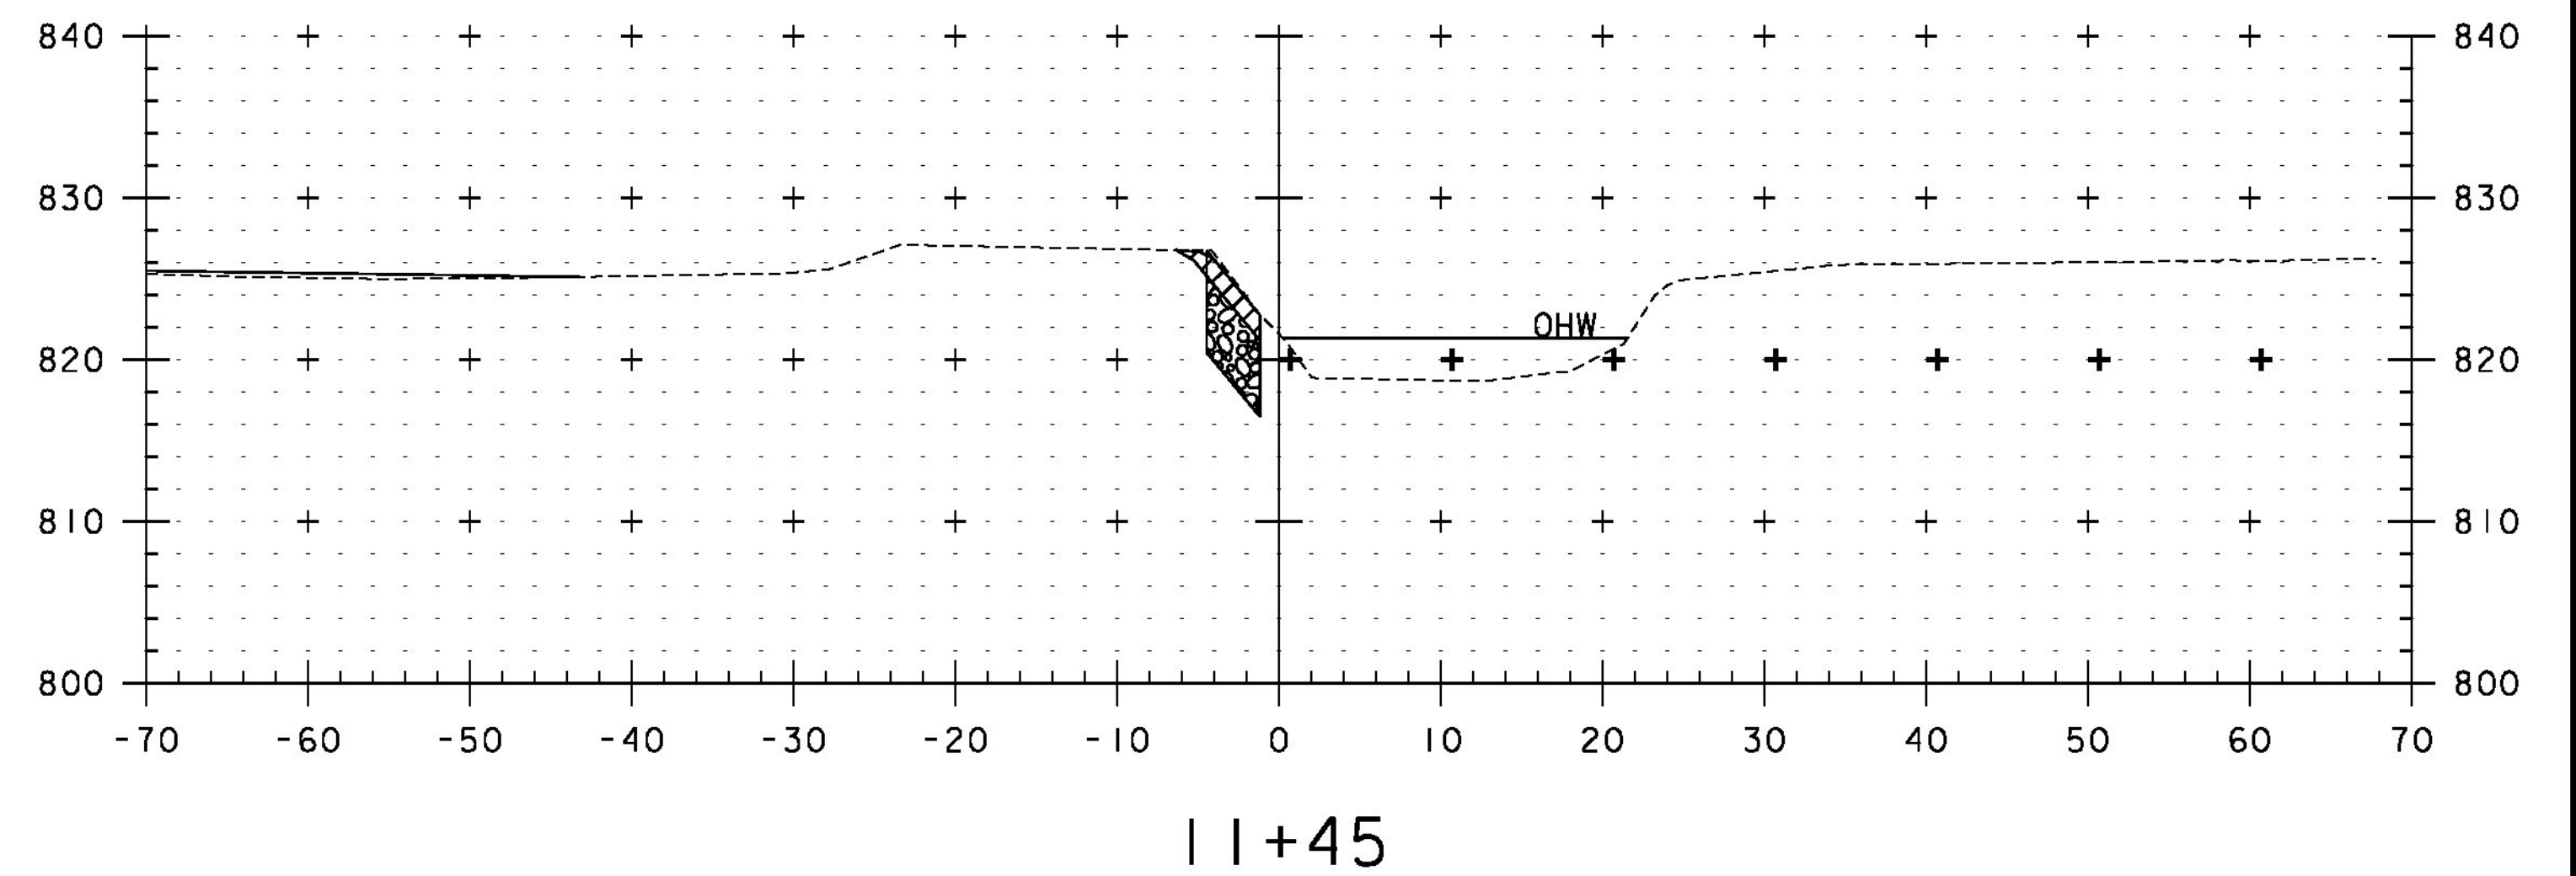


STA. 11+47 LT
 END UNCLASSIFIED CHANNEL EXCAVATION
 STONE FILL, TYPE III
 GEOTEXTILE UNDER STONE FILL
 GRUBBING MATERIAL

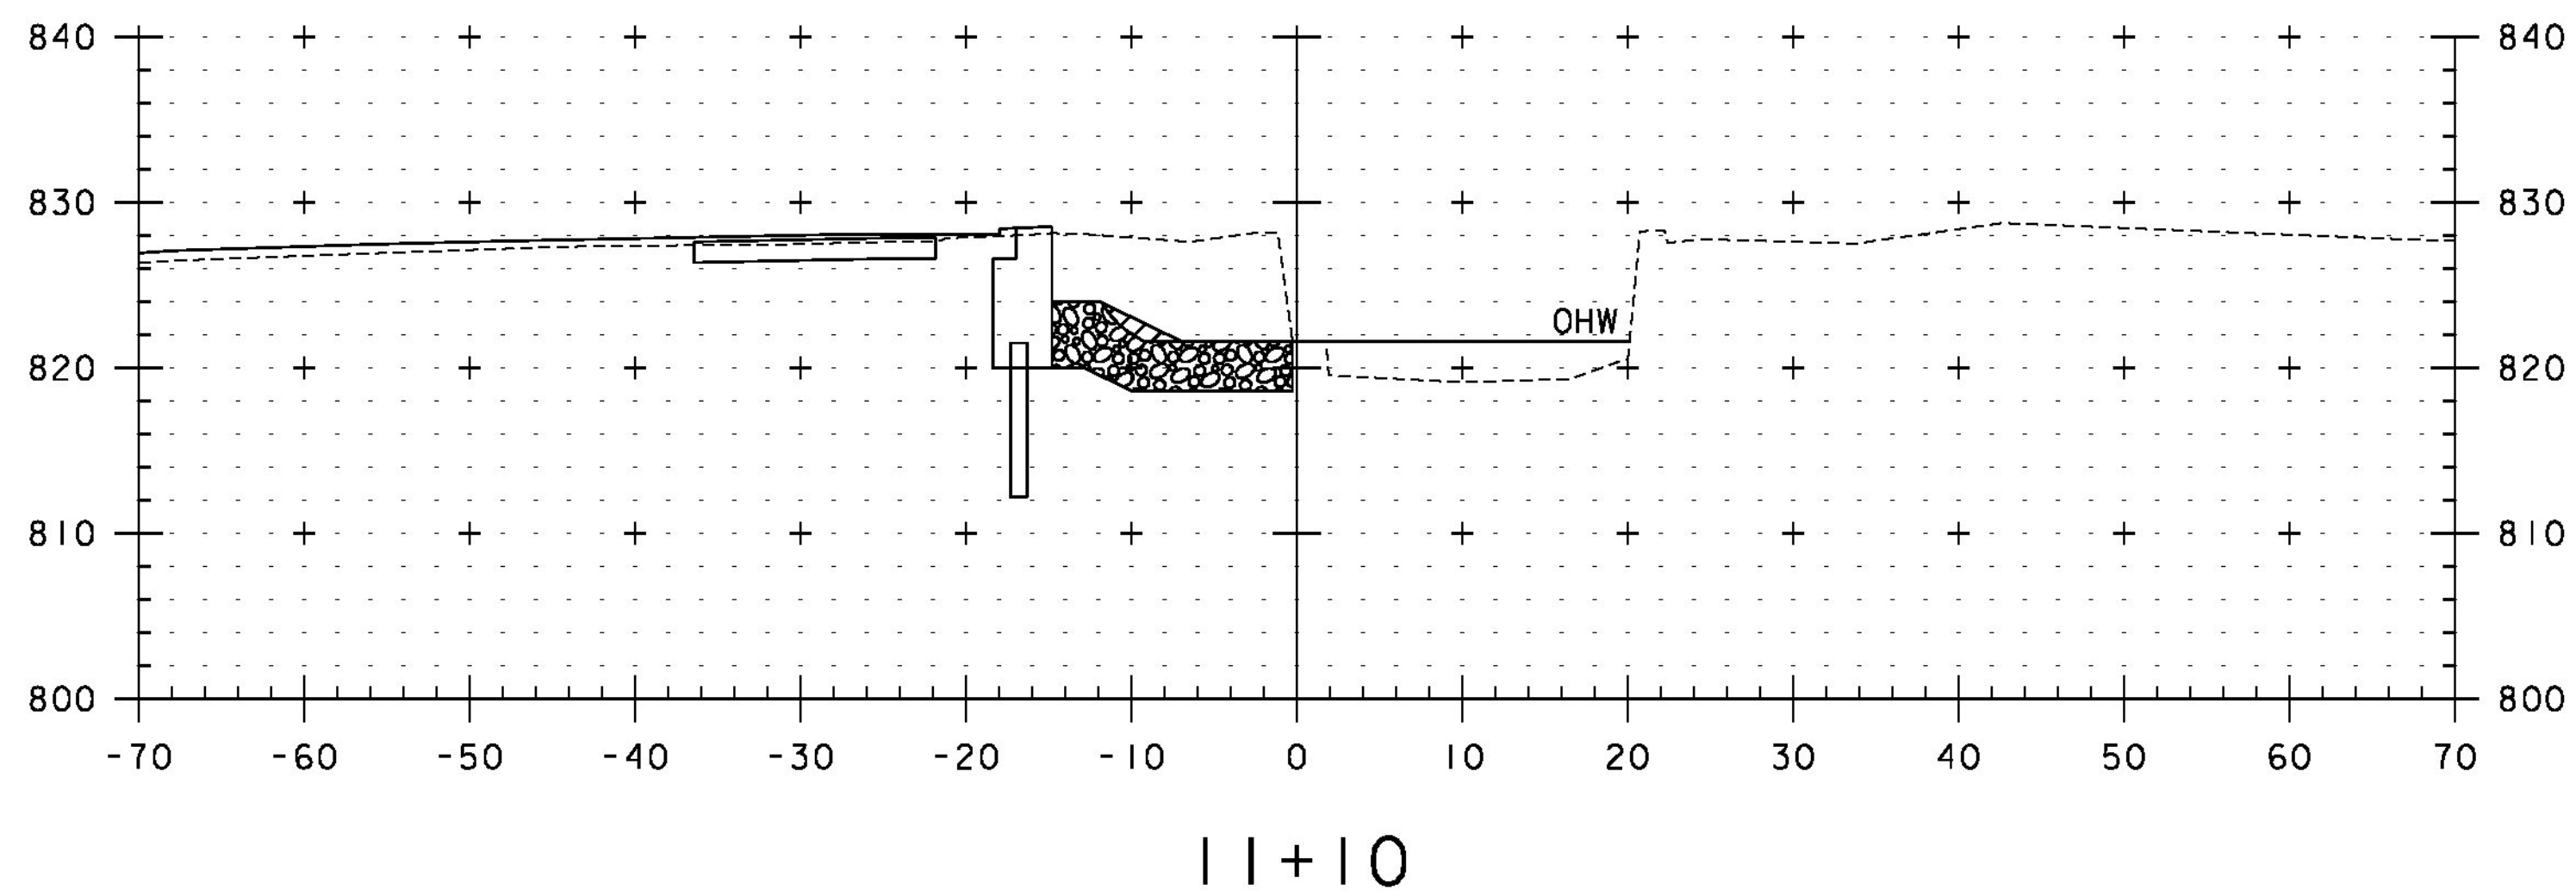

STA. 11+10 TO STA. 11+45

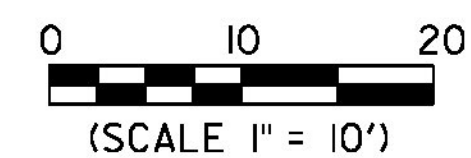

PROJECT NAME: BURKE	PLOT DATE: 10/14/2014
PROJECT NUMBER: BRF 0269(13)	DRAWN BY: M. SMITH
FILE NAME: I0c412/cos/z10c412xs1chan.dgn	CHECKED BY: J. BYATT
PROJECT LEADER: J. BYATT	SHEET 65 OF 73
DESIGNED BY: S. BEAUMONT	CHANNEL CROSS SECTIONS 3