



SOIL INFORMATION:
COLTON-DUXBURY COMPLEX
K = 0.24, HIGHLY ERODIBLE
HYDROLOGIC SOIL GROUP: A

SOIL INFORMATION:
COLTON-DUXBURY COMPLEX
K = 0.24, HIGHLY ERODIBLE
HYDROLOGIC SOIL GROUP: A

SOIL INFORMATION:
COLTON-DUXBURY COMPLEX
K = 0.24, NOT HIGHLY ERODIBLE
HYDROLOGIC SOIL GROUP: A

SOIL INFORMATION:
COLTON-DUXBURY COMPLEX
K = 0.24, HIGHLY ERODIBLE
HYDROLOGIC SOIL GROUP: A

SOIL INFORMATION:
COLTON-DUXBURY COMPLEX
K = 0.24, HIGHLY ERODIBLE
HYDROLOGIC SOIL GROUP: A

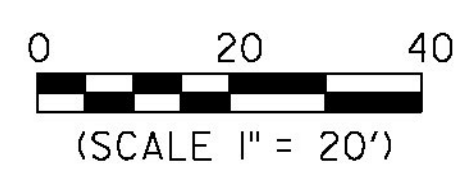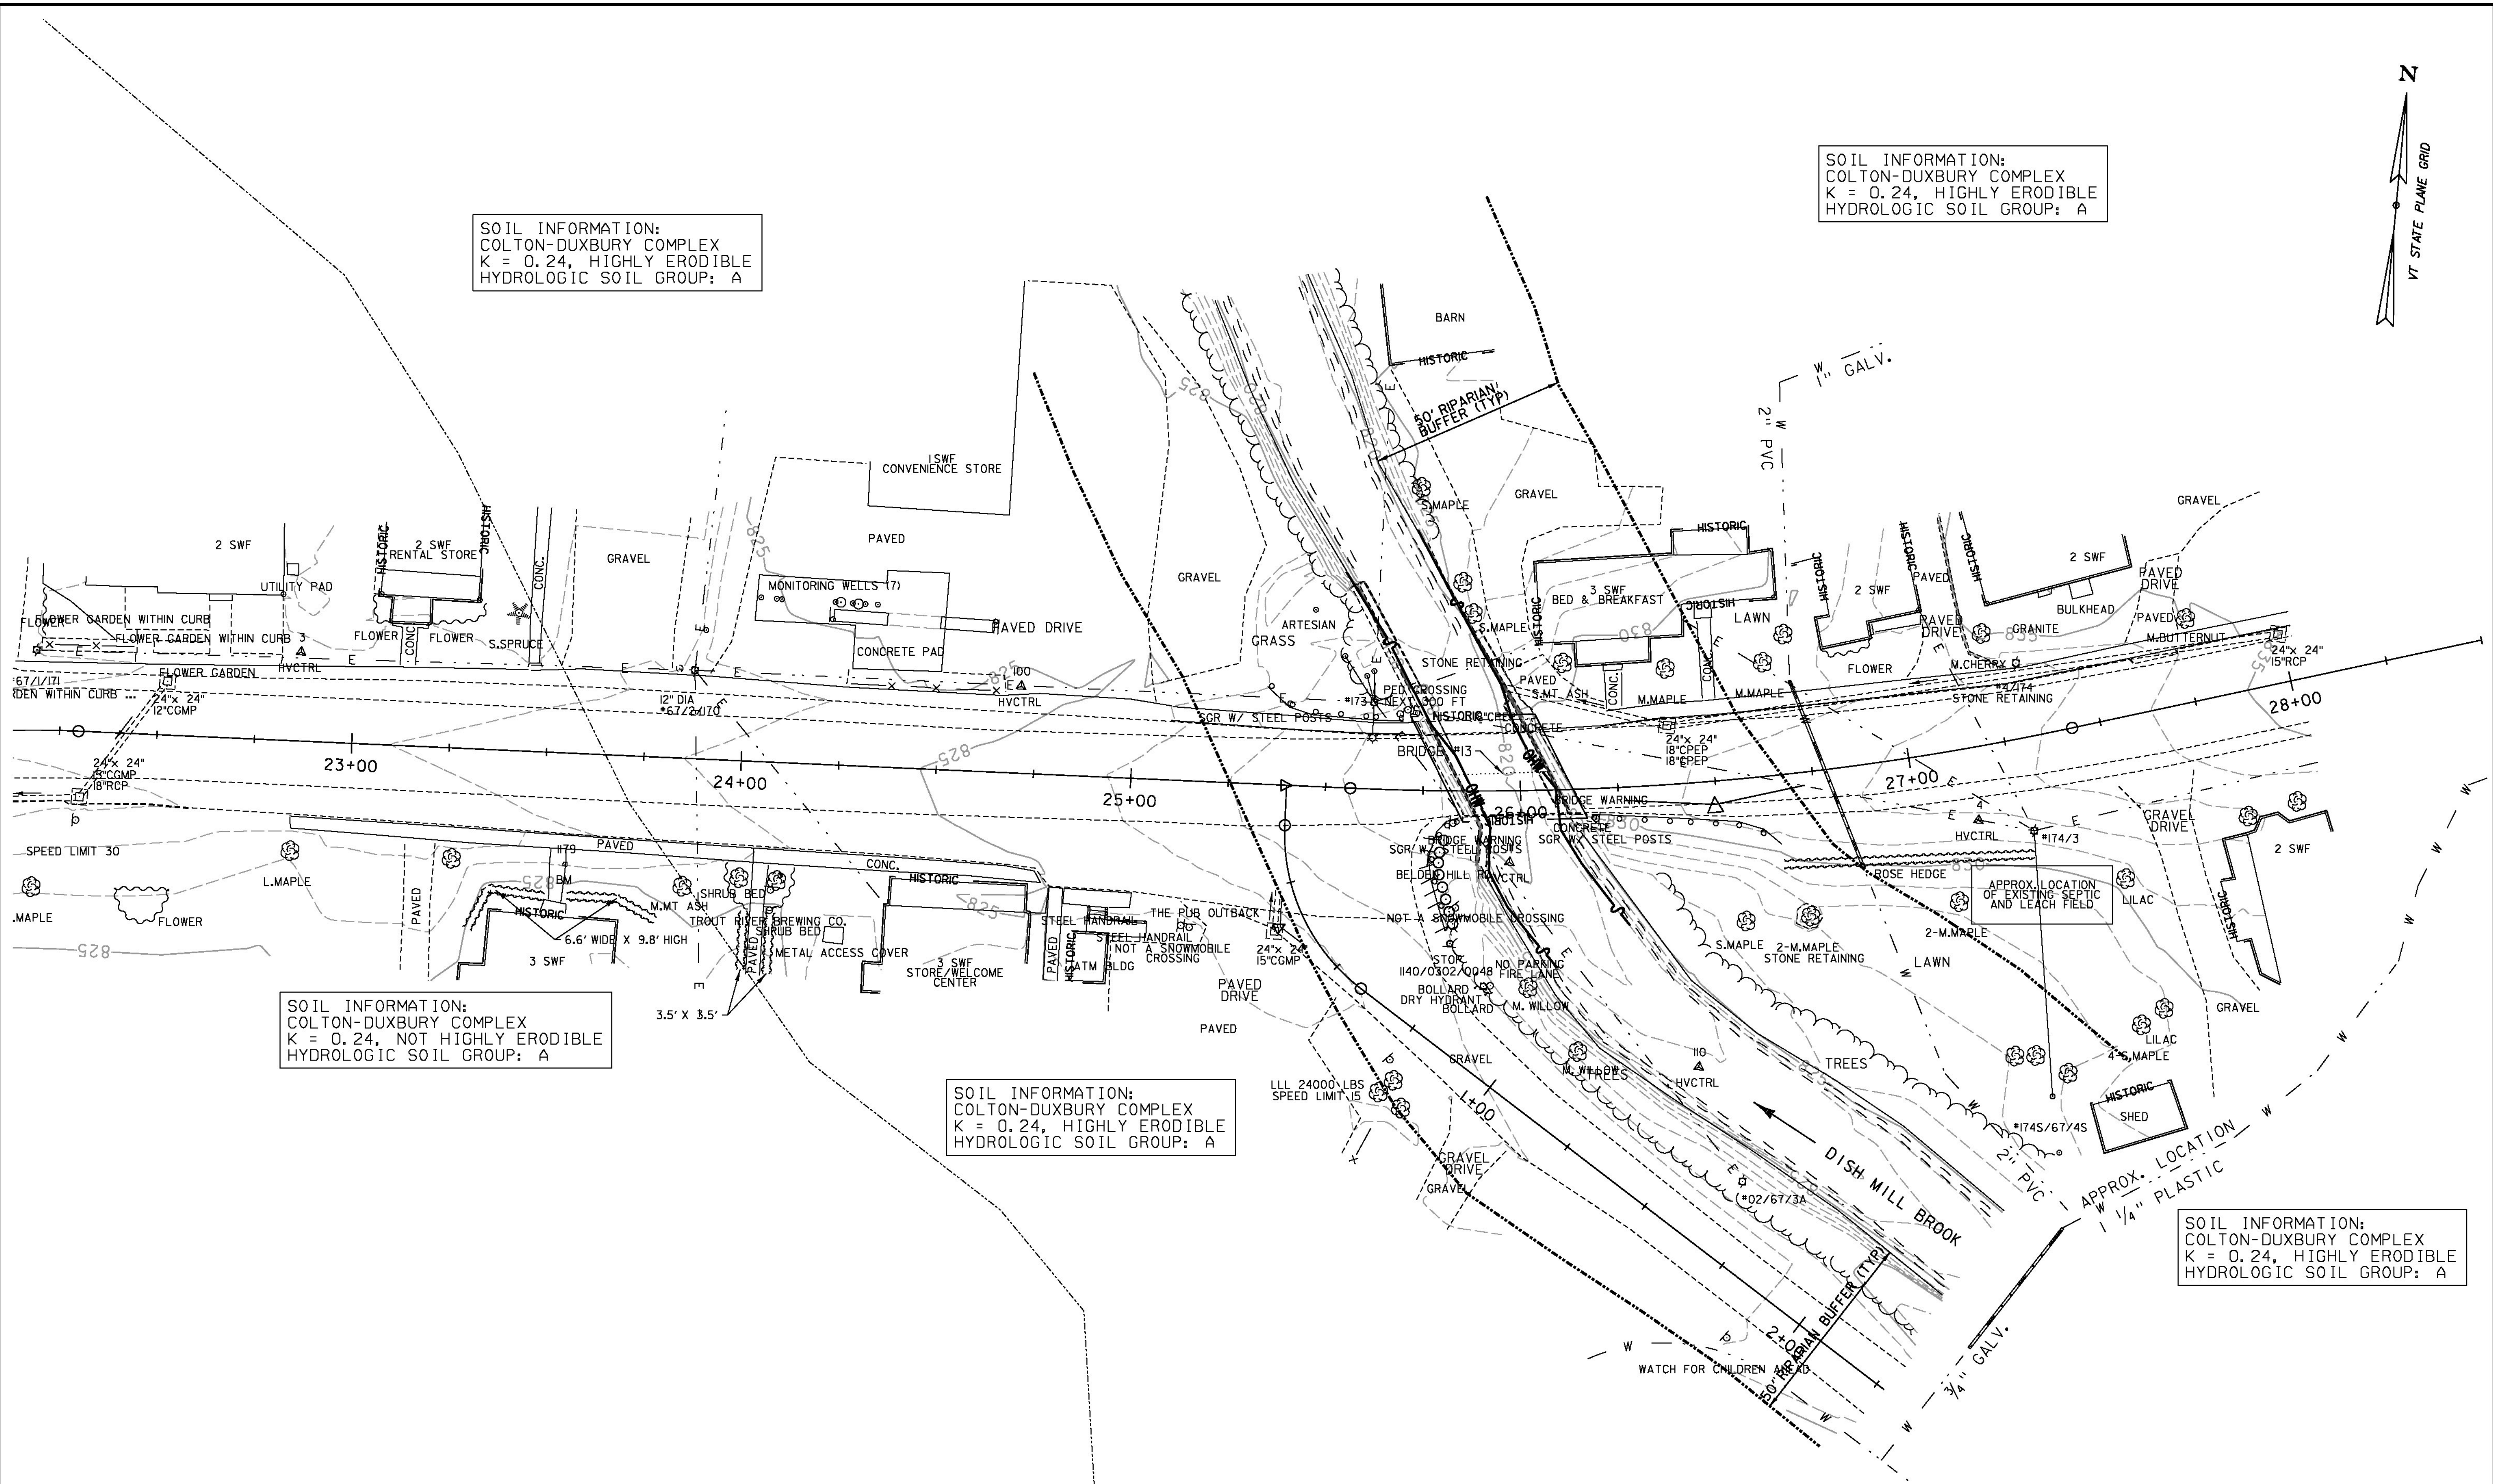

PROJECT NAME: BURKE
PROJECT NUMBER: BRF 0269(13)
FILE NAME: I0c412/cos/z10c412bdrroex.dgn PLOT DATE: 10/14/2014
PROJECT LEADER: J. BYATT DRAWN BY: M. HALEY
DESIGNED BY: M. HALEY CHECKED BY: P. SHEDD
EPSC EXISTING PLAN SHEET SHEET 67 OF 73

CLD 12-0121 MODEL: LOI