


1 STEM REINFORCING PLAN VIEW IN FORM
 NB3C 3/4" = 1'-0"
 - LONGITUDINAL REINFORCING NOT SHOWN FOR CLARITY
 - SEE SHEET NB3B FOR REINFORCING PLAN
 - SEE SHEET NB3D FOR FLANGE REINFORCING AT BEAM END

SHOP NOTE
 - STRIPS SPACINGS TO BE ADJUSTED TO ALLOW FOR 2" PVC SLEEVE

Vermont Agency of Transportation
RECEIVED
 CR'D BY: [Signature]
 RESUBMIT No: [Blank]
 BY: Rob Young
 DATE: 04/10/2015
 Approved As Noted

SHOP DRAWING REVIEW	
<input type="checkbox"/> REVIEWED AS REQUIRED BY THE CONSTRUCTION CONTRACT DOCUMENTS AND APPROVED BUT ONLY FOR CONFORMANCE TO THE DESIGN CONCEPT OF THE WORK, AND SUBJECT TO FURTHER LIMITATIONS AND REQUIREMENTS CONTAINED IN THE CONSTRUCTION CONTRACT DOCUMENTS.	<input type="checkbox"/> APPROVED AS NOTED
<input type="checkbox"/> REJECTED	<input type="checkbox"/> REVISE AND RESUBMIT
CORRECTIONS OR COMMENTS MADE ON THE SHOP DRAWINGS DURING THIS REVIEW DO NOT RELIEVE CONTRACTOR FROM COMPLIANCE WITH REQUIREMENTS OF THE DRAWINGS AND SPECIFICATIONS. THIS CHECK IS ONLY FOR REVIEW OF GENERAL CONFORMANCE WITH THE DESIGN CONCEPT OF THE PROJECT AND GENERAL COMPLIANCE WITH THE INFORMATION GIVEN IN THE CONTRACT DOCUMENTS. THE CONTRACTOR IS RESPONSIBLE FOR CONFIRMING AND CORRELATING ALL QUANTITIES AND DIMENSIONS, SELECTING FABRICATION PROCESSES AND TECHNIQUES OF CONSTRUCTION, COORDINATING THEIR WORK WITH THAT OF ALL OTHER TRADES, AND PERFORMING THEIR WORK IN A SAFE AND SATISFACTORY MANNER.	
CLO Consulting Engineers 340 Commercial Street Montpelier, VT 05602 802-888-8225	Job Number: 120121 Reviewed by: SRB Date: 04/10/2015

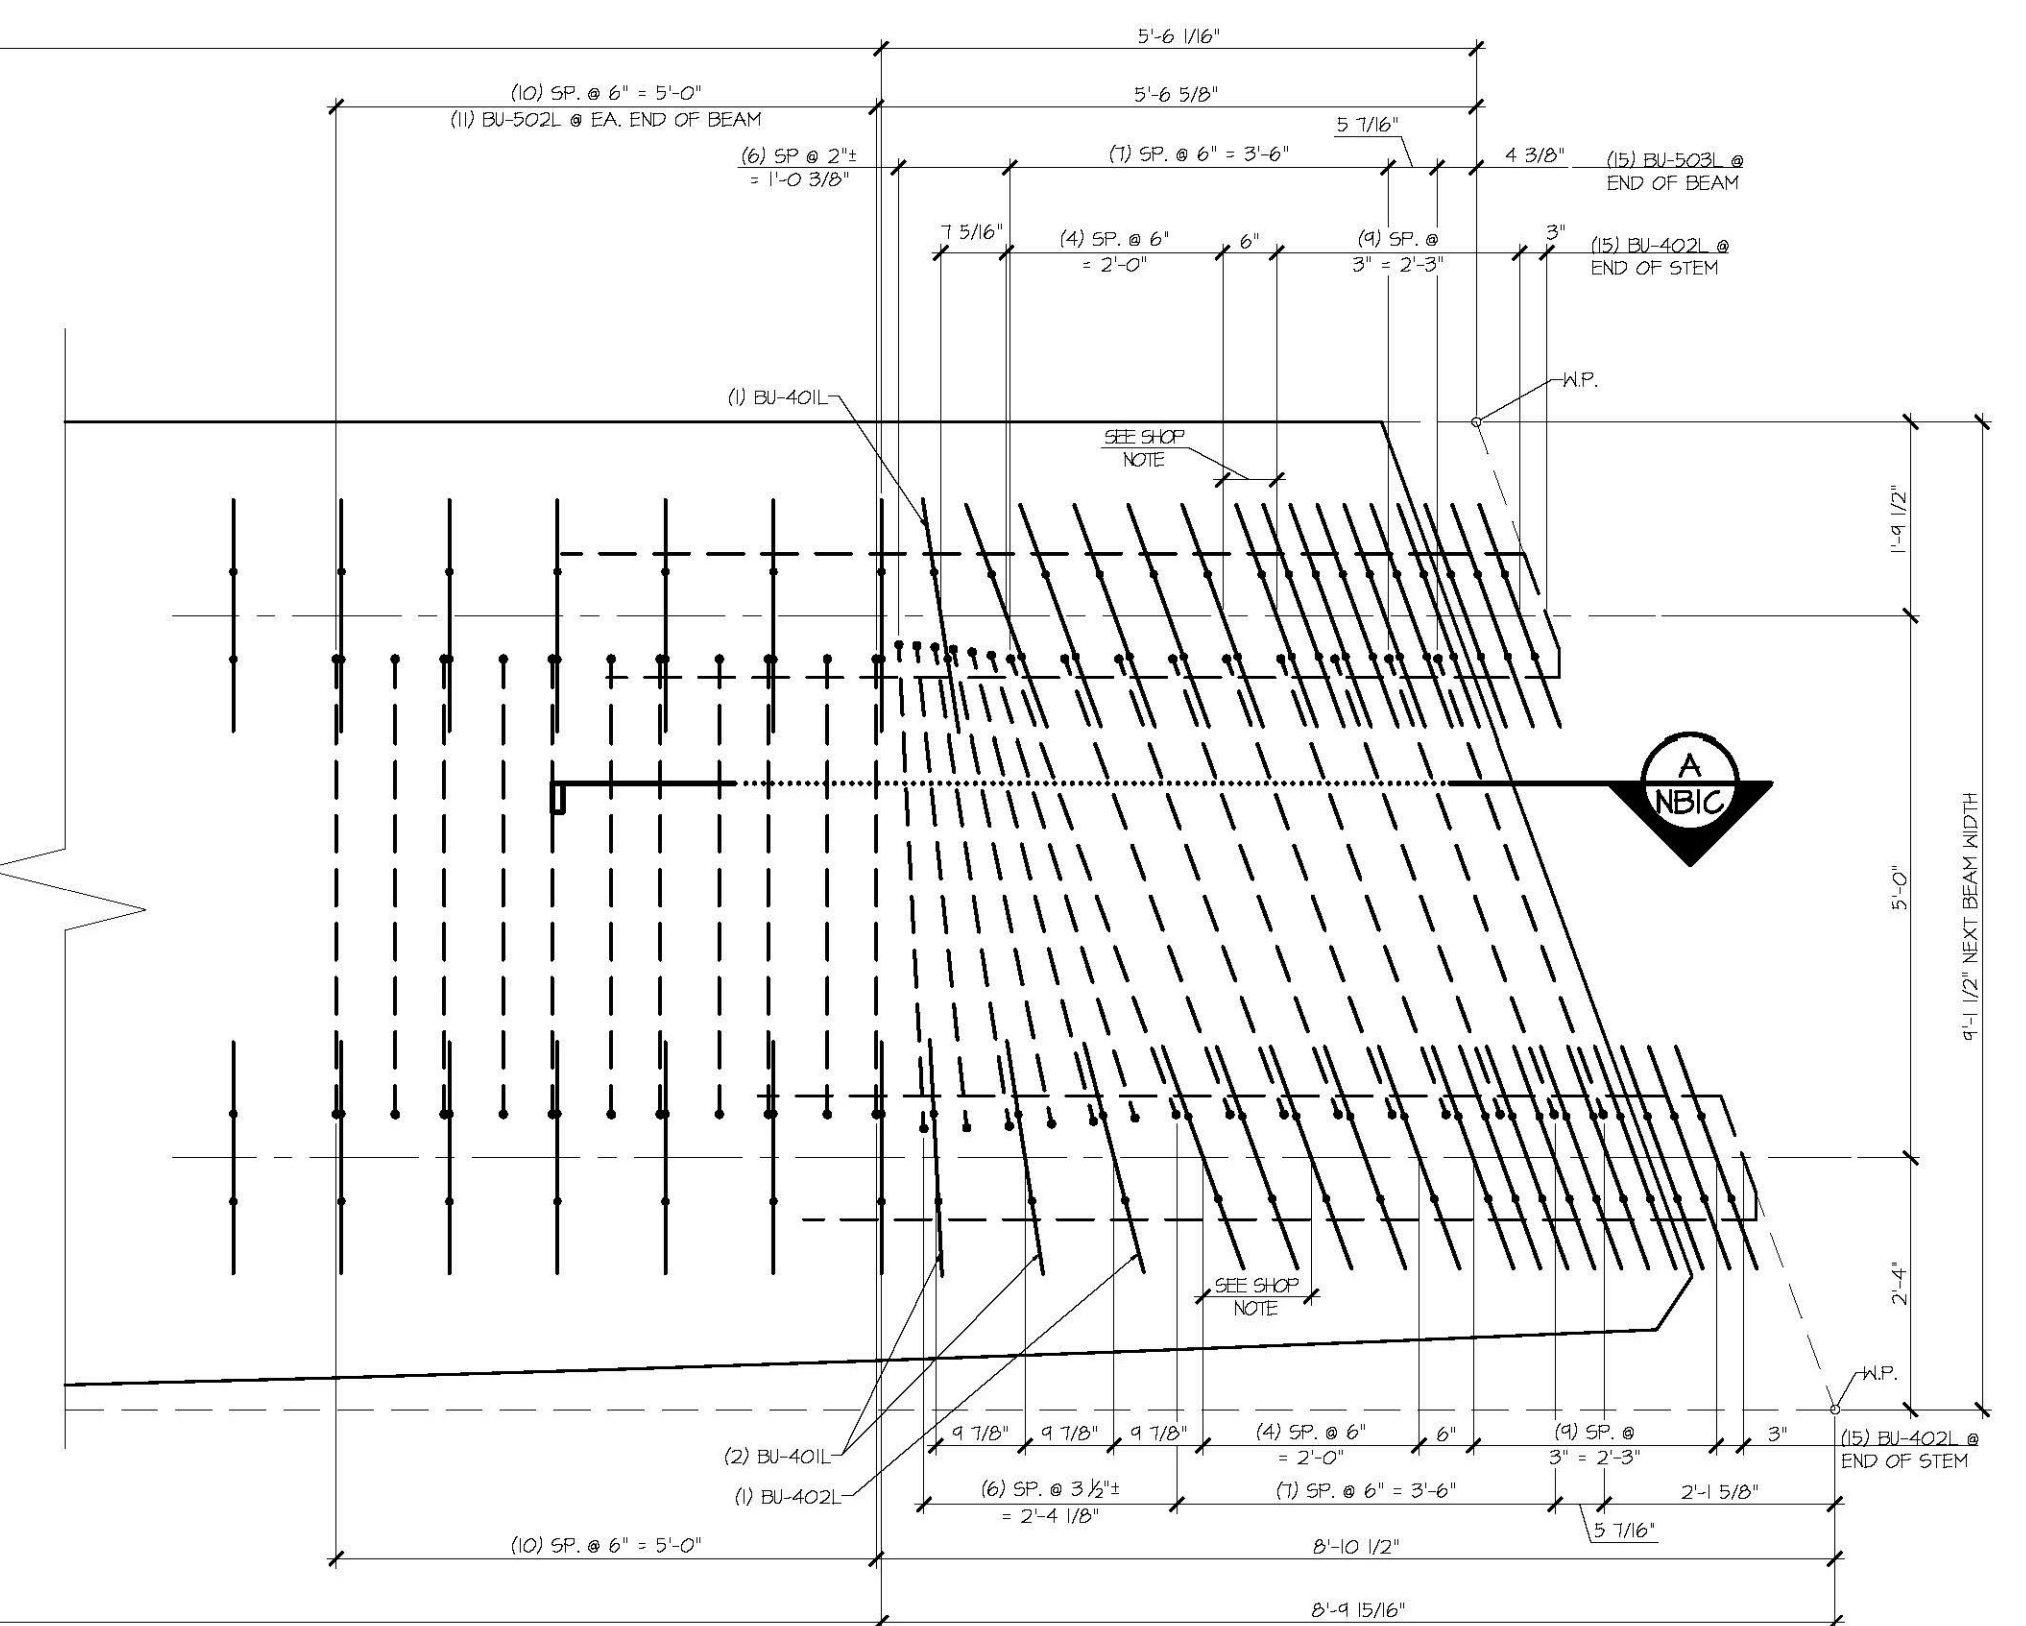

2 STEM REINFORCING PLAN VIEW IN FORM
 NB3C 3/4" = 1'-0"
 - LONGITUDINAL REINFORCING NOT SHOWN FOR CLARITY
 - SEE SHEET NB3B FOR REINFORCING PLAN
 - SEE SHEET NB3D FOR FLANGE REINFORCING AT BEAM END

APPROVAL STAMP:	J.P. CARRARA & SONS INC. Precast & Prestress Manufacturer 244 CHEE ST. WOODBURY, VERMONT 05053 Phone: (802)388-4361 Fax: (802)388-8010	T. BUCK CONSTRUCTION, INC. CONTRACTOR AUBURN, MAINE
STATE OF VERMONT AGENCY OF TRANSPORTATION COUNTY OF CALEDONIA	DATE: MAR. 26, 2015	SCALE: NOTED
TOWN OF BURKE VERMONT ROUTE 114 BRIDGE NO.: 13 PROJECT NO.: BRP 0269(13)	CHKD: [Blank] DFTM: JOK	JOB NO: 23454-015
PRESTRESSED NEXT BEAM DETAILS	DWG. NO: NB3C	