



STATE OF VERMONT AGENCY OF TRANSPORTATION

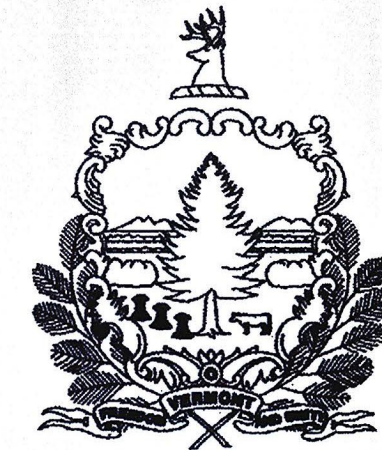

PROPOSED IMPROVEMENT BRIDGE PROJECT

TOWN OF ROCHESTER
COUNTY OF WINDSOR
VT ROUTE 73 (RURAL MAJOR COLLECTOR)

RECORD PLANS	
CONTRACTOR:	W.M. SCHULTZ CONSTRUCTION, INC. <i>Burlington Spa, NY</i>
RESIDENT ENGINEER:	CHRISTOPHER D. WILLIAMS
CONSTRUCTION BEGAN:	APRIL 28, 2014
CONSTRUCTION COMPLETE:	DECEMBER 16, 2015
RECORD PLANS BY:	CHRISTOPHER D. WILLIAMS & AARON WEAVER
I HEREBY CERTIFY THAT ALL THE CONSTRUCTION REQUIRED BY THIS SET OF DRAWINGS HAS BEEN ACCOMPLISHED AS INDICATED HEREIN.	
BY <i>Chris Williams</i>	RESIDENT ENGINEER
DATE <i>June 15, 2018</i>	
NOTE: Any further information concerning final quantities, amounts or other details relative to this project may be found at Central Files in the electronic archives.	

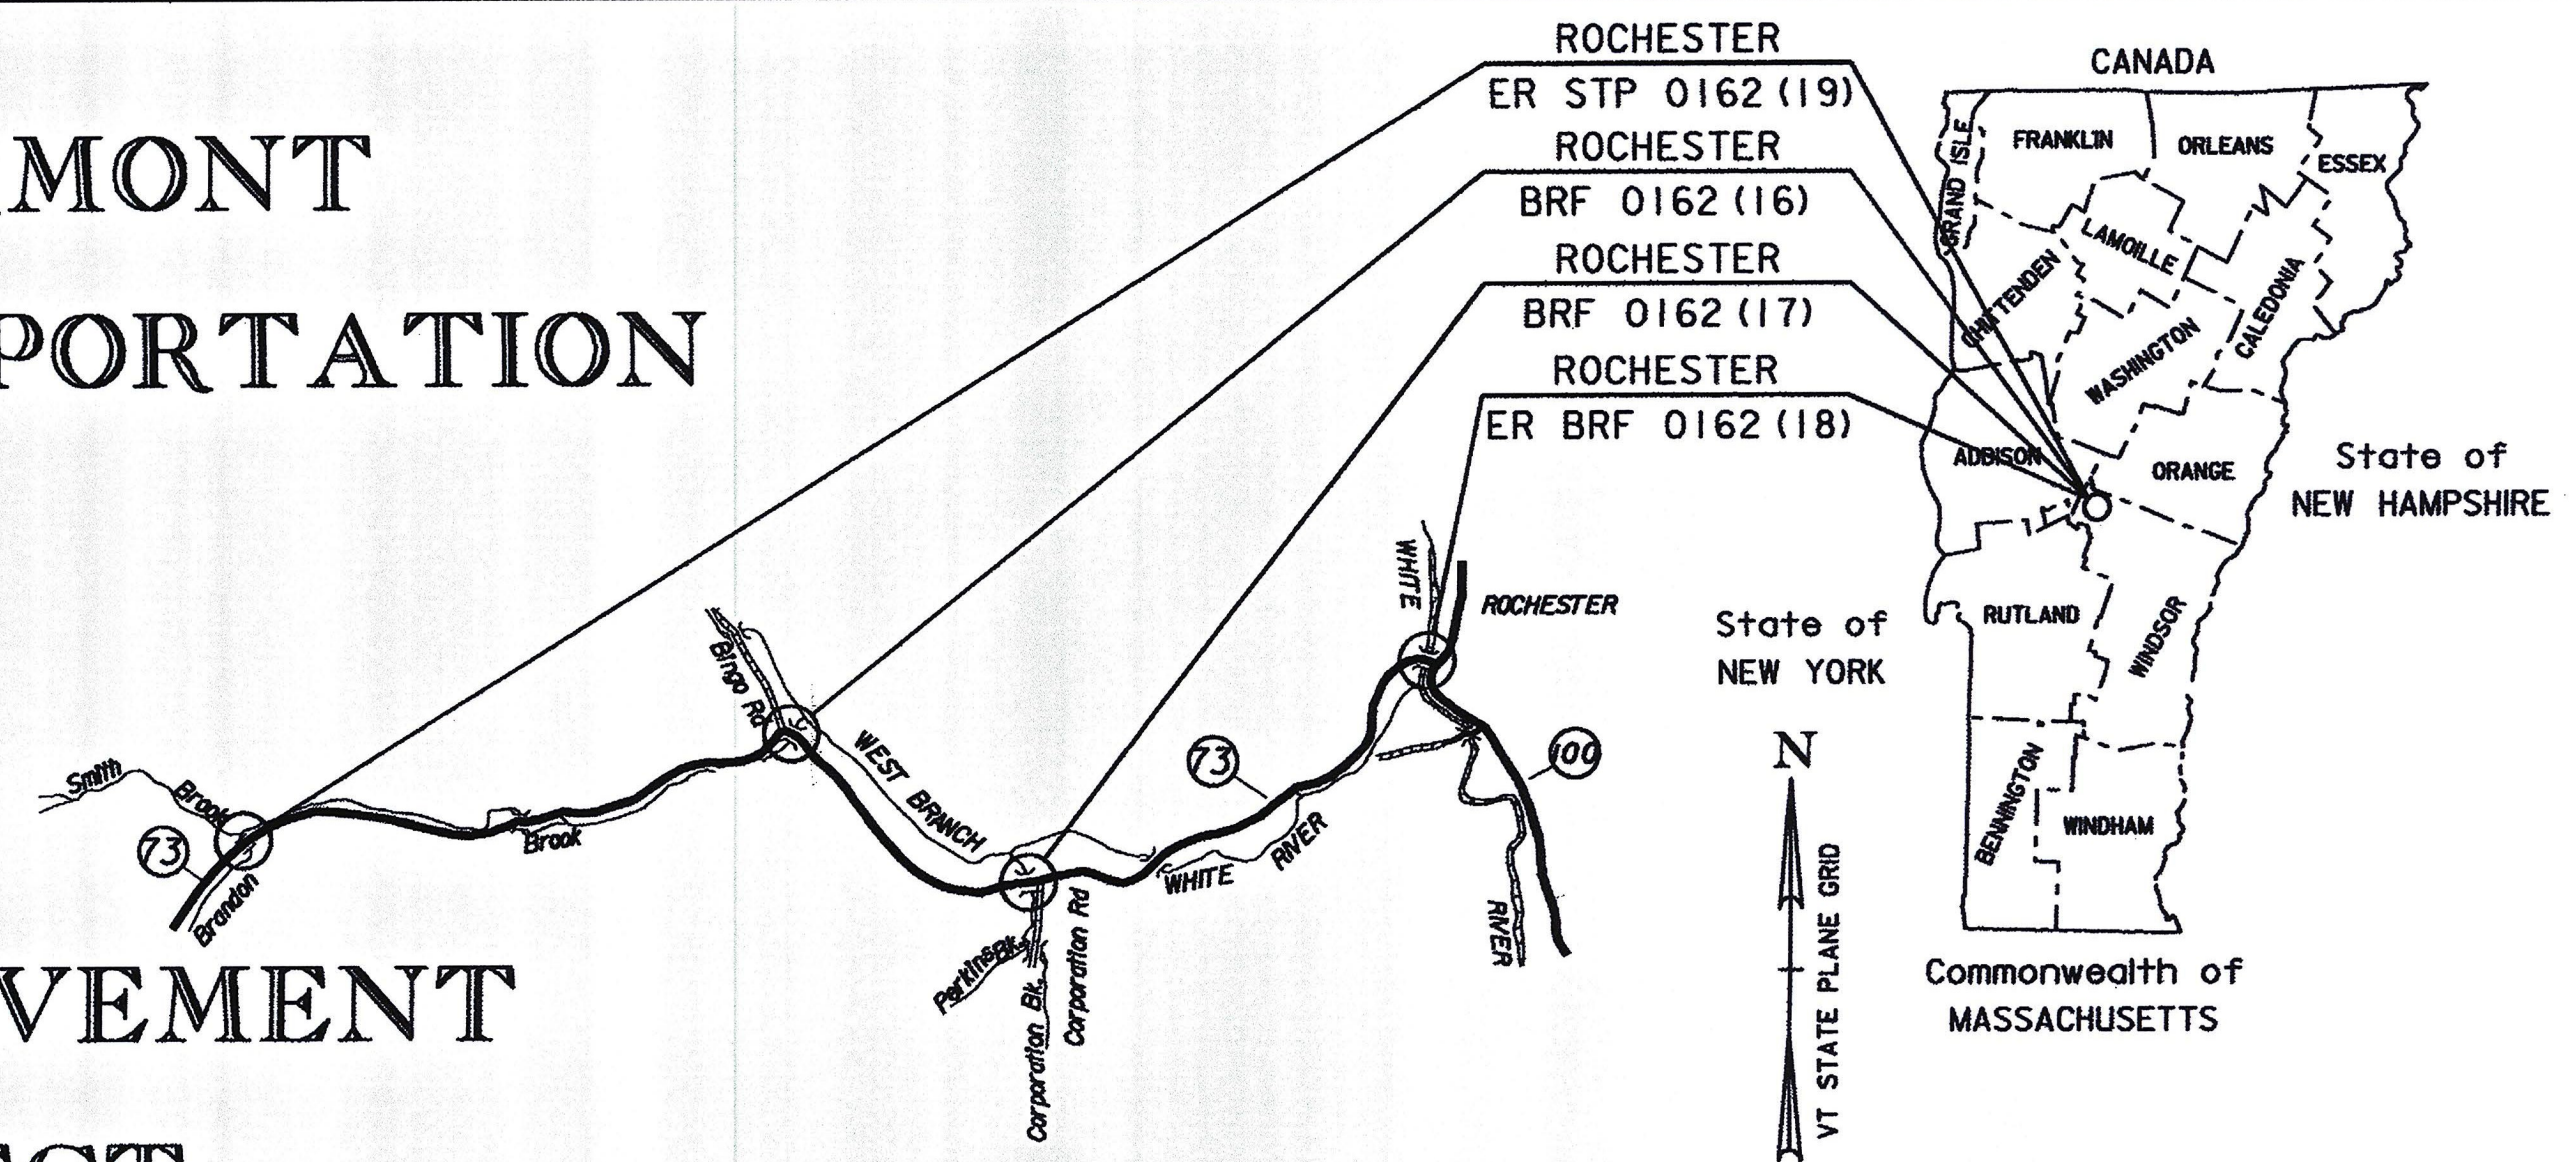

ROCHESTER ER STP 0162 (19)

BRIDGE NO 13

(SEE SHEET 13)

PROJECT LOCATION: LOCATED IN THE COUNTY OF WINDSOR, TOWN OF ROCHESTER, ON VT 73; BRIDGE NO 13 OVER BRANDON BROOK, APPROXIMATELY 2.43 MILES EAST OF THE GOSHEN/ROCHESTER TOWN LINE.

PROJECT DESCRIPTION: WORK TO BE PERFORMED UNDER THIS PROJECT INCLUDES THE REMOVAL AND REPLACEMENT OF THE EXISTING 10' CMP ON THE EXISTING ALIGNMENT, WITH ASSOCIATED ROADWAY AND CHANNEL WORK.

LENGTH OF STRUCTURE: 52.94 FT
LENGTH OF ROADWAY: 222.06 FT
LENGTH OF PROJECT: 275.00 FT

ROCHESTER BRF 0162 (16)

BRIDGE NO 15

(SEE SHEET 59)

PROJECT LOCATION: LOCATED IN THE COUNTY OF WINDSOR, TOWN OF ROCHESTER, ON VT 73; BRIDGE NO 15 OVER BRANDON BROOK, APPROXIMATELY 4.00 MILES WEST OF THE INTERSECTION WITH VT ROUTE 73 AND VT ROUTE 100.

PROJECT DESCRIPTION: WORK TO BE PERFORMED UNDER THIS PROJECT INCLUDES THE REMOVAL AND REPLACEMENT OF EXISTING BRIDGE NO 15 ON THE EXISTING ALIGNMENT, WITH ASSOCIATED ROADWAY AND CHANNEL WORK.

LENGTH OF STRUCTURE: 71.12 FT
LENGTH OF ROADWAY: 163.88 FT
LENGTH OF PROJECT: 235.00 FT

ROCHESTER BRF 0162 (17)

BRIDGE NO 16

(SEE SHEET 121)

PROJECT LOCATION: LOCATED IN THE COUNTY OF WINDSOR, TOWN OF ROCHESTER, ON VT 73; BRIDGE NO 16 OVER CORPORATION BROOK, APPROXIMATELY 2.50 MILES WEST OF THE INTERSECTION WITH VT 73 AND VT 100.

PROJECT DESCRIPTION: WORK TO BE PERFORMED UNDER THIS PROJECT INCLUDES THE REMOVAL AND REPLACEMENT OF EXISTING BRIDGE NO 16 ON THE EXISTING ALIGNMENT, WITH ASSOCIATED ROADWAY AND CHANNEL WORK.

LENGTH OF STRUCTURE: 65.17 FT
LENGTH OF ROADWAY: 104.83 FT
LENGTH OF PROJECT: 170.00 FT

ROCHESTER ER BRF 0162 (18)

BRIDGE NO 19

(SEE SHEET 174)

PROJECT LOCATION: LOCATED IN THE COUNTY OF WINDSOR, TOWN OF ROCHESTER, ON VT 73; BRIDGE NO 19 OVER WHITE RIVER, APPROXIMATELY 0.02 MILES WEST OF THE INTERSECTION OF VT 73 AND VT 100.



PROJECT DESCRIPTION: WORK TO BE PERFORMED UNDER THIS PROJECT INCLUDES REMOVAL AND REPLACEMENT OF BRIDGE NO 19 ON A NEW ALIGNMENT, WITH ASSOCIATED ROADWAY AND CHANNEL WORK.

LENGTH OF STRUCTURE: 130.33 FEET
LENGTH OF ROADWAY: 235.04 FEET
LENGTH OF PROJECT: 365.37 FEET

QUALITY ASSURANCE PROGRAM: LEVEL 2



CONVENTIONAL SYMBOLS

COUNTY LINE	
TOWN LINE	
LIMITS OF ACCESS	
POINT OF ACCESS	
FENCE LINE	
STONE WALL	
TRAVELED WAY	
GUARD RAIL	
RAILROAD	
SURVEY LINE	
CULVERT	
POWER POLE	
TELEPHONE POLE	
TREES	
CONTROL OF ACCESS	
PROPERTY LINE	
R.O.W. TAKING LINE	
SLOPE RIGHTS	
TOP OF CUT	
TOE OF SLOPE	

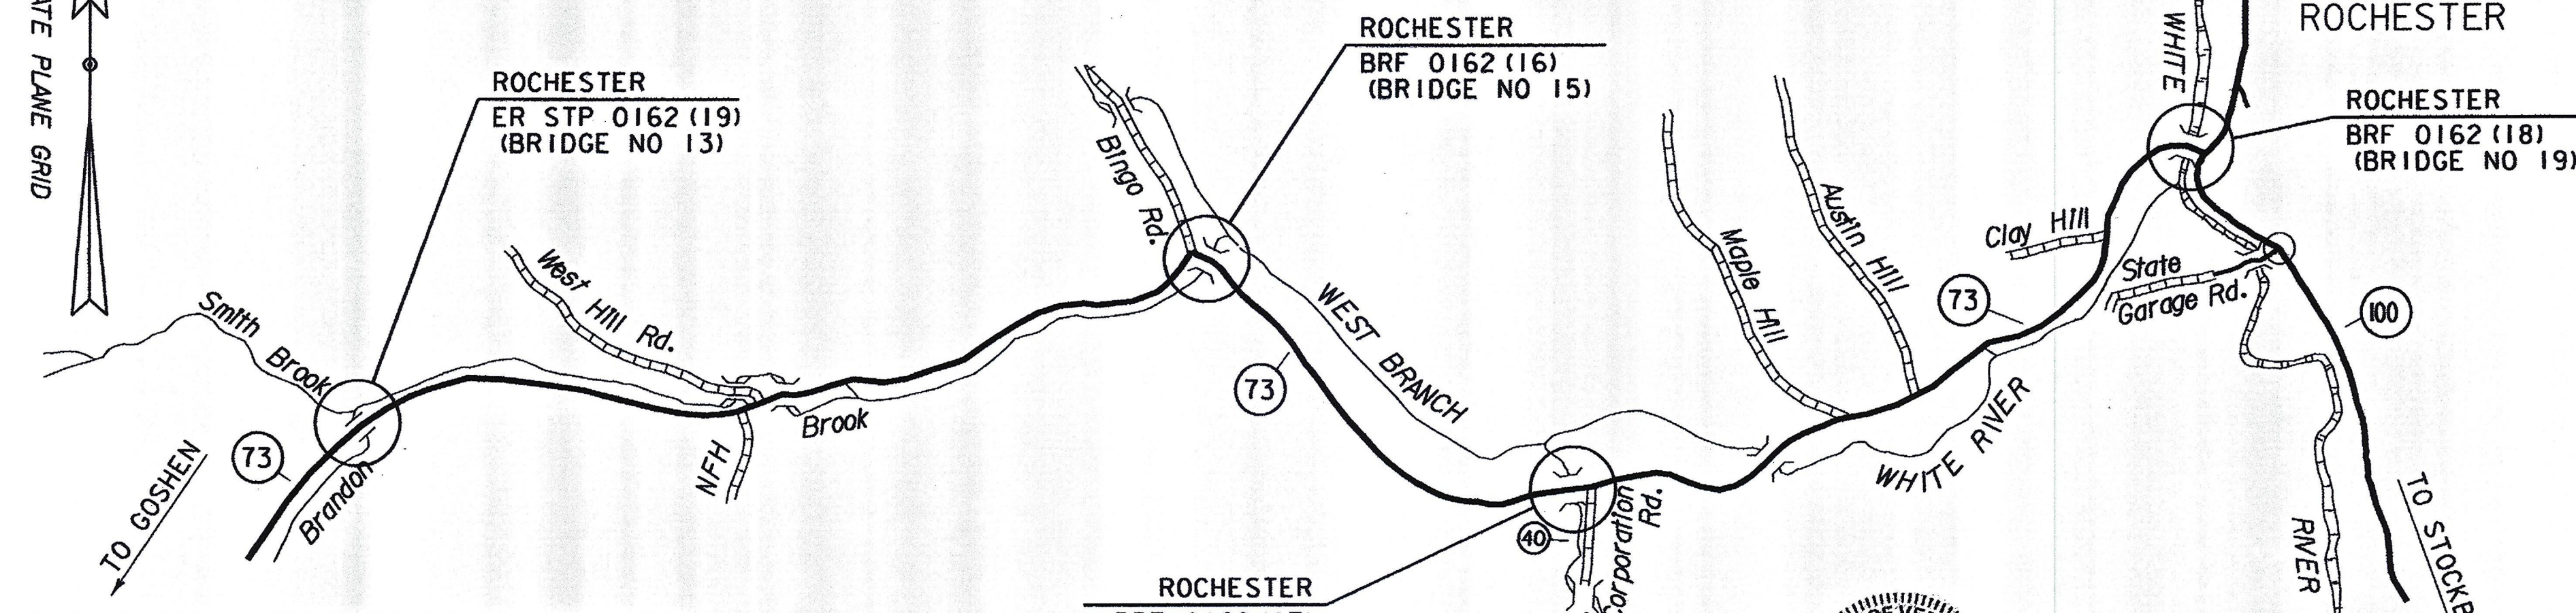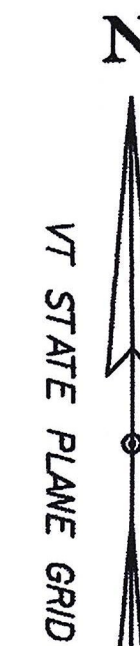

SURVEYED BY : VTRANS/VHB
SURVEYED DATE : JUN 2011, DEC 2011, JAN 2012

DATUM
VERTICAL NAVD 88
HORIZONTAL NAD 83 (2007)

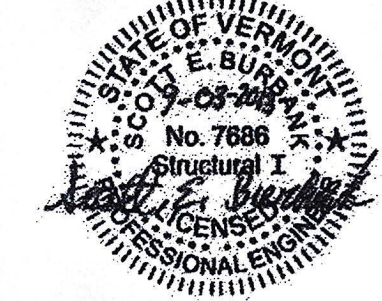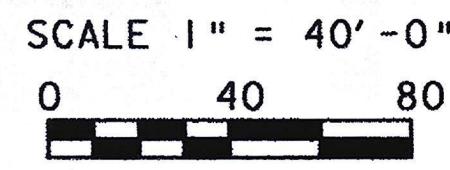

VHB Vanasse Hangen Brustlin, Inc.

THESE PLANS ARE SUBJECT TO SUCH ENGINEERING CHANGES AS MAY BE REQUIRED BY THE FEDERAL HIGHWAY ADMINISTRATION OR THE DIRECTOR OF PROGRAM DEVELOPMENT.

CONSTRUCTION IS TO BE CARRIED ON IN ACCORDANCE WITH THESE PLANS AND THE STANDARD SPECIFICATIONS FOR CONSTRUCTION DATED 2011, AS APPROVED BY THE FEDERAL HIGHWAY ADMINISTRATION ON JULY 20, 2011 FOR USE ON THIS PROJECT, INCLUDING ALL SUBSEQUENT REVISIONS AND SUCH REVISED SPECIFICATIONS AND SPECIAL PROVISIONS AS ARE INCORPORATED IN THESE PLANS.

DIRECTOR OF PROGRAM DEVELOPMENT	
APPROVED <i>Jennifer M.V. Fitch</i>	DATE 9-5-13
PROJECT MANAGER : JENNIFER M.V. FITCH, P.E.	
PROJECT NAME : ROCHESTER	
PROJECT NUMBER : ER STP 0162 (19), BRF 0162 (16), BRF 0162 (17) & ER BRF 0162 (18)	
SHEET 1 OF 238 SHEETS	