


**SPECIAL PROVISION (STONE FILL, CHANNEL FLOW LINE)**  
STA 12+00 - 14+50

**ROCK CROSS VANE**  
STA 12+00, LT & RT  
STA 14+20, LT & RT

**BANKLINE STONE**  
STA 12+29 - 13+73, LT  
STA 12+29 - 13+45, RT

**ROCK WEIR**  
STA 12+50, LT & RT  
STA 12+90, LT & RT  
STA 13+45, LT & RT  
STA 13+70, LT & RT

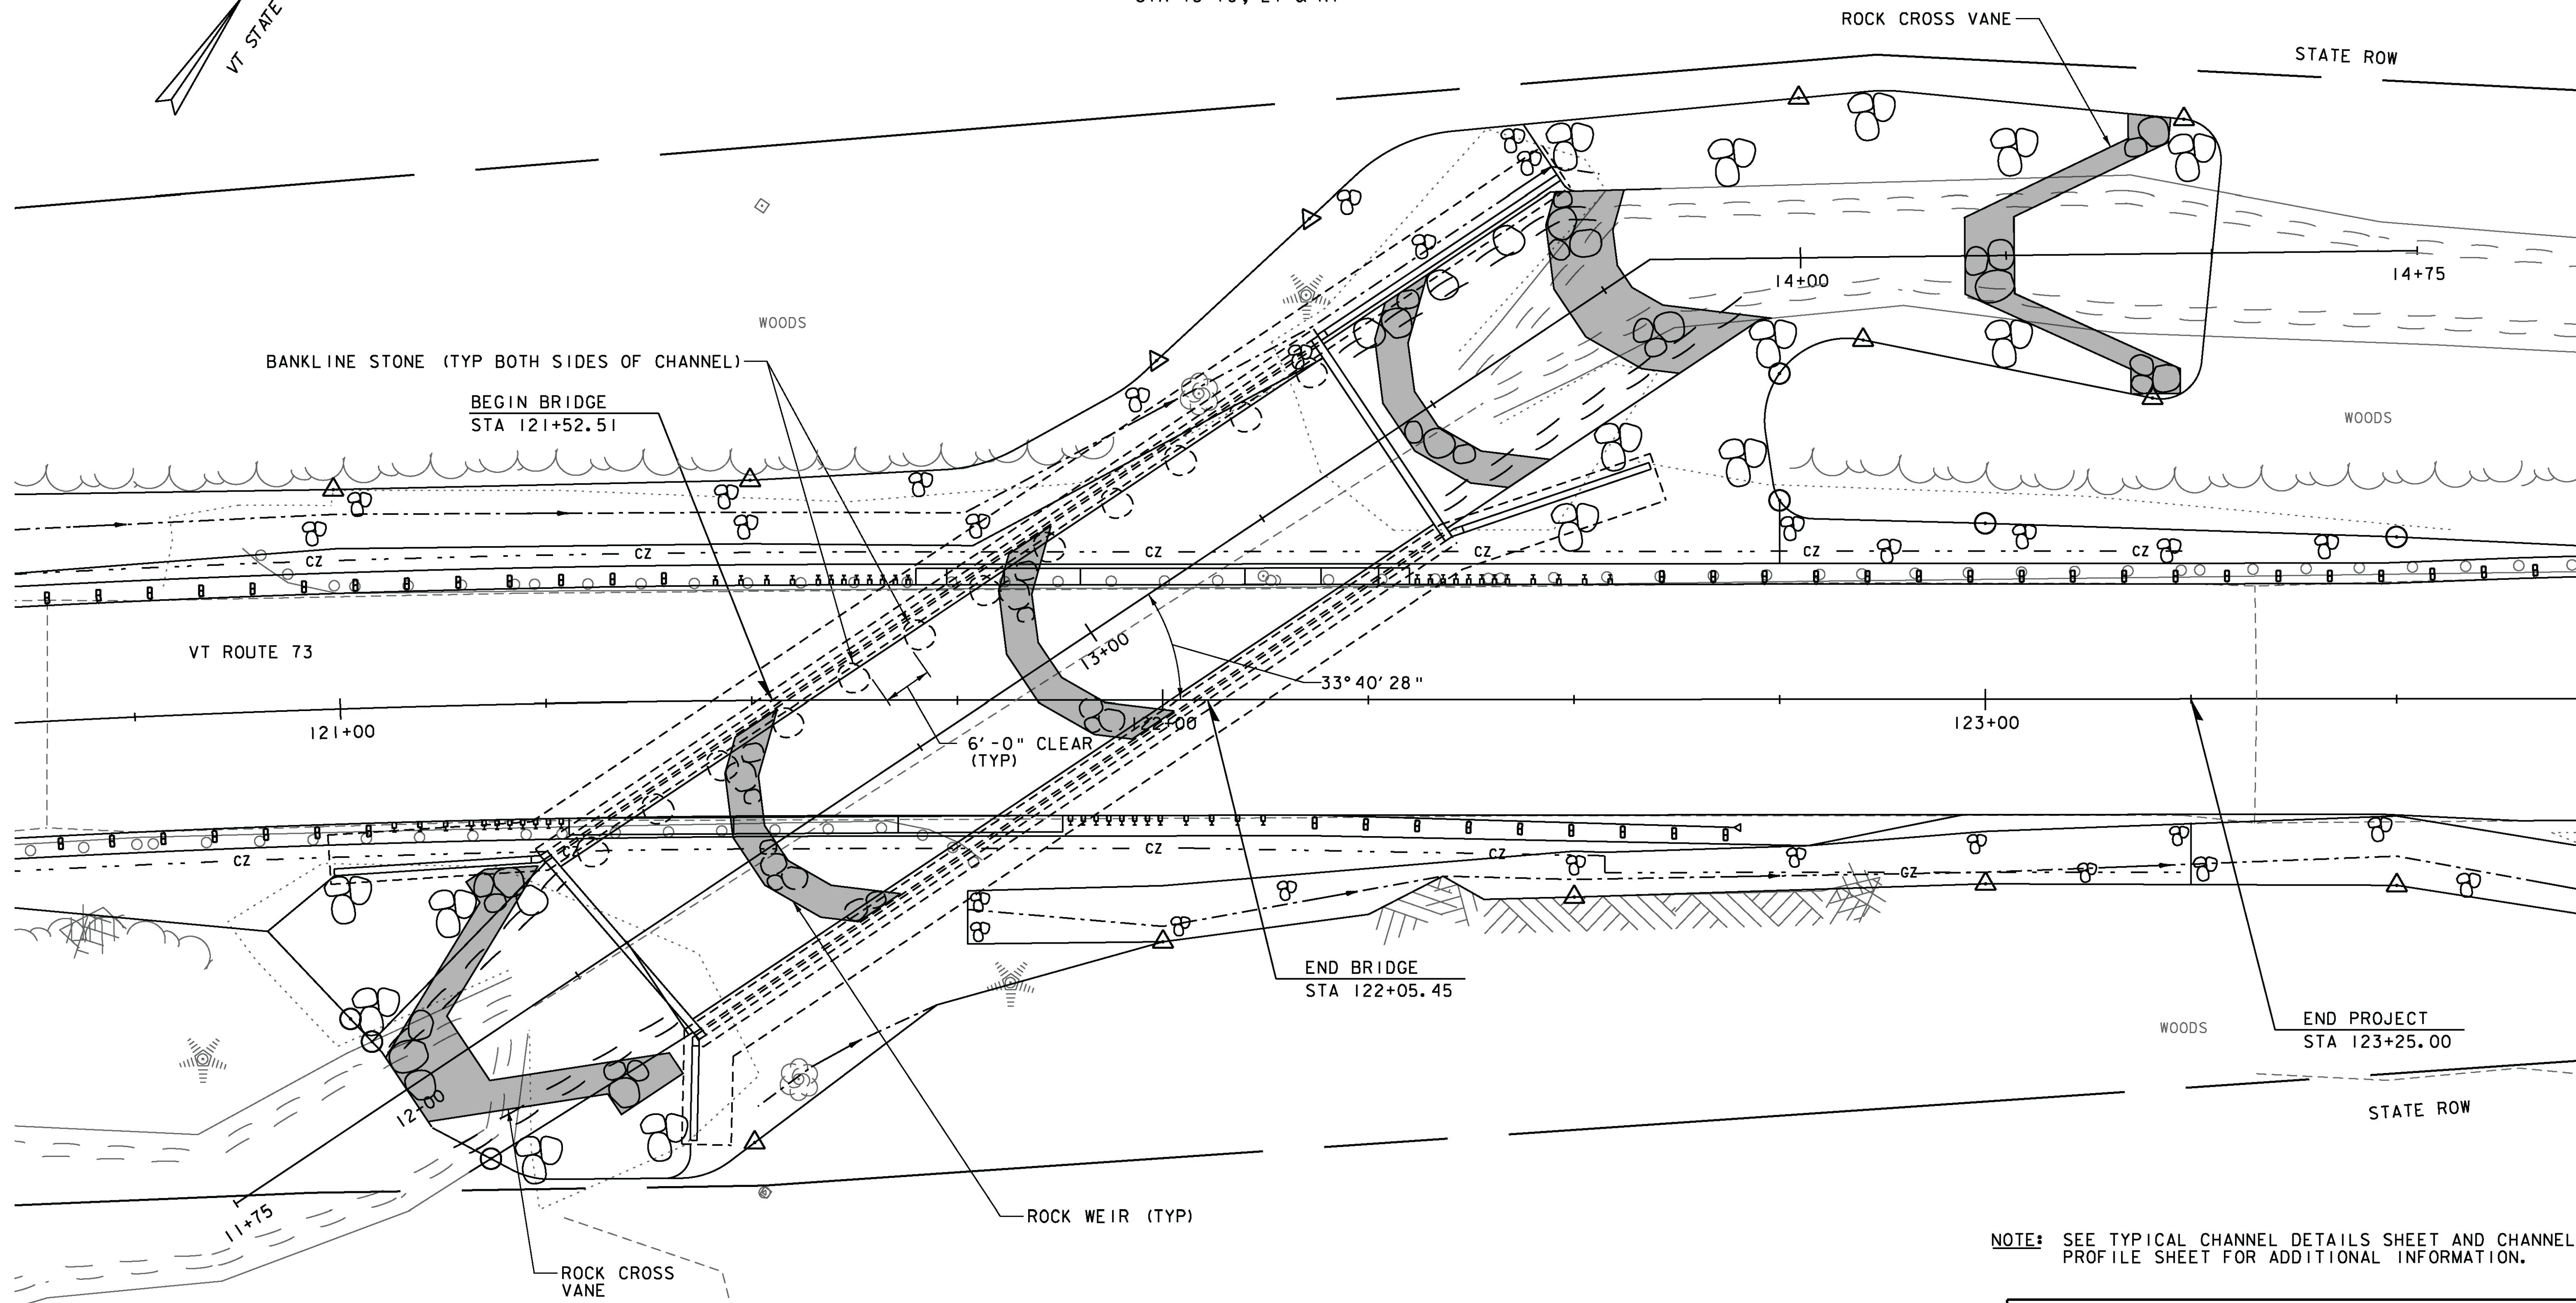

NOTE: SEE TYPICAL CHANNEL DETAILS SHEET AND CHANNEL PROFILE SHEET FOR ADDITIONAL INFORMATION.

SCALE 1" = 10'-0"  
0 10 20



PROJECT NAME: ROCHESTER	PLOT DATE: 8/19/2013
PROJECT NUMBER: ER STP 0162(19)	DRAWN BY: E.A. FIALA
FILE NAME: zllc334bdr_weir.dgn	CHECKED BY: S.E. BURBANK
PROJECT LEADER: S.E. BURBANK	SHEET 27 OF 238
DESIGNED BY: R.A. WILDEY	
BR 13 CHANNEL LAYOUT SHEET	