

SIGNING LEGEND

N = NEW
RET = RETAIN
R = REMOVE
S = SALVAGE




STRIPING LEGEND

DYL = DOUBLE YELLOW LINE
SWL = SINGLE WHITE LINE

TRAFFIC SIGNS, TYPE A

STA 121+00, RT
STA 122+50, LT

4 INCH YELLOW LINE
STA 119+60 - 124+15, LT & RT
4 INCH WHITE LINE
STA 119+60 - 124+15, LT & RT

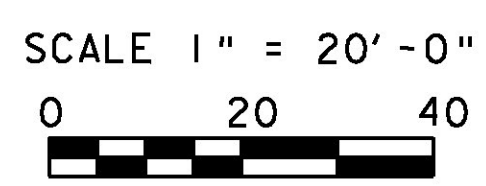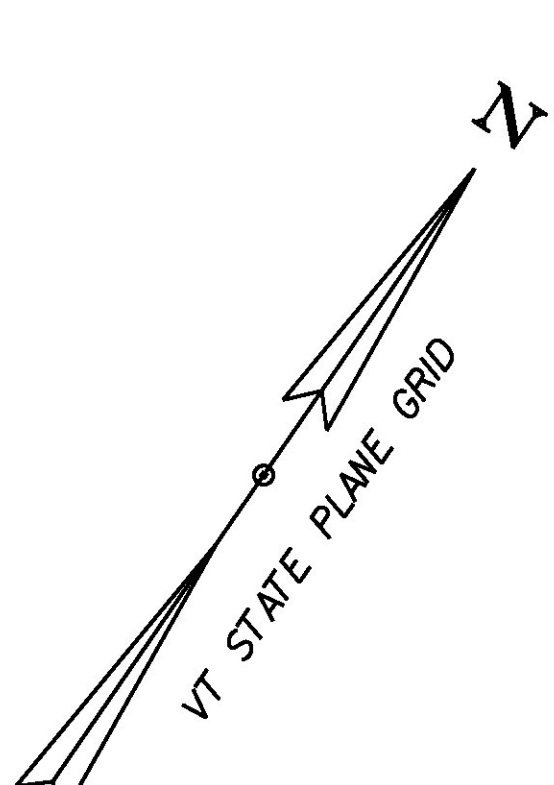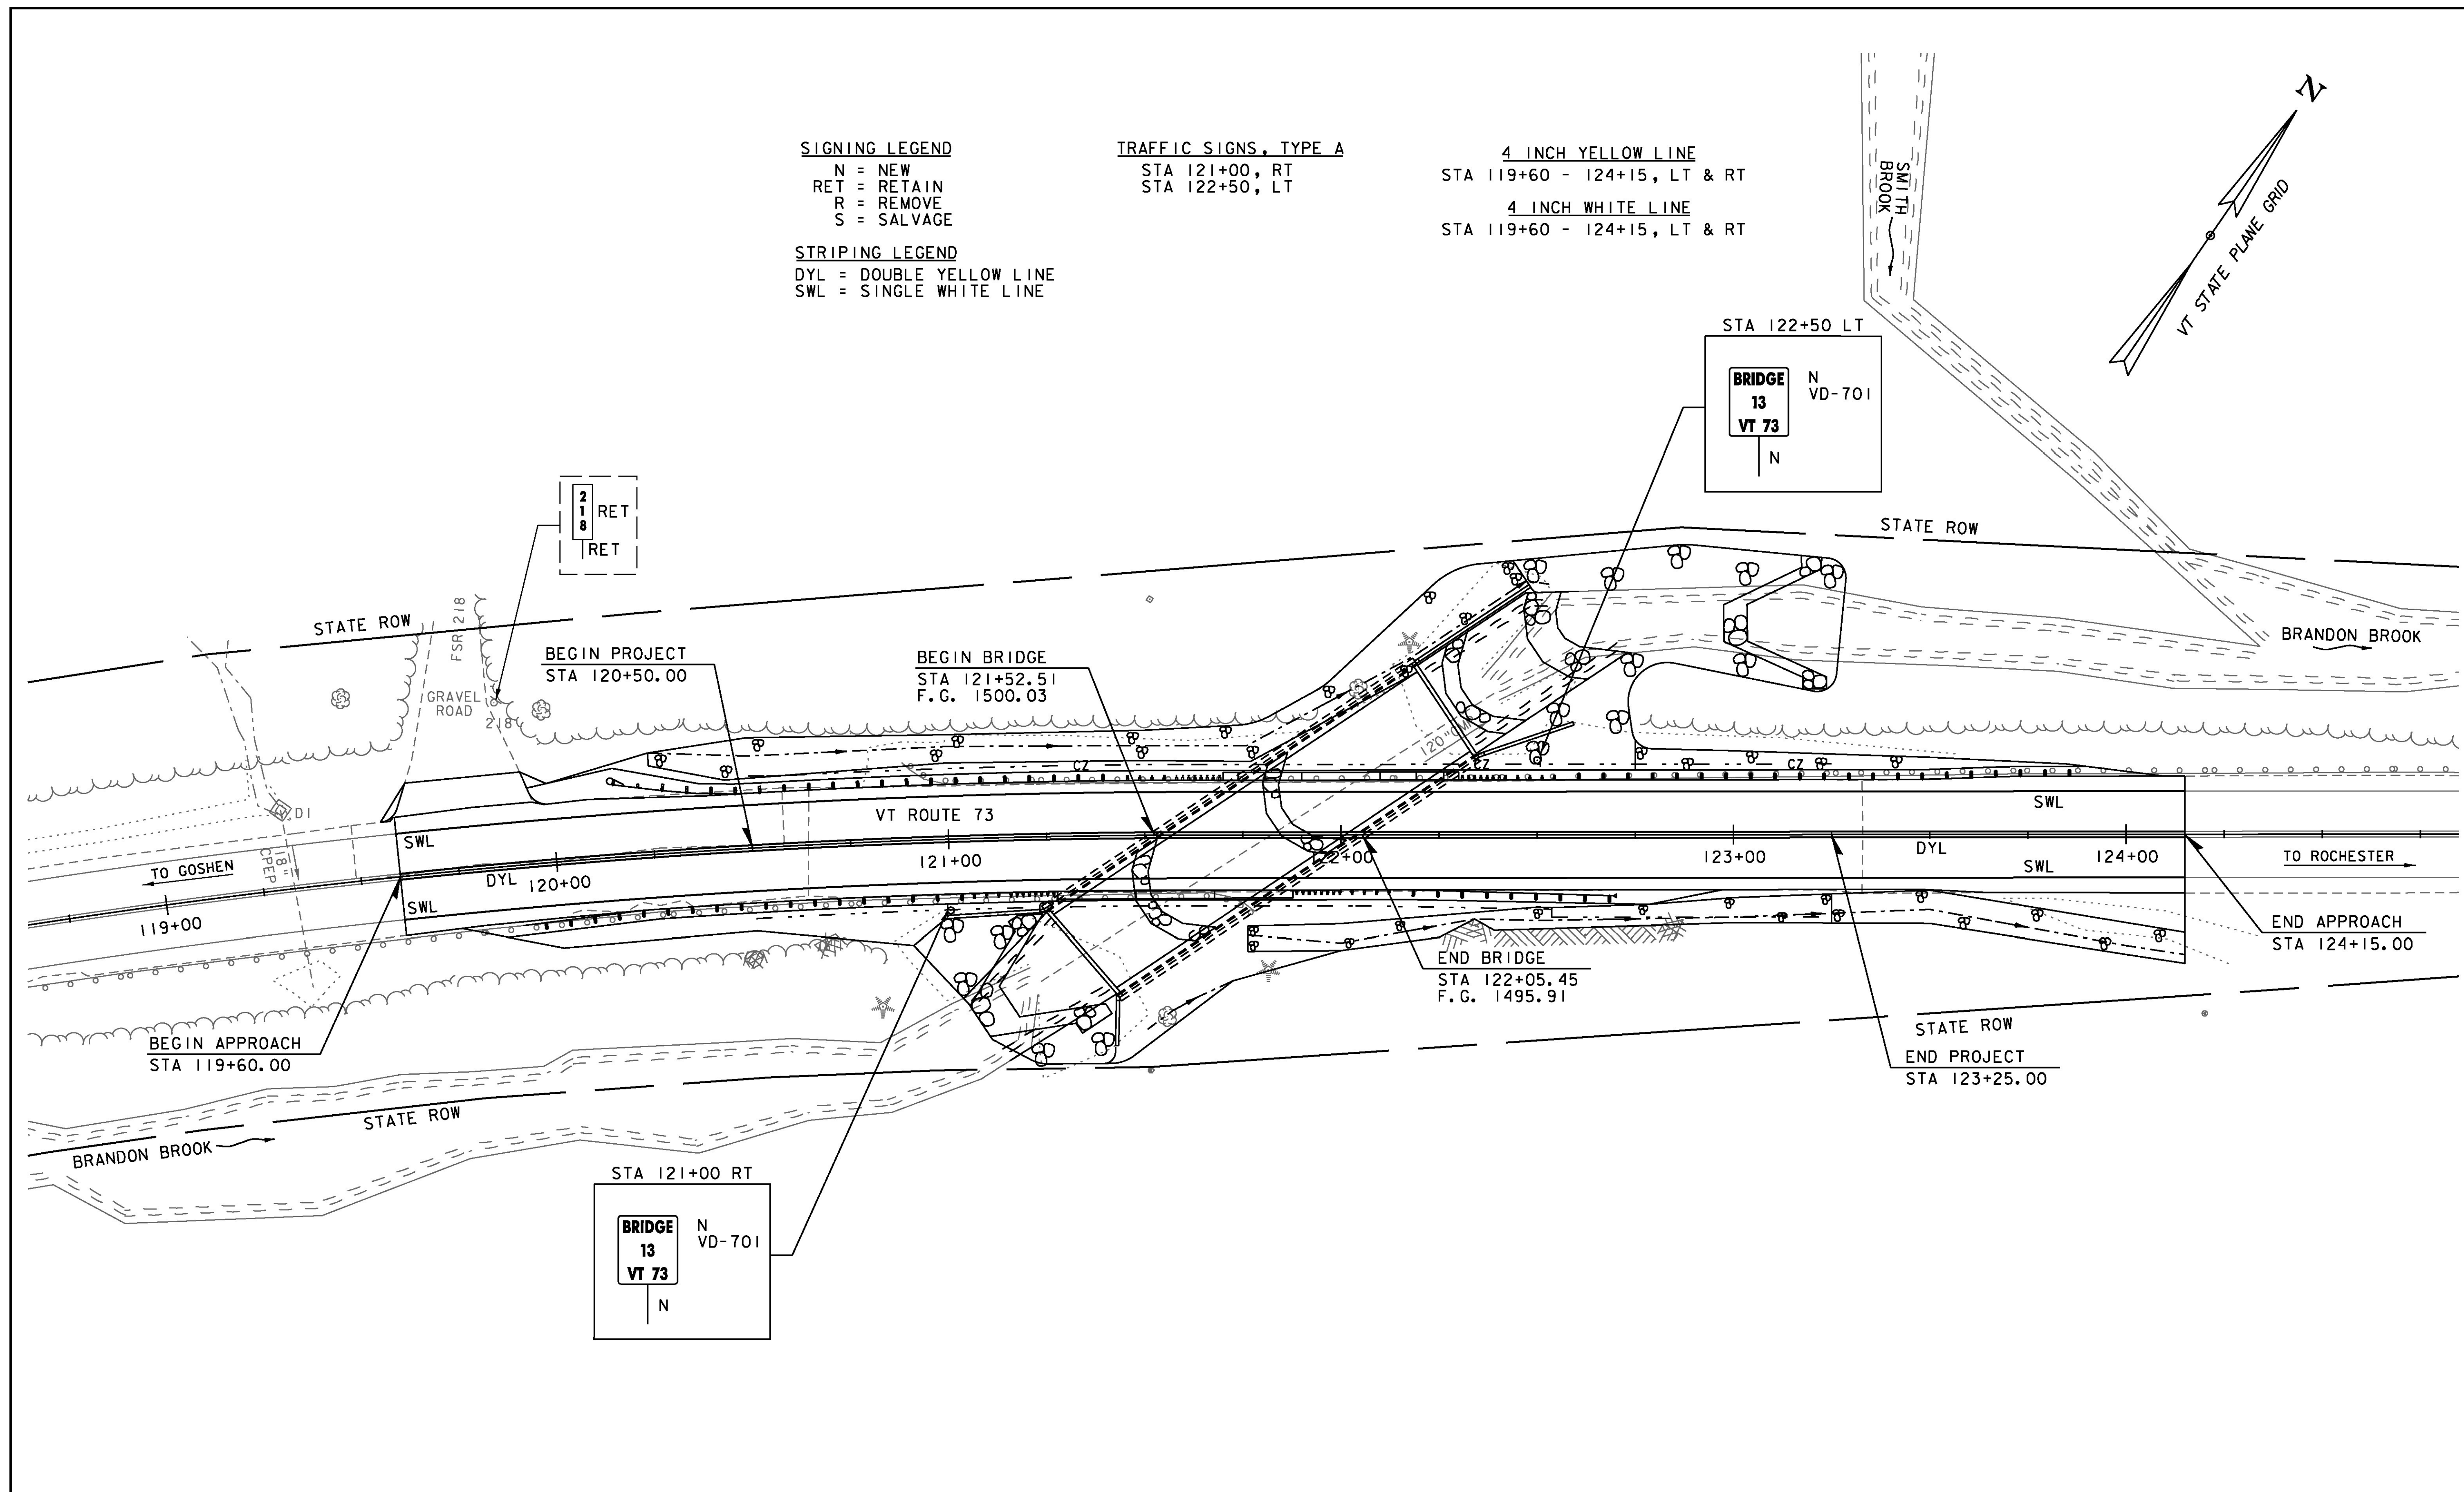

PROJECT NAME: ROCHESTER	
PROJECT NUMBER: ER STP 0162(19)	
FILE NAME: zllc334+sl.dgn	PLOT DATE: 8/19/2013
PROJECT LEADER: S.E. BURBANK	DRAWN BY: C.L. CILLEY
DESIGNED BY: C.L. CILLEY	CHECKED BY: S.E. BURBANK
BR 13 TRAFFIC SIGNS & LINE STRIPING SHEET SHEET 31 OF 238	