




FOOTING PLAN
SCALE 1/8" = 1'-0"

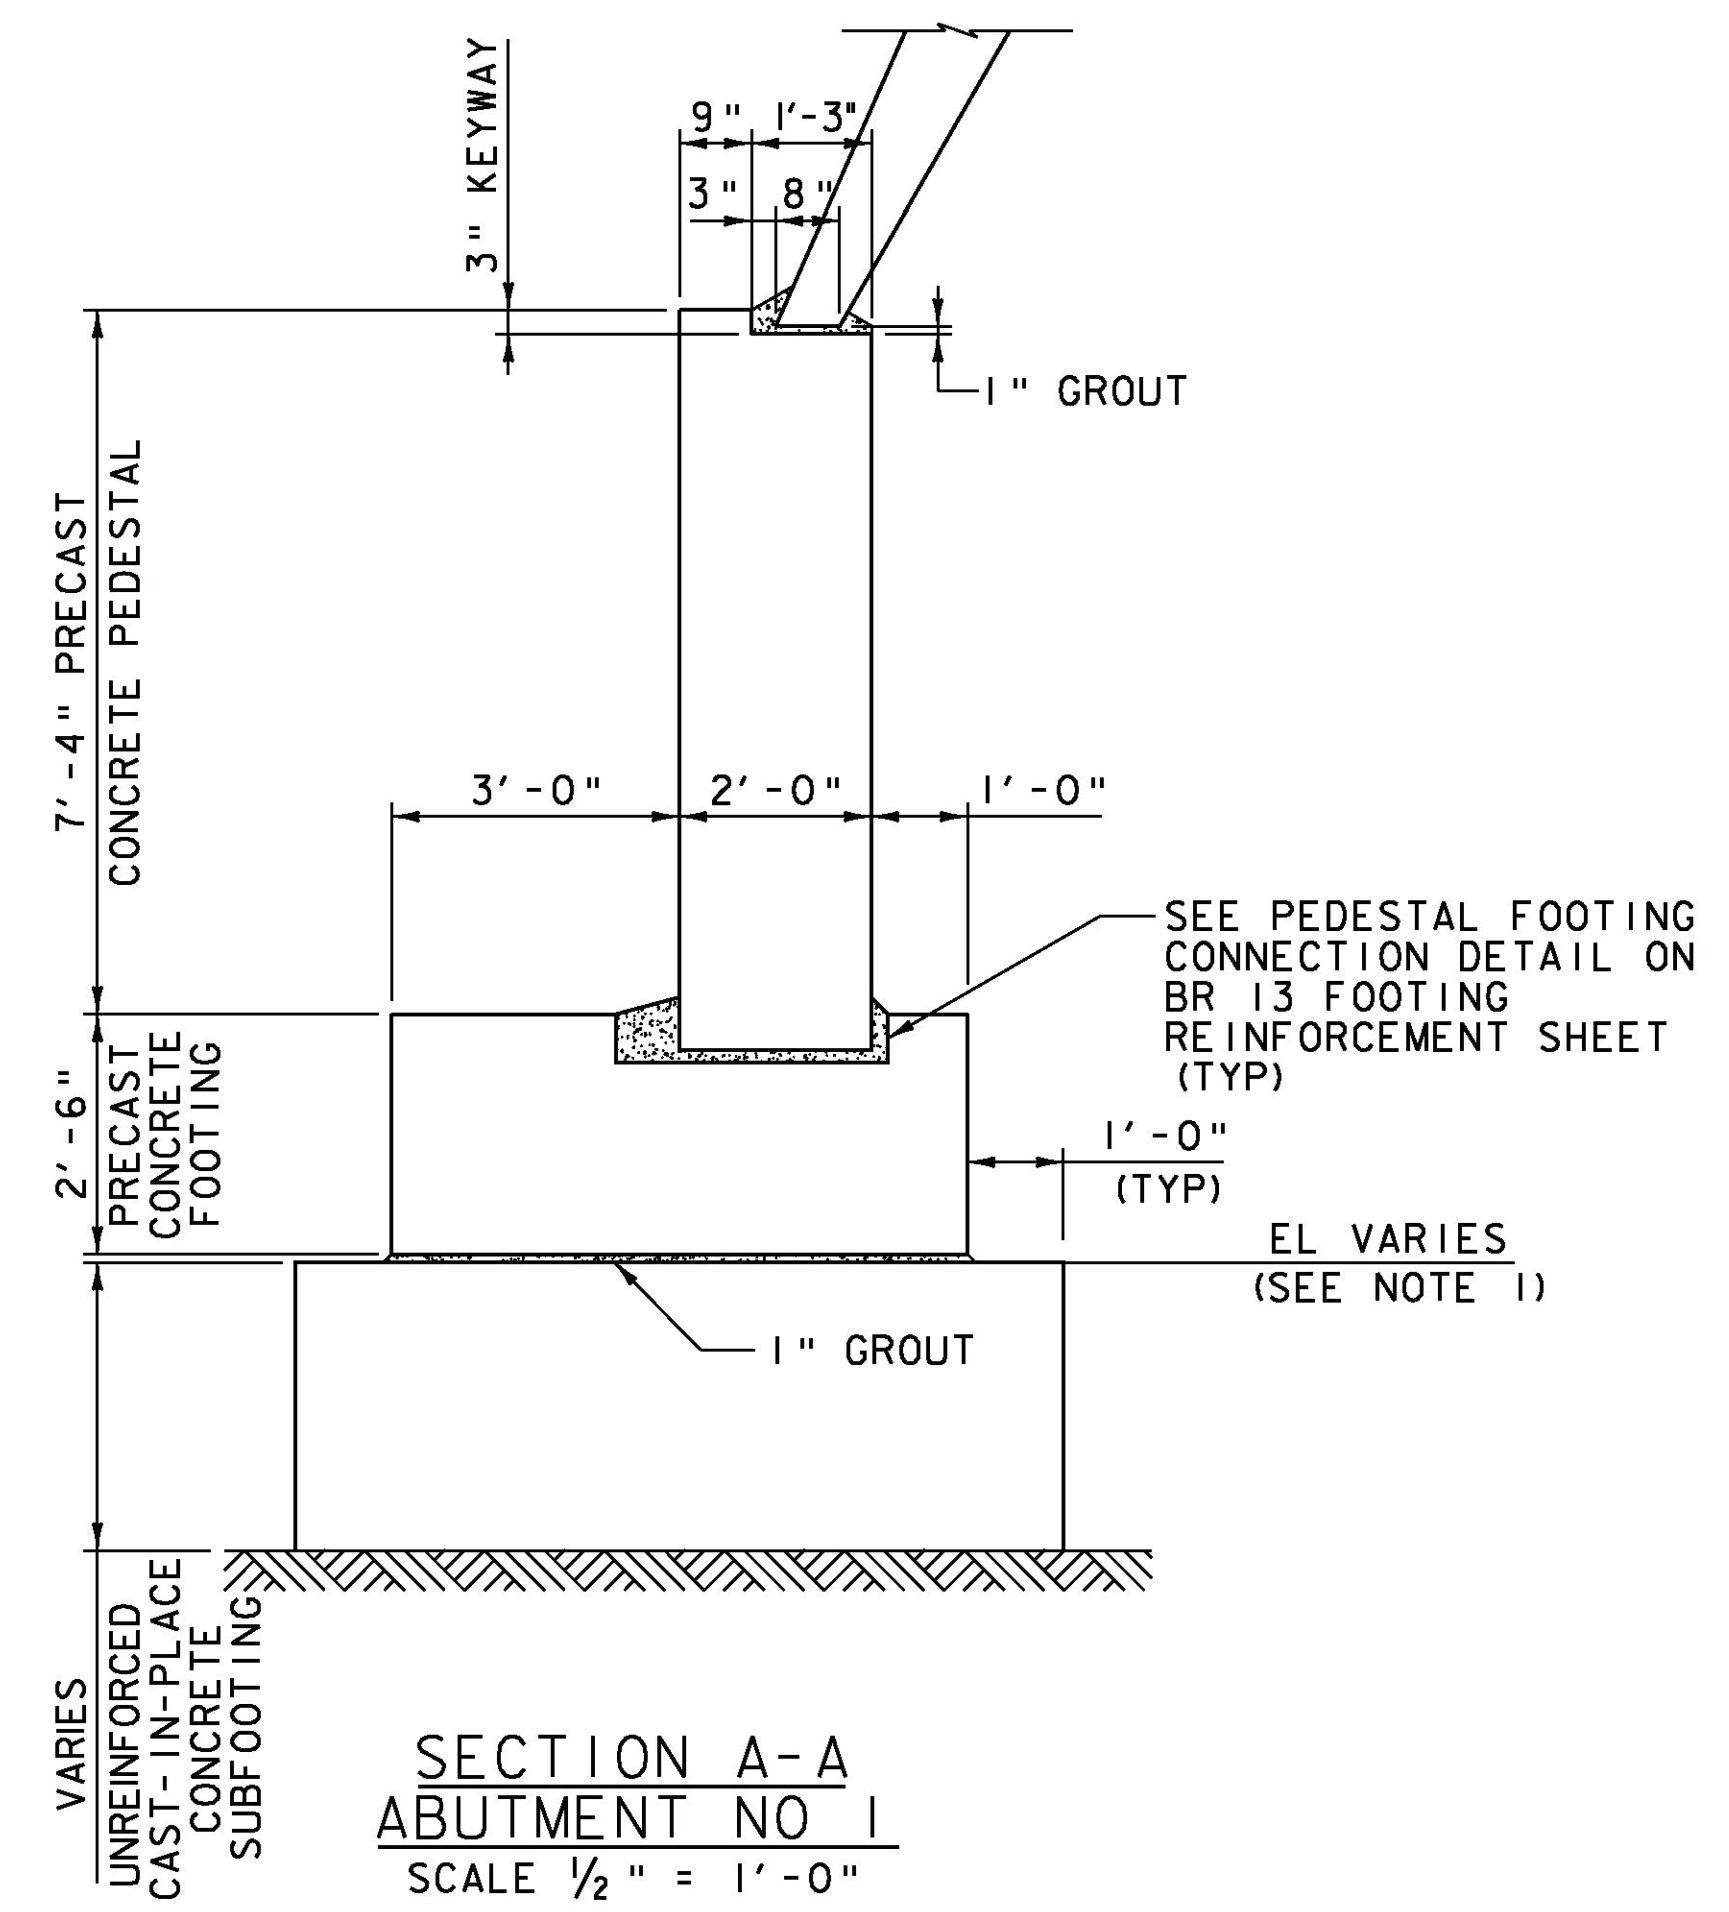

SECTION A-A
ABUTMENT NO 1
SCALE 1/2" = 1'-0"

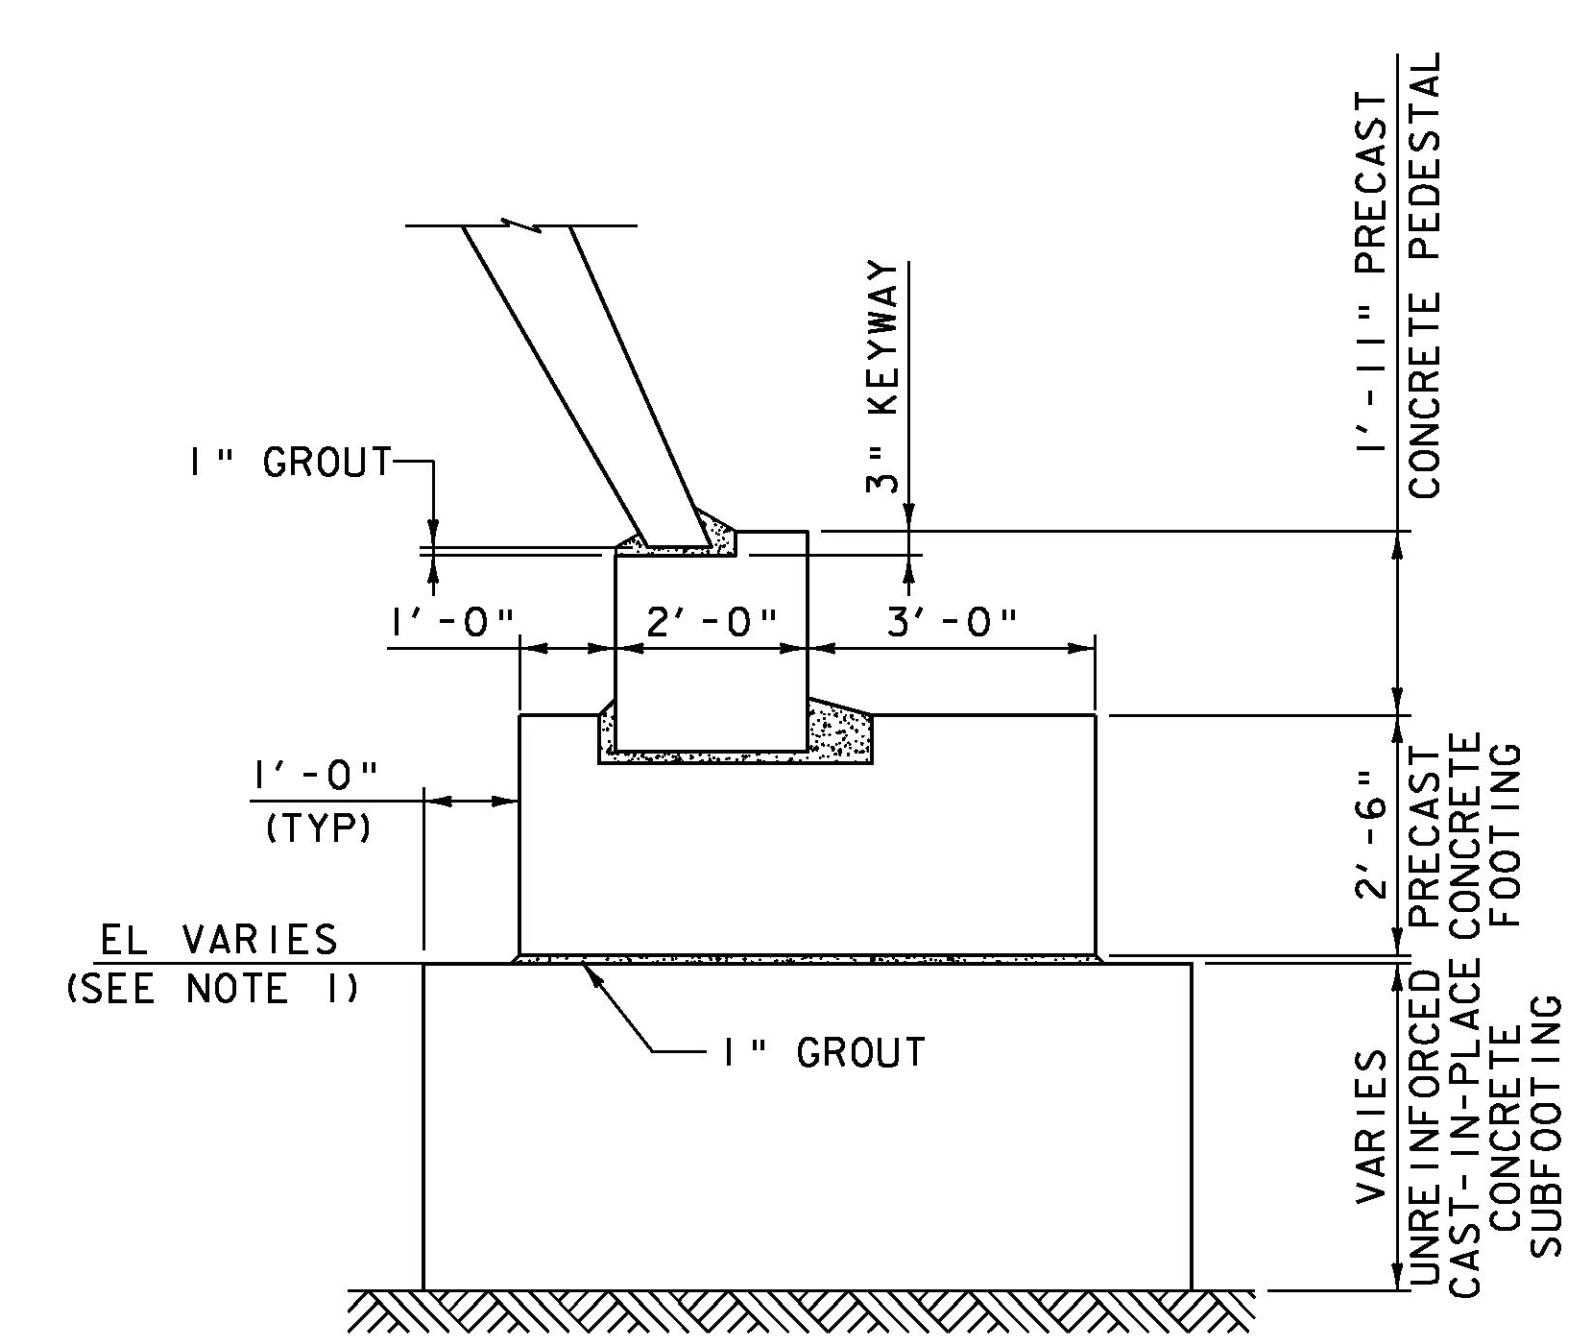

SECTION B-B
ABUTMENT NO 2
SCALE 1/2" = 1'-0"

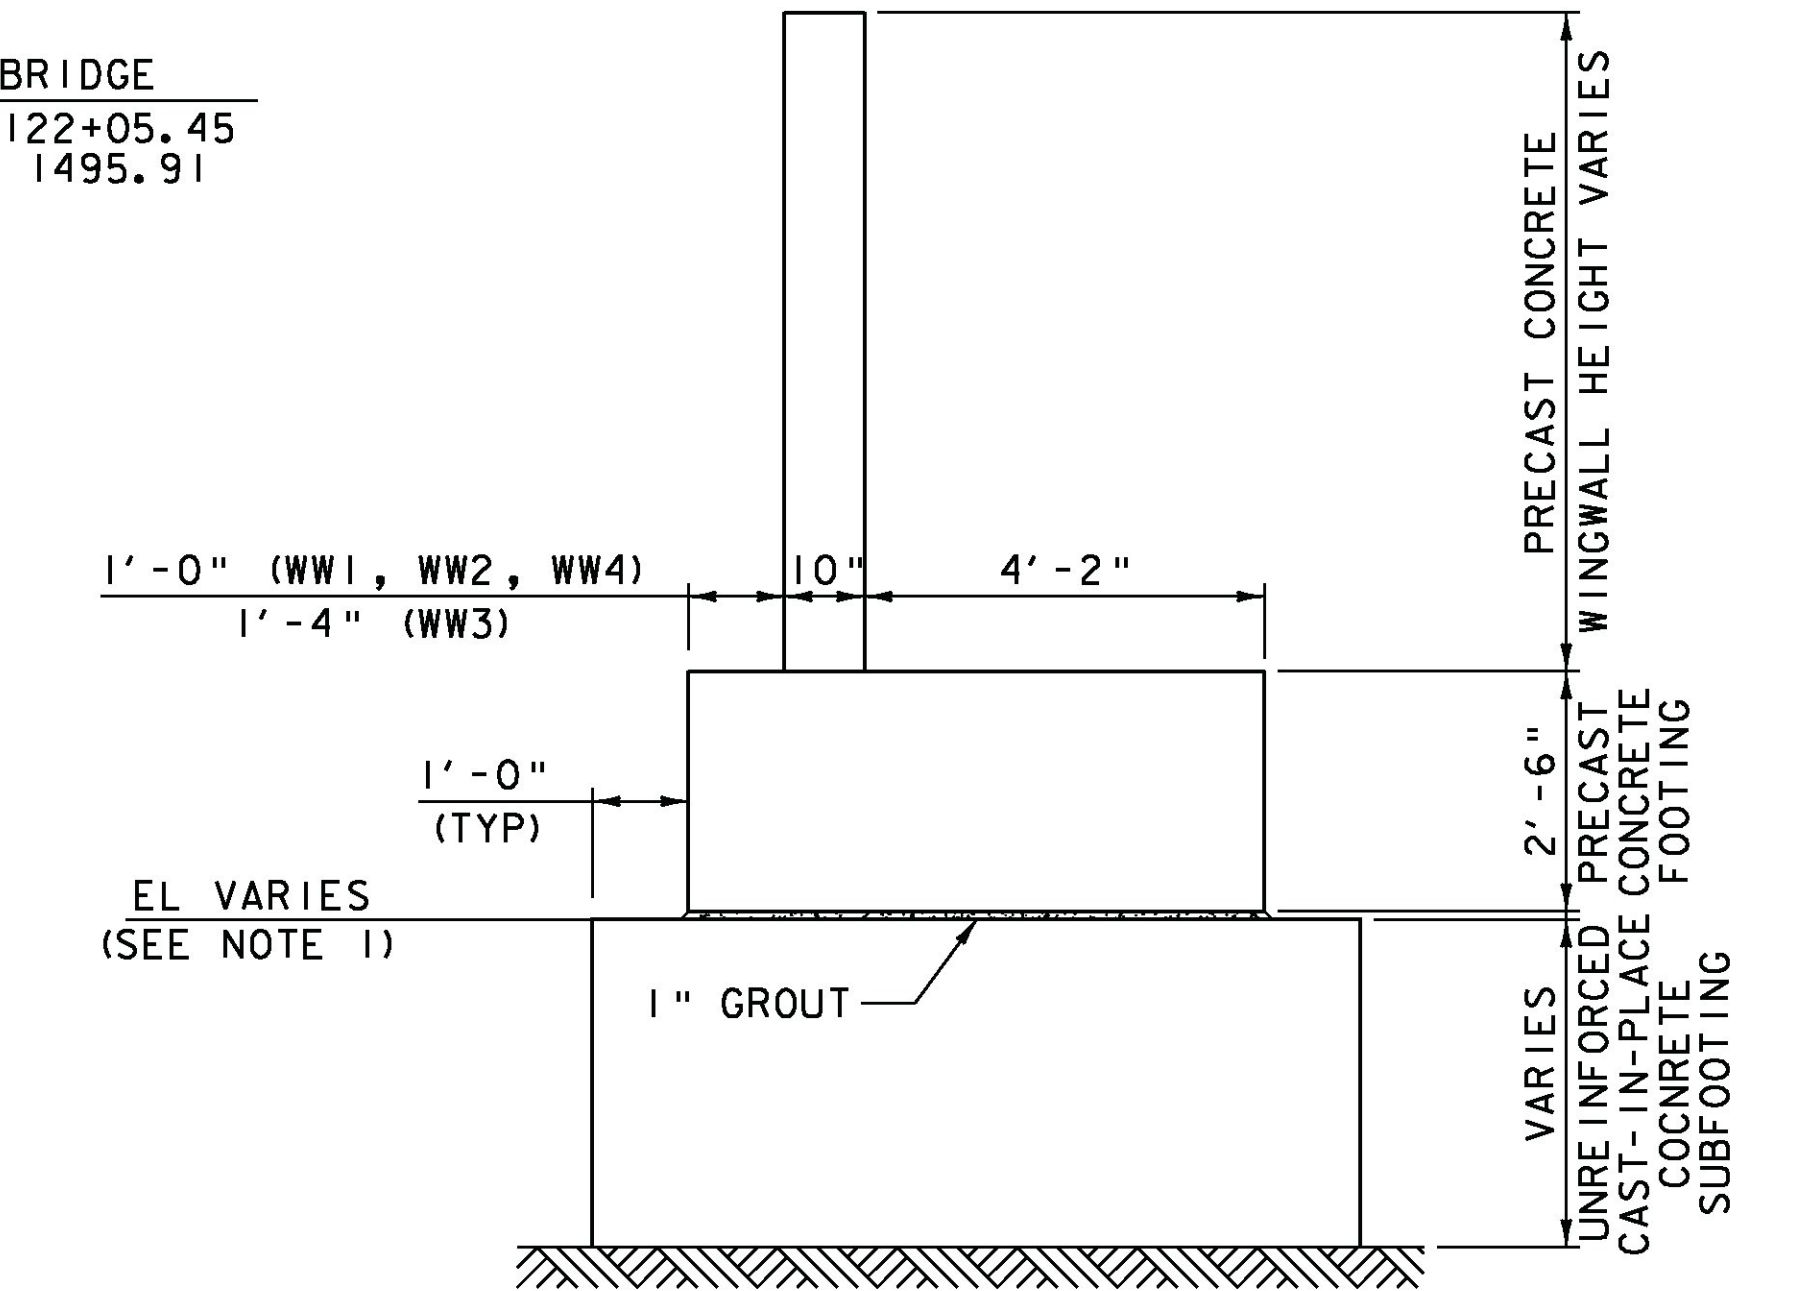

SECTION C-C
TYPICAL WINGWALL SECTION
SCALE 1/2" = 1'-0"

NOTE:

- 1. SEE BR 13 ABUTMENT ELEVATIONS SHEET FOR TOP OF FOOTING ELEVATIONS.



PROJECT NAME: ROCHESTER	PLOT DATE: 8/19/2013
PROJECT NUMBER: ER STP 0162(19)	DRAWN BY: E.A. FIALA
FILE NAME: zilc334sub.dgn	CHECKED BY: L.S. CHERVINCKY
PROJECT LEADER: S.E. BURBANK	SHEET 40 OF 238
DESIGNED BY: E.A. FIALA	
BR 13 FOOTING PLAN	