




119+50

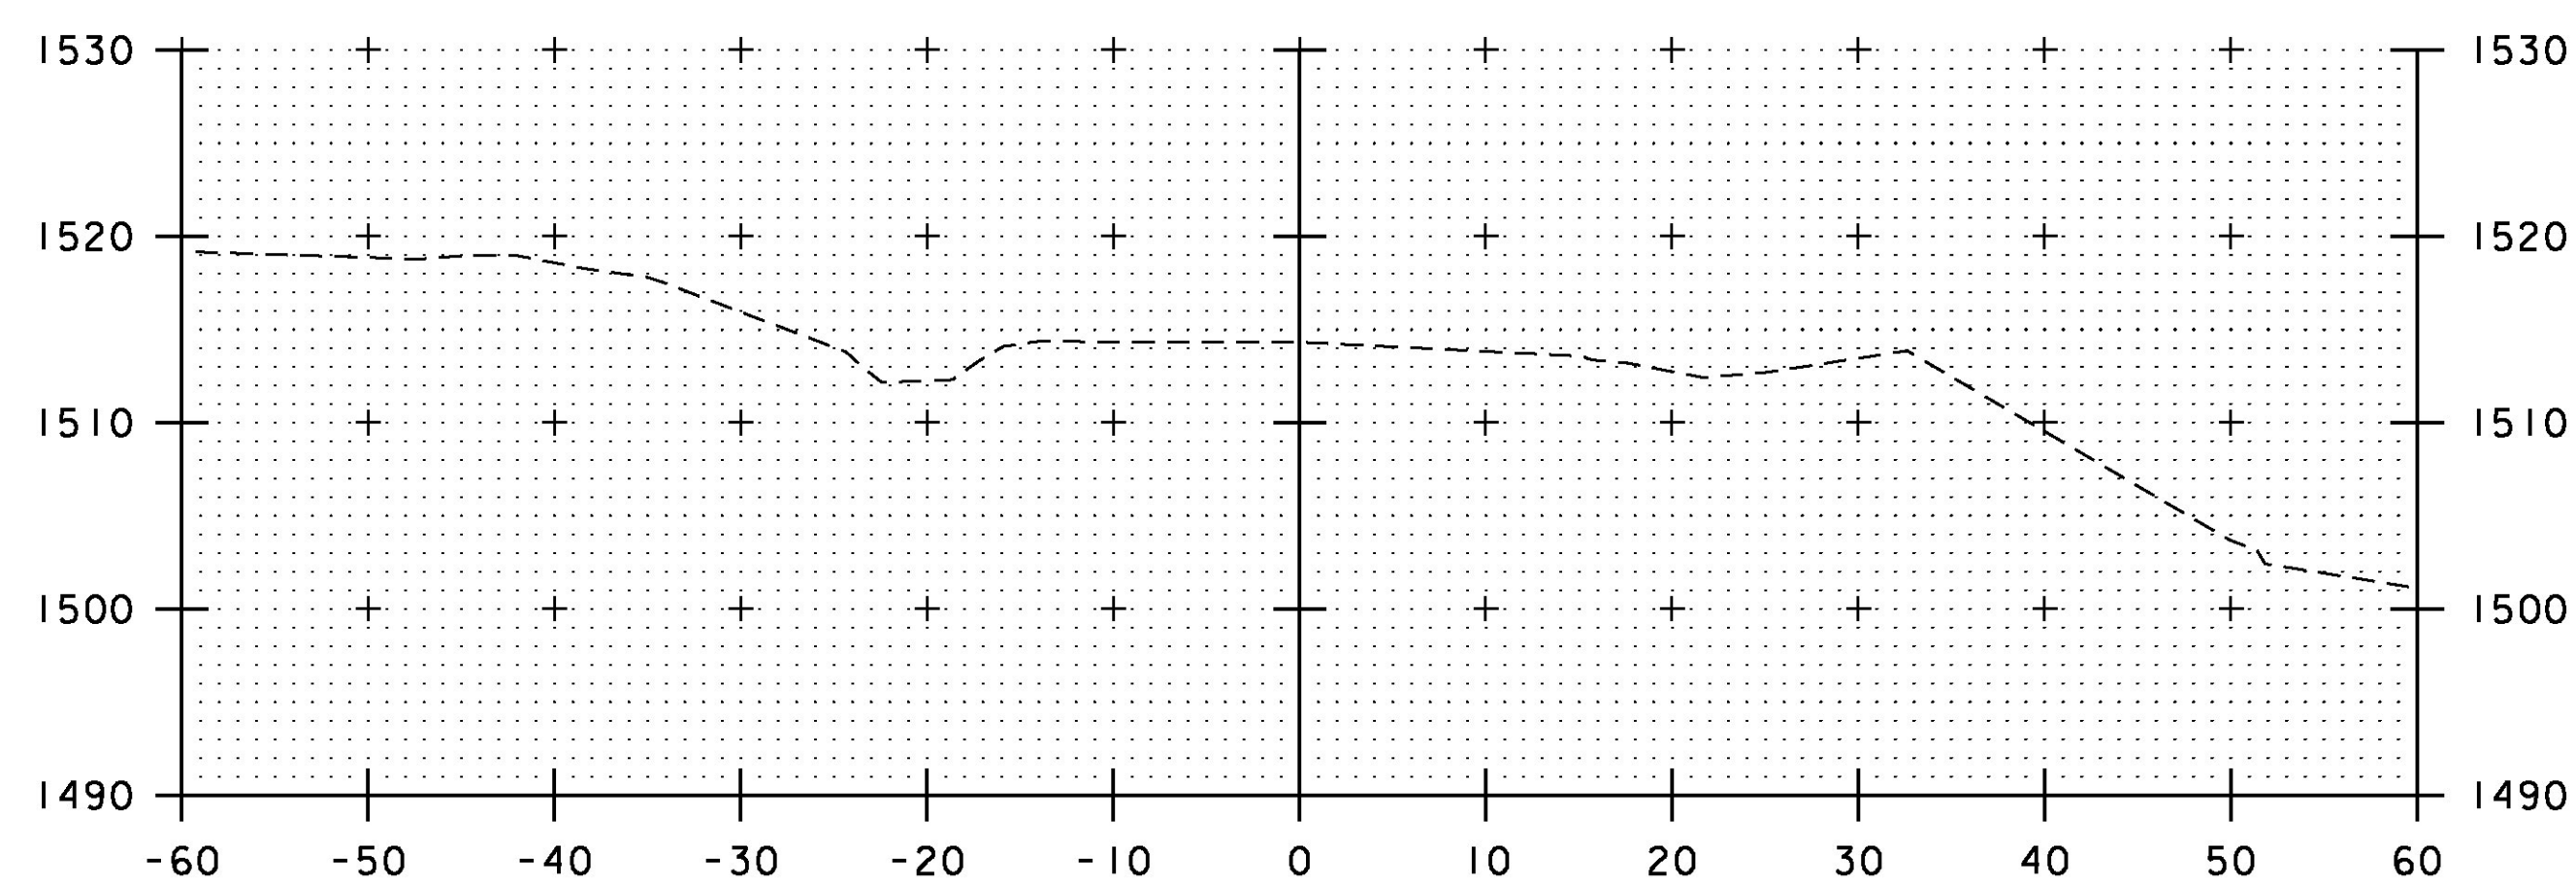

119+00

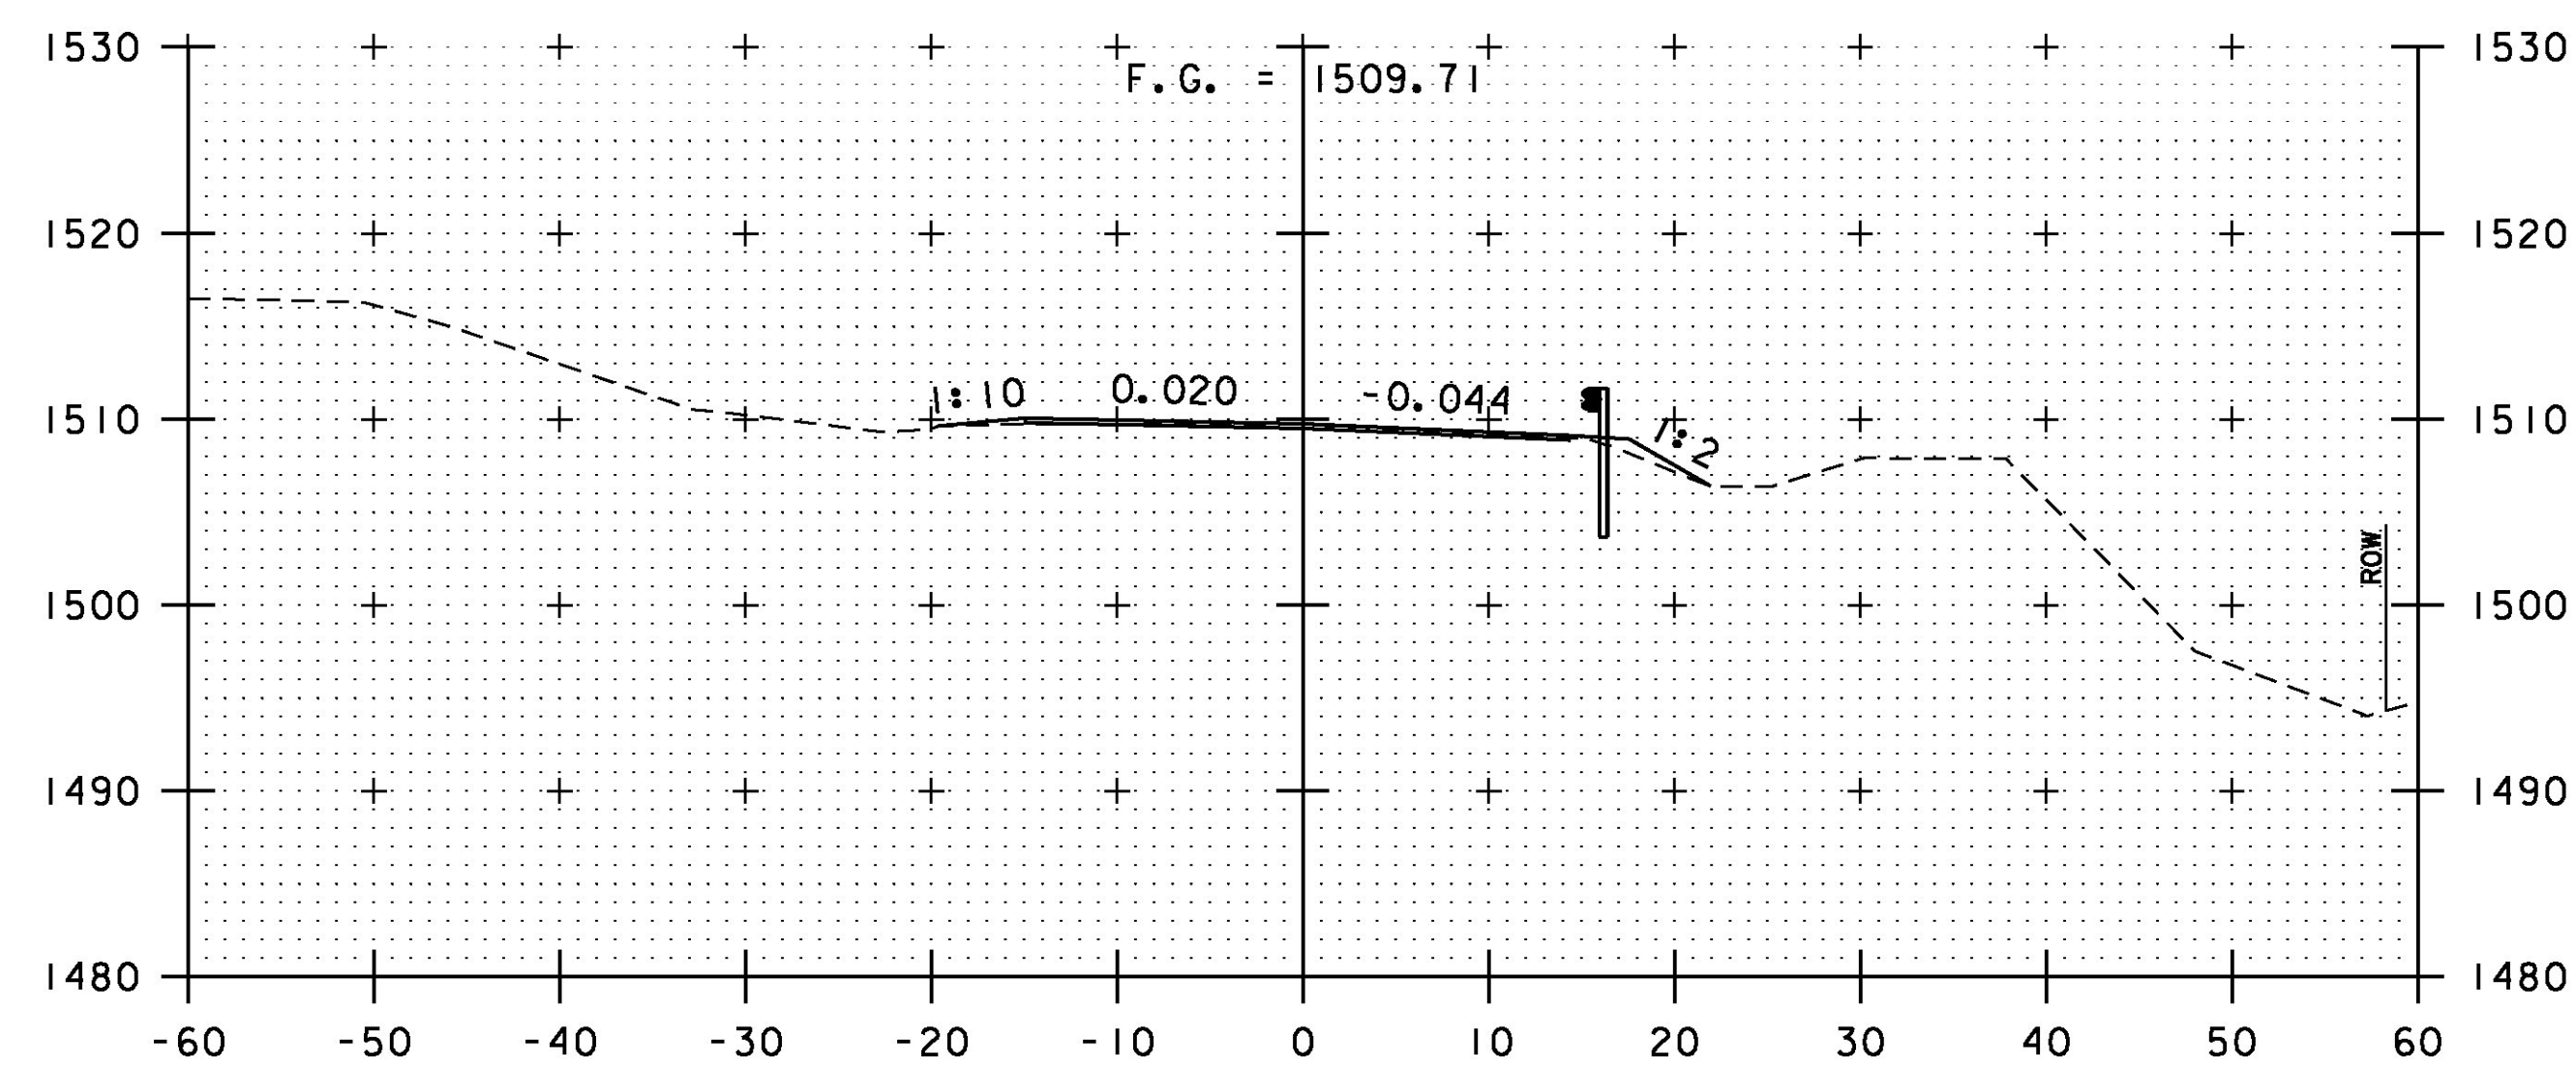

120+00

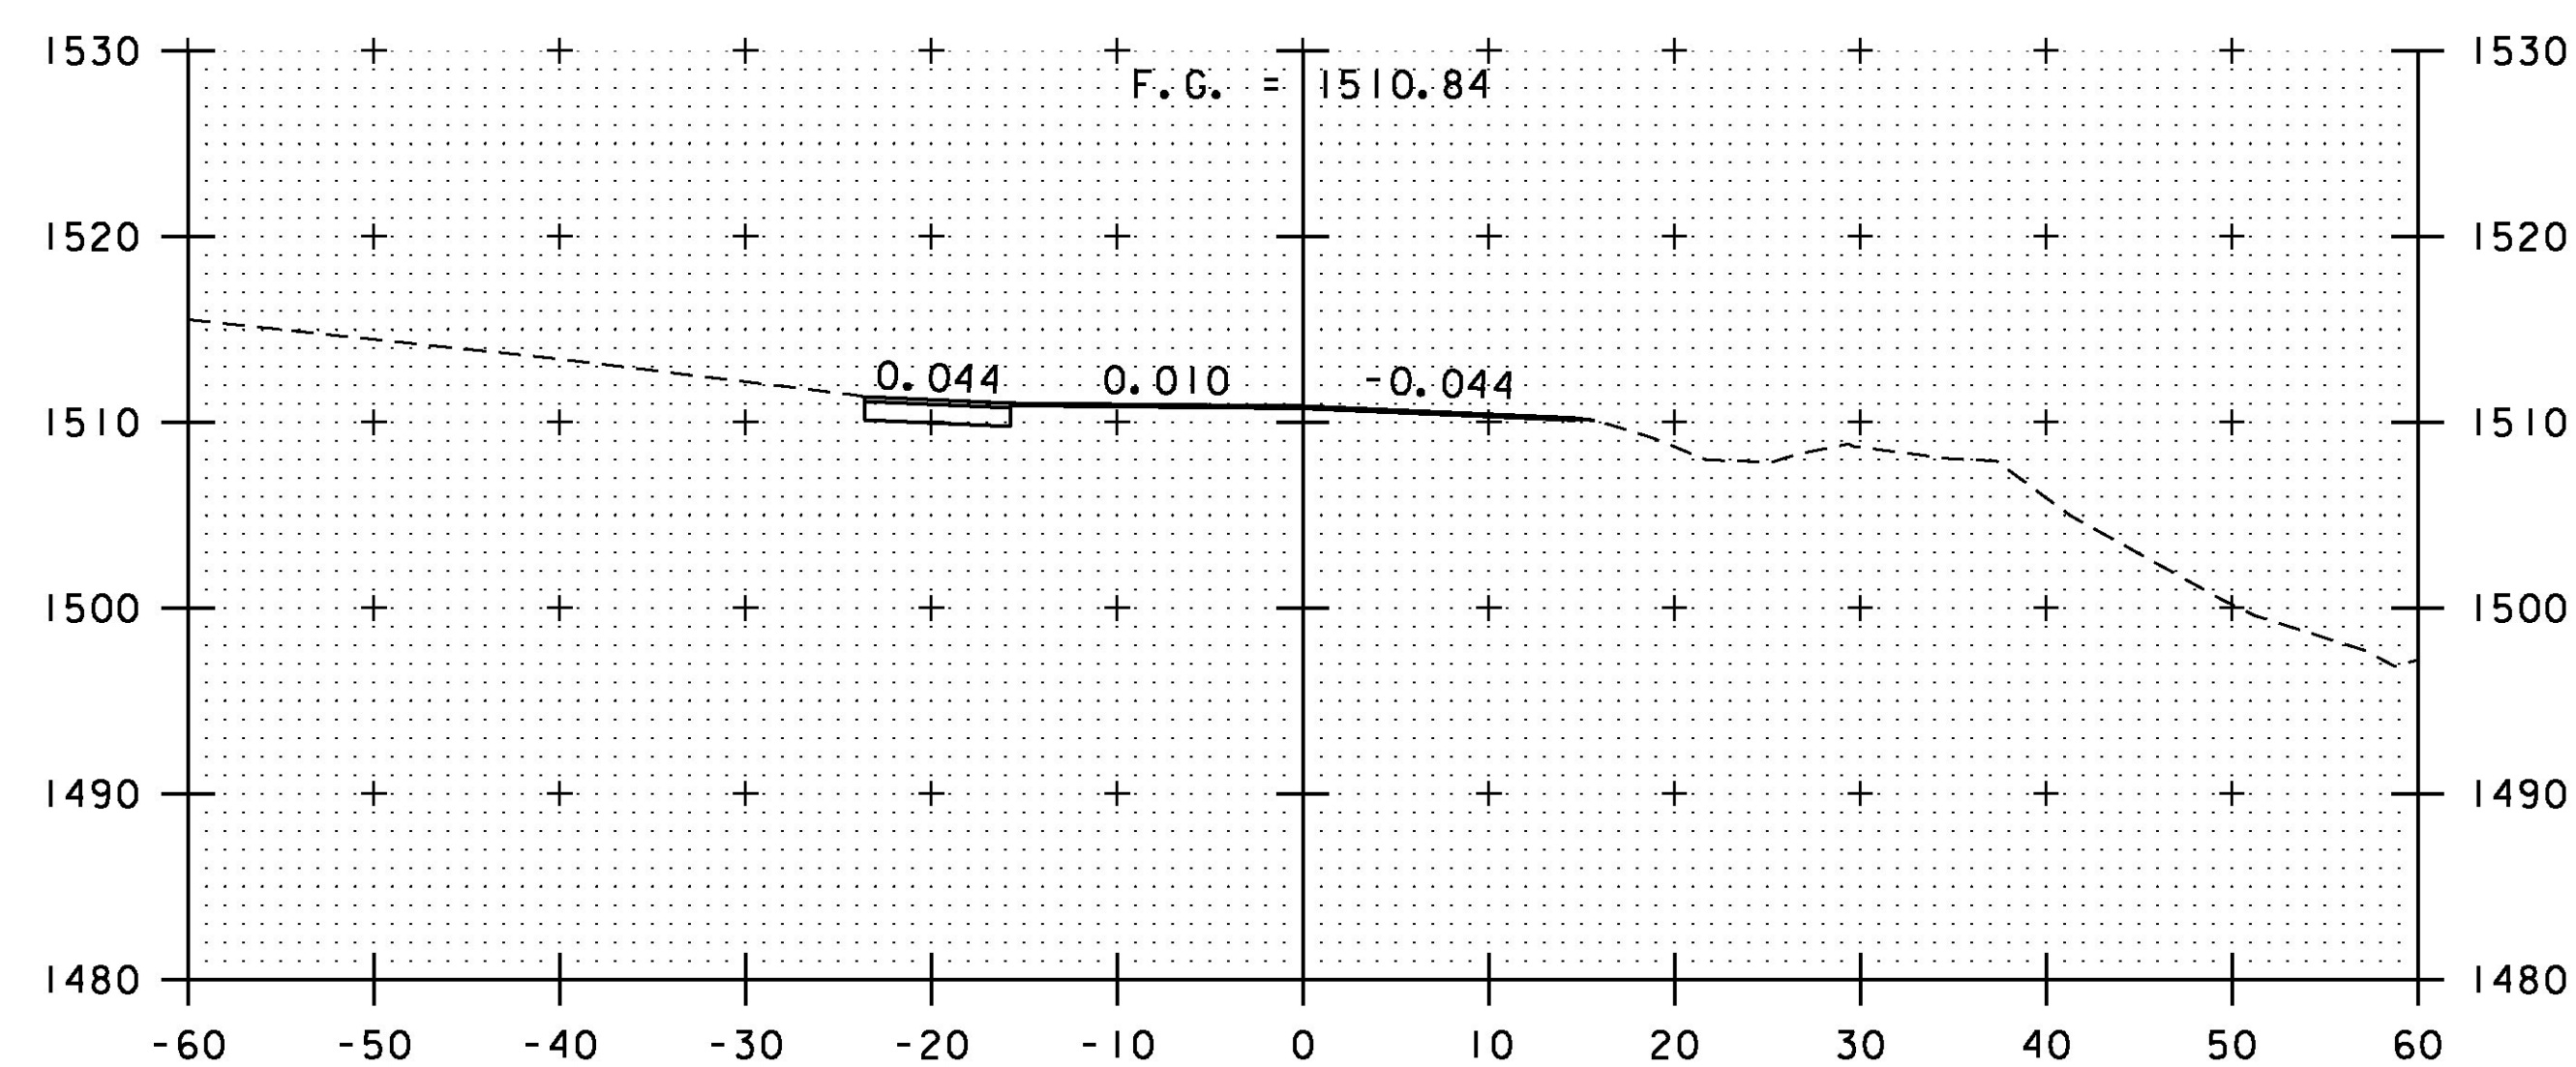

119+78 DRIVE, LT

BEGIN APPROACH
STA 119+60

VT 73 CROSS SECTIONS
STA 119+00 TO STA 120+00



PROJECT NAME:	ROCHESTER
PROJECT NUMBER:	ER STP 0162(19)
FILE NAME:	zllc334xsl.dgn
PROJECT LEADER:	S.E. BURBANK
DESIGNED BY:	C.L. CILLEY
BR 13 VT 73 CROSS SECTIONS (1 OF 4)	
PLOT DATE:	8/19/2013
DRAWN BY:	C.L. CILLEY
CHECKED BY:	D.M. PECK
SHEET	46 OF 238