




123+00

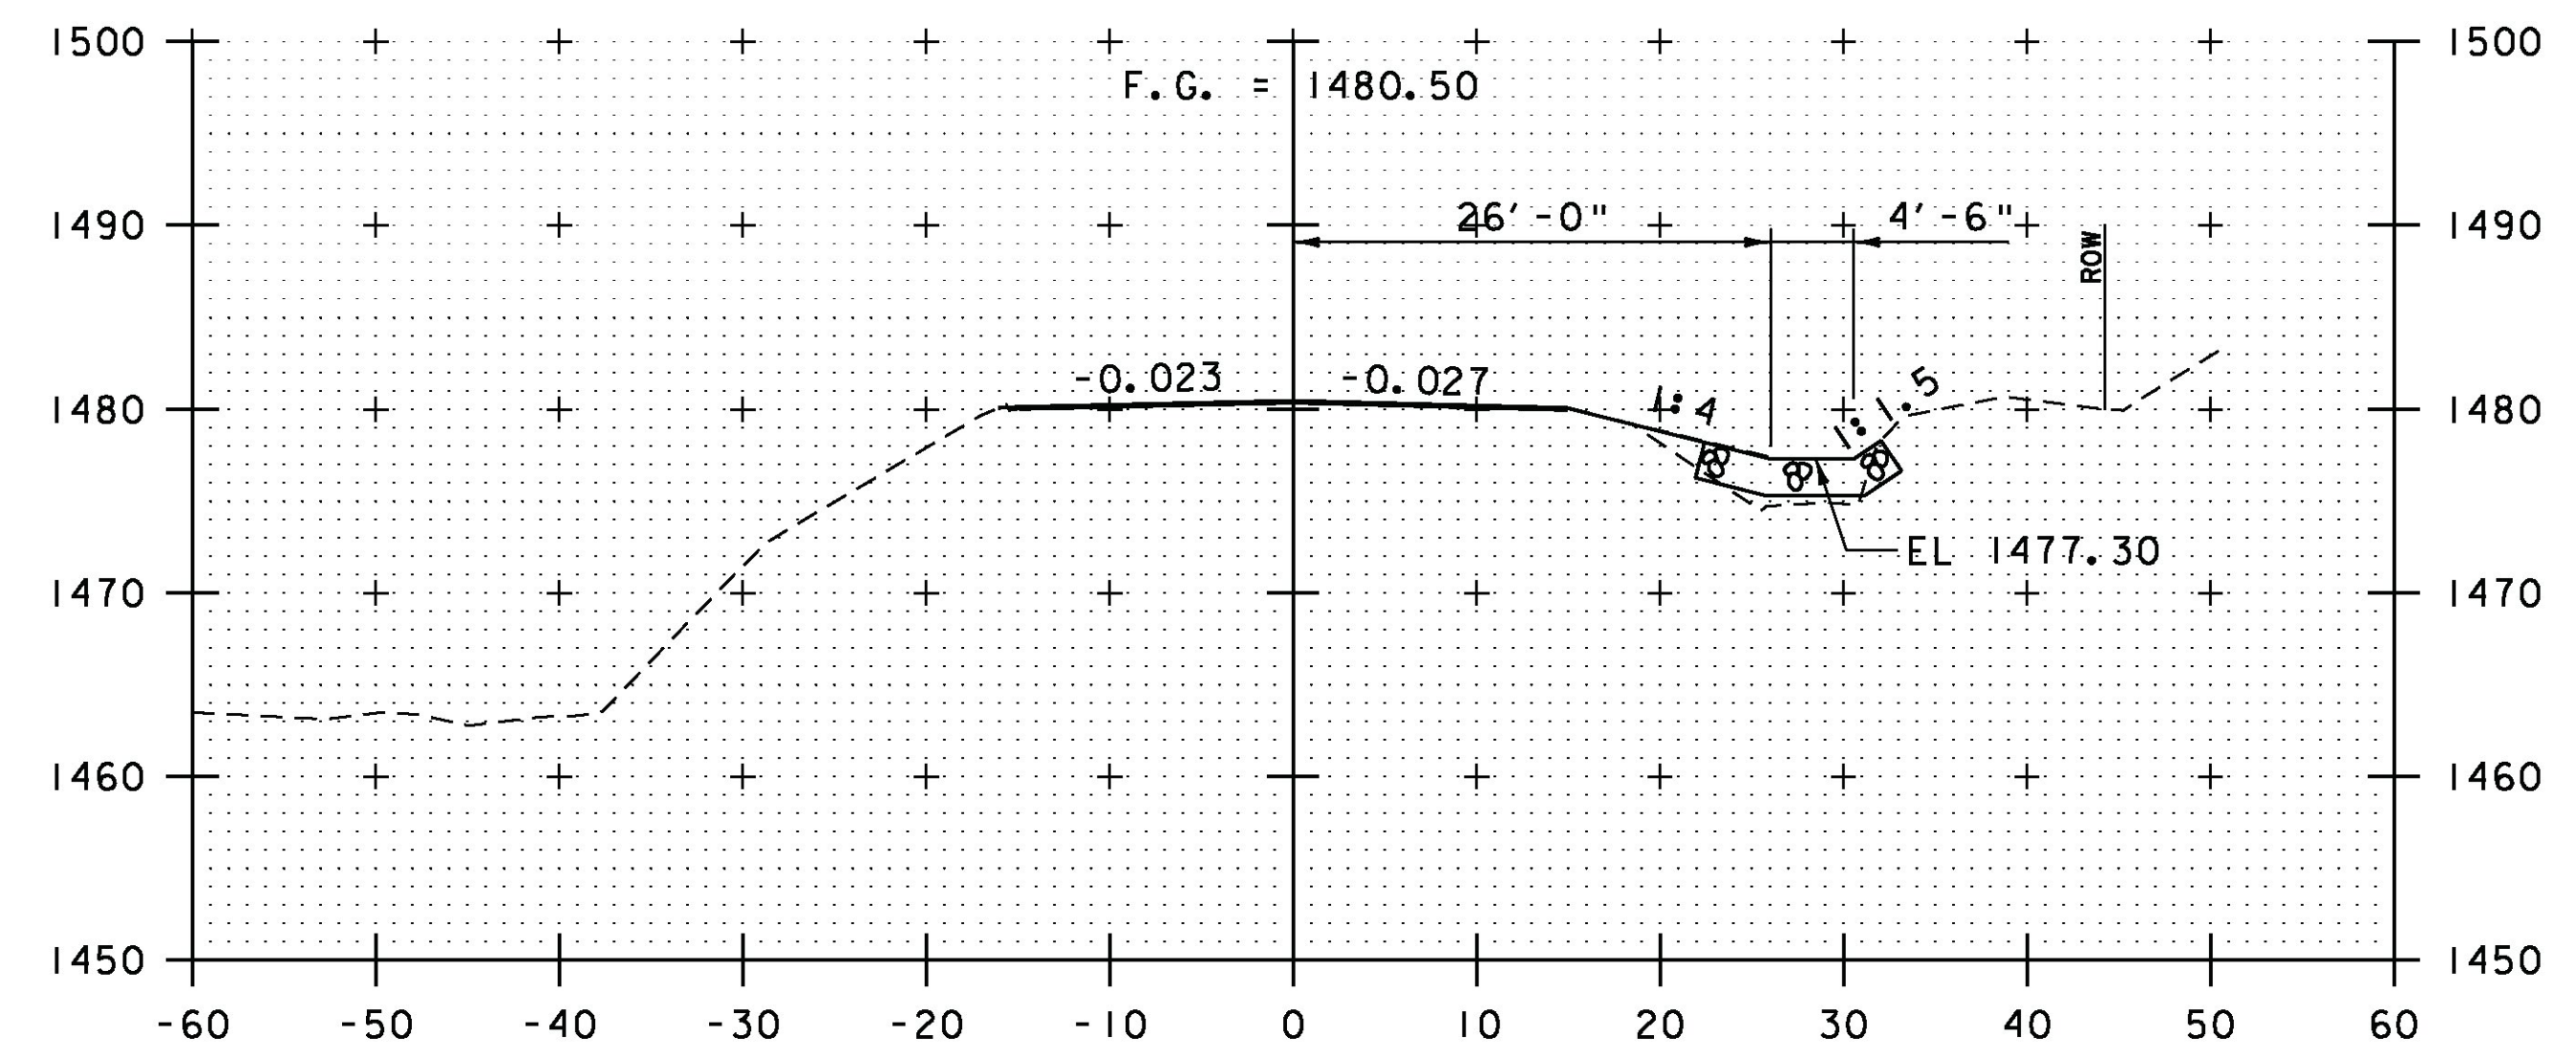

124+00

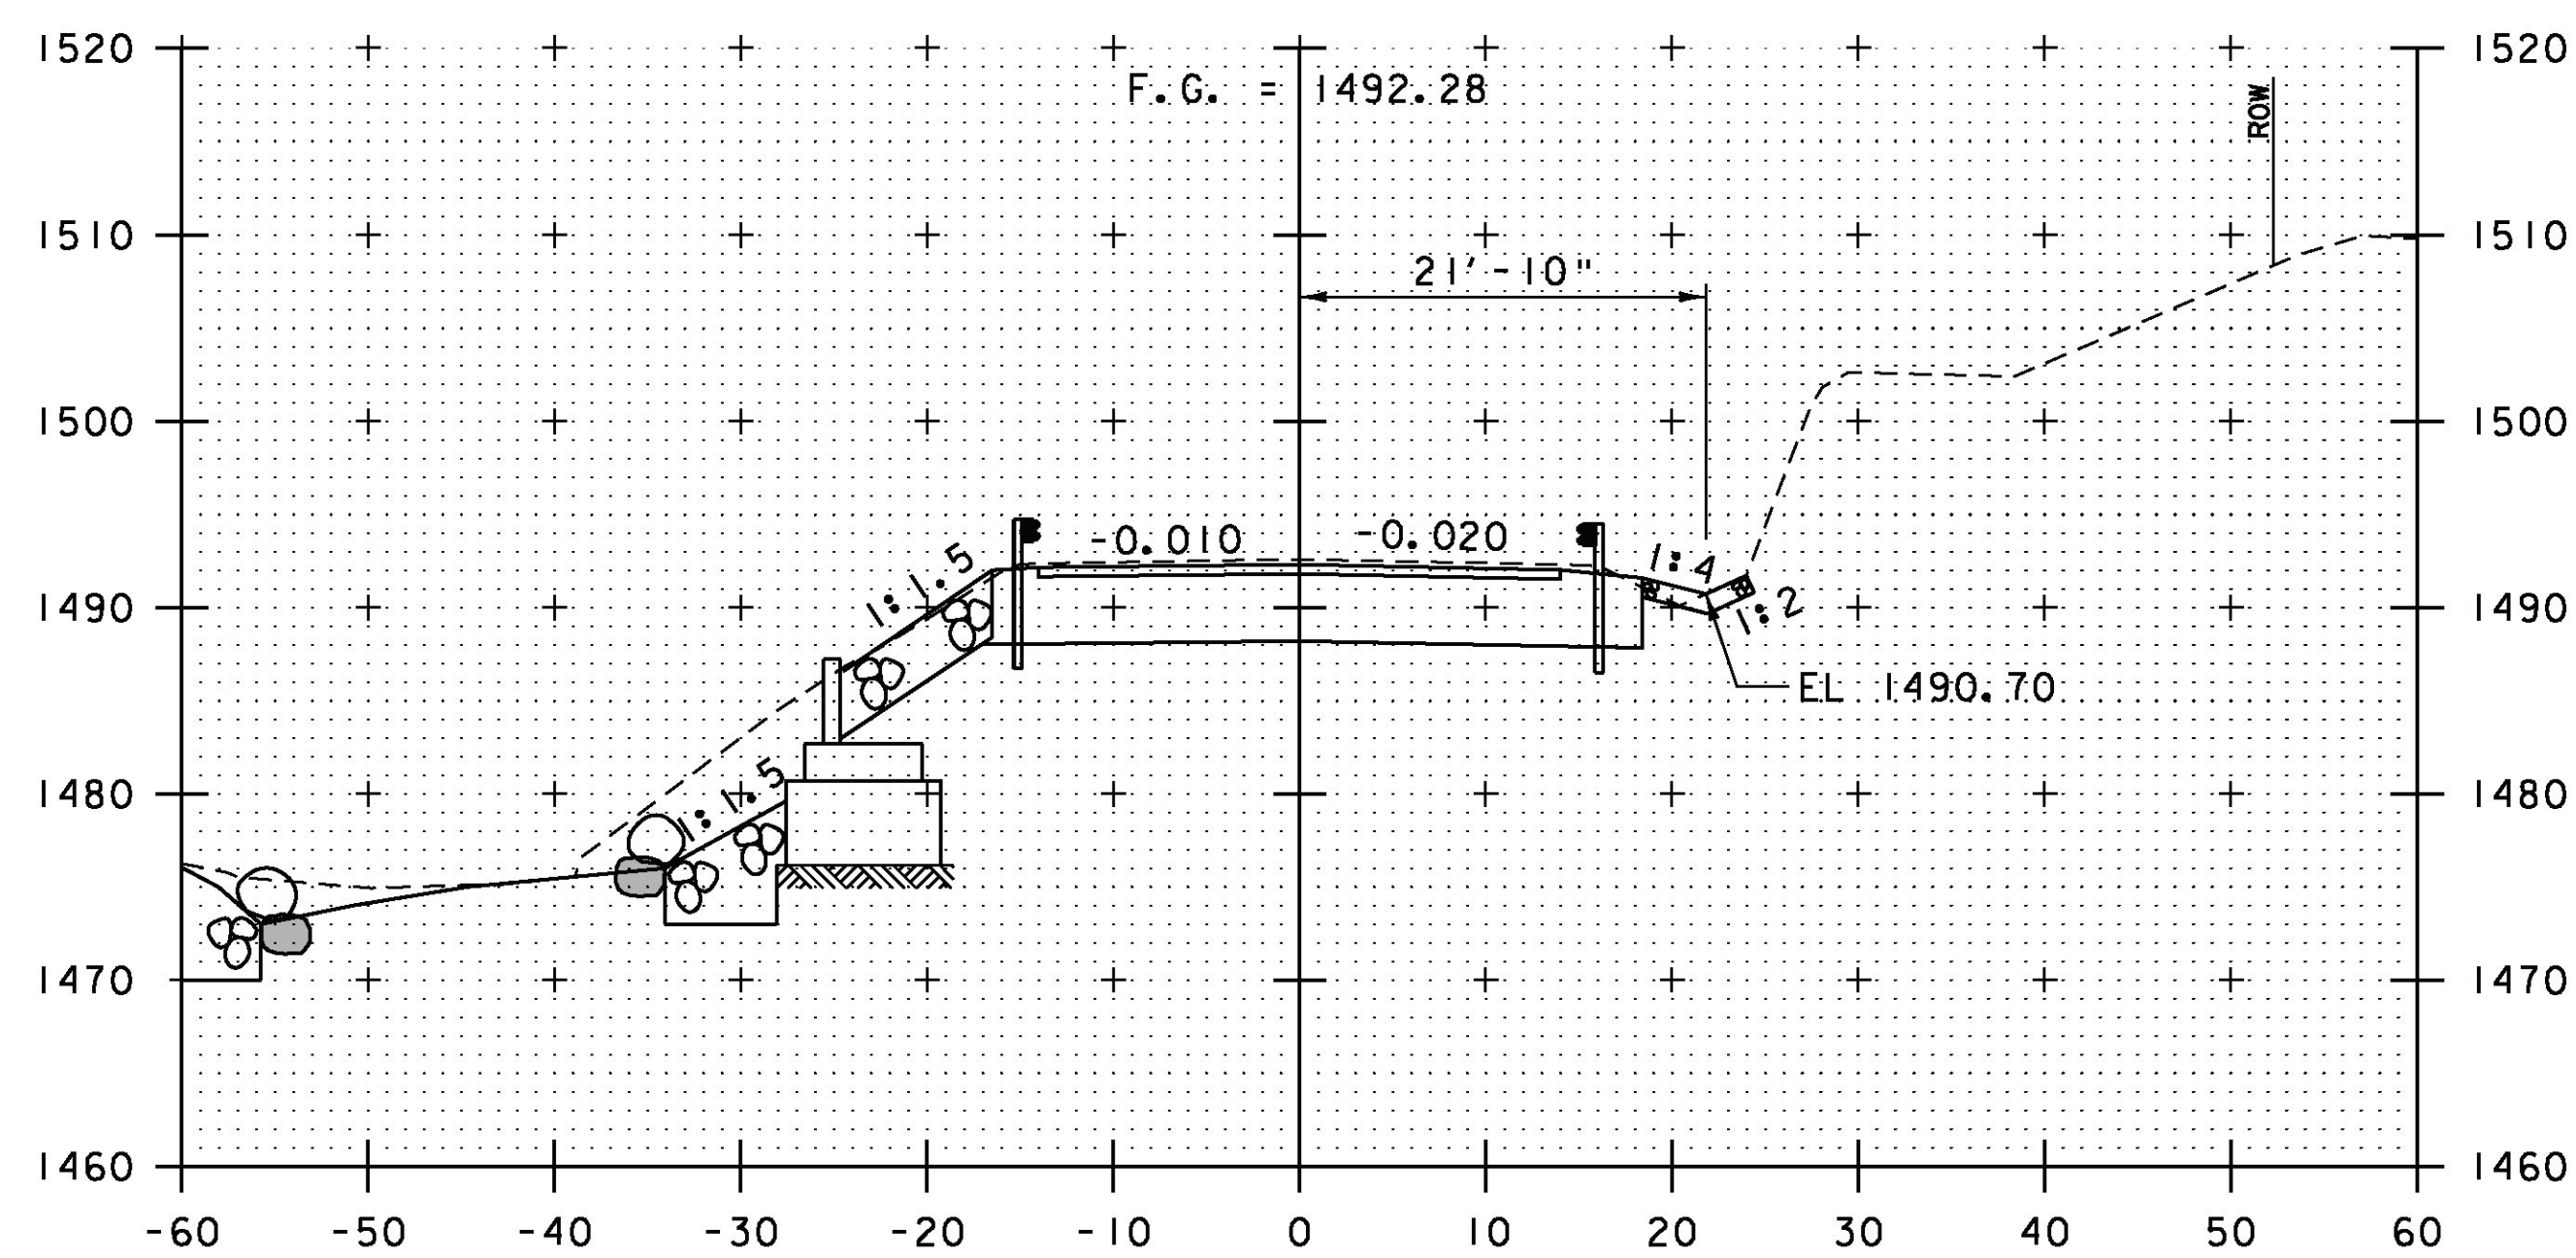

122+50

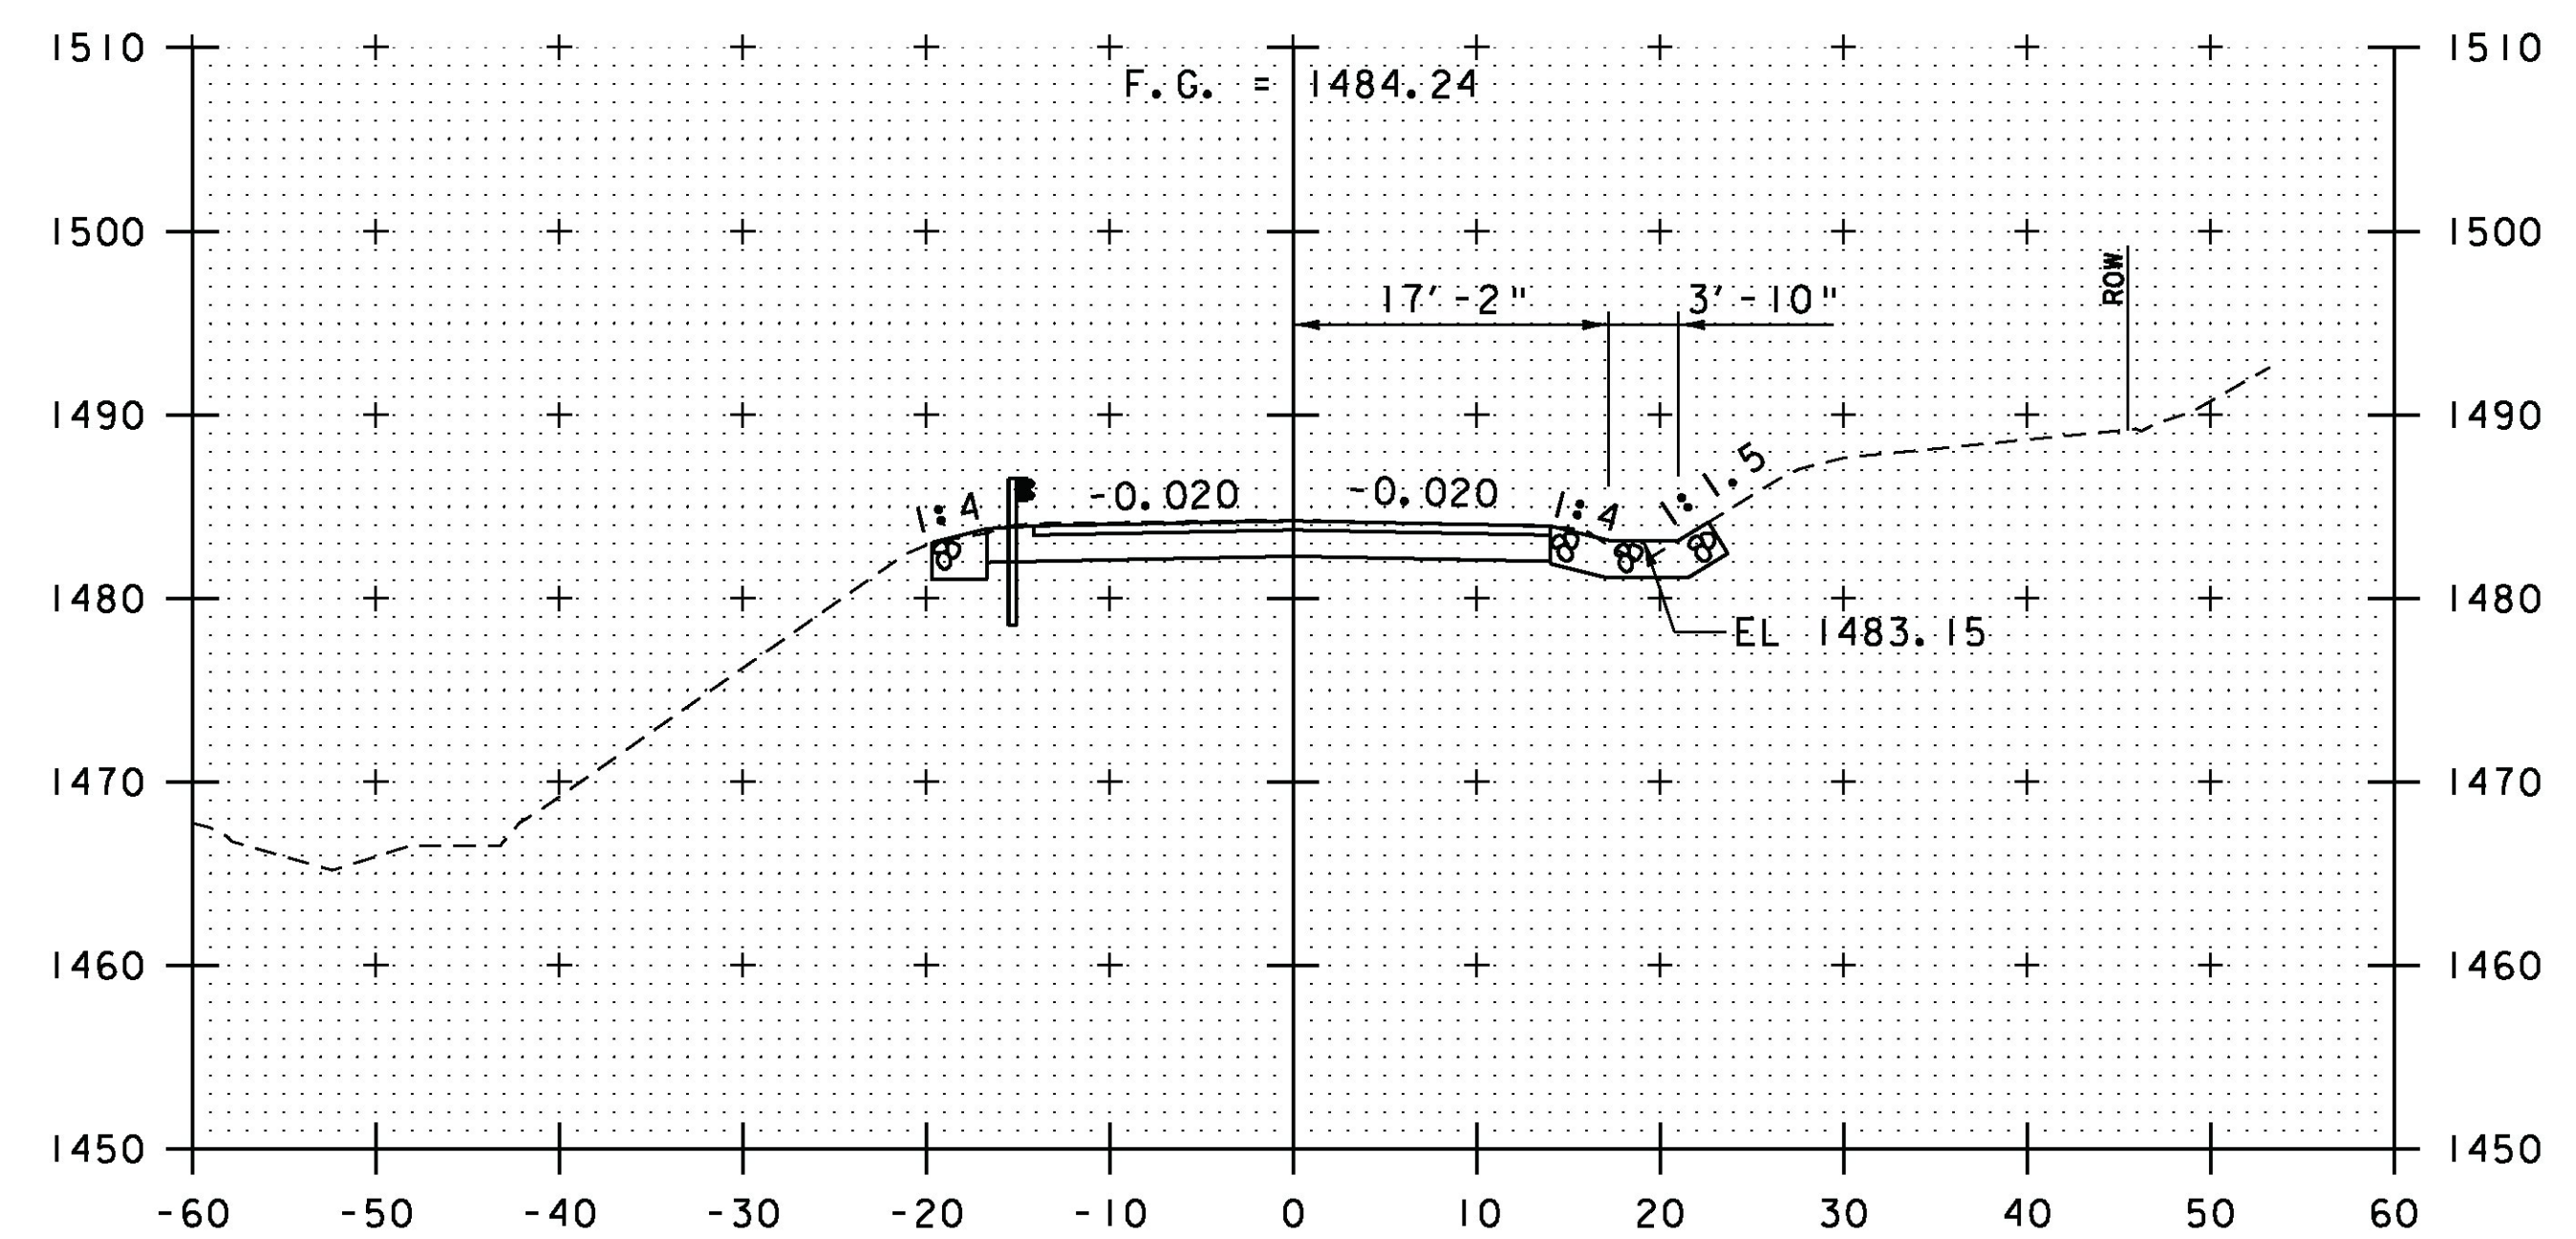

123+50

END PROJECT
STA 123+25

VT 73 CROSS SECTIONS
STA 122+50 TO STA 124+00



PROJECT NAME:	ROCHESTER	PLOT DATE:	8/19/2013
PROJECT NUMBER:	ER STP 0162(19)	DRAWN BY:	C.L. CILLEY
FILE NAME:	z1lc334xsl.dgn	DESIGNED BY:	C.L. CILLEY
PROJECT LEADER:	S.E. BURBANK	CHECKED BY:	D.M. PECK
BR 13 VT 73 CROSS SECTIONS (3 OF 4)		SHEET 48 OF 238	