


**NOTES:**

1. THESE PLANS SHOW A CONCEPTUAL EROSION CONTROL PLAN, THE CONTRACTOR MUST SUBMIT A TEMPORARY EPSC PLAN FOR APPROVAL.
2. TEMPORARY EPSC PLAN MEASURES ARE CONCEPTUALLY SHOWN. THE CONTRACTOR MAY RELOCATE TEMPORARY MEASURES TO IMPROVE EROSION CONTROL WITH APPROVAL OF THE RESIDENT ENGINEER. SILT FENCE SHALL NOT BE INSTALLED ACROSS CONTOURS.
3. THE CONTRACTOR SHALL USE OTHER TEMPORARY EROSION CONTROL MEASURES AS NECESSITATED BY THE SEQUENCE OF CONSTRUCTION OR AS DIRECTED BY THE RESIDENT ENGINEER.
4. REFER TO TEMPORARY EROSION CONTROL DETAIL SHEETS FOR ADDITIONAL DETAILS.

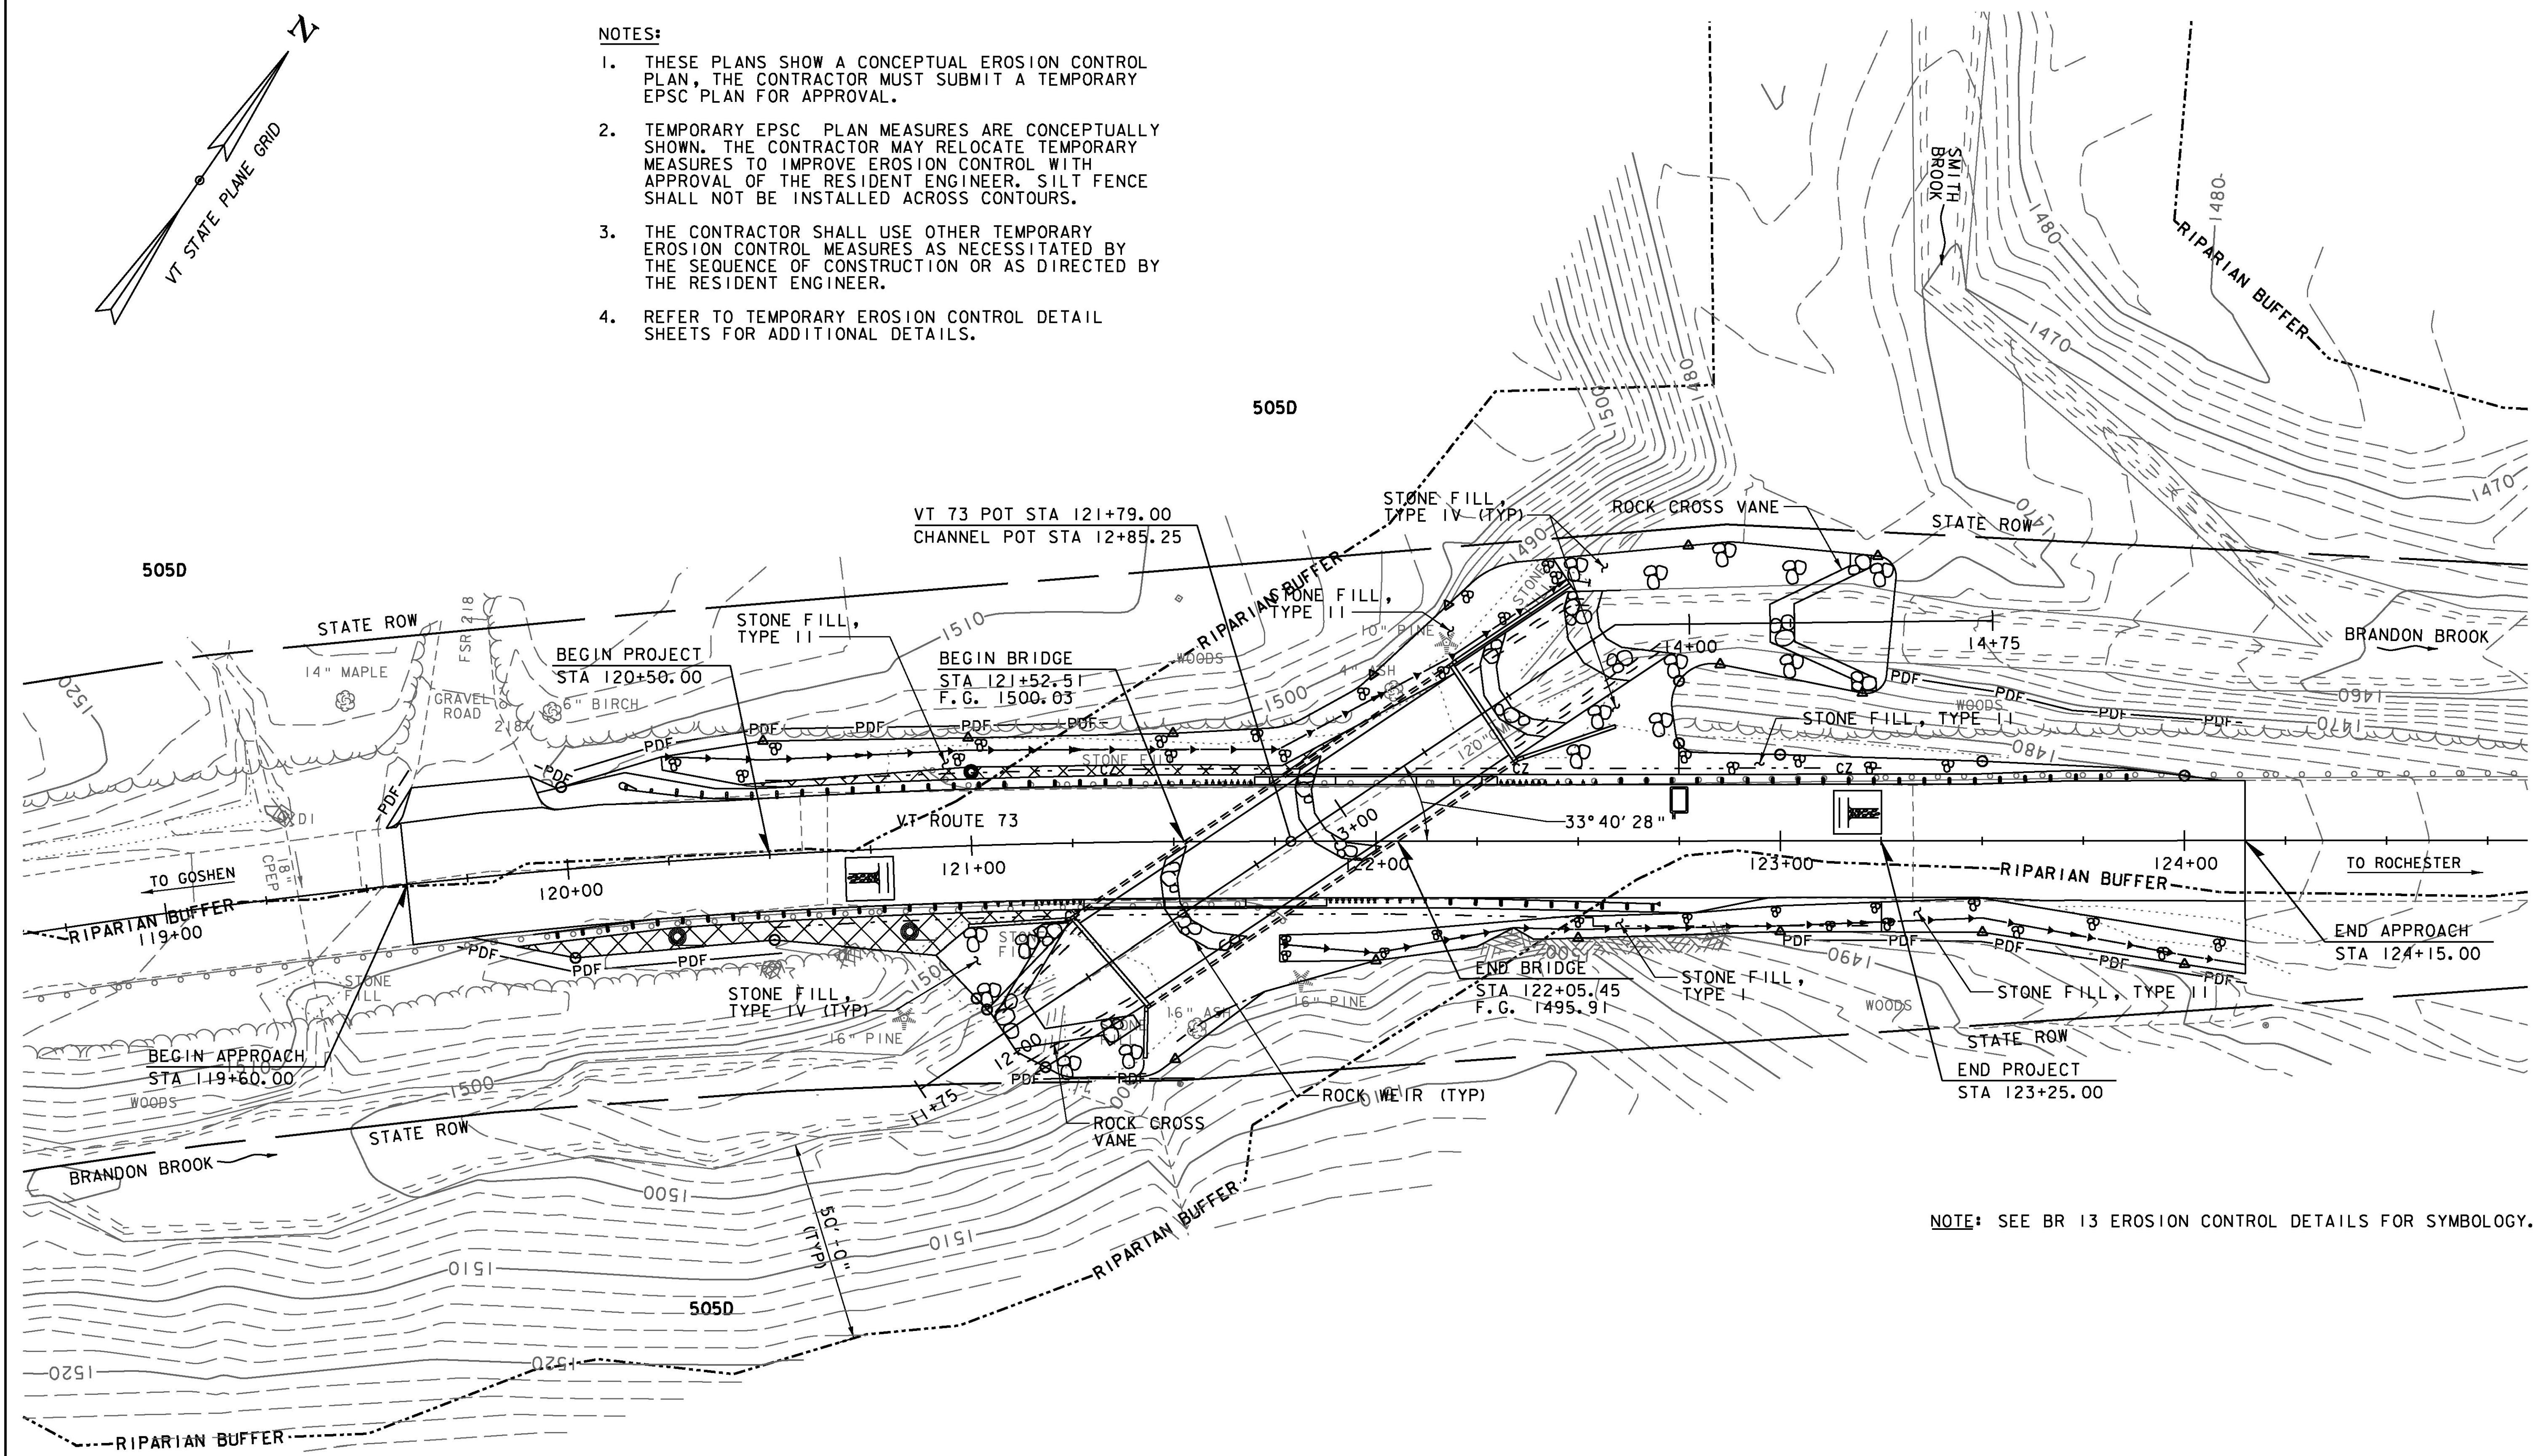

NOTE: SEE BR 13 EROSION CONTROL DETAILS FOR SYMBOLLOGY.

SCALE 1" = 20'-0"  
 20 0 20



PROJECT NAME:	ROCHESTER
PROJECT NUMBER:	ER STP 0162(19)
FILE NAME:	zllc334bdr_ero.dgn
PROJECT LEADER:	S.E. BURBANK
DESIGNED BY:	E.A. FIALA
BR 13 EPSC CONSTRUCTION SITE PLAN	
PLOT DATE:	8/19/2013
DRAWN BY:	E.A. FIALA
CHECKED BY:	B.O. CRONIN
SHEET	55 OF 238