


VT 73 PROFILE
 SCALE 1" = 20' HORIZONTAL
 1" = 10' VERTICAL

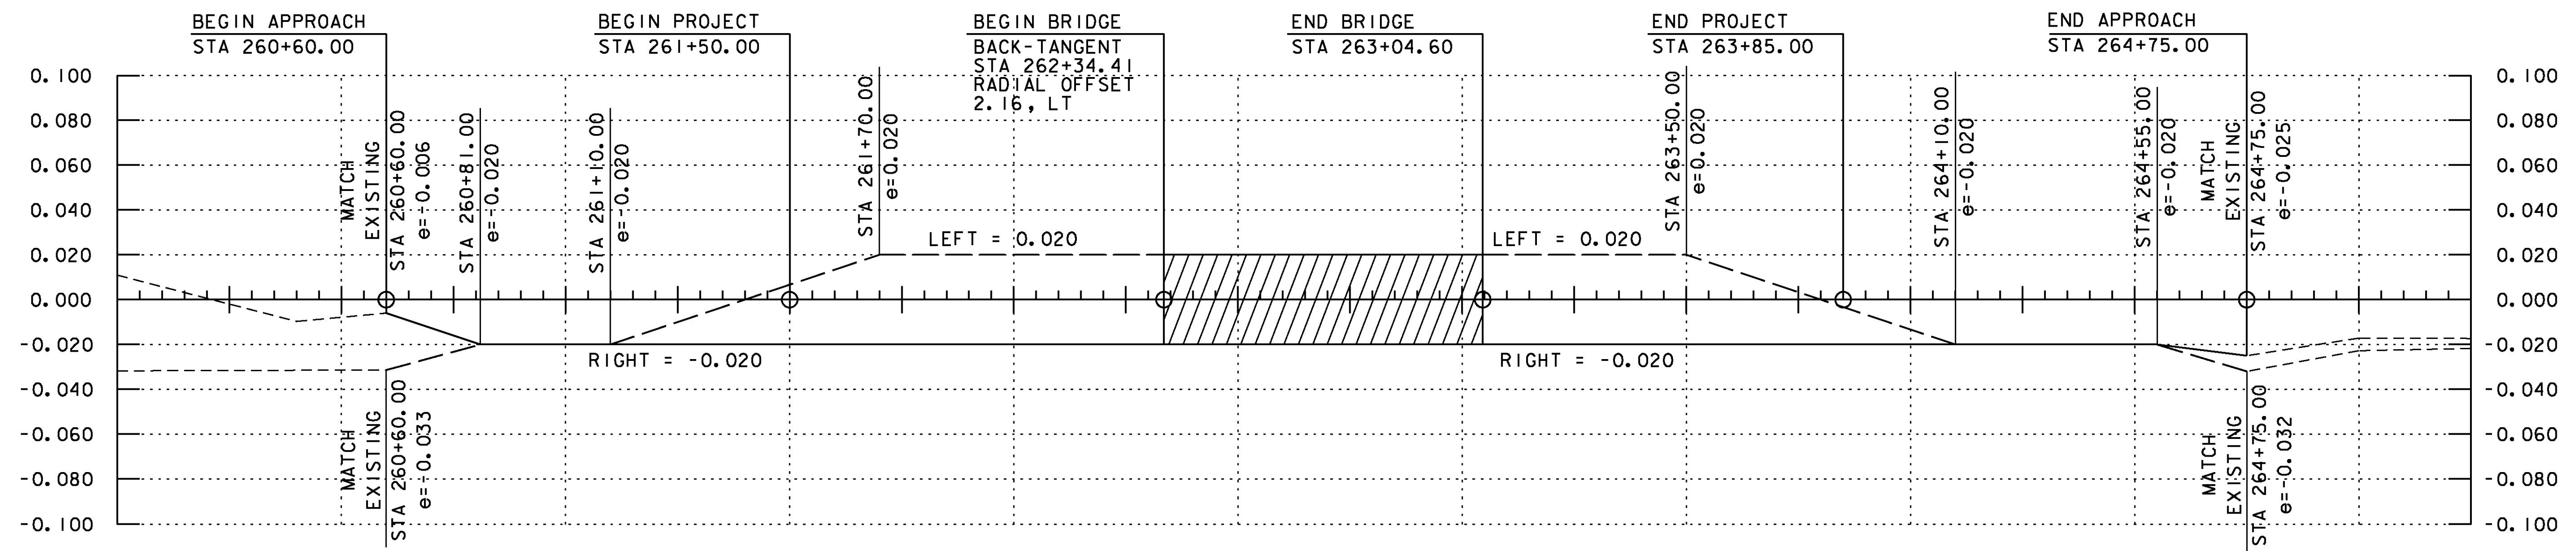

THE GRADES SHOWN TO THE NEAREST TENTH ARE THE ORIGINAL GROUND ELEVATIONS ALONG THE PROPOSED ALIGNMENT.

THE GRADES SHOWN TO THE NEAREST HUNDREDTH ARE THE FINISH GRADES ALONG THE PROPOSED ALIGNMENT.

VT 73 BANKING DIAGRAM
 SCALE 1" = 20' HORIZONTAL
 1" = 0.040 FT/FT VERTICAL

NOTE:
 BEGIN BRIDGE IS ALONG THE BACK-TANGENT OF CURVE NO 1, AT THE INTERSECTION OF THE APPROACH SLAB SEAT.



PROJECT NAME:	ROCHESTER	PLOT DATE:	8/19/2013
PROJECT NUMBER:	BRF 0162(16)	DRAWN BY:	C.L. CILLEY
FILE NAME:	z10c418pro.dgn	CHECKED BY:	D.M. PECK
PROJECT LEADER:	G.S. GOODRICH	SHEET	73 OF 238
DESIGNED BY:	C.L. CILLEY		
BR 15 VT 73 PROFILE SHEET			