




263+66 DRIVE, RT

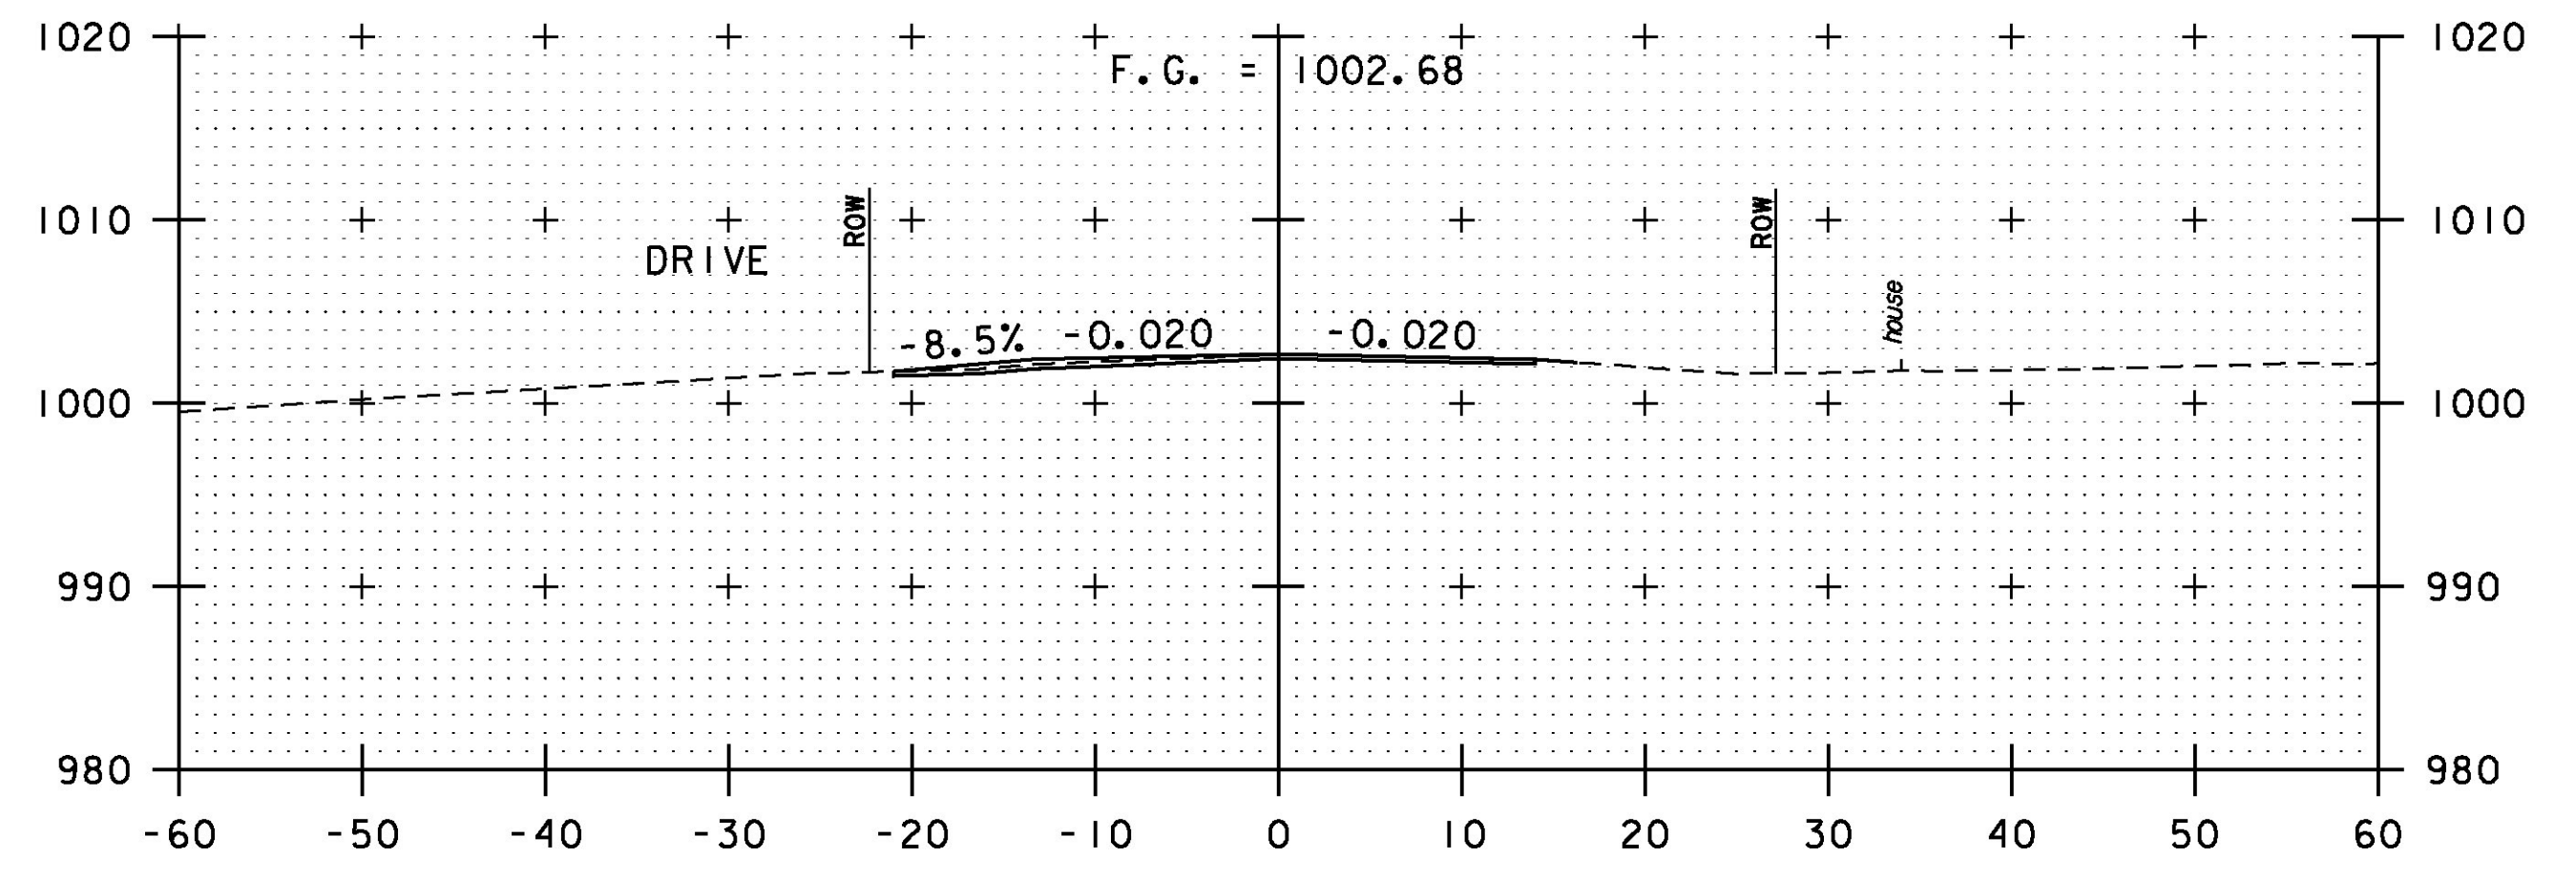


264+50

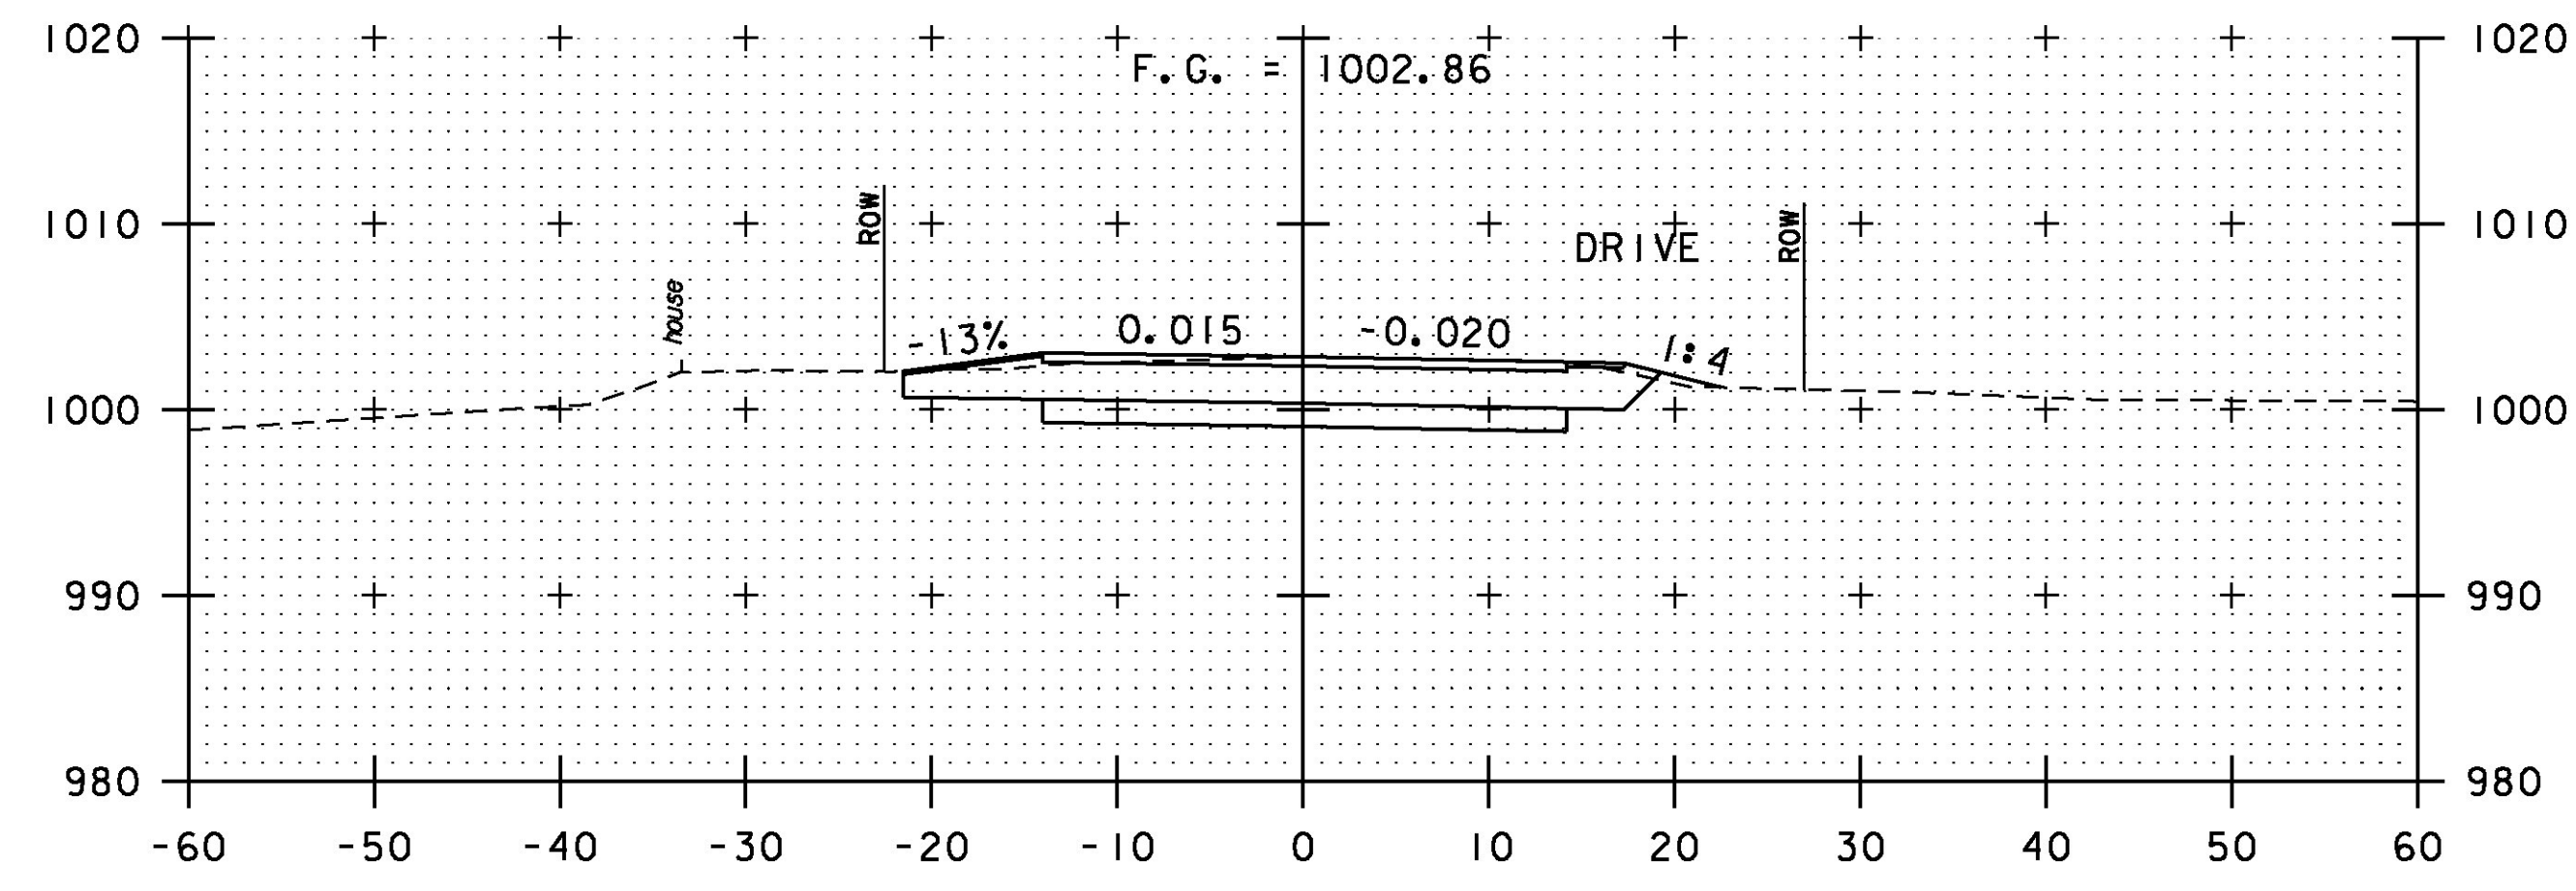


263+58 DRIVE, LT

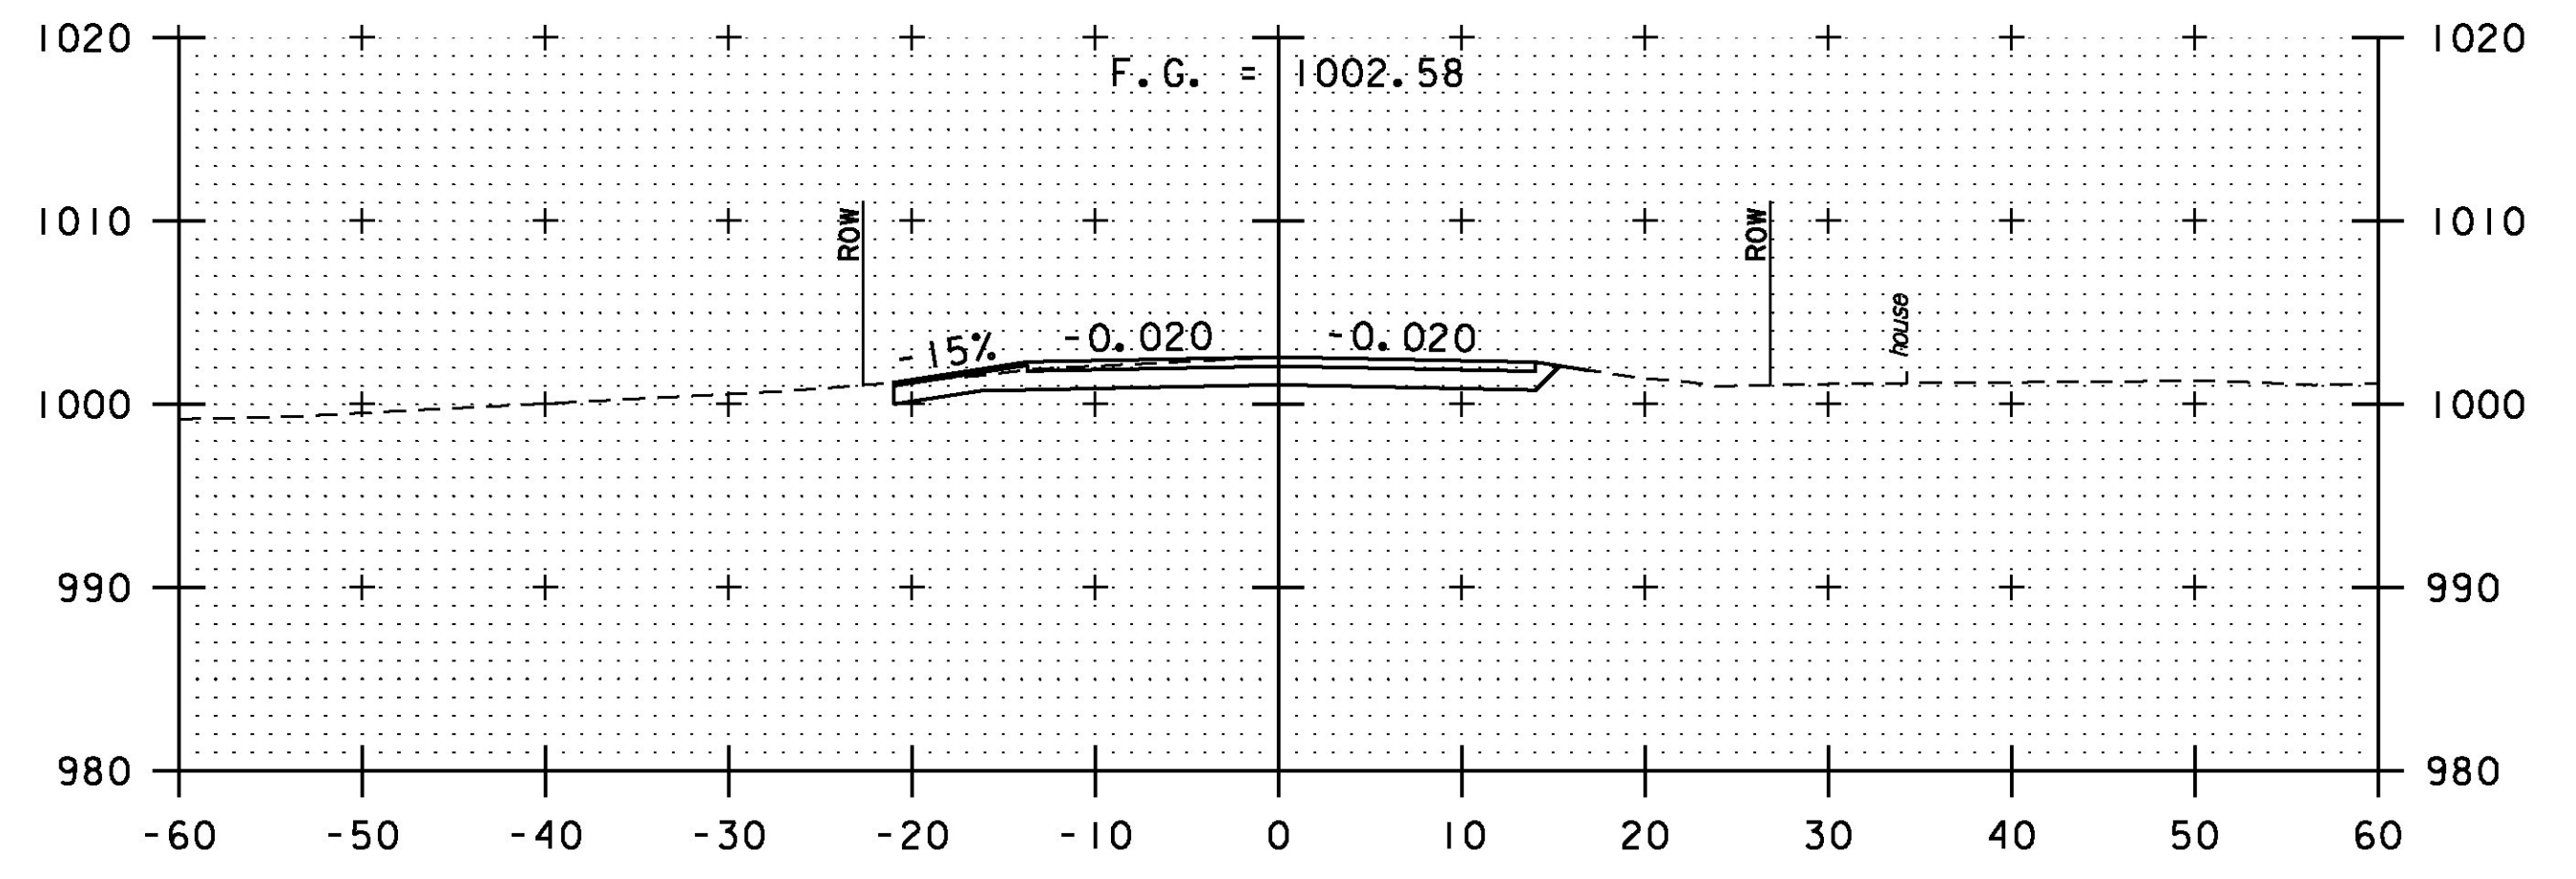

264+11 DRIVE, LT

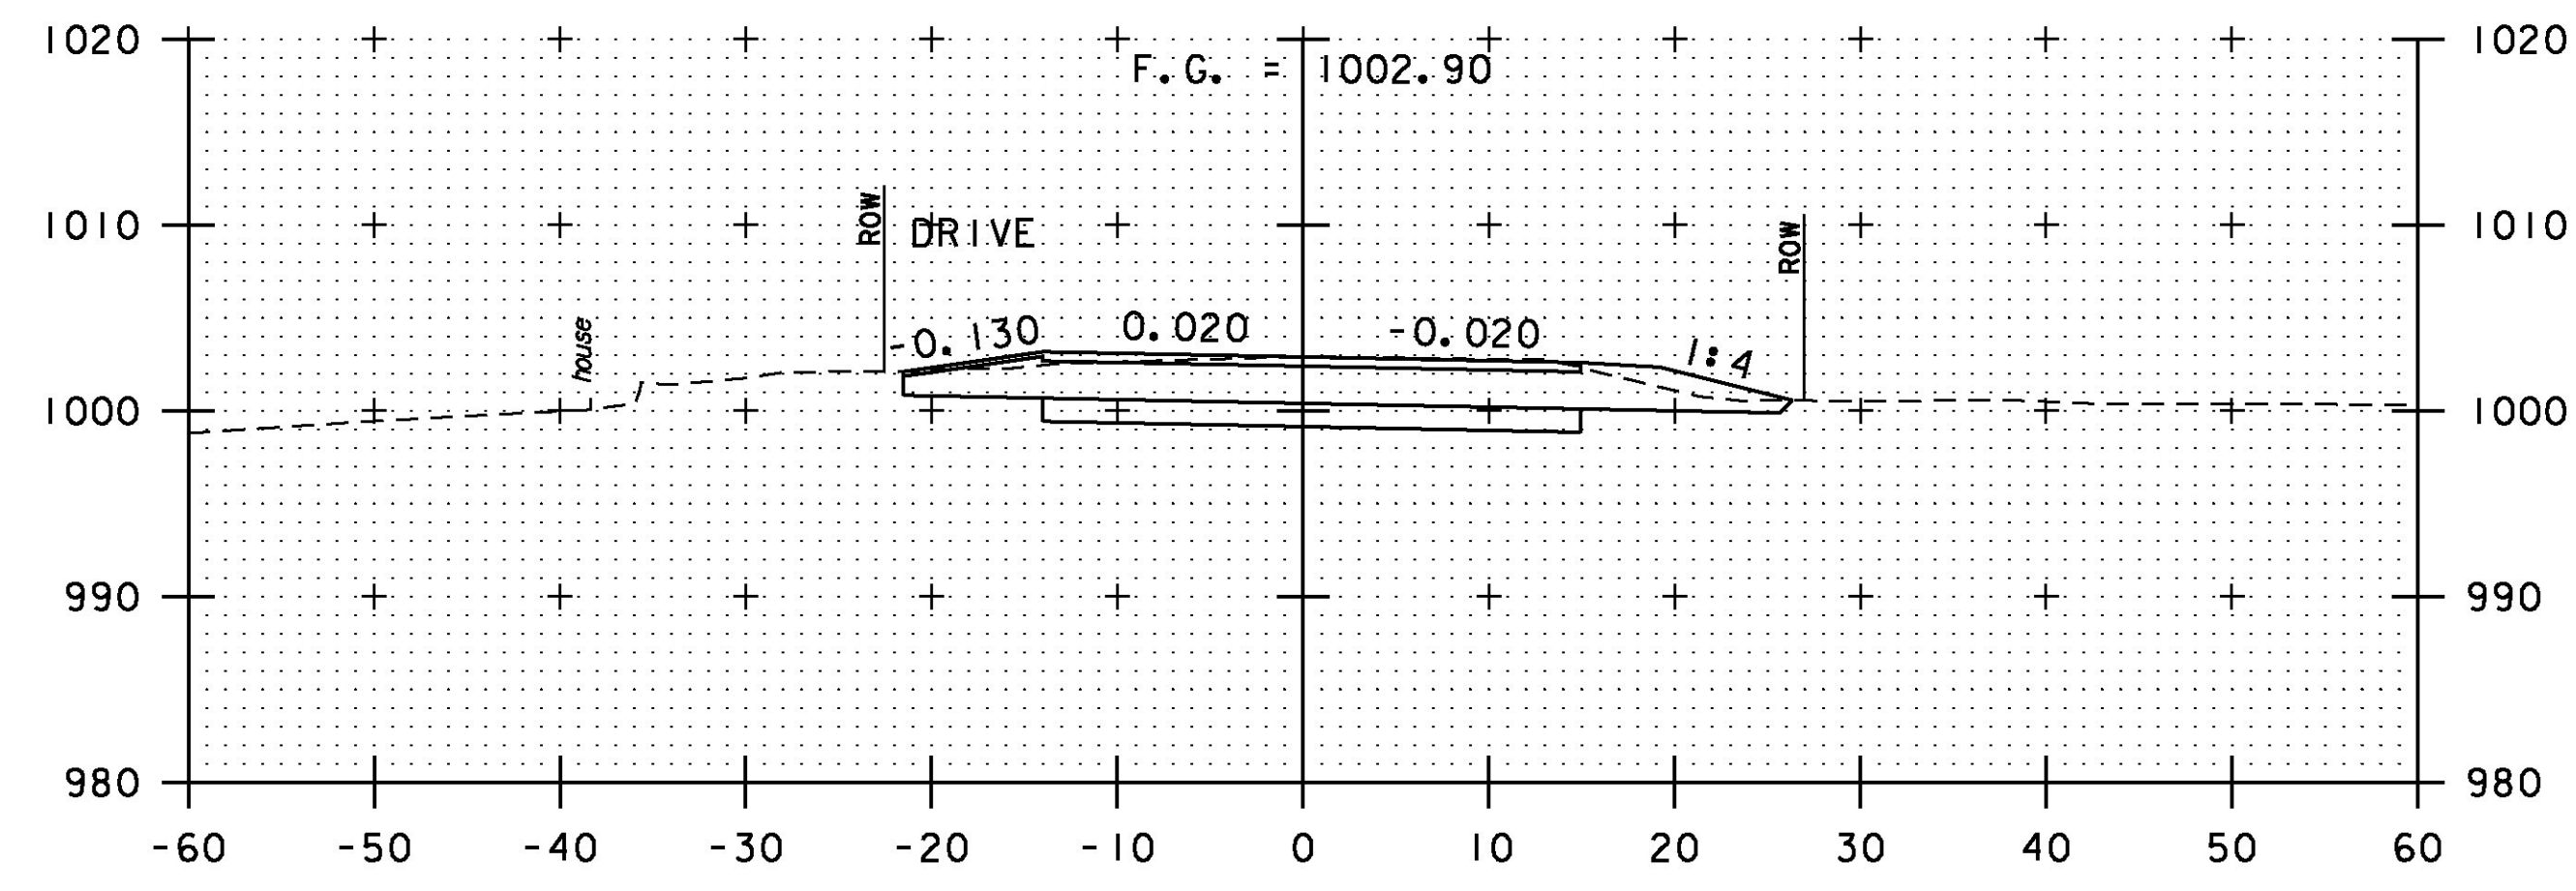

263+50

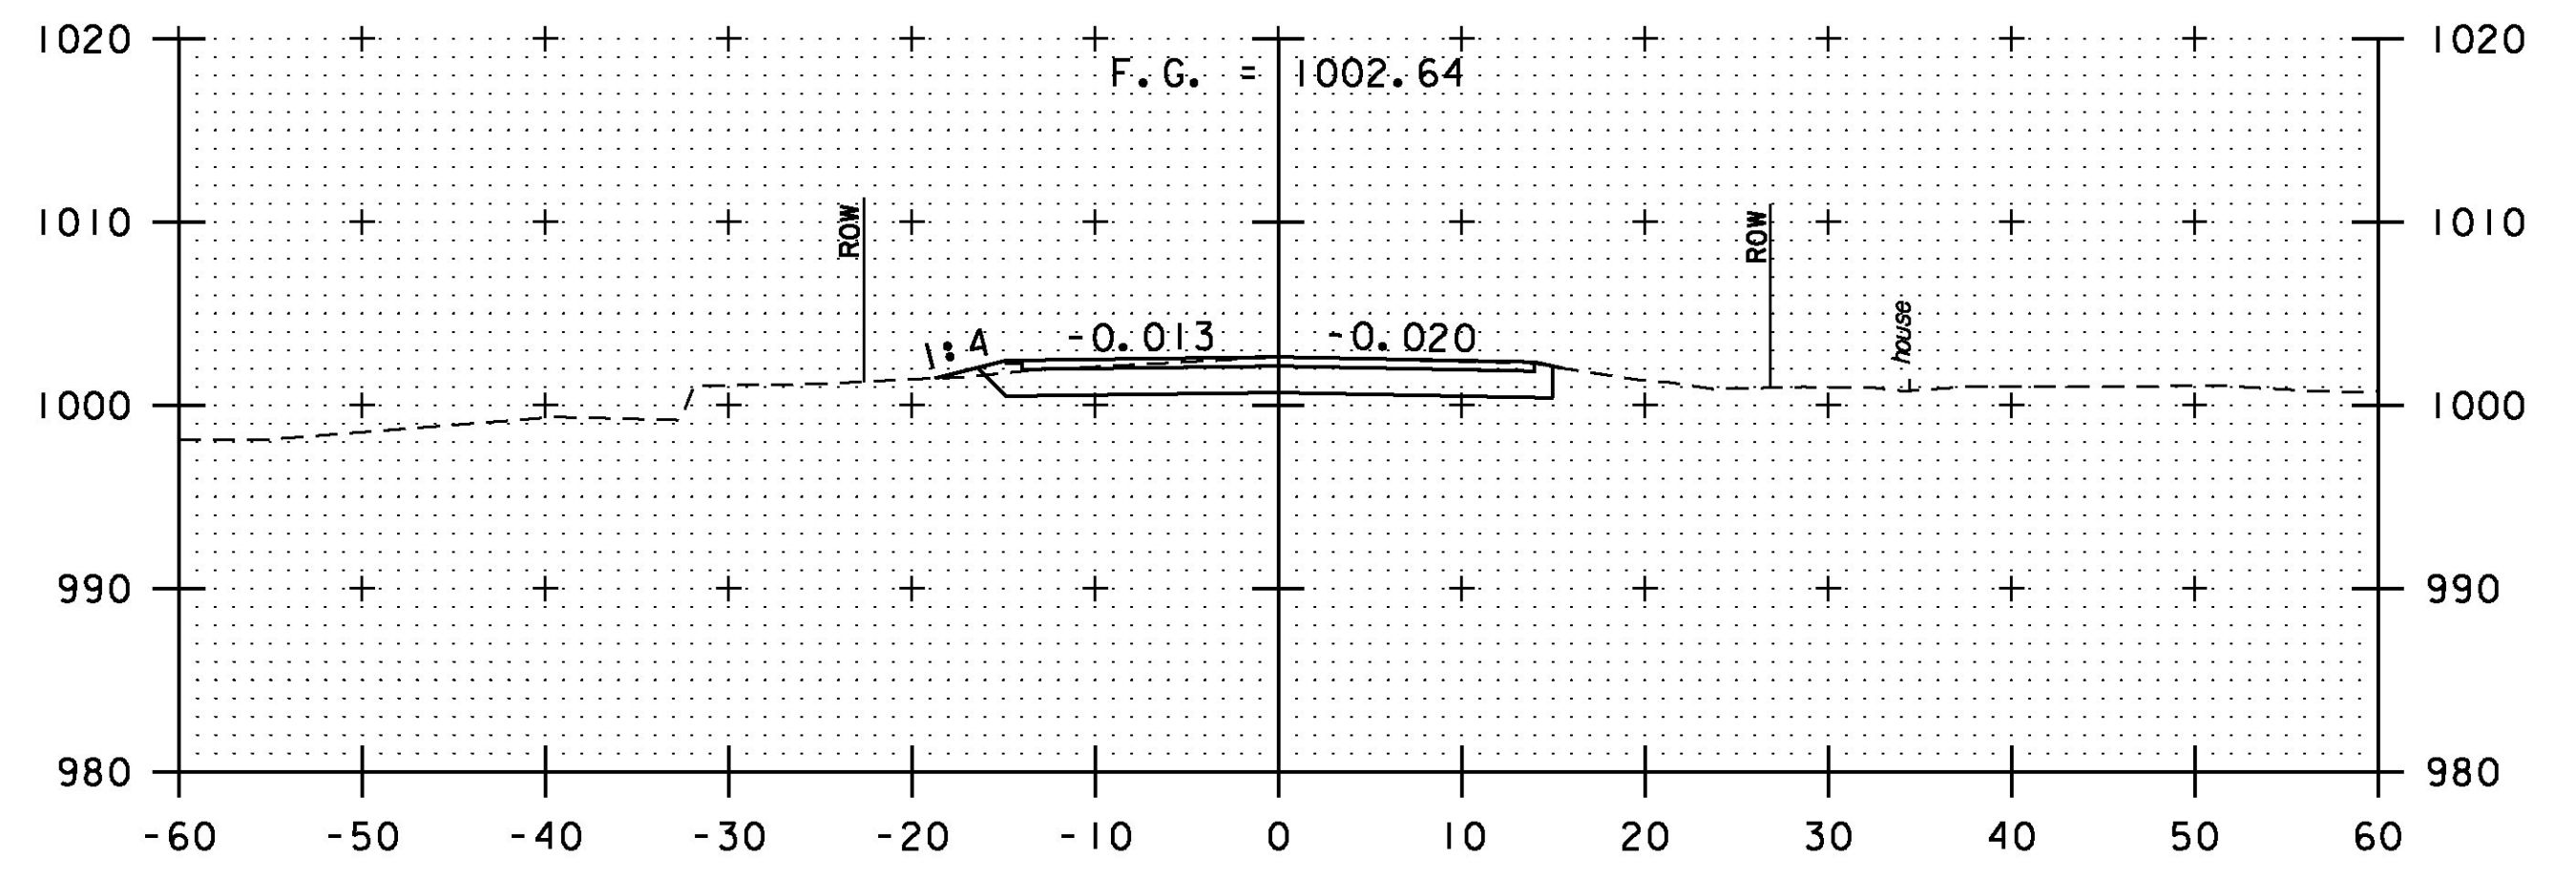

264+00

END PROJECT  
STA 263+85.00

VT 73 CROSS SECTIONS  
STA 263+50 THRU STA 264+50



PROJECT NAME: ROCHESTER	
PROJECT NUMBER: BRF 0162(16)	
FILE NAME: z10c418xst.dgn	PLOT DATE: 8/19/2013
PROJECT LEADER: G.S. GOODRICH	DRAWN BY: C.L. CILLEY
DESIGNED BY: C.L. CILLEY	CHECKED BY: D.M. PECK
BR 15 VT 73 CROSS SECTIONS (3 OF 4)	SHEET 107 OF 238