


265+00  
 END APPROACH  
 STA 264+75.00  
 MATCH EXISTING

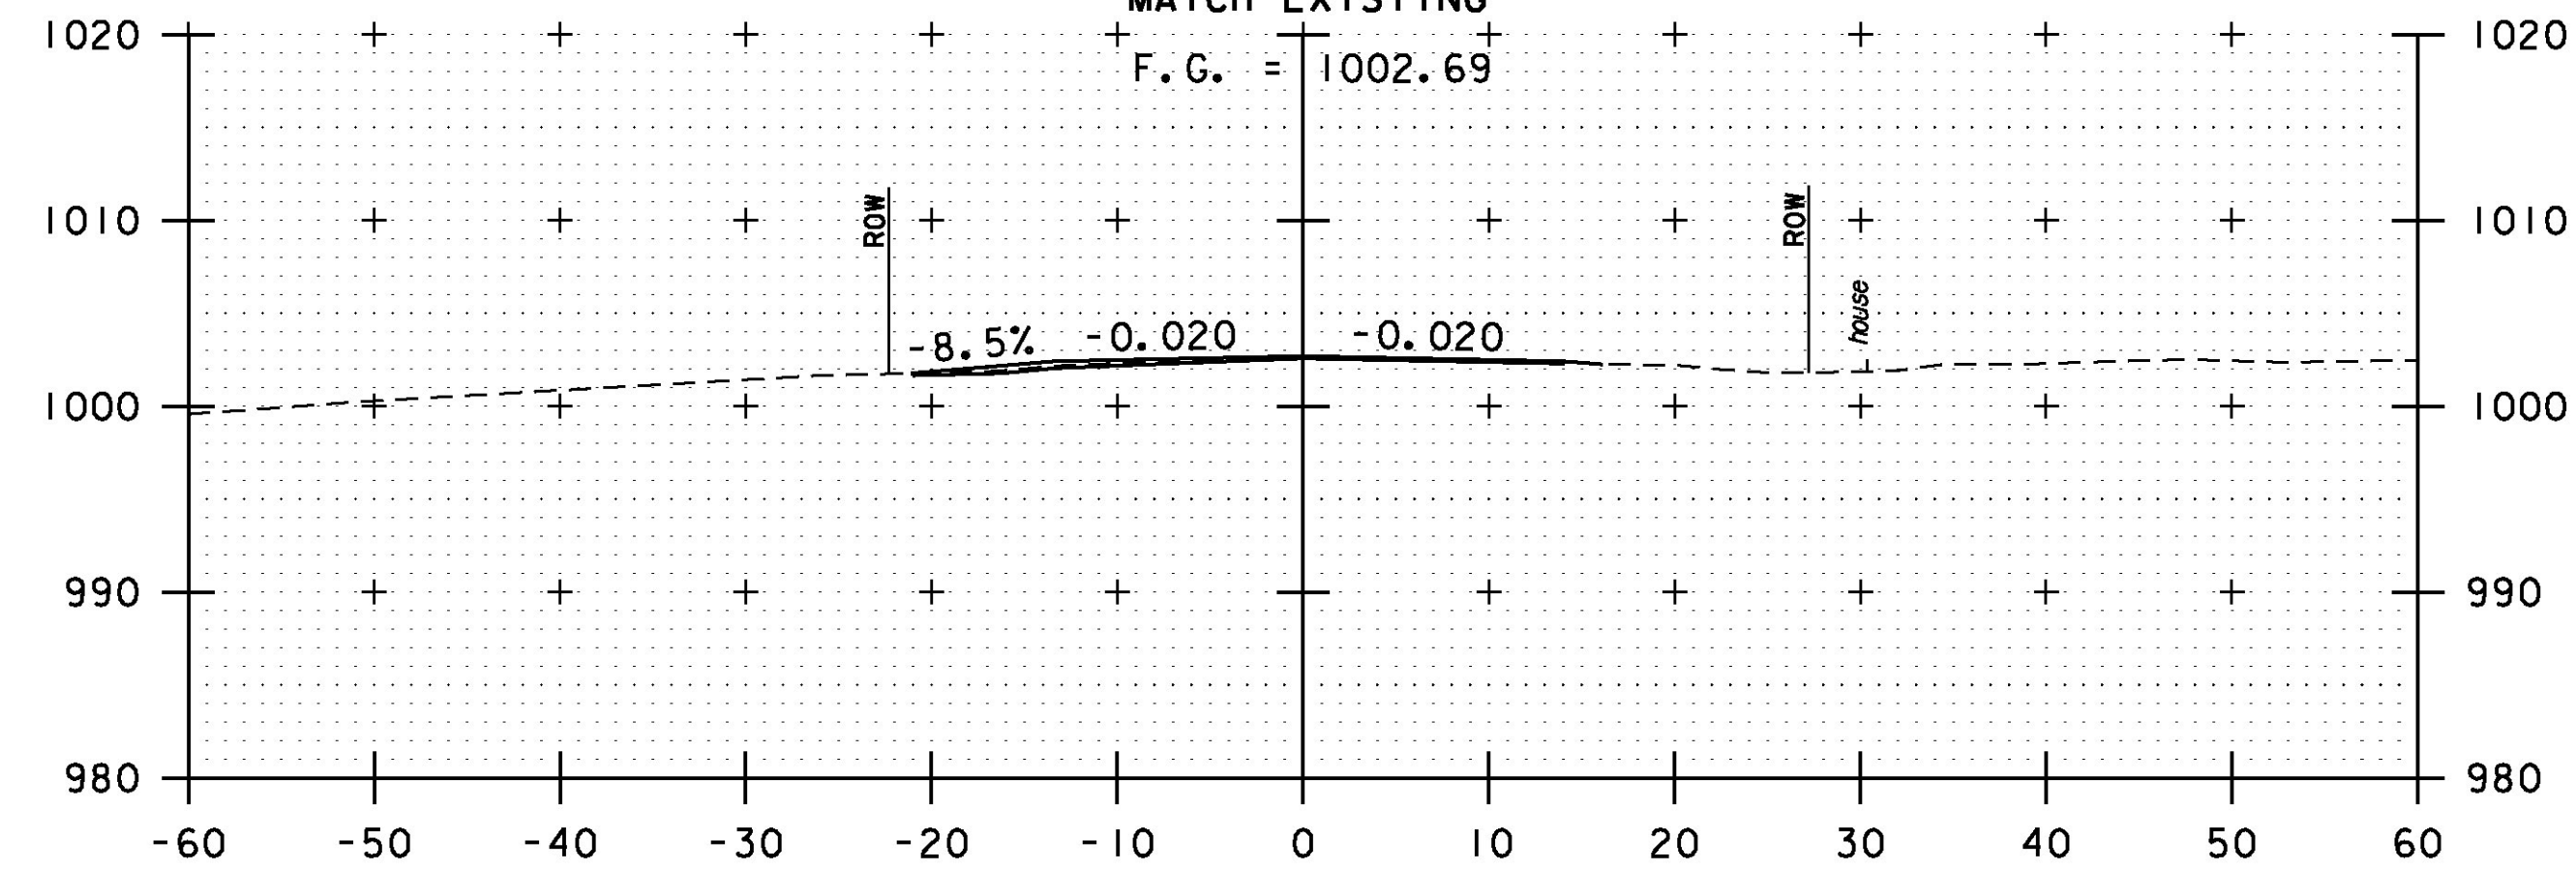

264+56 DRIVE, LT

VT 73 CROSS SECTIONS  
 STA 264+56 THRU STA 265+00



|                                     |                       |
|-------------------------------------|-----------------------|
| PROJECT NAME: ROCHESTER             | PLOT DATE: 8/19/2013  |
| PROJECT NUMBER: BRF 0162(16)        | DRAWN BY: C.L. CILLEY |
| FILE NAME: z10c418xst.dgn           | CHECKED BY: D.M. PECK |
| PROJECT LEADER: G.S. GOODRICH       | SHEET 108 OF 238      |
| DESIGNED BY: C.L. CILLEY            |                       |
| BR 15 VT 73 CROSS SECTIONS (4 OF 4) |                       |