



1+50
LIMIT OF PAVEMENT
LIMIT OF WORK
STA 1+25.00
MATCH EXISTING

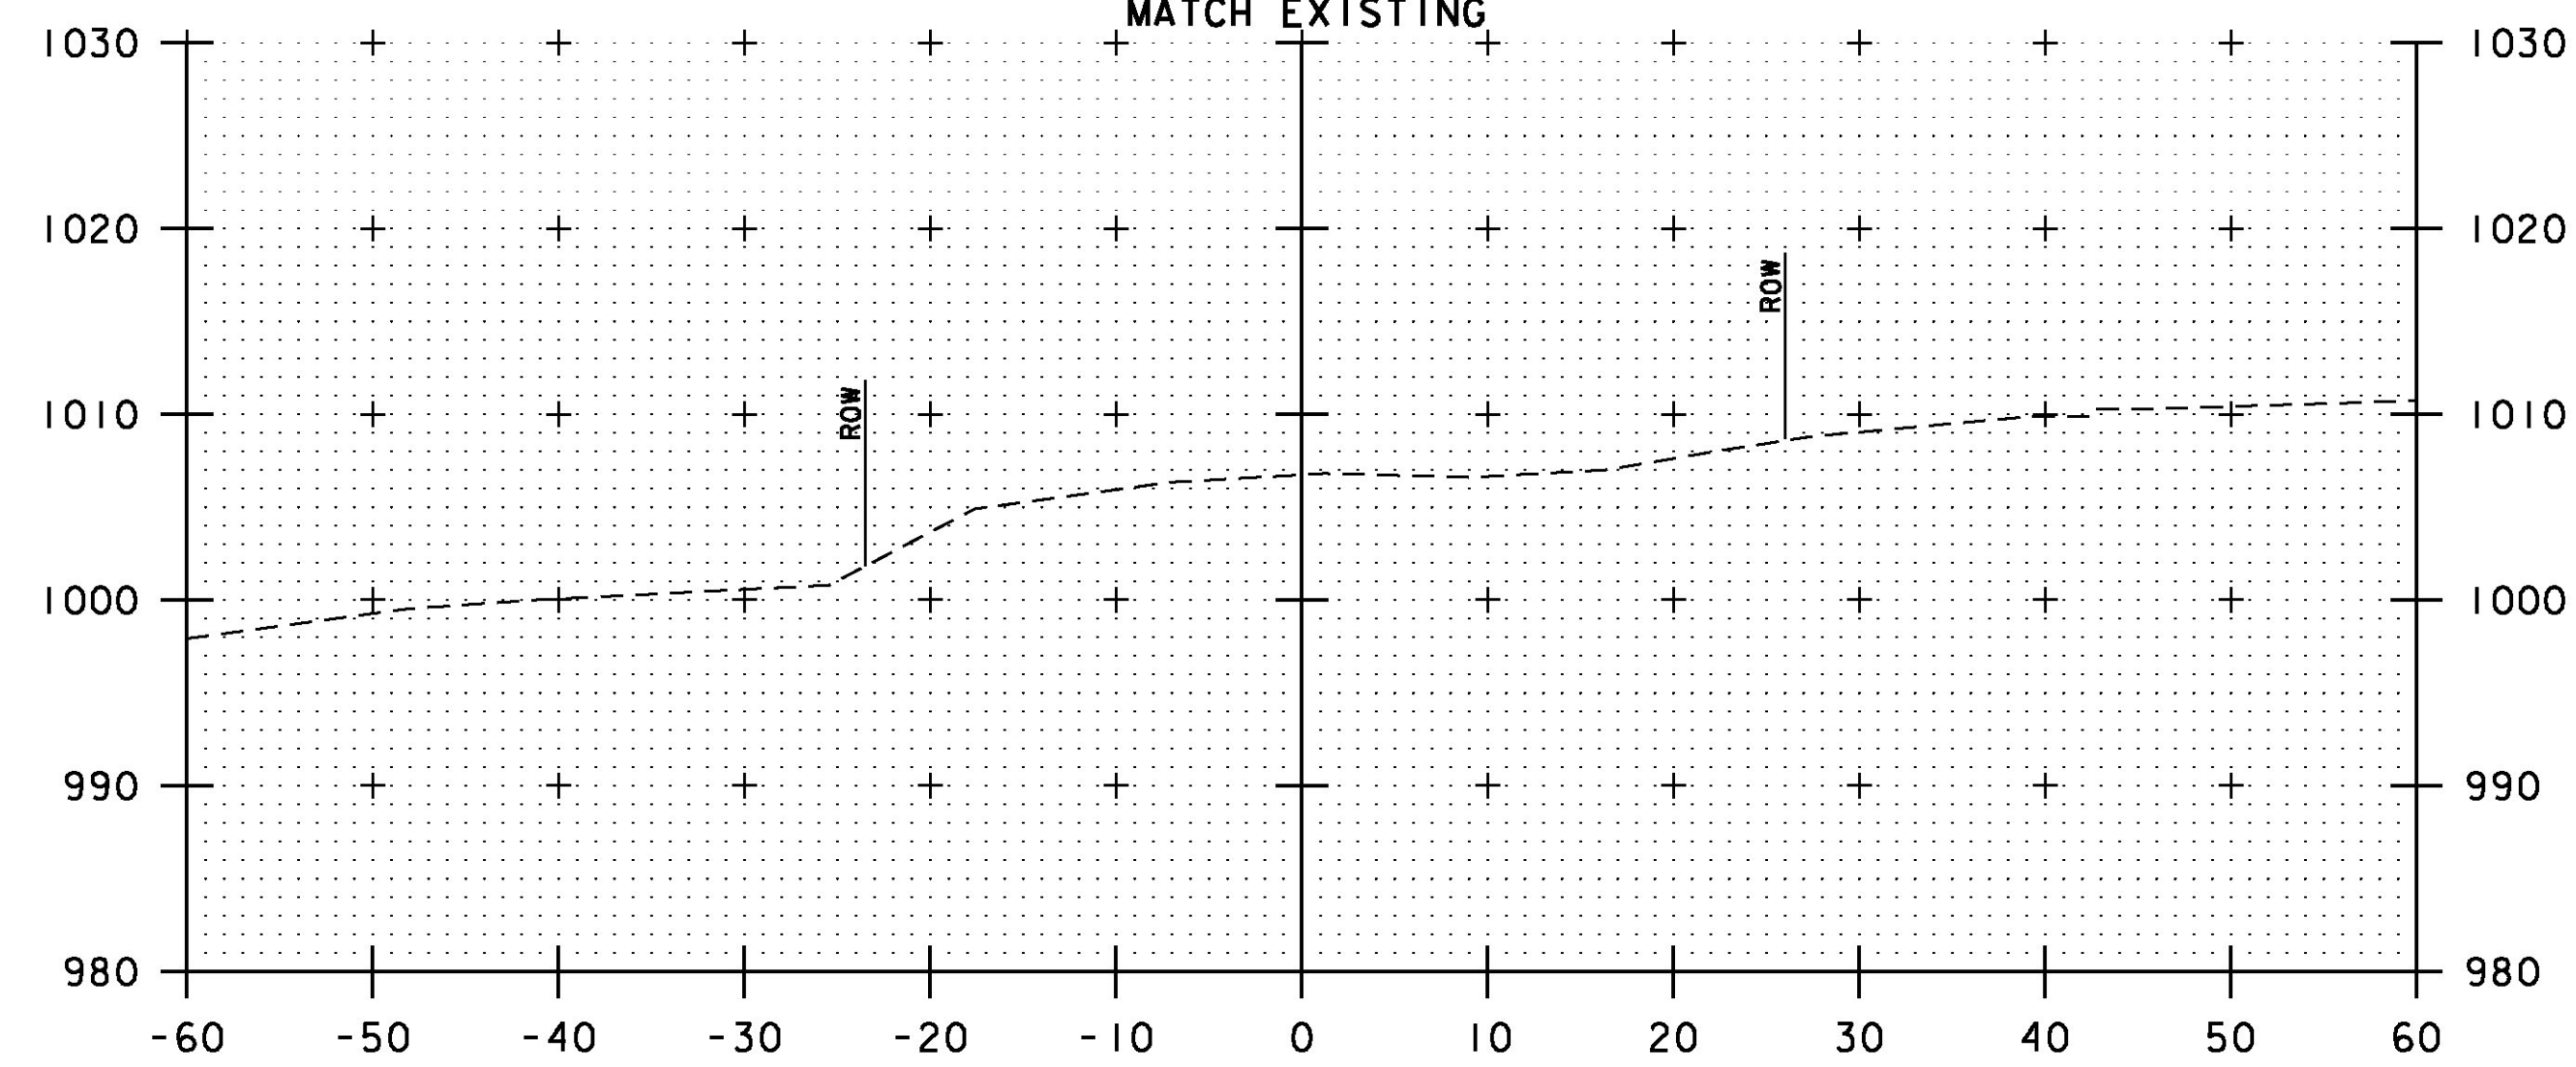

1+00

BINGO ROAD CROSS SECTIONS
STA 1+00 THRU STA 2+00

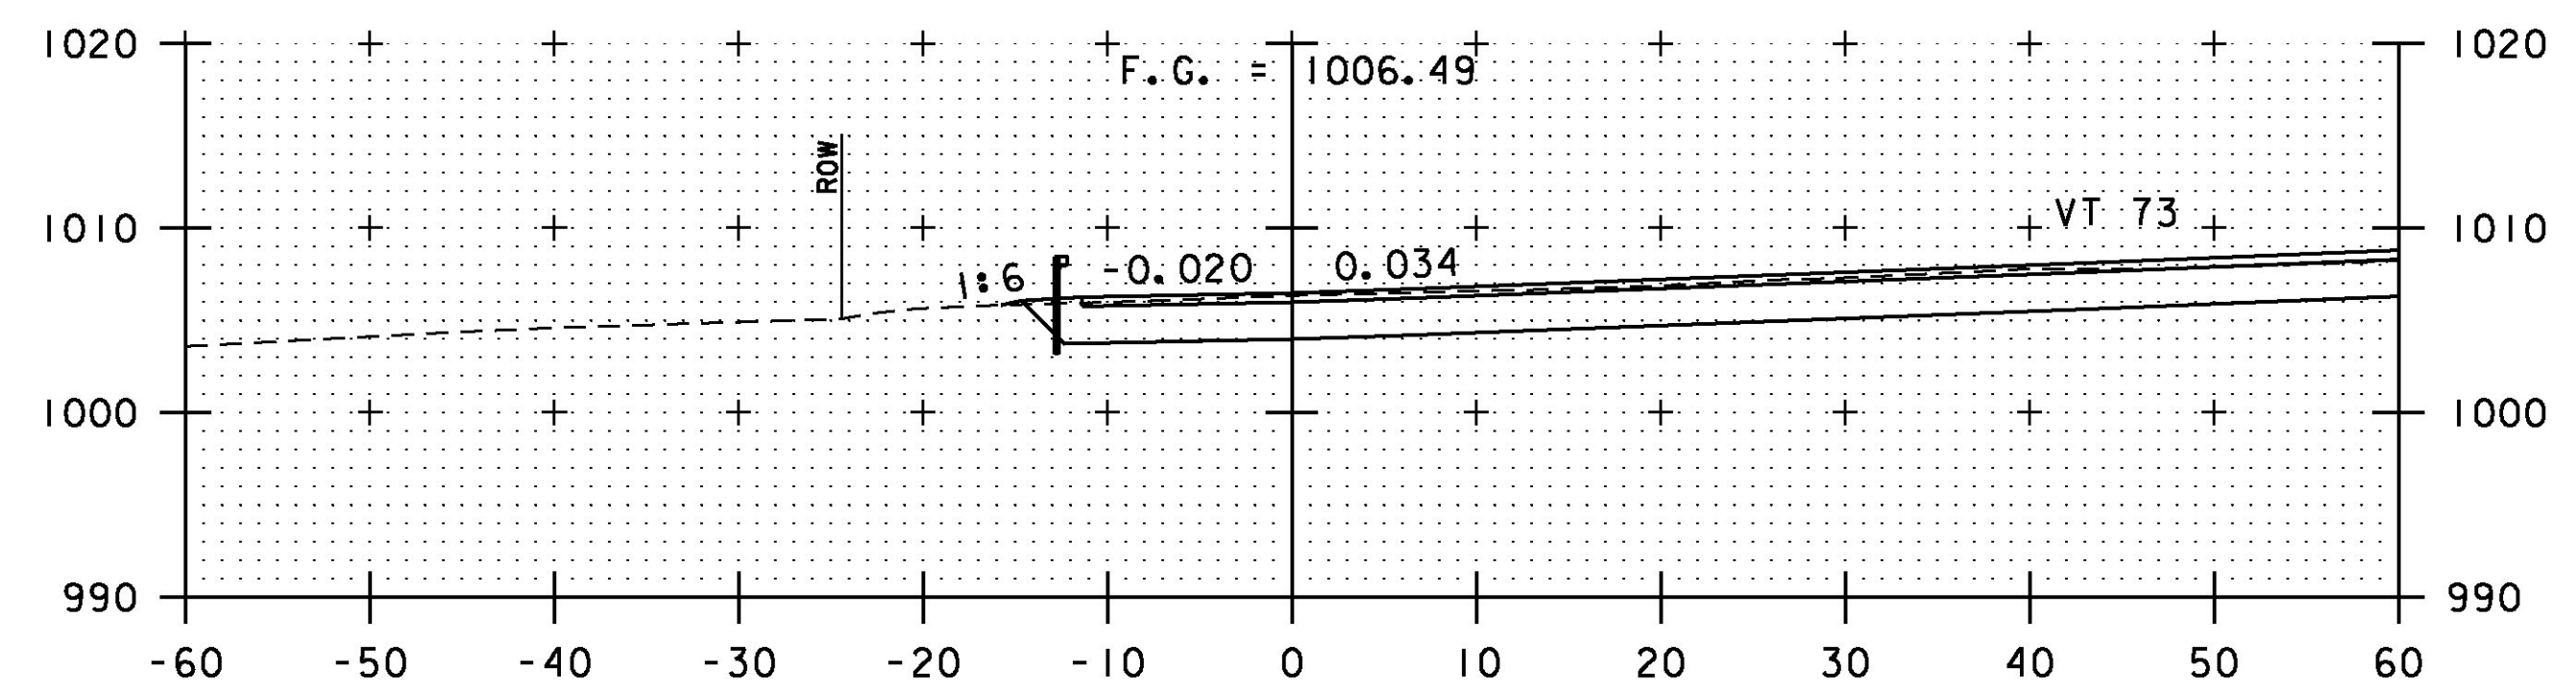

2+00

PROJECT NAME: ROCHESTER	PLOT DATE: 8/19/2013
PROJECT NUMBER: BRF 0162(16)	DRAWN BY: C.L. CILLEY
FILE NAME: z10c418xsl.dgn	DESIGNED BY: C.L. CILLEY
PROJECT LEADER: G.S. GOODRICH	CHECKED BY: D.M. PECK
BR 15 BINGO ROAD CROSS SECTIONS	SHEET 109 OF 238

