



NOTE:
 1. SEE BR 15 EROSION CONTROL DETAILS FOR SYMBOLLOGY.

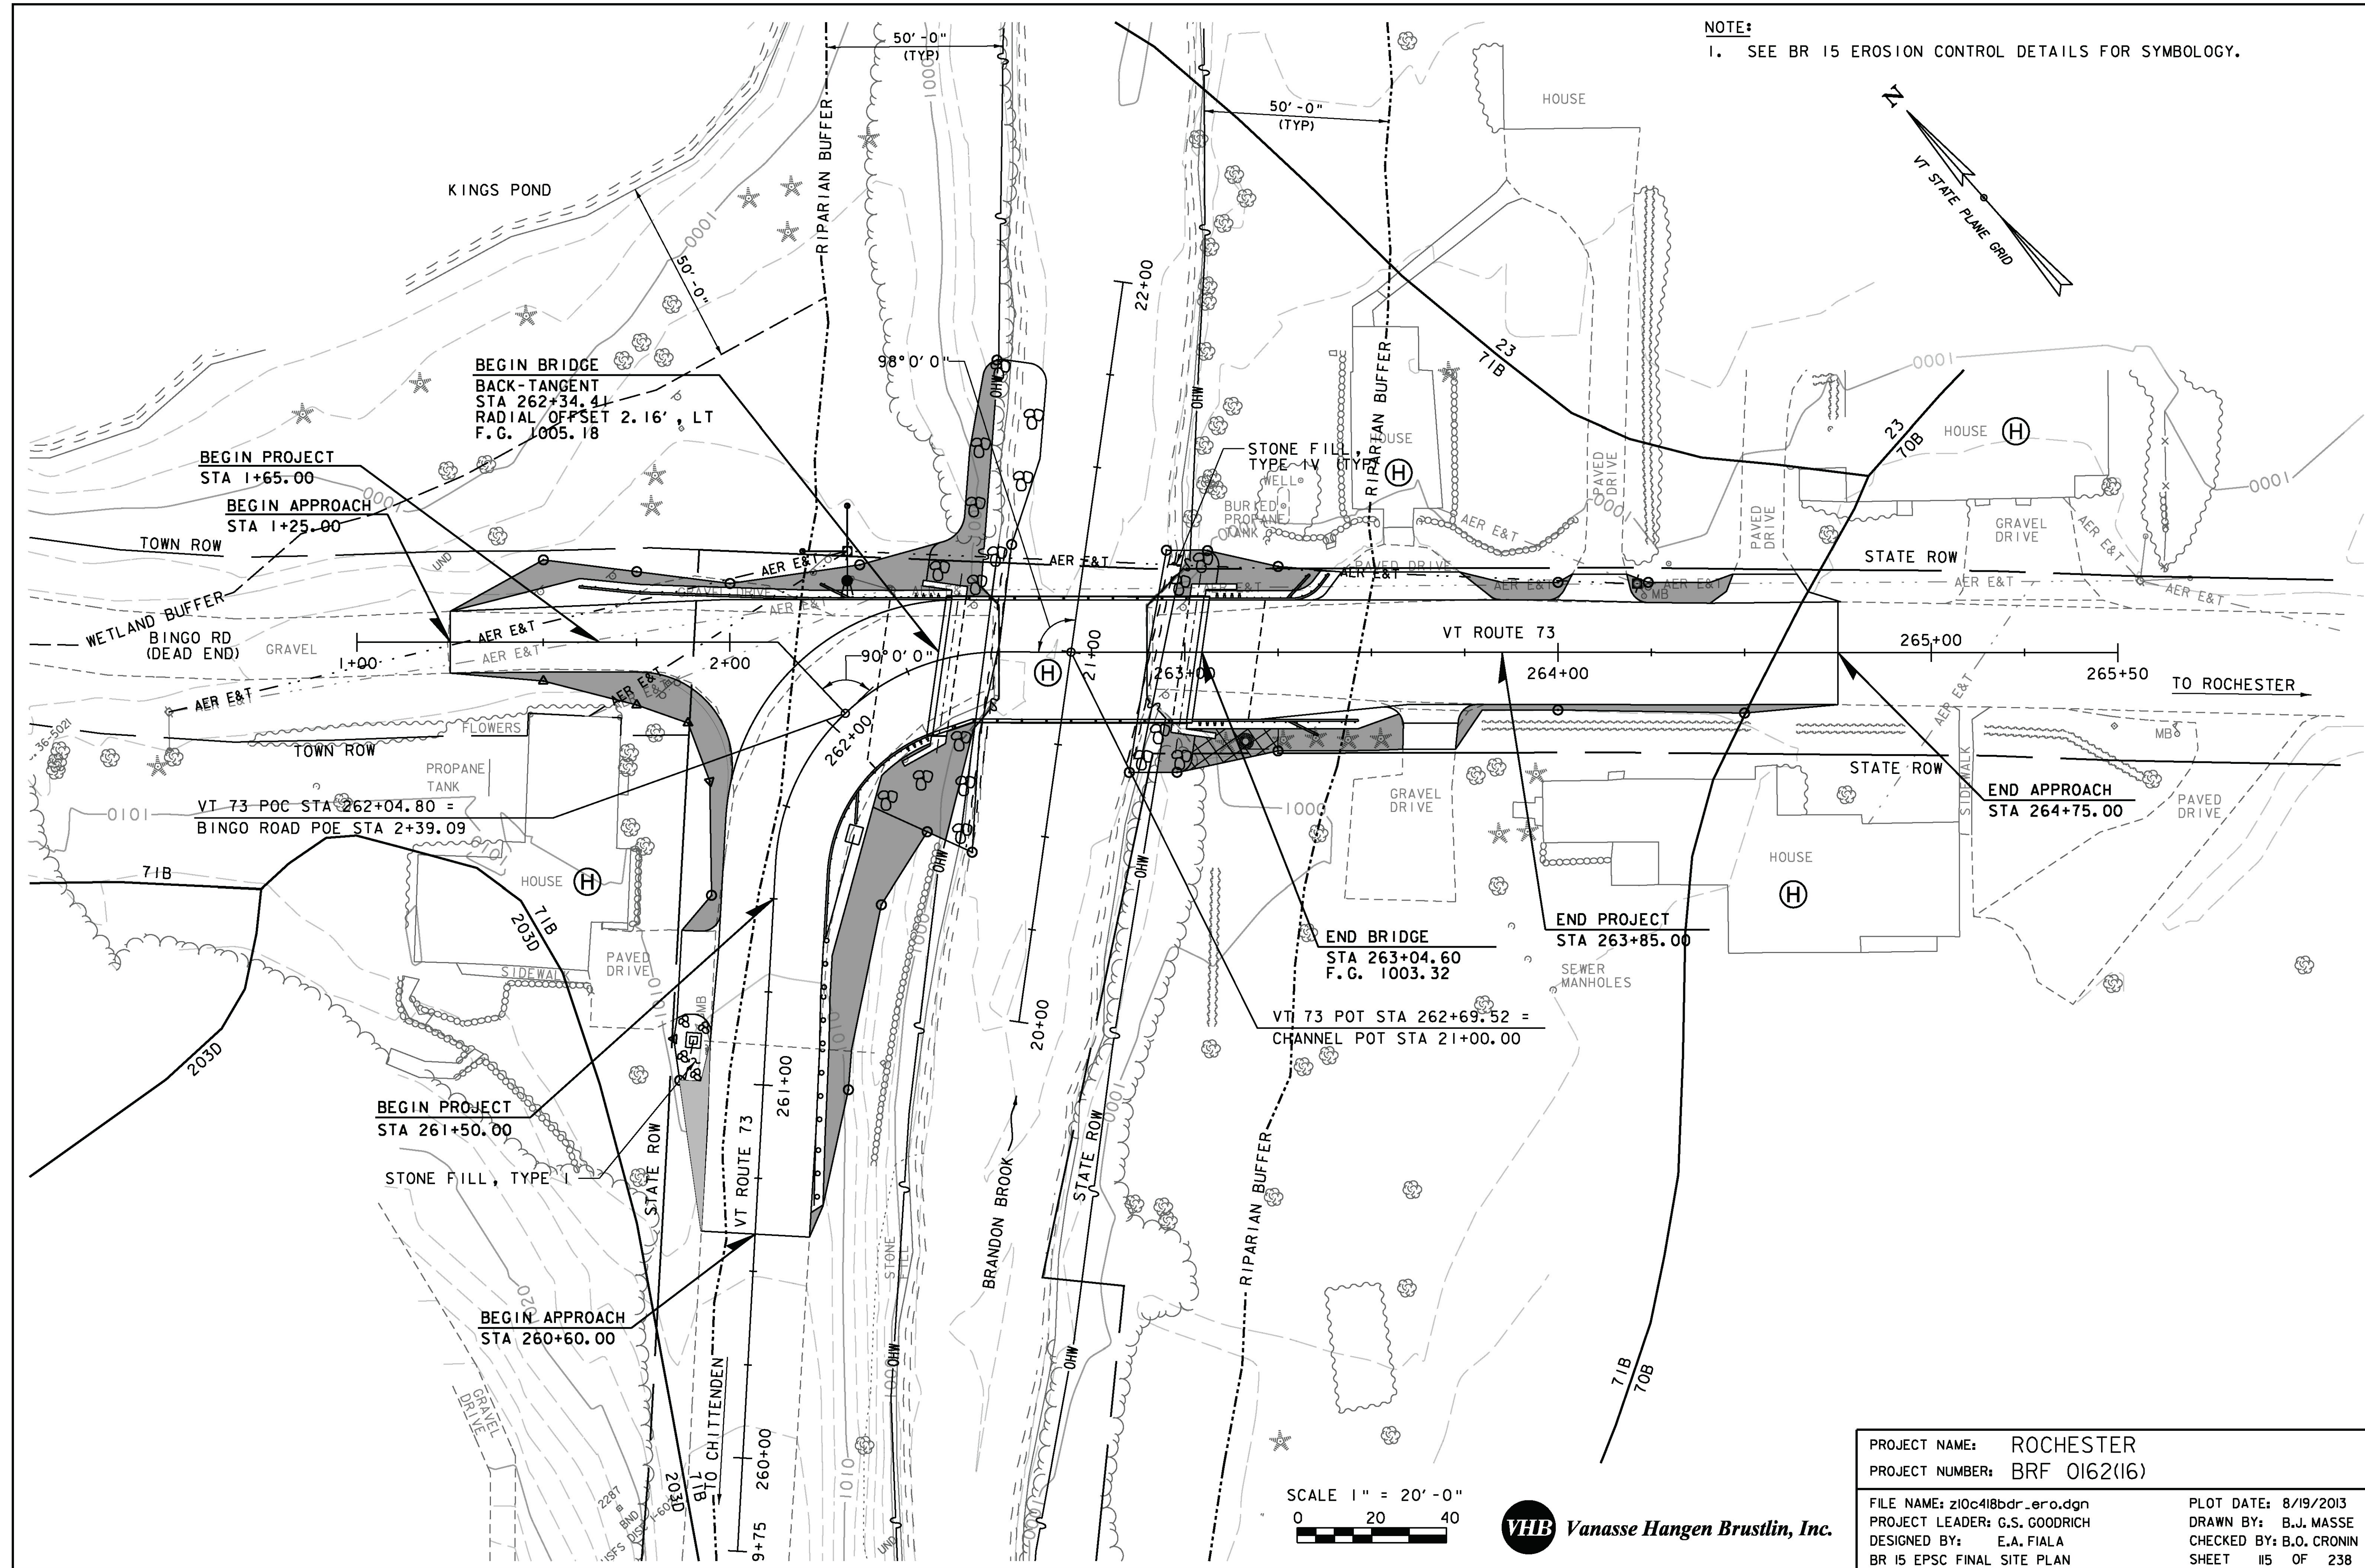

PROJECT NAME:	ROCHESTER	PLOT DATE:	8/19/2013
PROJECT NUMBER:	BRF 0162(16)	DRAWN BY:	B.J. MASSE
FILE NAME:	z10c418bdr_ero.dgn	DESIGNED BY:	E.A. FIALA
PROJECT LEADER:	G.S. GOODRICH	CHECKED BY:	B.O. CRONIN
BR 15 EPSC FINAL SITE PLAN		SHEET	115 OF 238

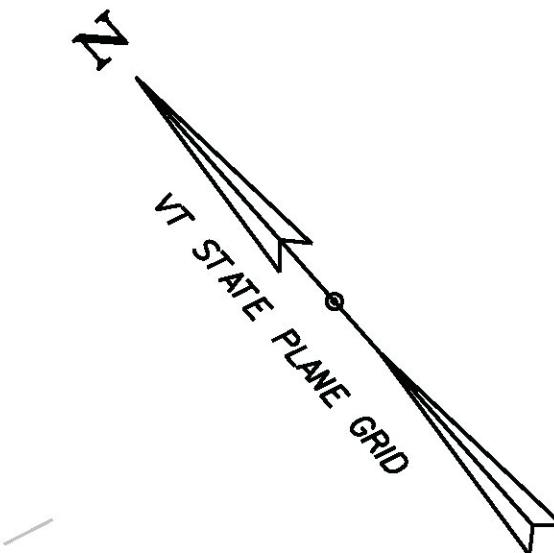