


VT 73 PROFILE
 SCALE 1" = 20' HORIZONTAL
 1" = 10' VERTICAL

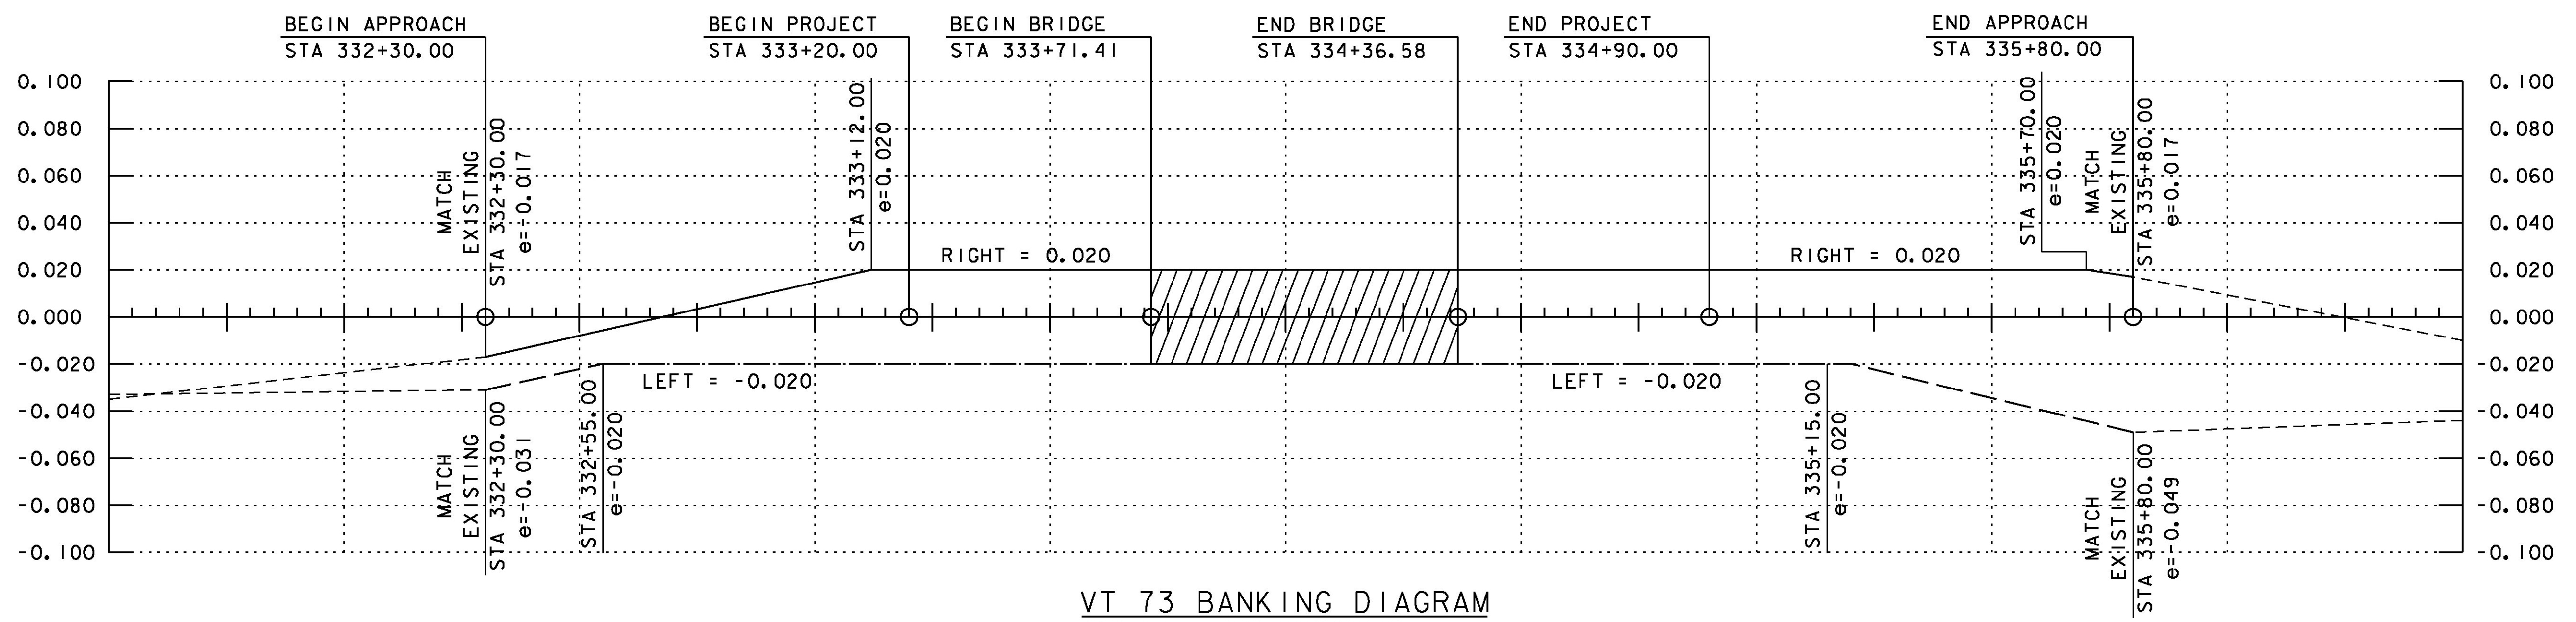

VT 73 BANKING DIAGRAM
 SCALE 1" = 20' HORIZONTAL
 1" = 0.040 FT/FT VERTICAL

THE GRADES SHOWN TO THE NEAREST TENTH ARE THE ORIGINAL GROUND ELEVATIONS ALONG THE PROPOSED ALIGNMENT.
 THE GRADES SHOWN TO THE NEAREST HUNDREDTH ARE THE FINISH GRADES ALONG THE PROPOSED ALIGNMENT.

PROJECT NAME:	ROCHESTER
PROJECT NUMBER:	BRF 0162(17)
FILE NAME:	z85e035pro.dgn
PROJECT LEADER:	G.S. GOODRICH
DESIGNED BY:	C.L. CILLEY
BR 16 VT 73 PROFILE SHEET	
PLOT DATE:	8/19/2013
DRAWN BY:	C.L. CILLEY
CHECKED BY:	D.M. PECK
SHEET	136 OF 238

