


- DRAINAGE**
- ① STA 334+42.9, 33.1' LT - 334+72.0, 31.8' LT
 CONST. 29 LF x 18" CPEP (SL)
 18" INV. @ INLET (31.8' LT) = 951.40
 18" INV. @ OUTLET (33.1' LT) = 949.00
 - ② STA 334+43.4, 38.1' LT - 334+60.8, 48.2' LT
 CONST. 22 LF x 6" PVC SLEEVE FOR UTILITIES
 6" INV. @ INLET (48.2' LT) = 949.45
 6" INV. @ OUTLET (38.1' LT) = 949.25
 6" PVC SLEEVE SHALL BE PAID FOR
 UNDER ITEM 625.10

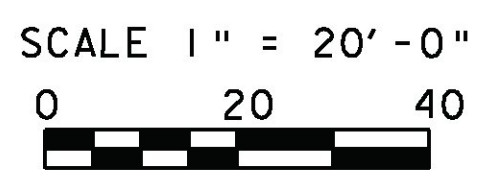

PROJECT NAME: ROCHESTER	PLOT DATE: 8/19/2013
PROJECT NUMBER: BRF 0162(17)	DRAWN BY: J.D. KEENER
FILE NAME: z85e035bdr_u+llty.dgn.dgn	DESIGNED BY: GMP
PROJECT LEADER: G.S. GOODRICH	CHECKED BY: S.E. BURBANK
BR 16 DRAINAGE & UTILITIES LAYOUT SHEET	SHEET 140 OF 238