

REMOVING SIGNS

STA 333+84, LT
 STA 333+90, RT
 STA 334+18, LT
 STA 334+25, RT
 STA 334+31, LT

4 INCH YELLOW LINE

STA 332+30 - 335+80, LT & RT

4 INCH WHITE LINE



STA 332+30 - 335+80, LT & RT

ERECTING SALVAGED SIGN

STA 334+31, LT

TRAFFIC SIGNS, TYPE A

STA 333+75, RT
 STA 334+31, LT

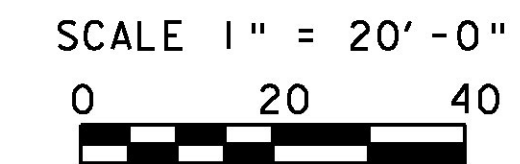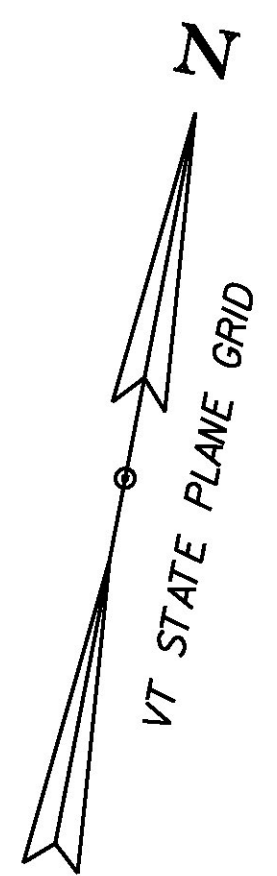

SIGNING LEGEND

N = NEW
 RET = RETAIN
 R = REMOVE
 S = SALVAGE

STRIPING LEGEND

DYL = DOUBLE YELLOW LINE
 SWL = SINGLE WHITE LINE

PROJECT NAME:	ROCHESTER
PROJECT NUMBER:	BRF 0162(17)
FILE NAME:	z85e035+sl.dgn
PROJECT LEADER:	G.S. GOODRICH
DESIGNED BY:	E.A. FIALA
PLOT DATE:	8/19/2013
DRAWN BY:	E.A. FIALA
CHECKED BY:	S.E. BURBANK
BR 16 TRAFFIC SIGNS & LINE STRIPING SHEET SHEET 141 OF 238	

