




**ABUTMENT NO 1, NEXT 1**  
SCALE 3/4" = 1'-0"

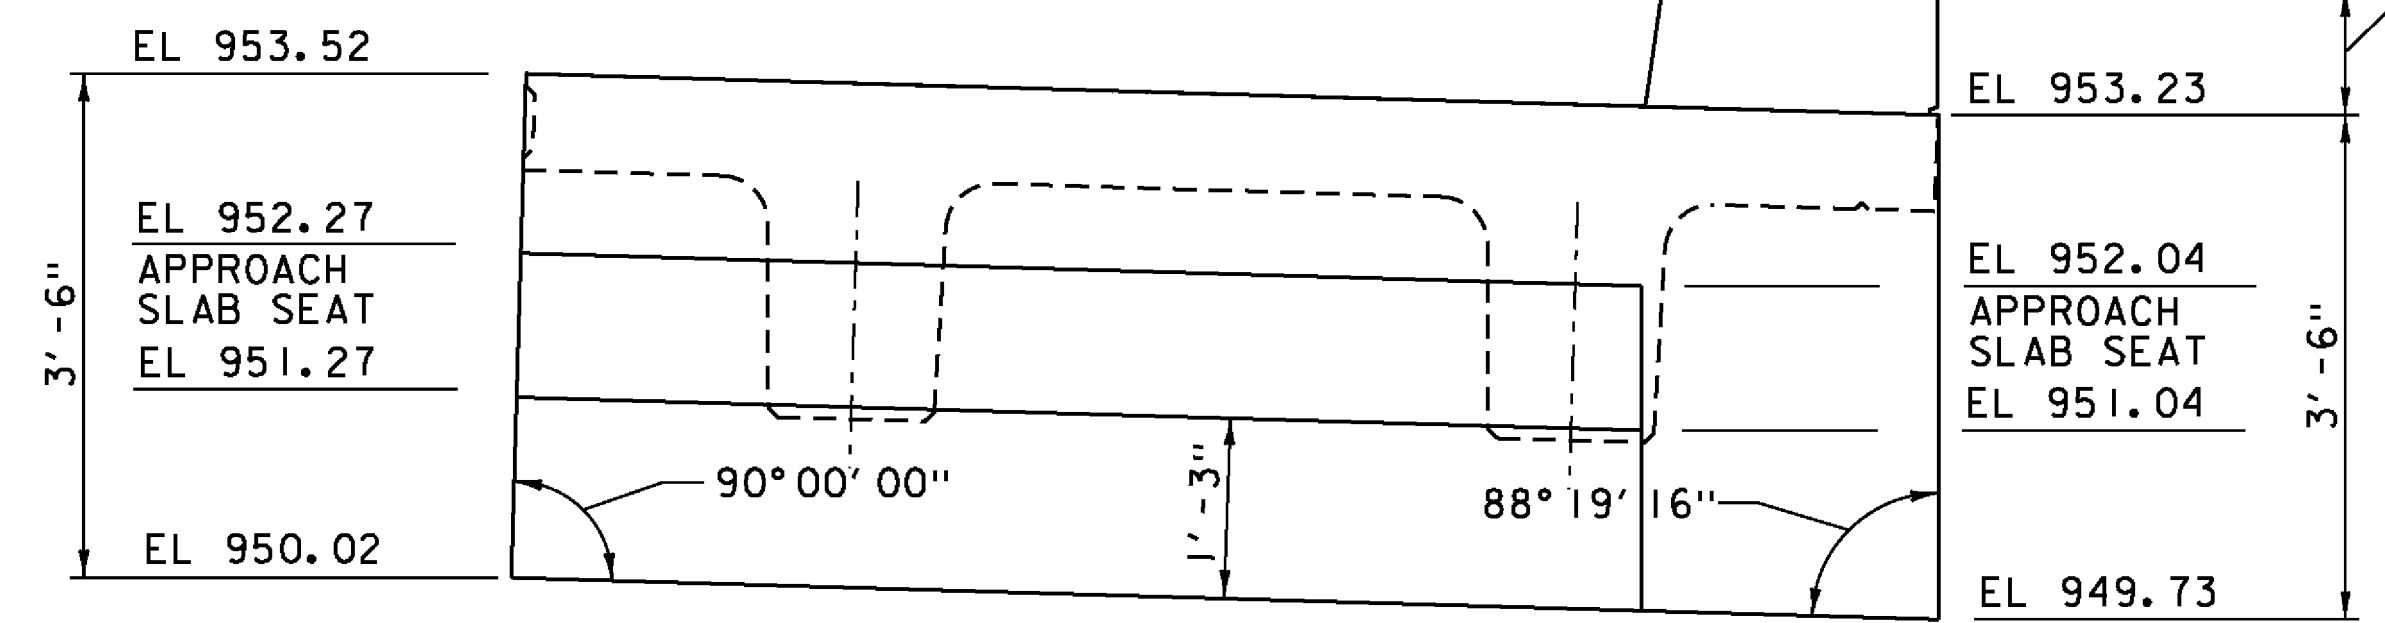


**ABUTMENT NO 2, NEXT 1**  
SCALE 3/4" = 1'-0"

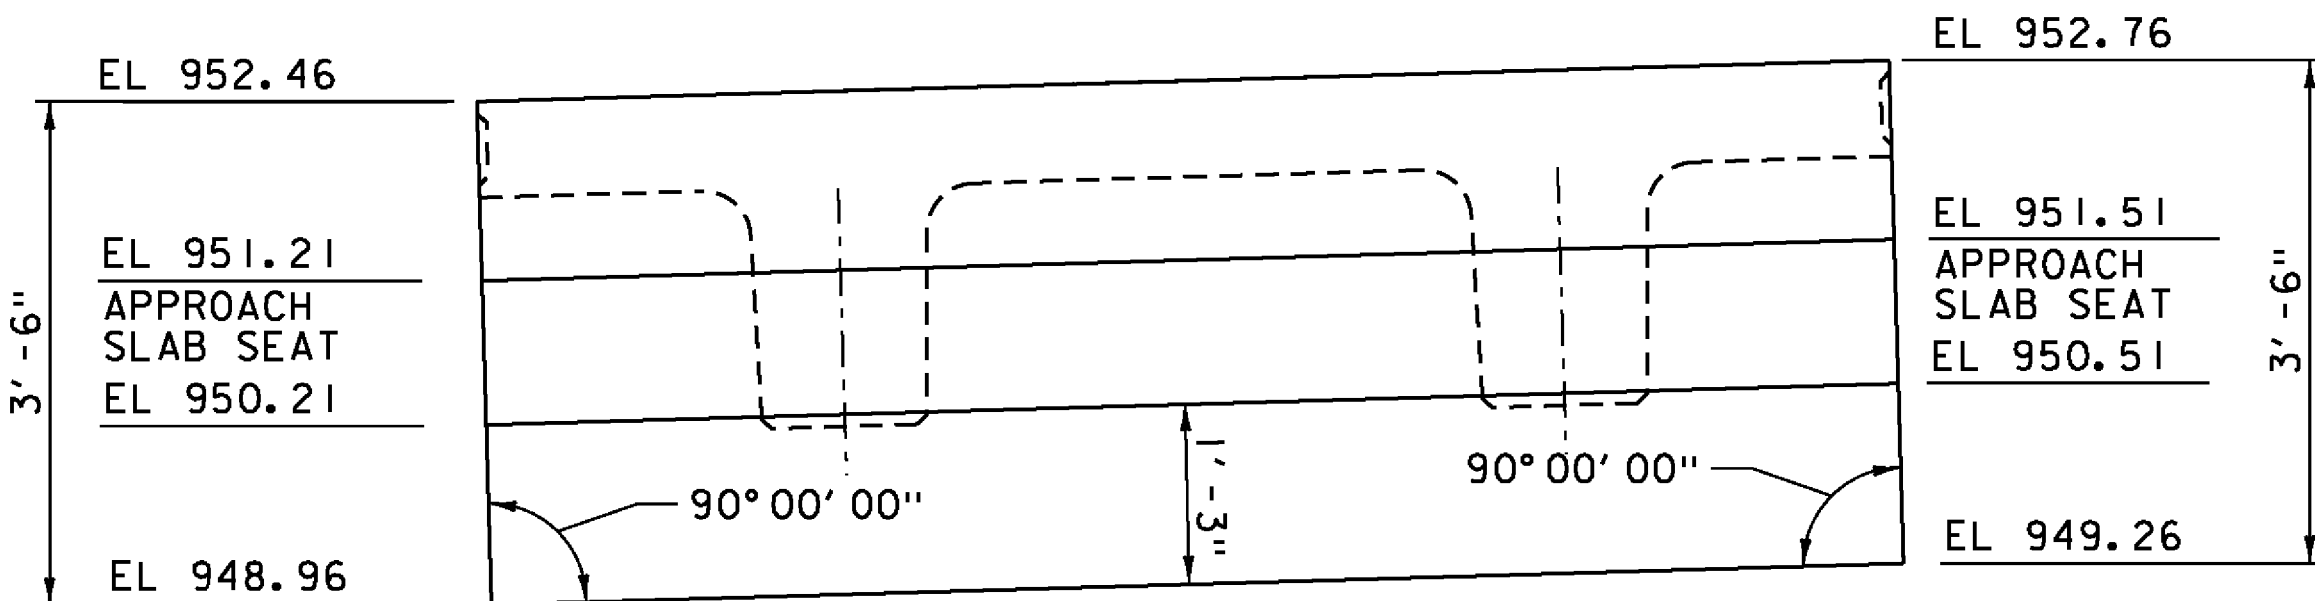


**ABUTMENT NO 1, NEXT 2**  
SCALE 3/4" = 1'-0"

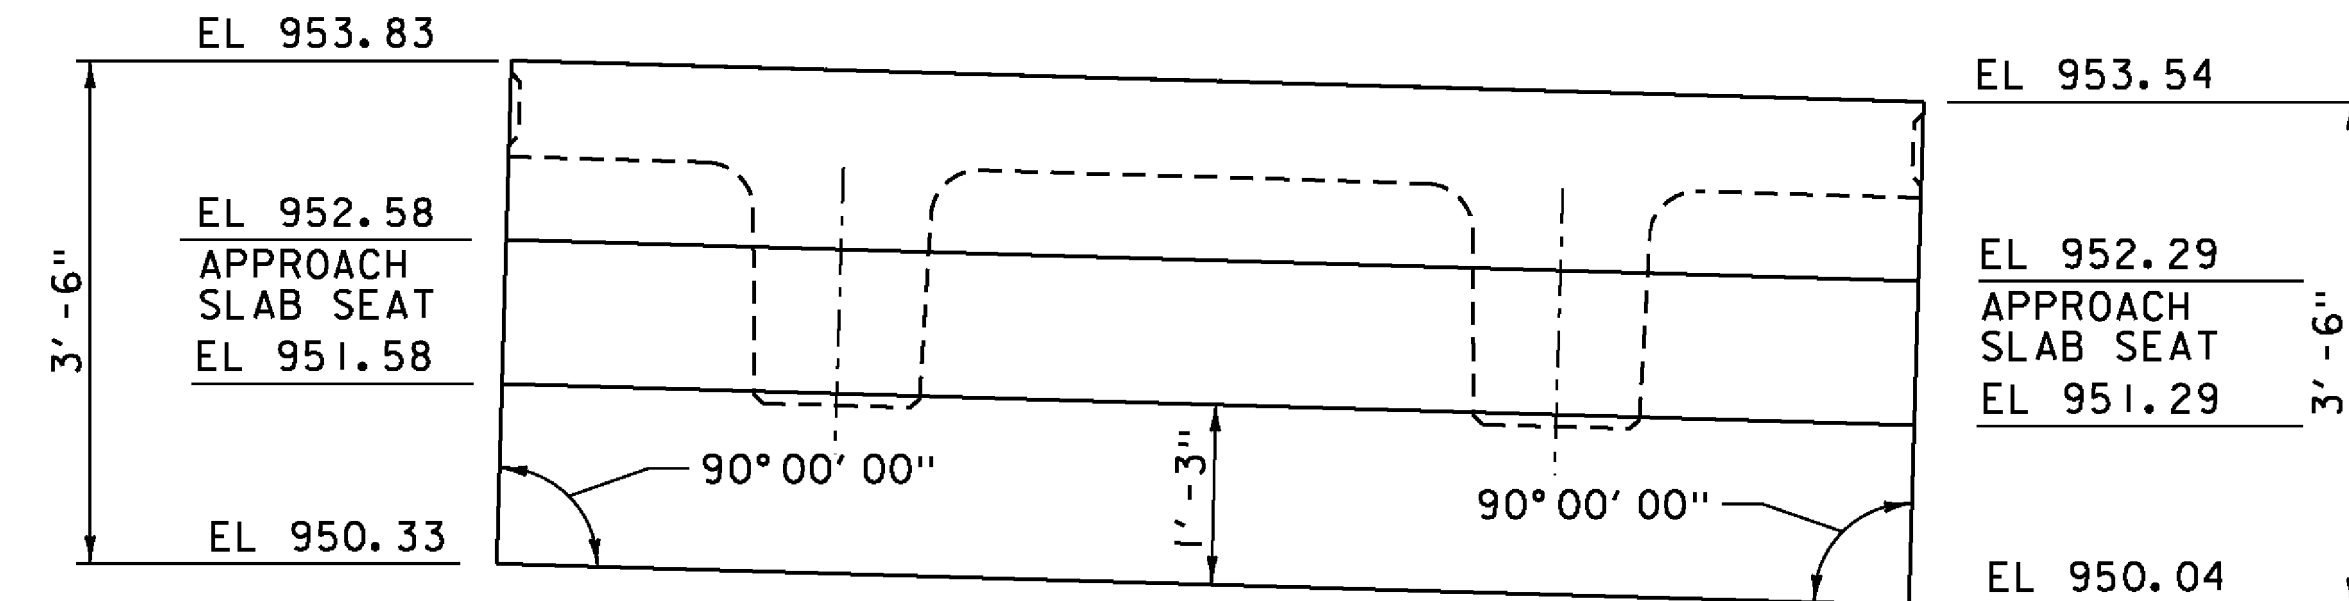

**ABUTMENT NO 2, NEXT 2**  
SCALE 3/4" = 1'-0"

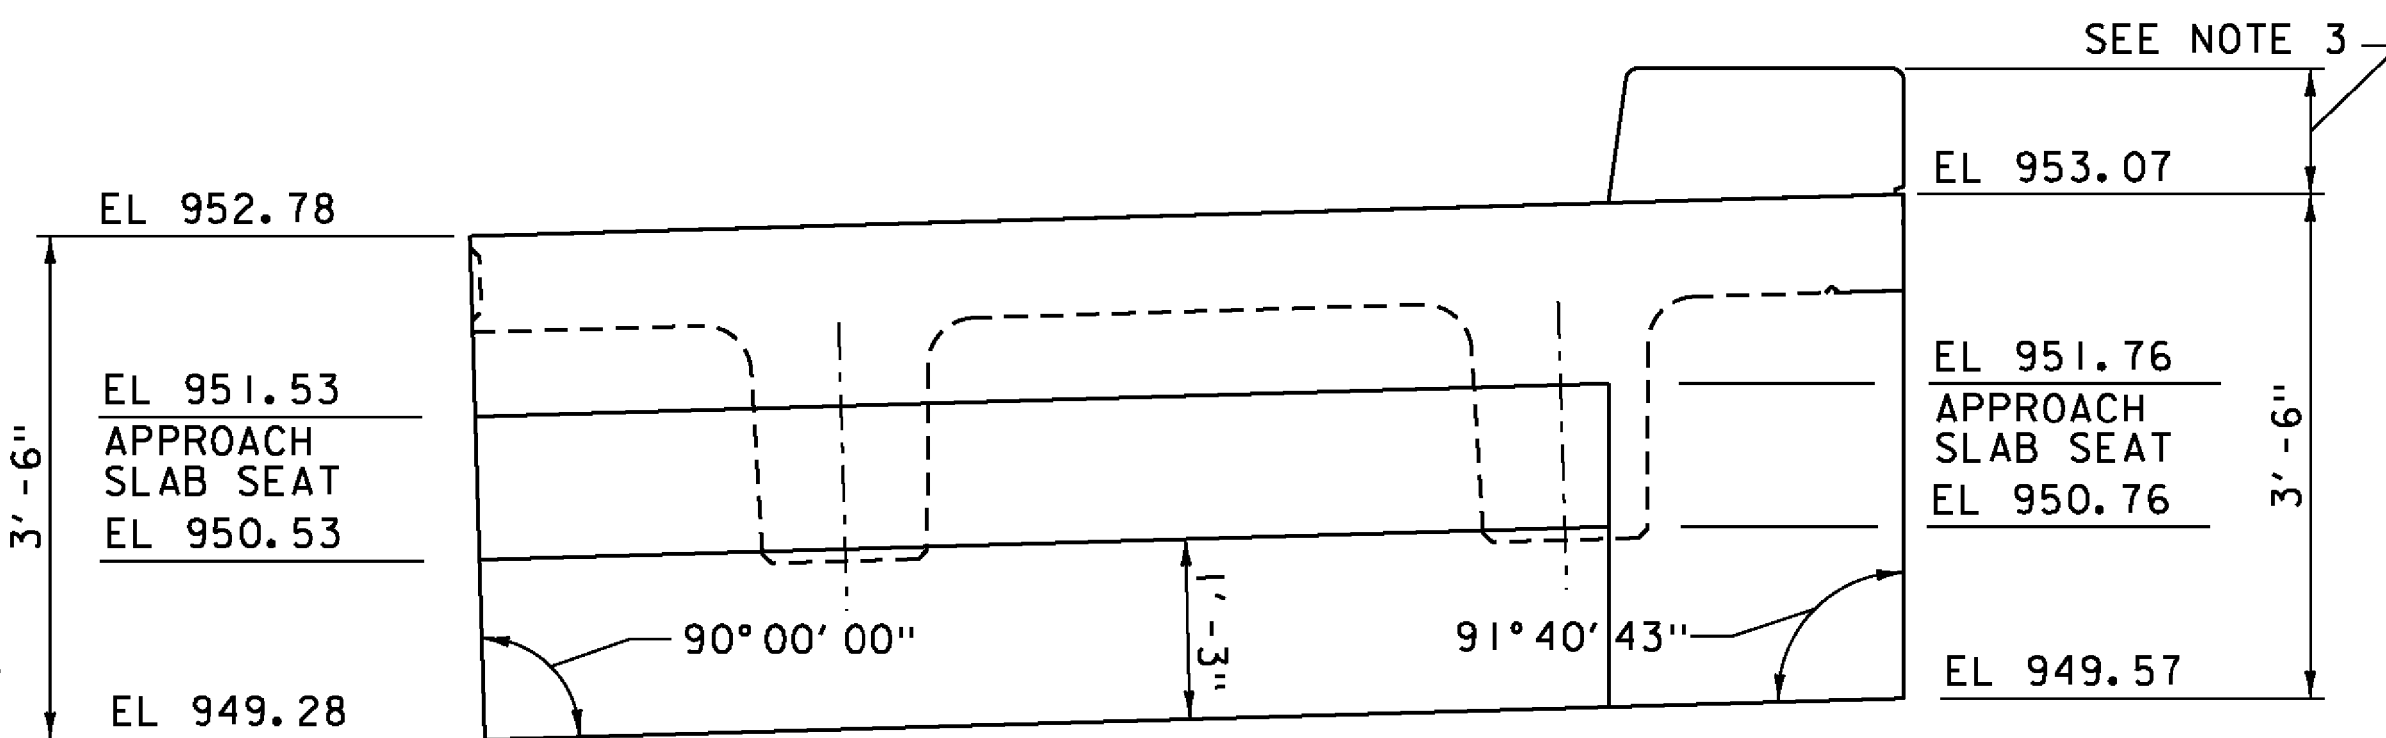

**ABUTMENT NO 1, NEXT 3**  
SCALE 3/4" = 1'-0"

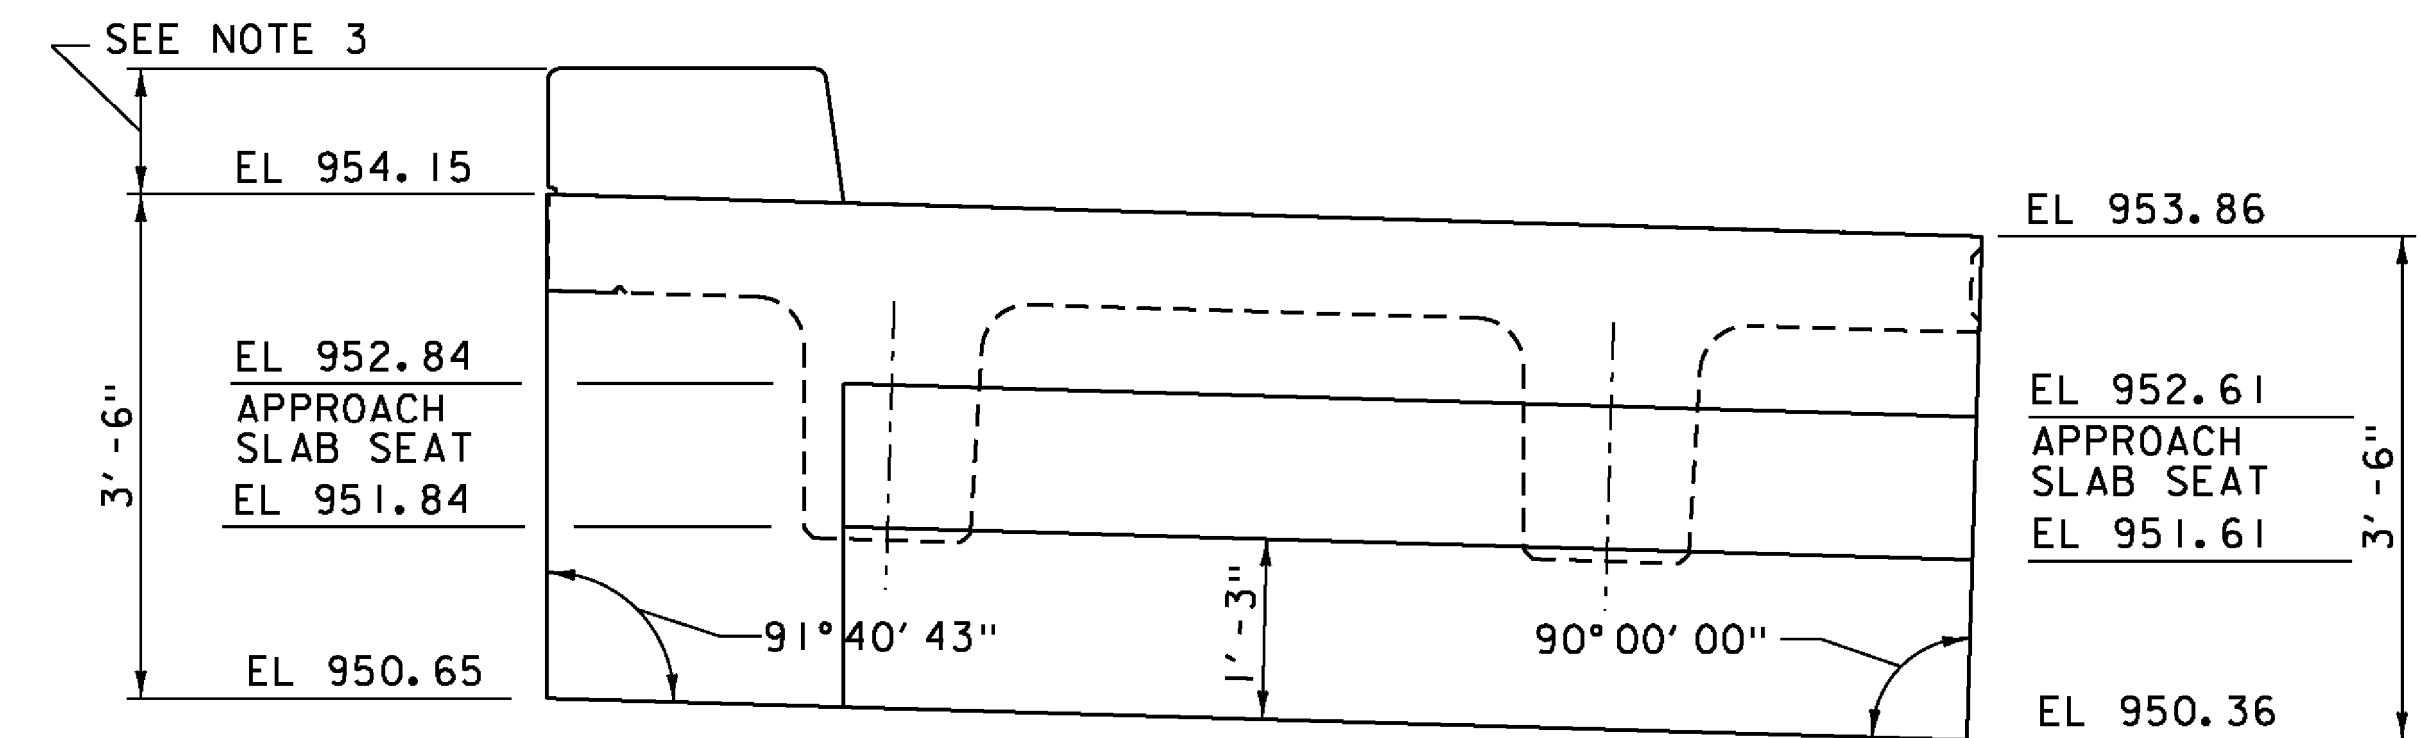

**ABUTMENT NO 2, NEXT 3**  
SCALE 3/4" = 1'-0"

- NOTES:**
- SEE BR 16 CURTAIN WALL DETAILS SHEET (1 OF 2) FOR HORIZONTAL DIMENSIONS AND CURTAIN WALL LIMITS.
  - SEE BR 16 NEXT BEAM DETAILS SHEET (3 OF 3) FOR PRECAST CURTAIN WALL SECTION AND REINFORCING INFORMATION.
  - SEE CURB HEIGHT DETAIL ON BR 16 NEXT BEAM DETAILS SHEET (2 OF 3).

REVISION	DESCRIPTION	DATE
△	ELEVATION CHANGES	6/11/2014
PROJECT NAME: ROCHESTER		
PROJECT NUMBER: BRF 0162(17)		
FILE NAME: z85e035sup.dgn		PLOT DATE: 6/9/2014
PROJECT LEADER: G.S. GOODRICH		DRAWN BY: B.J. MASSE
DESIGNED BY: G.S. GOODRICH		CHECKED BY: L.S. CHERVINCKY
BR 16 CURTAIN WALL DETAILS (2 OF 2)		SHEET 152A OF 238

