


**ABUTMENT NO. 1 PLAN**  
SCALE 1/2" = 1'-0"

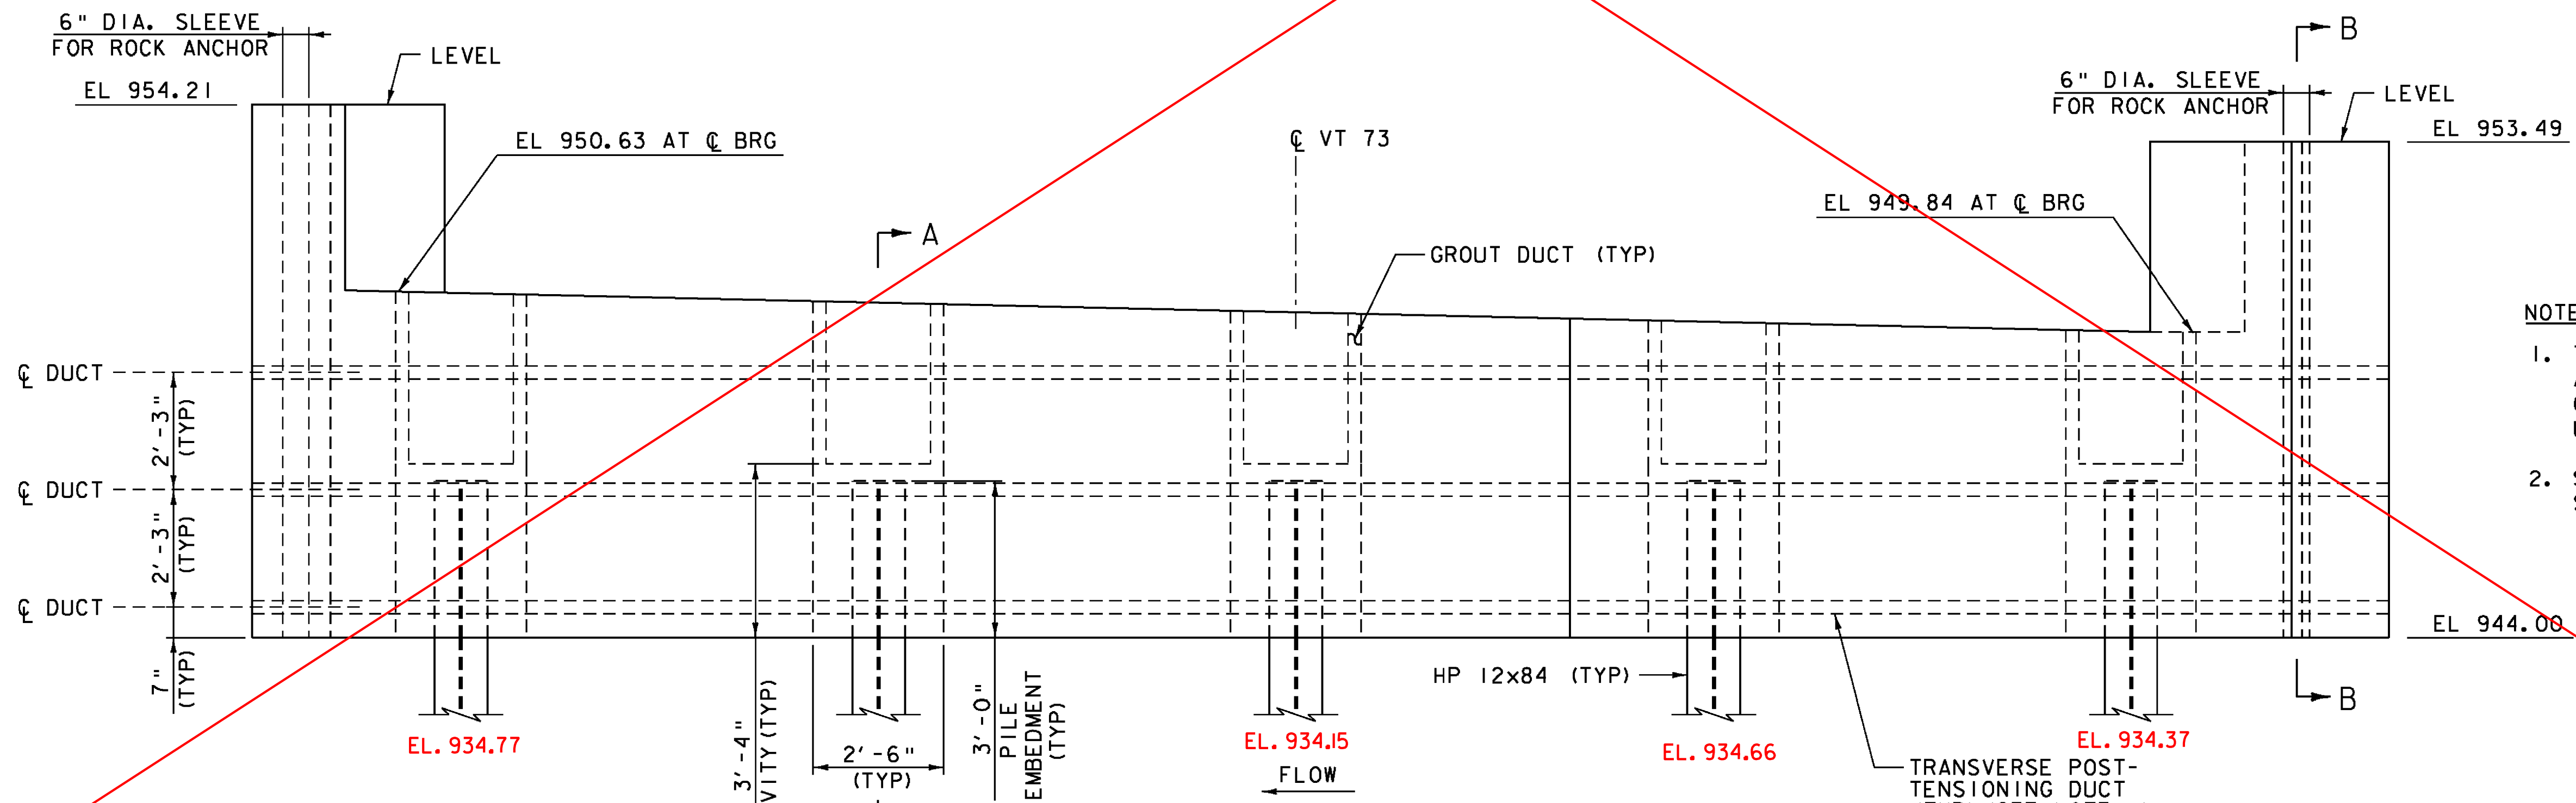

**ABUTMENT NO. 1 ELEVATION**  
SCALE 1/2" = 1'-0"

- NOTES:**
1. TRANSVERSE POST-TENSIONING AND ASSOCIATED ITEMS ONLY REQUIRED IF PILE CAP IS CONSTRUCTED OF MORE THAN ONE UNIT.
  2. SEE BR 16 ABUTMENT DETAILS SHEET FOR SECTIONS A-A AND B-B.

PROJECT NAME: ROCHESTER	PLOT DATE: 8/19/2013
PROJECT NUMBER: BRF 0162(17)	DRAWN BY: B.J. MASSE
FILE NAME: z85e035sub.dgn	CHECKED BY: L.S. CHERVINCKY
PROJECT LEADER: G.S. GOODRICH	SHEET 156 OF 238
DESIGNED BY: E.A. FIALA	
BR 16 ABUTMENT NO. 1 PLAN & ELEVATION	

