


ABUTMENT NO 1 PLAN
SCALE 1/2" = 1'-0"

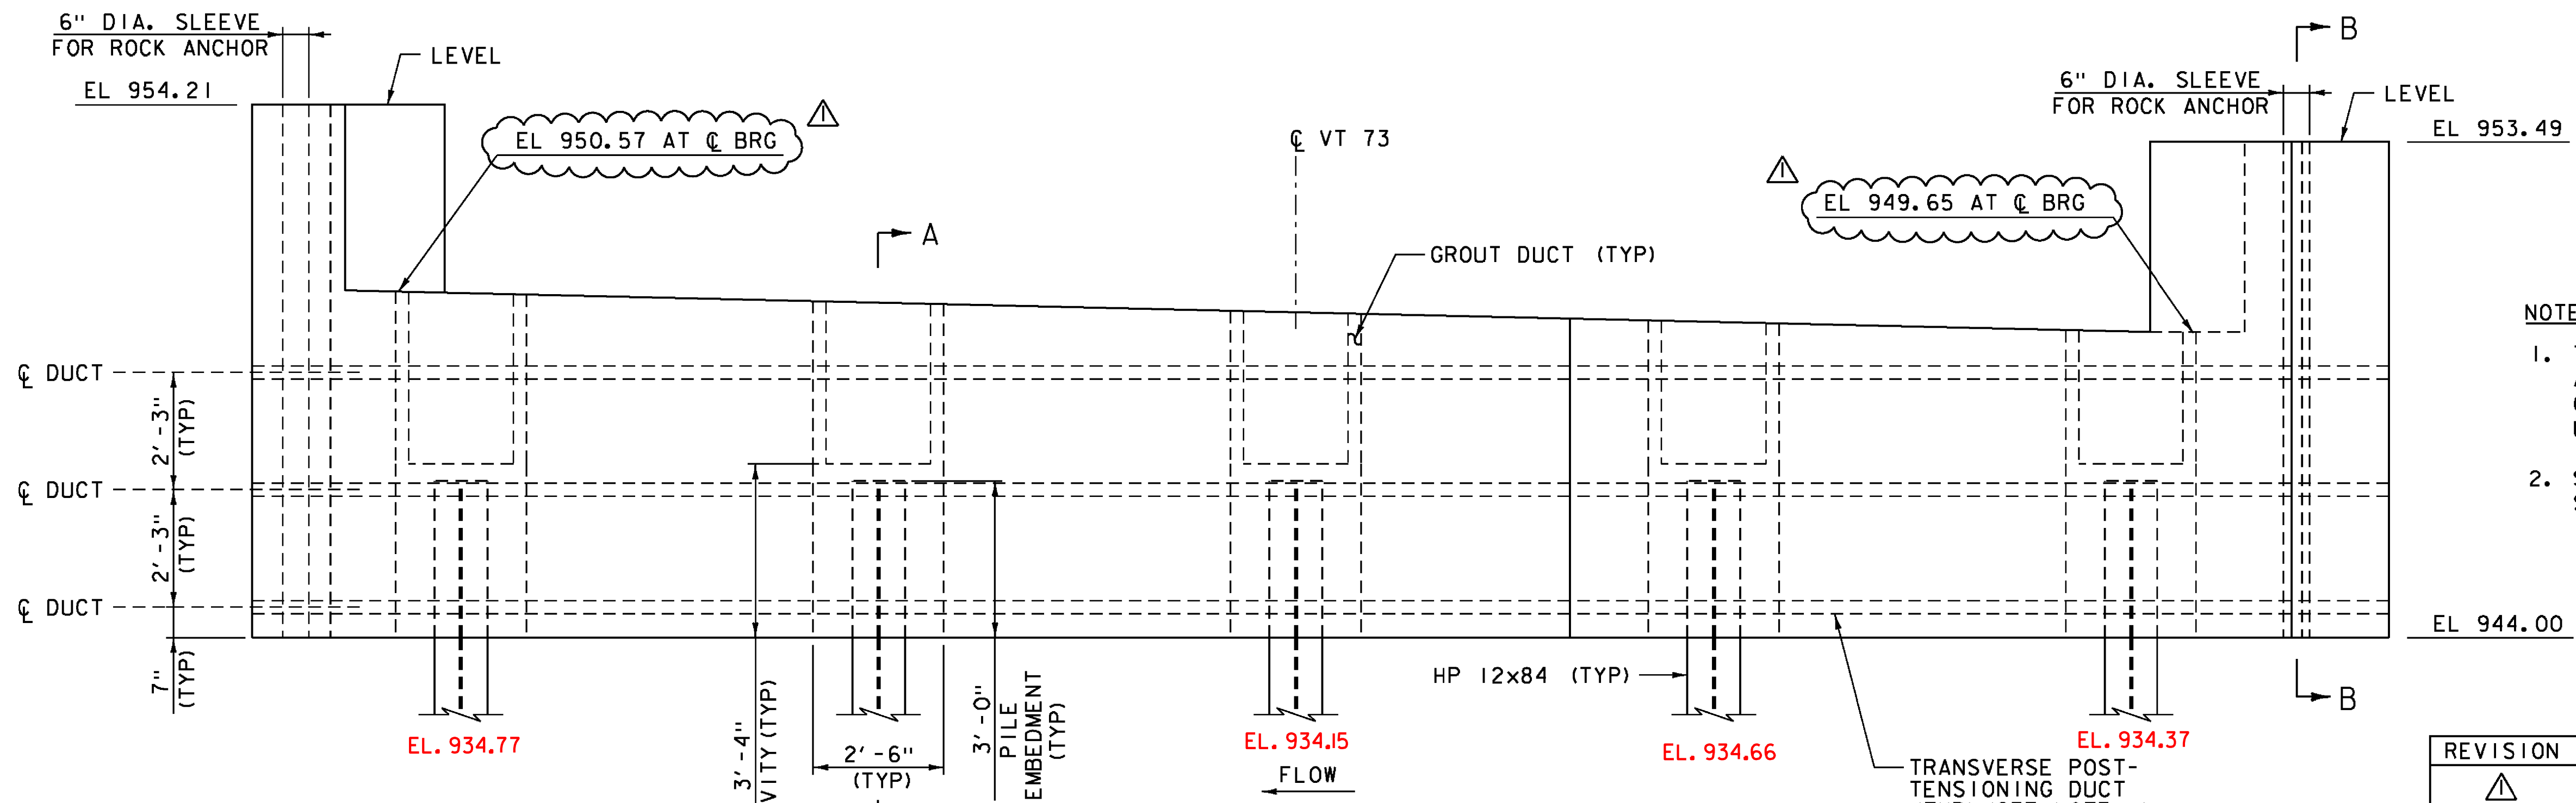

ABUTMENT NO 1 ELEVATION
SCALE 1/2" = 1'-0"

- NOTES:**
1. TRANSVERSE POST-TENSIONING AND ASSOCIATED ITEMS ONLY REQUIRED IF PILE CAP IS CONSTRUCTED OF MORE THAN ONE UNIT.
 2. SEE BR 16 ABUTMENT DETAILS SHEET FOR SECTIONS A-A AND B-B.

REVISION	DESCRIPTION	DATE
△	ELEVATION CHANGES	6/11/2014
PROJECT NAME: ROCHESTER		
PROJECT NUMBER: BRF 0162(17)		
FILE NAME: z85e035sub.dgn		PLOT DATE: 6/9/2014
PROJECT LEADER: G.S. GOODRICH		DRAWN BY: B.J. MASSE
DESIGNED BY: E.A. FIALA		CHECKED BY: L.S. CHERVINCKY
BR 16 ABUTMENT NO 1 PLAN & ELEVATION		SHEET 156A OF 238

