


ABUTMENT NO 2 PLAN
SCALE 1/2" = 1'-0"

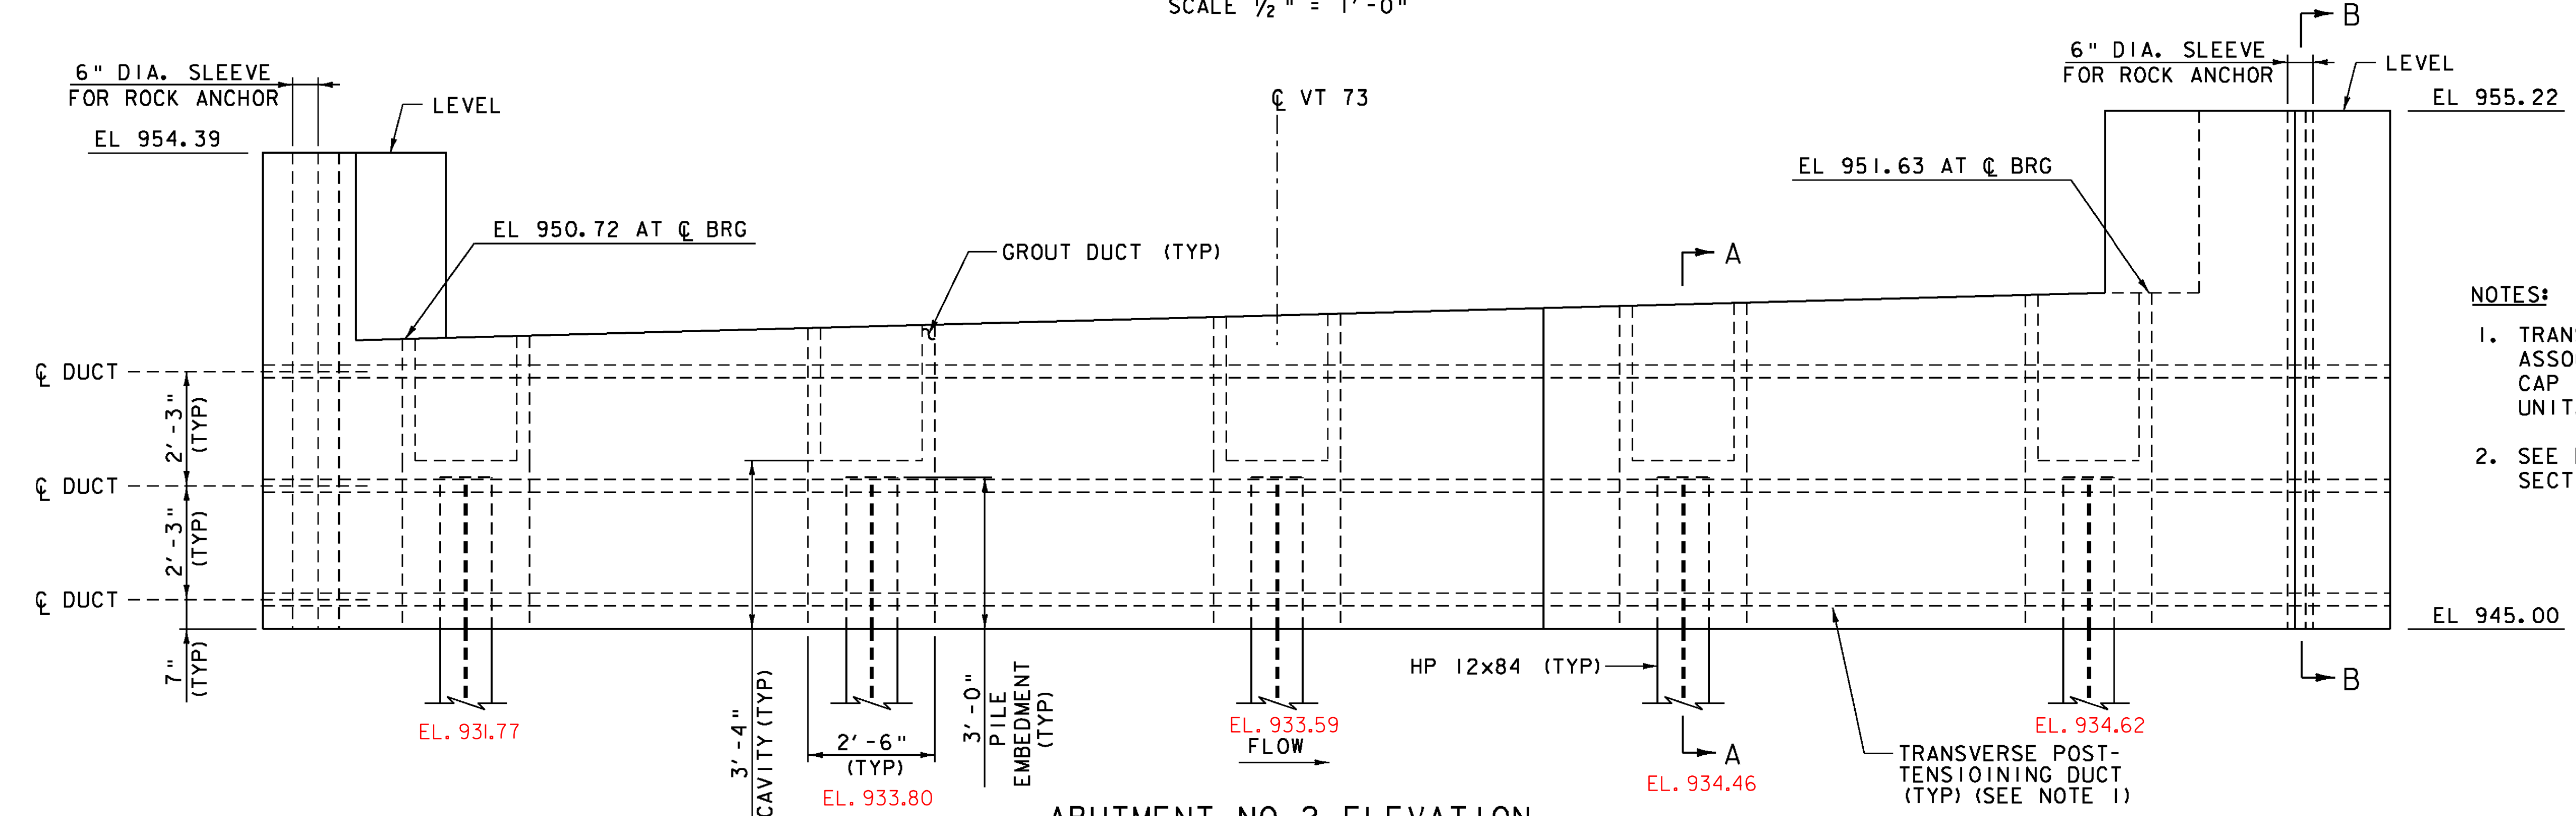

ABUTMENT NO 2 ELEVATION
SCALE 1/2" = 1'-0"

- NOTES:**
1. TRANSVERSE POST-TENSIONING AND ASSOCIATED ITEMS ONLY REQUIRED IF PILE CAP IS CONSTRUCTED OF MORE THAN ONE UNIT.
 2. SEE BR 16 ABUTMENT DETAILS SHEET FOR SECTIONS A-A AND B-B.

PROJECT NAME:	ROCHESTER
PROJECT NUMBER:	BRF 0162(17)
FILE NAME:	z85e035sub.dgn
PROJECT LEADER:	G.S. GOODRICH
DESIGNED BY:	E.A. FIALA
BR 16 ABUTMENT NO 2 PLAN & ELEVATION SHEET	157 OF 238
PLOT DATE:	8/19/2013
DRAWN BY:	E.A. FIALA
CHECKED BY:	L.S. CHERVINCKY

