



STA 12+55, LT
 END UNCLASSIFIED CHANNEL EXCAVATION
 GEOTEXTILE FOR STONE FILL
 STONE FILL, TYPE IV
 GRUBBING MATERIAL

12+75

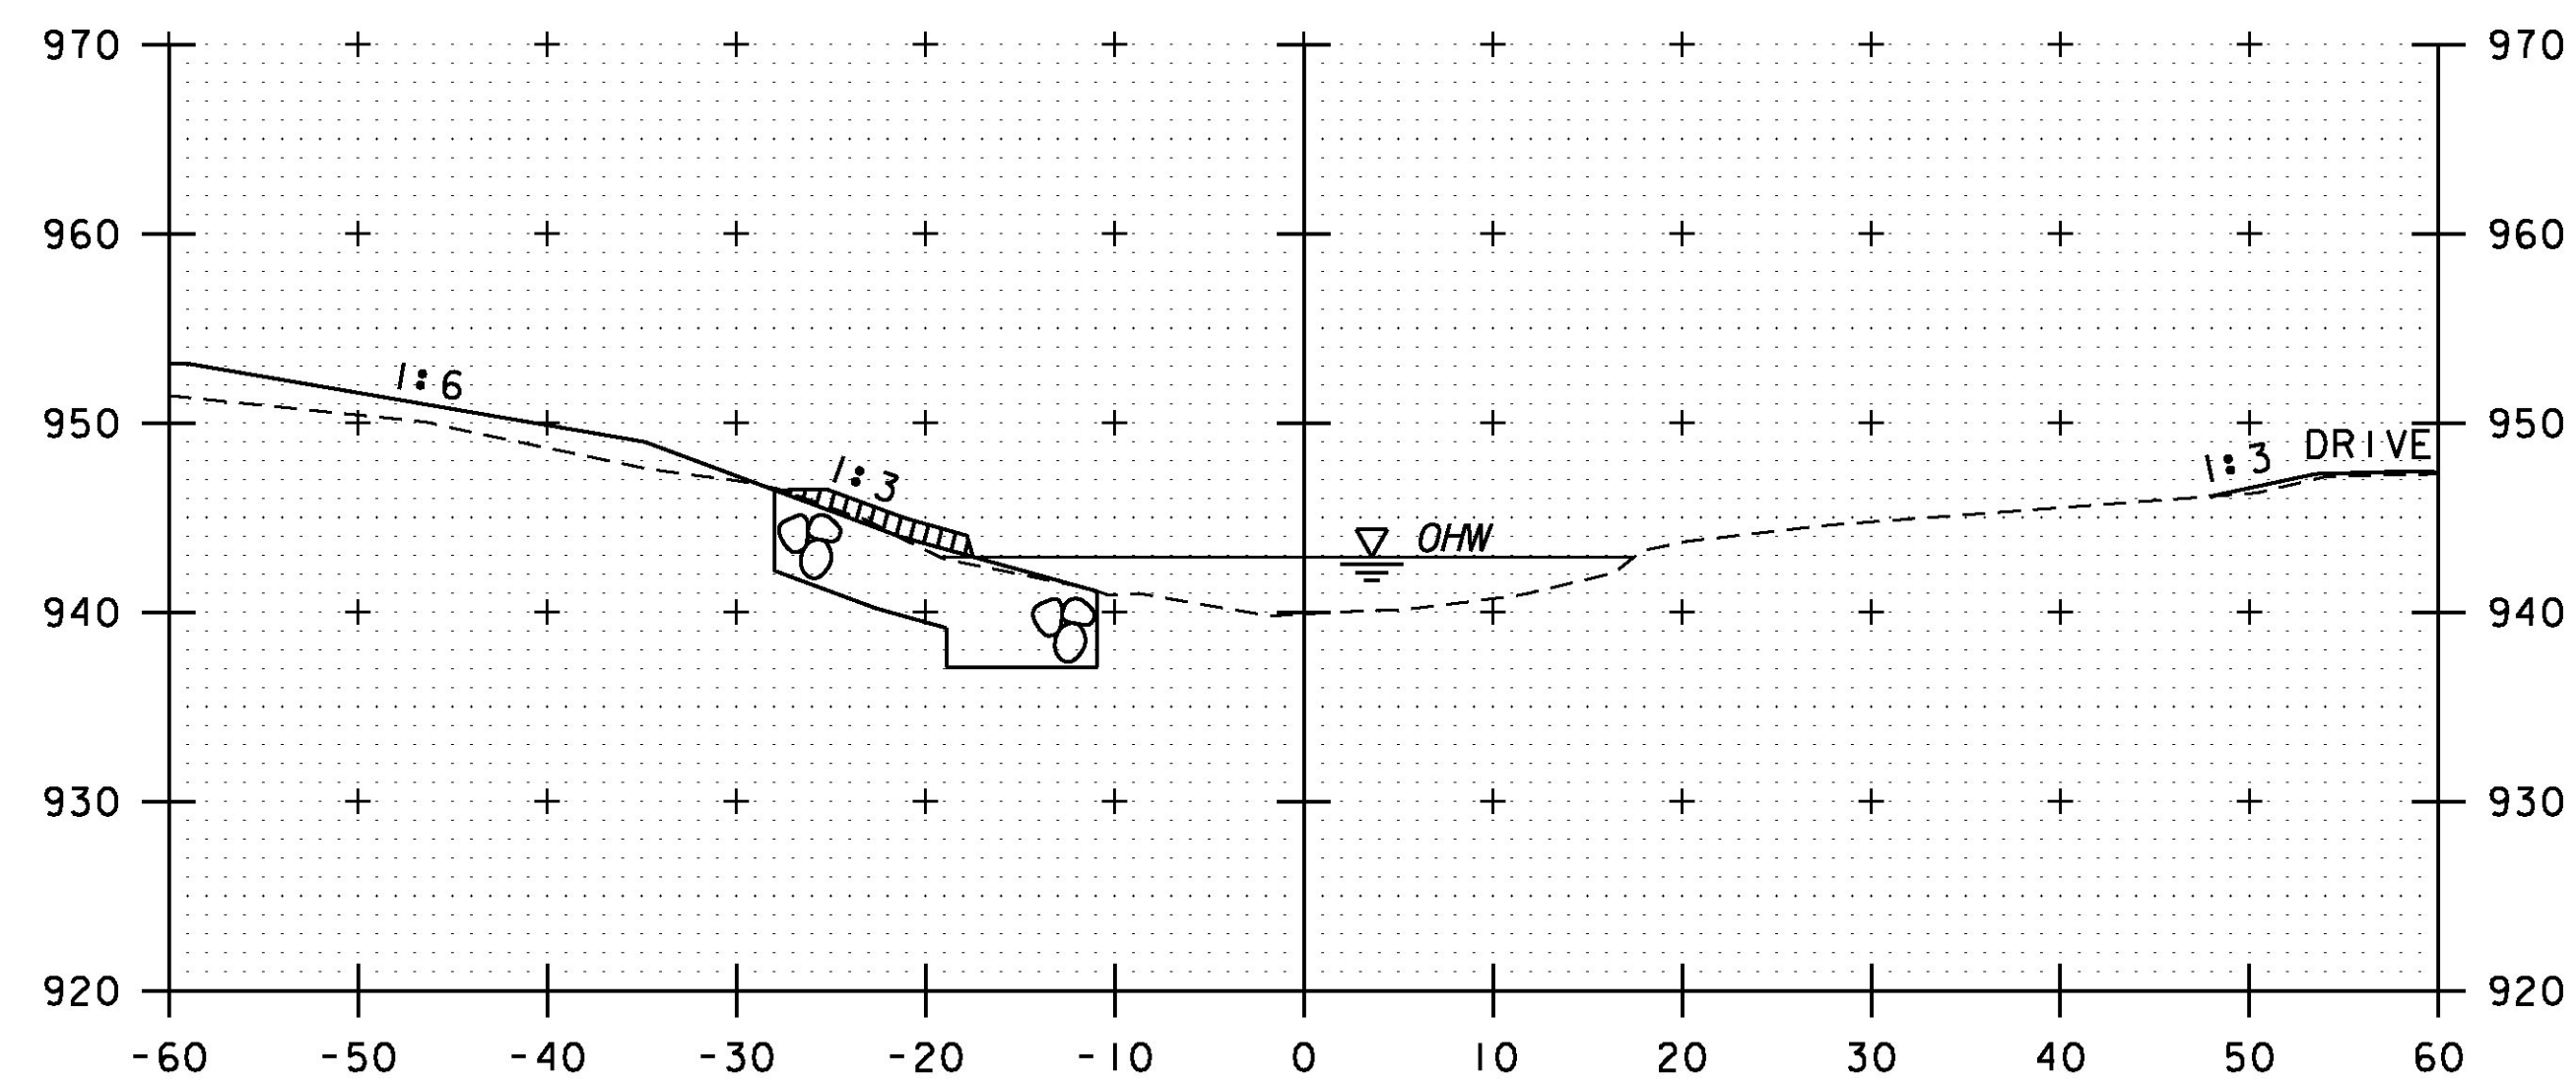

STA 12+45, RT
 END UNCLASSIFIED CHANNEL EXCAVATION
 GEOTEXTILE FOR STONE FILL
 STONE FILL, TYPE IV
 GRUBBING MATERIAL

12+50

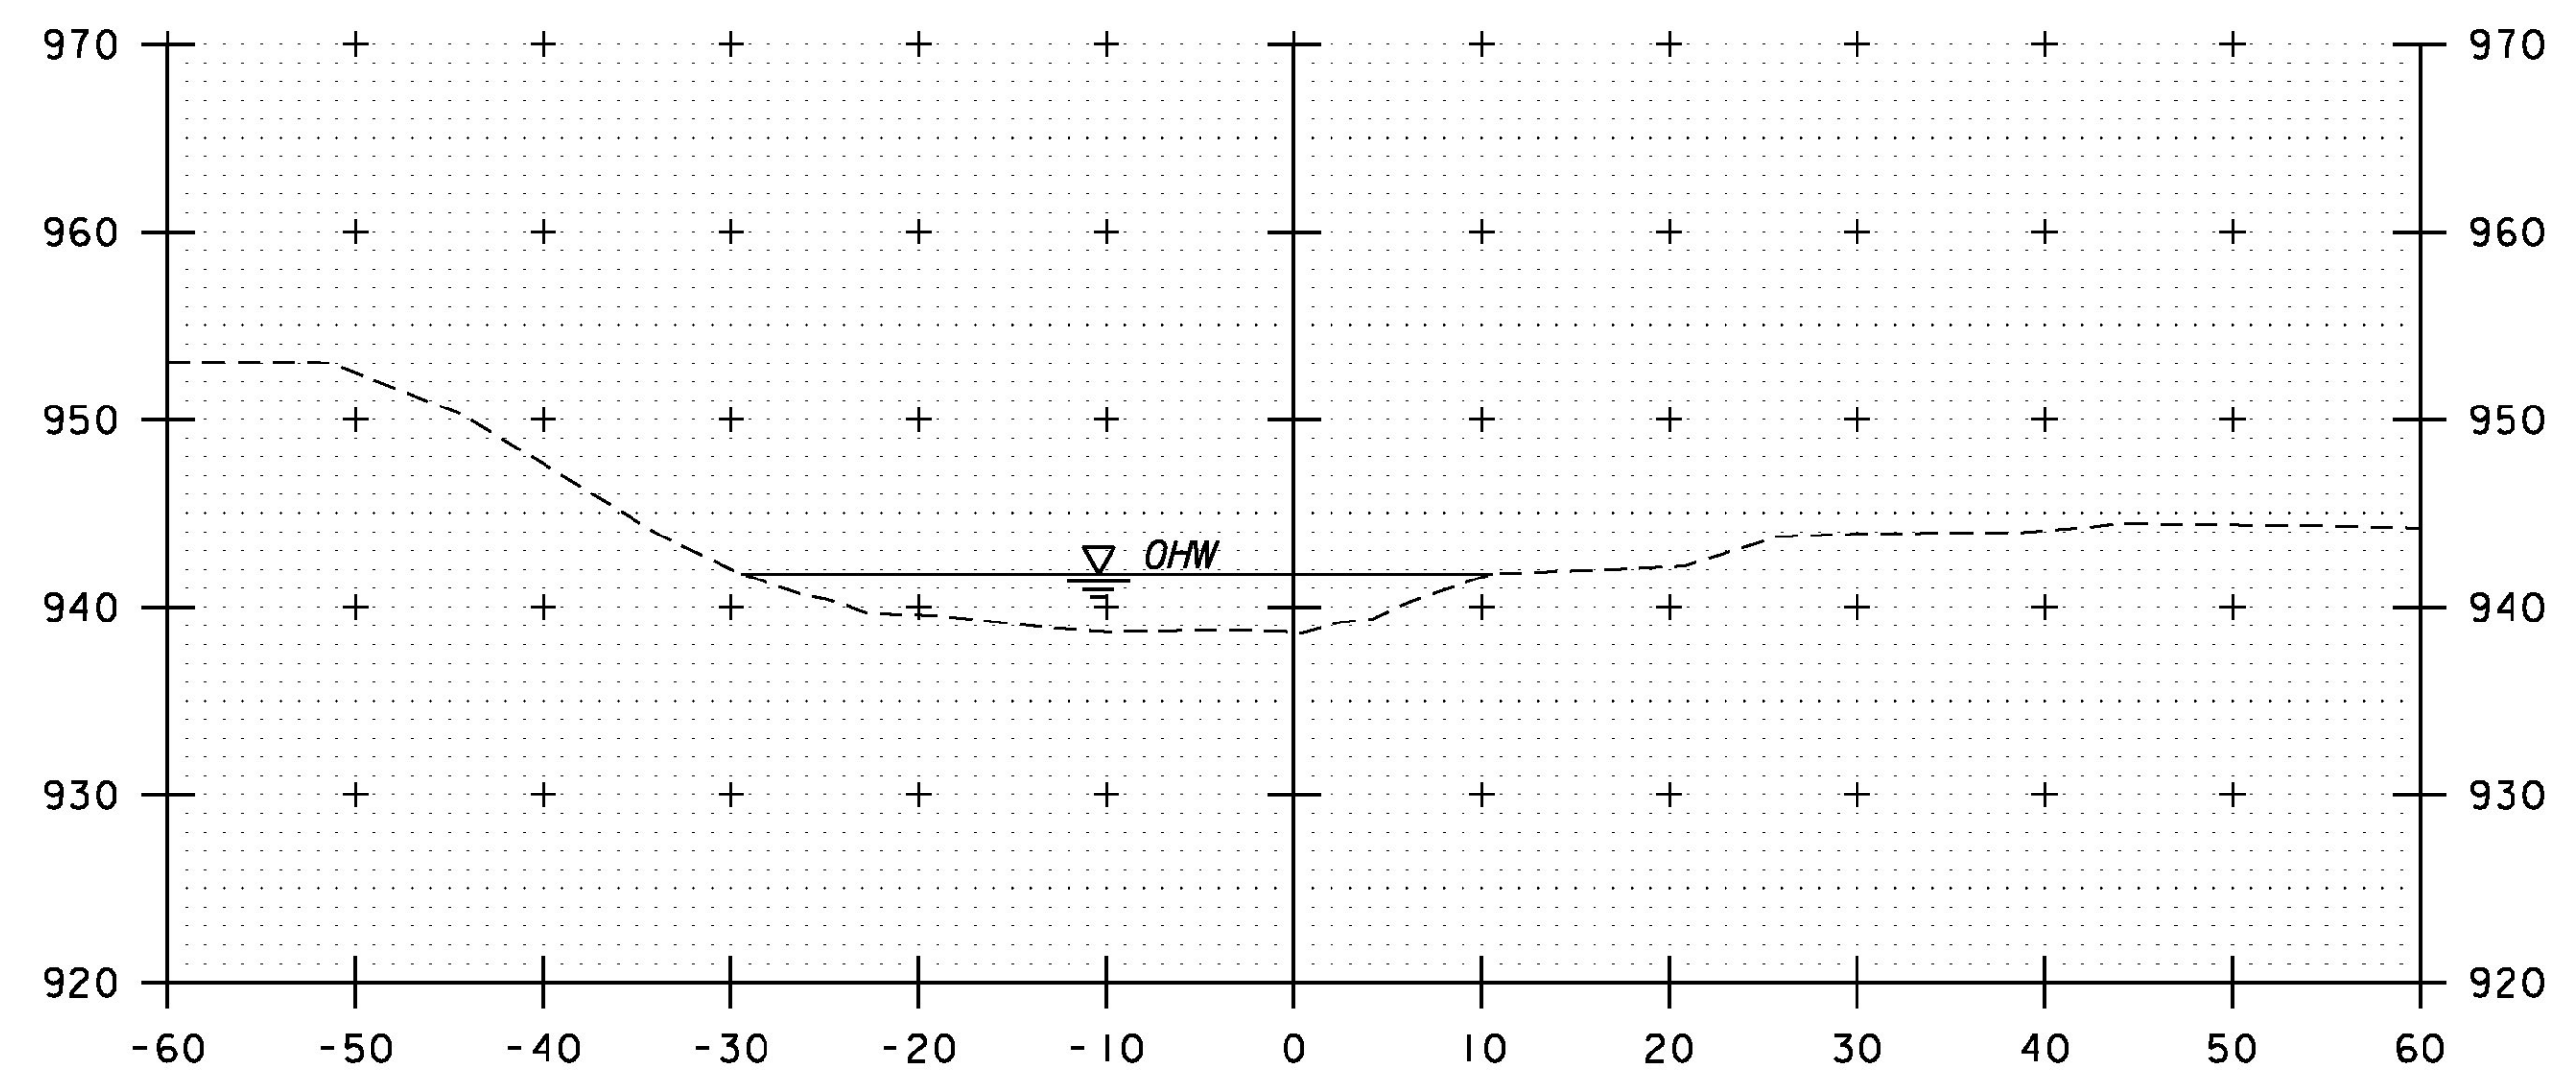

13+00

CHANNEL CROSS SECTIONS
 STA 12+50 TO STA 13+00



PROJECT NAME: ROCHESTER	PLOT DATE: 8/19/2013
PROJECT NUMBER: BRF 0162(17)	DRAWN BY: C.L. CILLEY
FILE NAME: z85e035xsl.dgn	CHECKED BY: G.S. GOODRICH
DESIGNED BY: C.L. CILLEY	SHEET 165 OF 238
BR 16 CHANNEL CROSS SECTIONS (2 OF 2)	