


NOTE:
 1. SEE BR 16 EROSION CONTROL DETAILS FOR SYMBOLOLOGY.



SCALE 1" = 20'-0"
 0 20 40

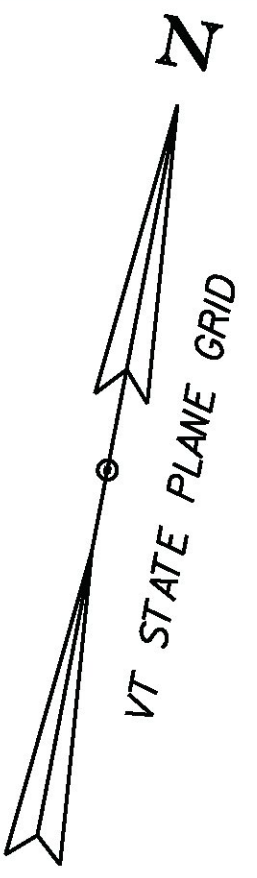

PROJECT NAME: ROCHESTER	PLOT DATE: 8/19/2013
PROJECT NUMBER: BRF 0162(17)	DRAWN BY: E.A. FIALA
FILE NAME: z85e035bdr_ero.dgn	CHECKED BY: B.O. CRONIN
PROJECT LEADER: G.S. GOODRICH	SHEET 169 OF 238
DESIGNED BY: E.A. FIALA	
BR 16 EPSC FINAL SITE PLAN	