



BEGIN APPROACH SECTION
NOT TO SCALE

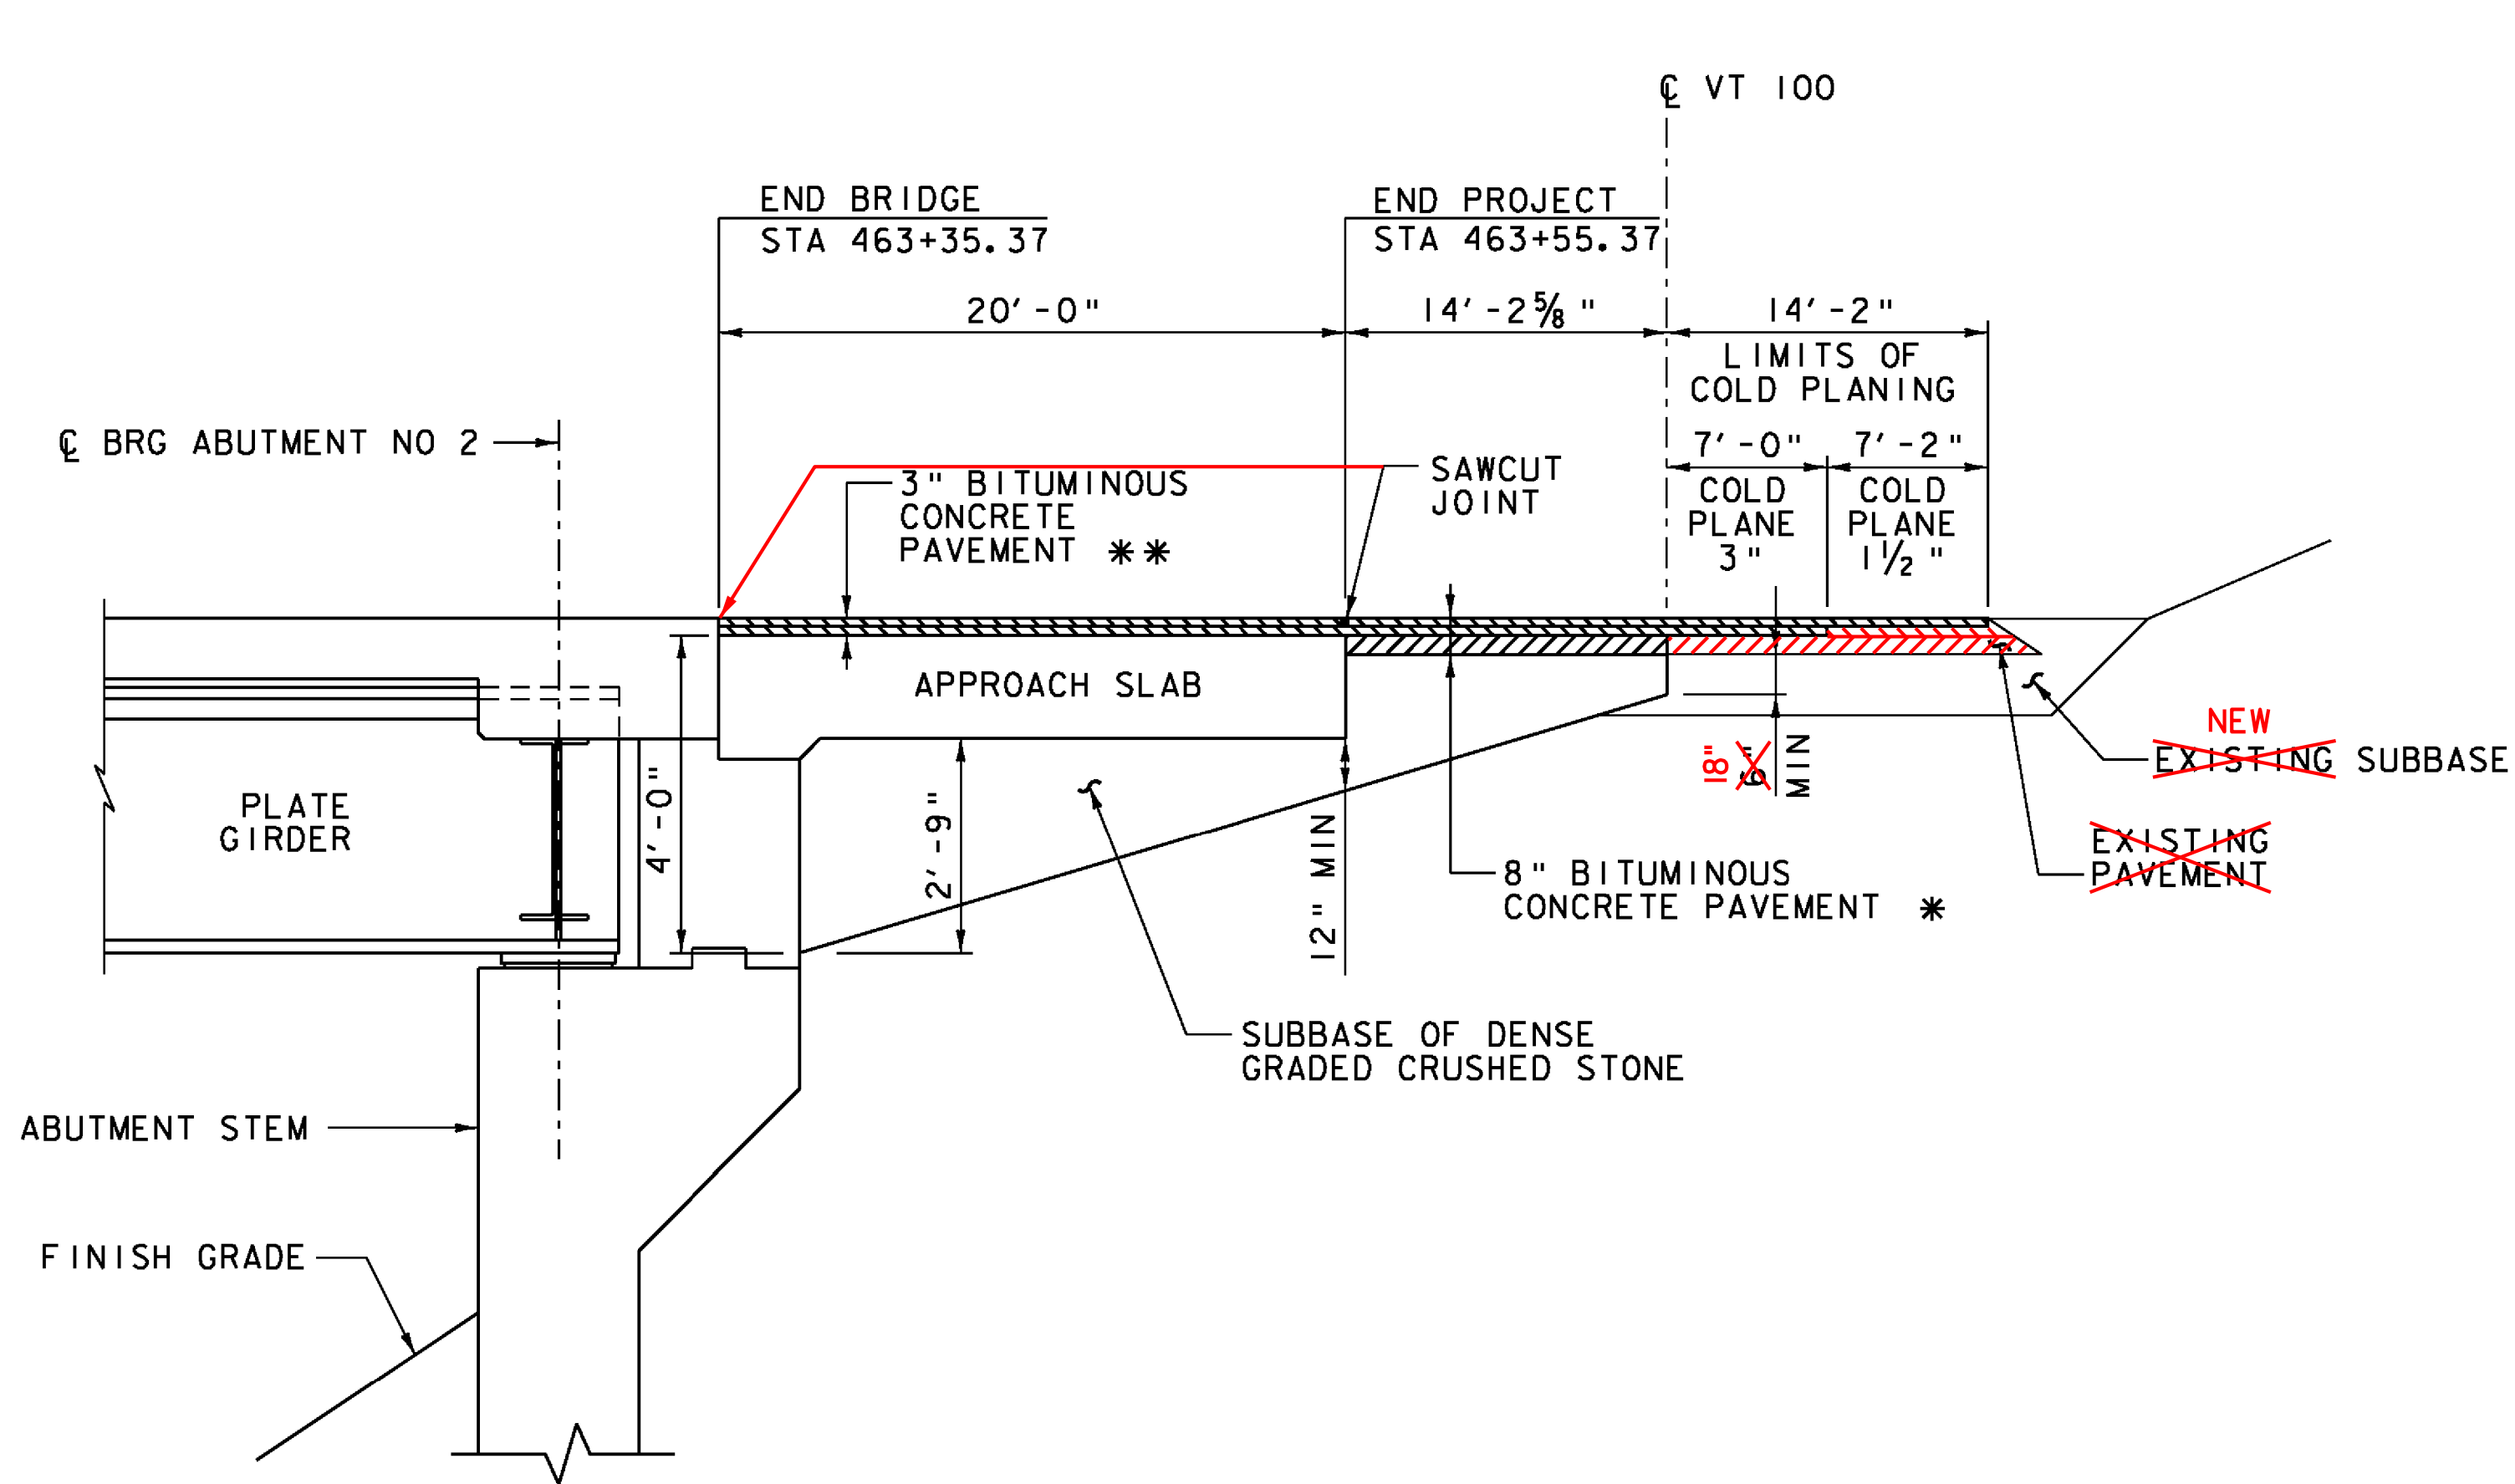

END APPROACH SECTION
NOT TO SCALE

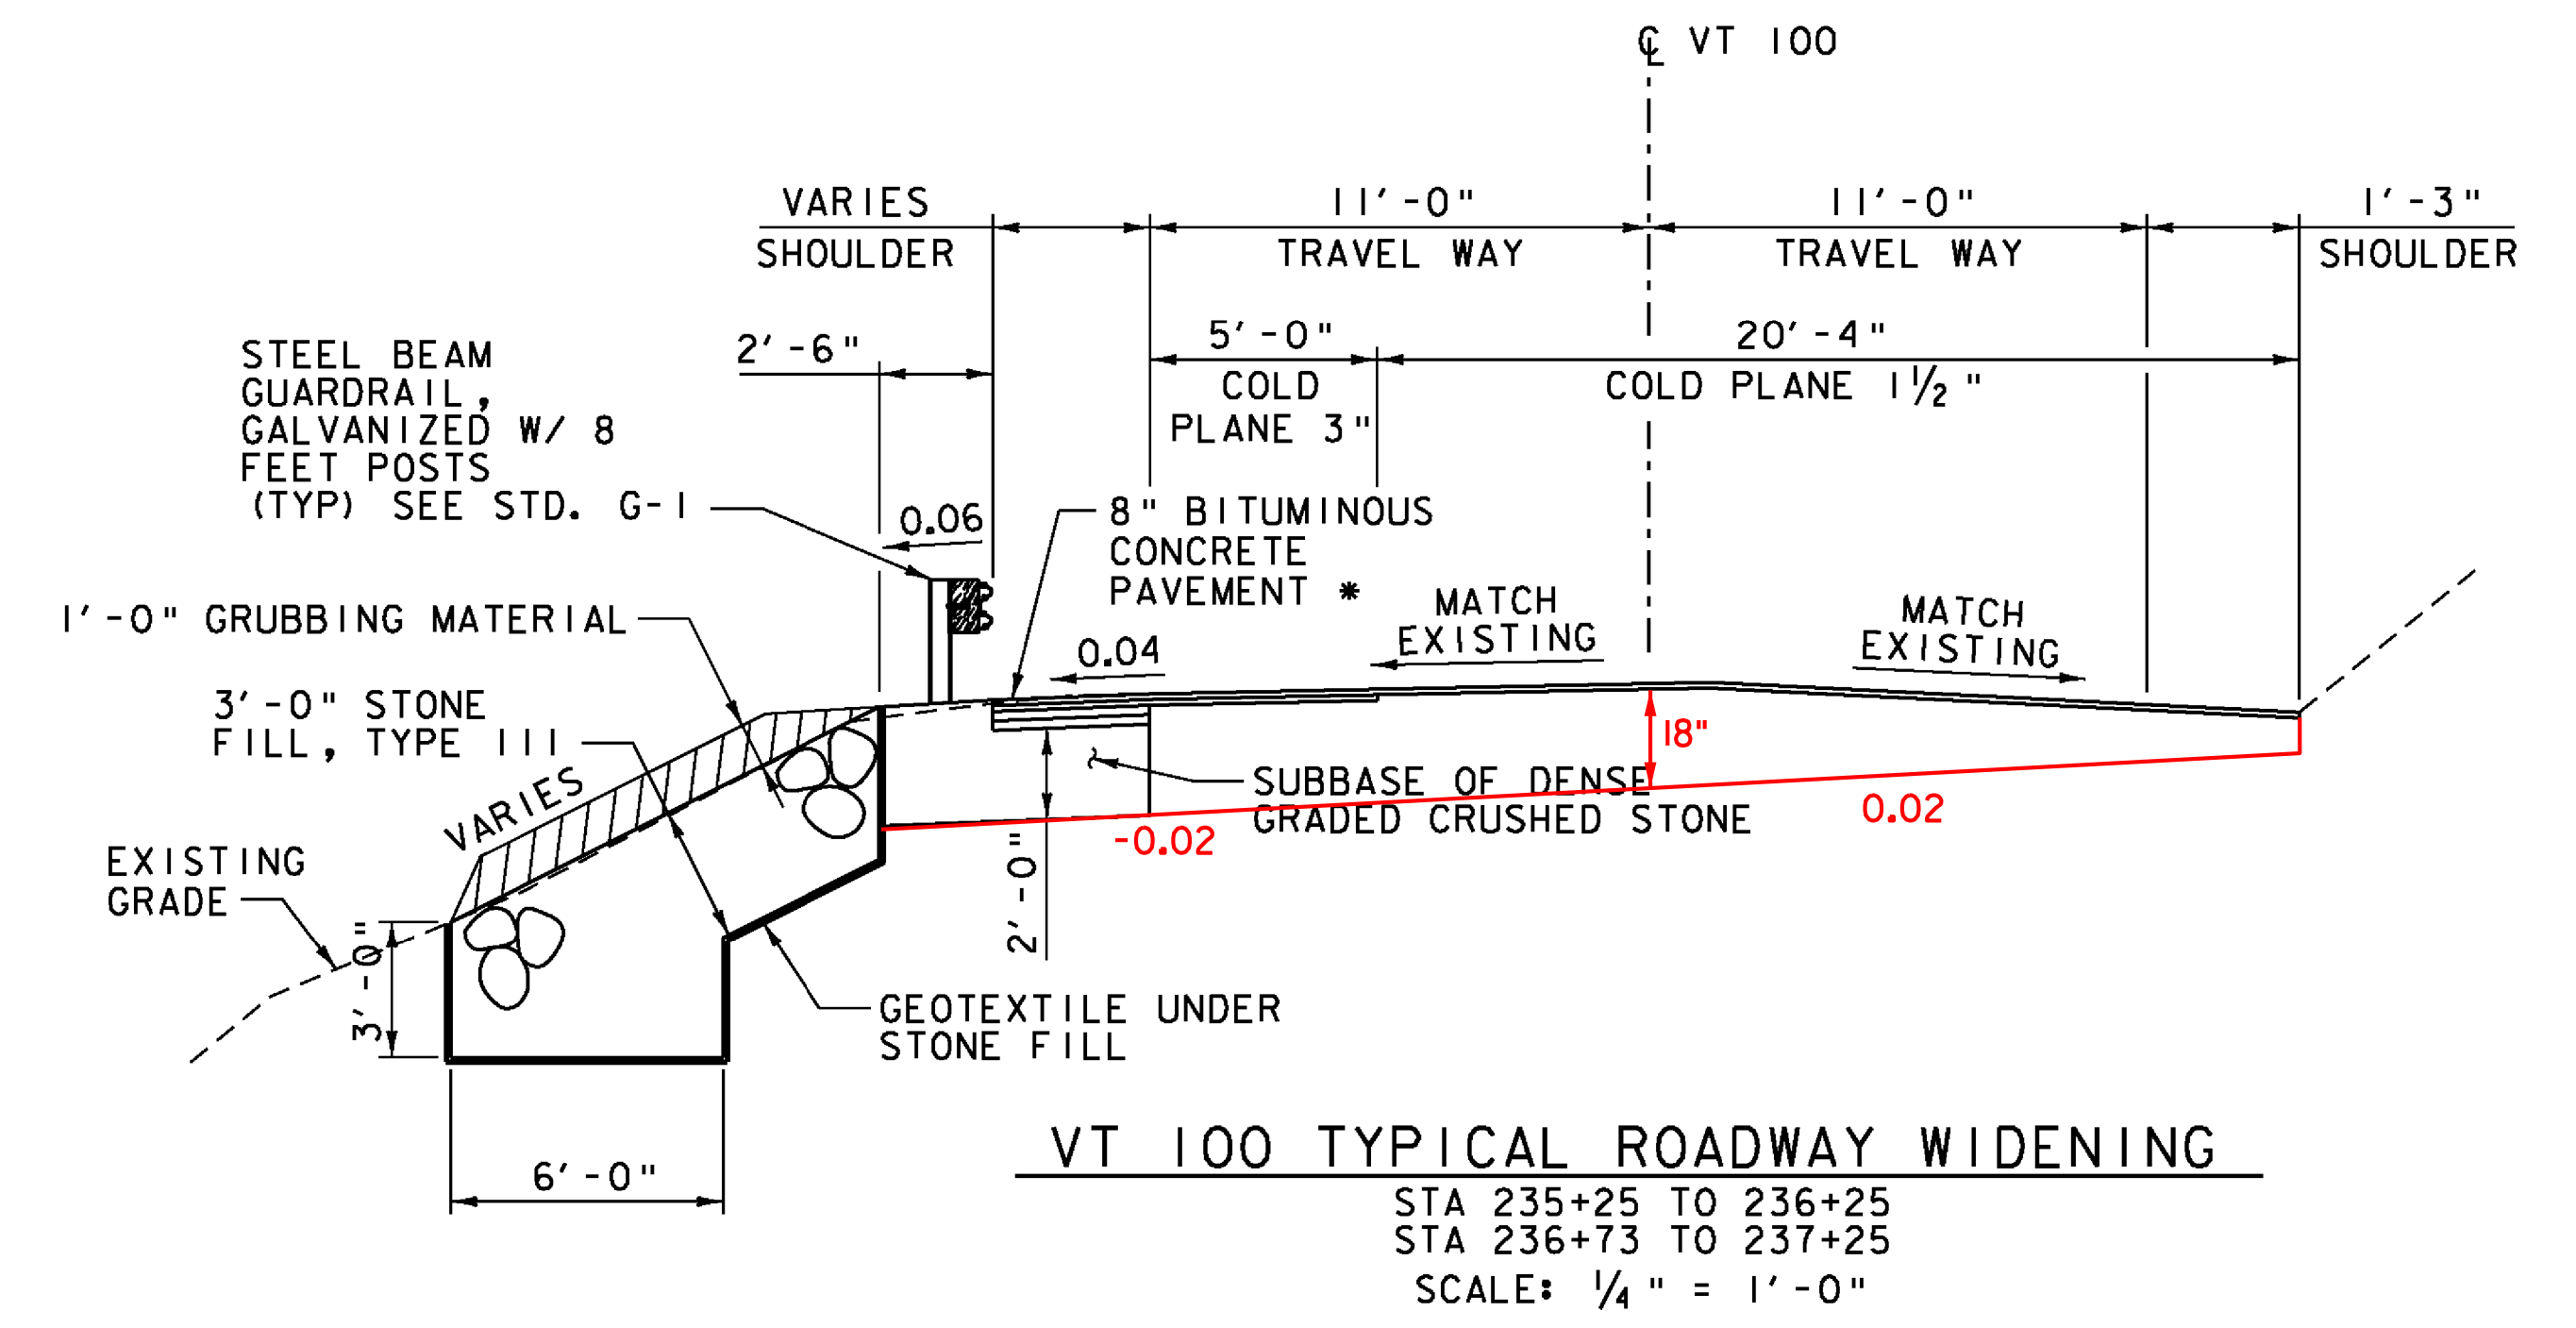

PROJECT NAME:	ROCHESTER	FILE NAME:	zllc332+tp.dgn	PLOT DATE:	8/19/2013
PROJECT NUMBER:	ER BRF 0162(18)	PROJECT LEADER:	S.E. BURBANK	DRAWN BY:	C.L. CILLEY
		DESIGNED BY:	C.L. CILLEY	CHECKED BY:	D.M. PECK
					BR 19 TYPICAL EARTHWORK SECTIONS (1 OF 2) SHEET 178 OF 238

