


STATE OF VERMONT AGENCY OF TRANSPORTATION MATERIALS & RESEARCH SECTION SUBSURFACE INFORMATION		BORING LOG		Boring No.: B-201						
VTSPG NAD83: N 497024.36 ft E 1558616.44 ft		ROCHESTER ER-BRF 0162(18) VT-73 BR-19		Page No.: 1 of 1						
Station: 236+35.0 Offset: 12.00		Type: WB Sampler: SS		Pin No.: 11C332						
Ground Elevation: 827.4 ft		I.D.: 4 in 1.5 in		Checked By: CCB						
Casing		Groundwater Observations		Date						
Hammer Wt: N.A. 140 lb.		Date		Depth (ft)						
Hammer Fall: N.A. 30 in.		04/11/13		9.8						
Hammer/Rod Type: Auto/AWJ				Notes						
Rig: CME 55 TRACK C = 1.46				After drilling.						
Depth (ft)	Strata (1)	CLASSIFICATION OF MATERIALS (Description)	Run (Dip deg.)	Core Rec. % (RQD %)	Drill Rate minutes/ft	Blows/ft (N Value)	Moisture Content %	Gravel %	Sand %	Fines %
0.0 - 0.78		Asphalt Pavement, 0.0 ft - 0.78 ft								
0.78 - 1.2		A-1-b, GrSa, Dk/bm, Moist, Rec. = 1.2 ft				5-8-12-15 (20)	9.8	36.9	44.7	18.4
1.2 - 5.0		Field Note: NXDC. Appears to be Gravelly Sand								
5.0 - 8.0		A-1-b, SiSaGr, brn, Moist, Rec. = 1.0 ft, Lab Note: Broken Rock was within sample.				16-16-R@5.0" (R)	9.1	43.3	36.2	20.5
8.0 - 13.0		8.0 ft - 13.0 ft, Pale green, Quartz-sericite Schist, with Quartzite. Moderate weathering along joint surfaces. Moderately hard, Fair rock, NXMDC, RMR = 54	1 (50)	100 (48)	6					
13.0 - 15.0		Hole stopped @ 13.0 ft								
15.0 - 22.5		Remarks: Hole collapsed at 6.7 ft. Northing, Easting, and Elevation are based off stations and offsets attained in the field and a topographic survey.								

BORING LOG 2 ROCHESTER ER-BRF 0162(18) GP1 VERMONT AOT.GDT 4/24/13

Notes:
 1. Stratification lines represent approximate boundary between material types. Transition may be gradual.
 2. N Values have not been corrected for hammer energy. C is the hammer energy correction factor.
 3. Water level readings have been made at times and under conditions stated. Fluctuations may occur due to other factors than those present at the time measurements were made.

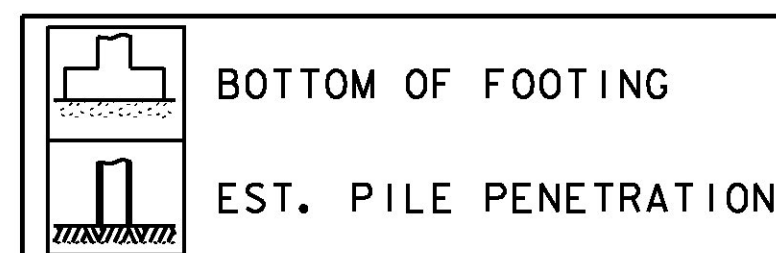

STATE OF VERMONT AGENCY OF TRANSPORTATION MATERIALS & RESEARCH SECTION SUBSURFACE INFORMATION		BORING LOG		Boring No.: B-202						
VTSPG NAD83: N 497007.06 ft E 1558606.86 ft		ROCHESTER ER-BRF 0162(18) VT-73 BR-19		Page No.: 1 of 1						
Station: 236+15.0 Offset: 11.40		Type: WB Sampler: SS		Pin No.: 11C332						
Ground Elevation: 827.1 ft		I.D.: 4 in 1.5 in		Checked By: CCB						
Casing		Groundwater Observations		Date						
Hammer Wt: N.A. 140 lb.		Date		Depth (ft)						
Hammer Fall: N.A. 30 in.		04/11/13		3.5						
Hammer/Rod Type: Auto/AWJ				Notes						
Rig: CME 55 TRACK C = 1.46				While drilling.						
Depth (ft)	Strata (1)	CLASSIFICATION OF MATERIALS (Description)	Run (Dip deg.)	Core Rec. % (RQD %)	Drill Rate minutes/ft	Blows/ft (N Value)	Moisture Content %	Gravel %	Sand %	Fines %
0.0 - 0.7		Asphalt Pavement, 0.0 ft - 0.7 ft								
0.7 - 1.0		A-2-4, SiGrSa, brn, Moist, Rec. = 1.0 ft				9-12-13-12 (25)	10.3	30.8	48.5	20.7
1.0 - 4.0		Field Note: NXDC, Possible Top of Bedrock at 4.0 ft.								
4.0 - 10.0		5.0 ft - 10.0 ft, Pale green, Quartz-sericite Schist, with Quartzite. Moderately hard, Unweathered, Good rock, NXMDC, RMR = 63	1 (35)	100 (88)	7					
10.0 - 12.5		Hole stopped @ 10.0 ft								
12.5 - 15.0		Remarks: Hole collapsed at 2.9 ft. Northing, Easting, and Elevation are based off stations and offsets attained in the field and a topographic survey.								

BORING LOG 2 ROCHESTER ER-BRF 0162(18) GP1 VERMONT AOT.GDT 4/24/13

Notes:
 1. Stratification lines represent approximate boundary between material types. Transition may be gradual.
 2. N Values have not been corrected for hammer energy. C is the hammer energy correction factor.
 3. Water level readings have been made at times and under conditions stated. Fluctuations may occur due to other factors than those present at the time measurements were made.

PROJECT NAME: ROCHESTER
 PROJECT NUMBER: ER BRF 0162(18)
 FILE NAME: zilc332borlogs.dgn PLOT DATE: 8/19/2013
 PROJECT LEADER: S.E. BURBANK DRAWN BY: E.A. FIALA
 DESIGNED BY: VTRANS CHECKED BY: S.E. BURBANK
 BR 19 BORING LOGS (3 OF 4) SHEET 201 OF 238

