


DECK REINFORCING PLAN  
SCALE 1/4" = 1'-0"

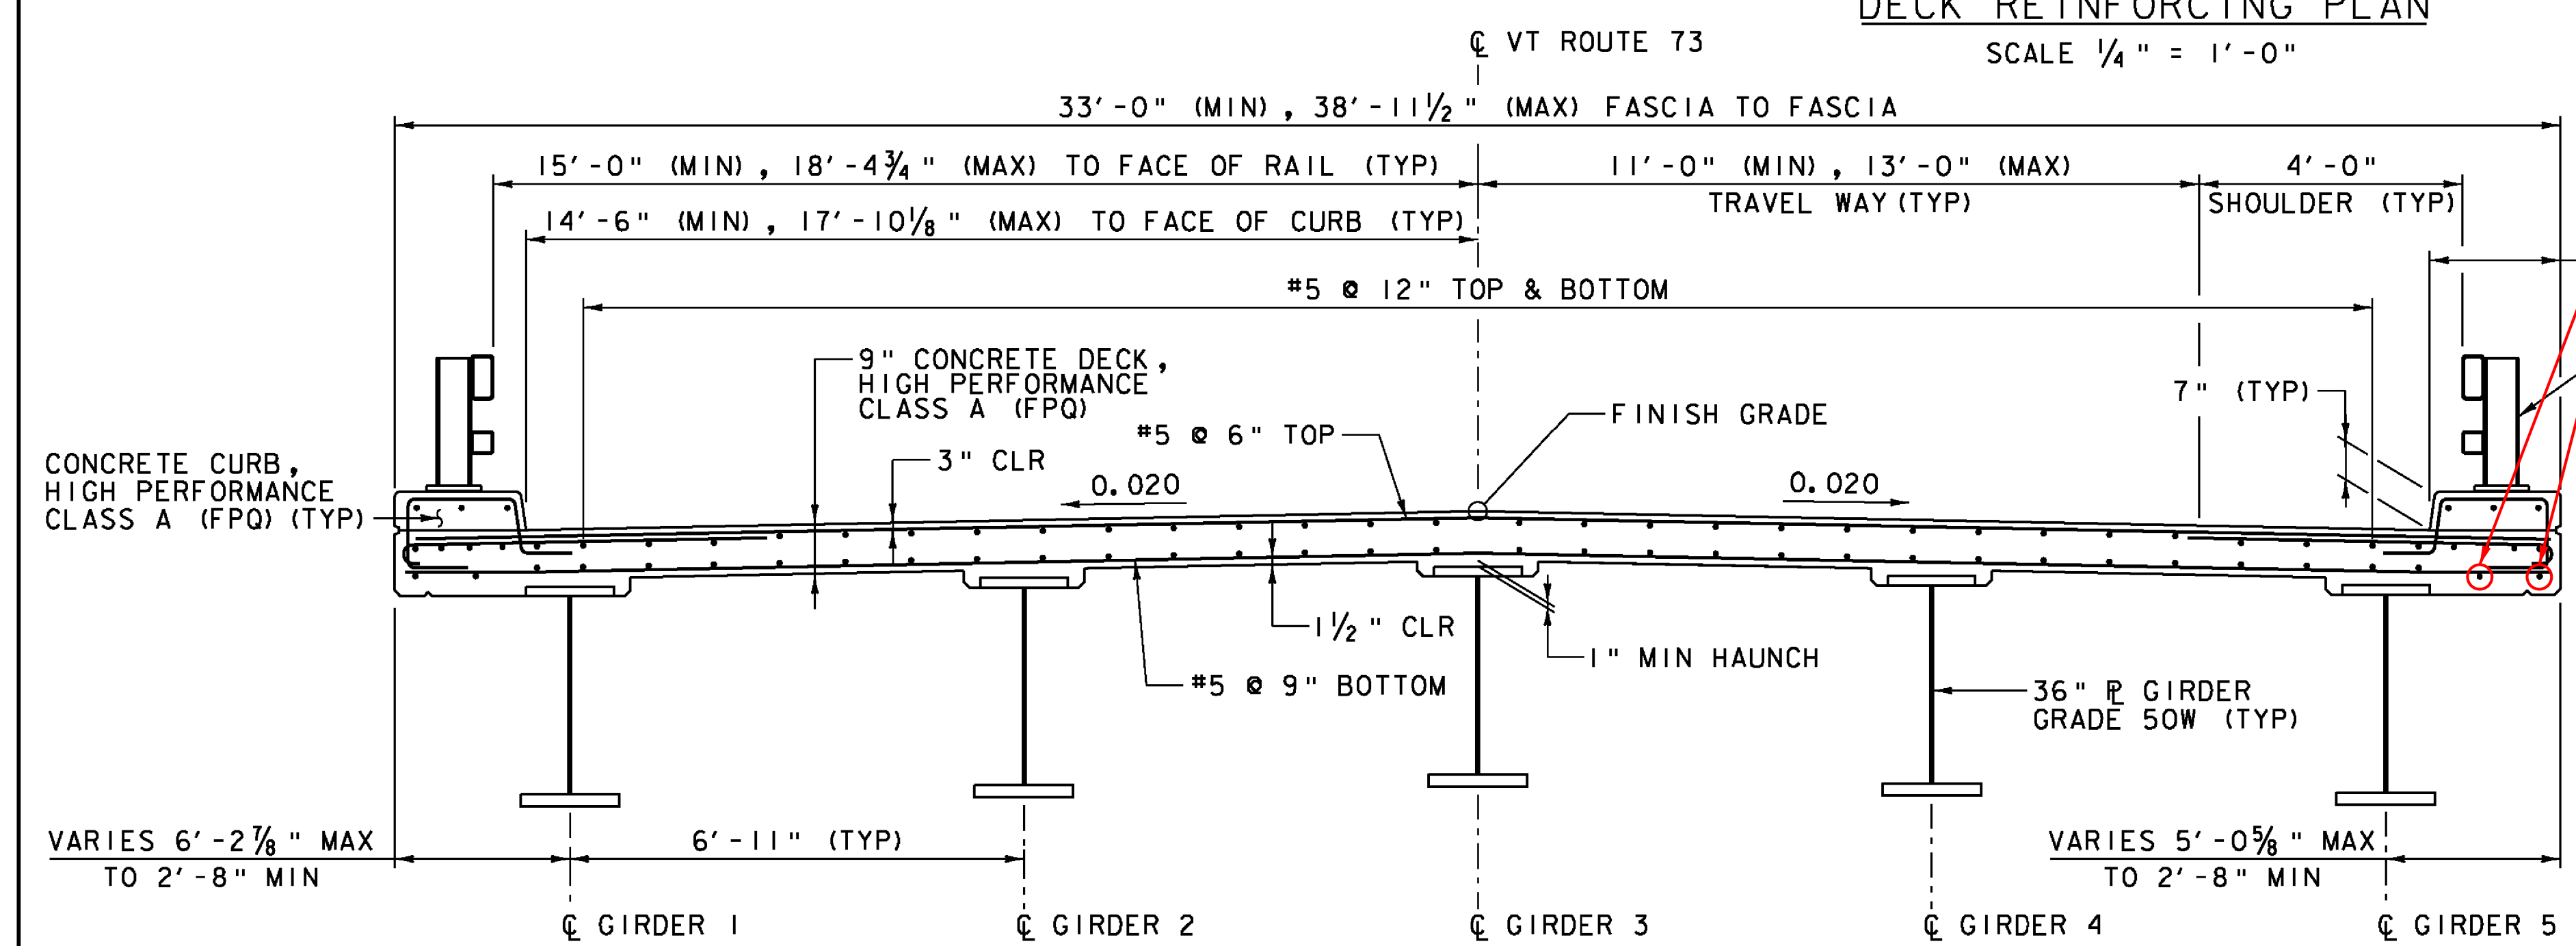


TYPICAL DECK REINFORCEMENT  
SCALE 1/2" = 1'-0"

MOVE THESE TWO (2) #5 LONGITUDINAL BARS DOWN SO THEY ARE ON TOP OF THE NEW TRANSVERSE #4 BARS

BRIDGE RAILING, GALVANIZED 2 RAIL BOX BEAM (TYP) SEE STD. SHEET S360A FOR DETAILS

NOTE:  
NF = NEAR FACE  
FF = FAR FACE  
EF = EACH FACE  
▲ = CUT TO FIT IN FIELD  
3" CLEAR, UNLESS OTHERWISE SPECIFIED ON THE PLANS.  
2'-2" BAR LAP UNLESS OTHERWISE SPECIFIED ON THE PLANS.

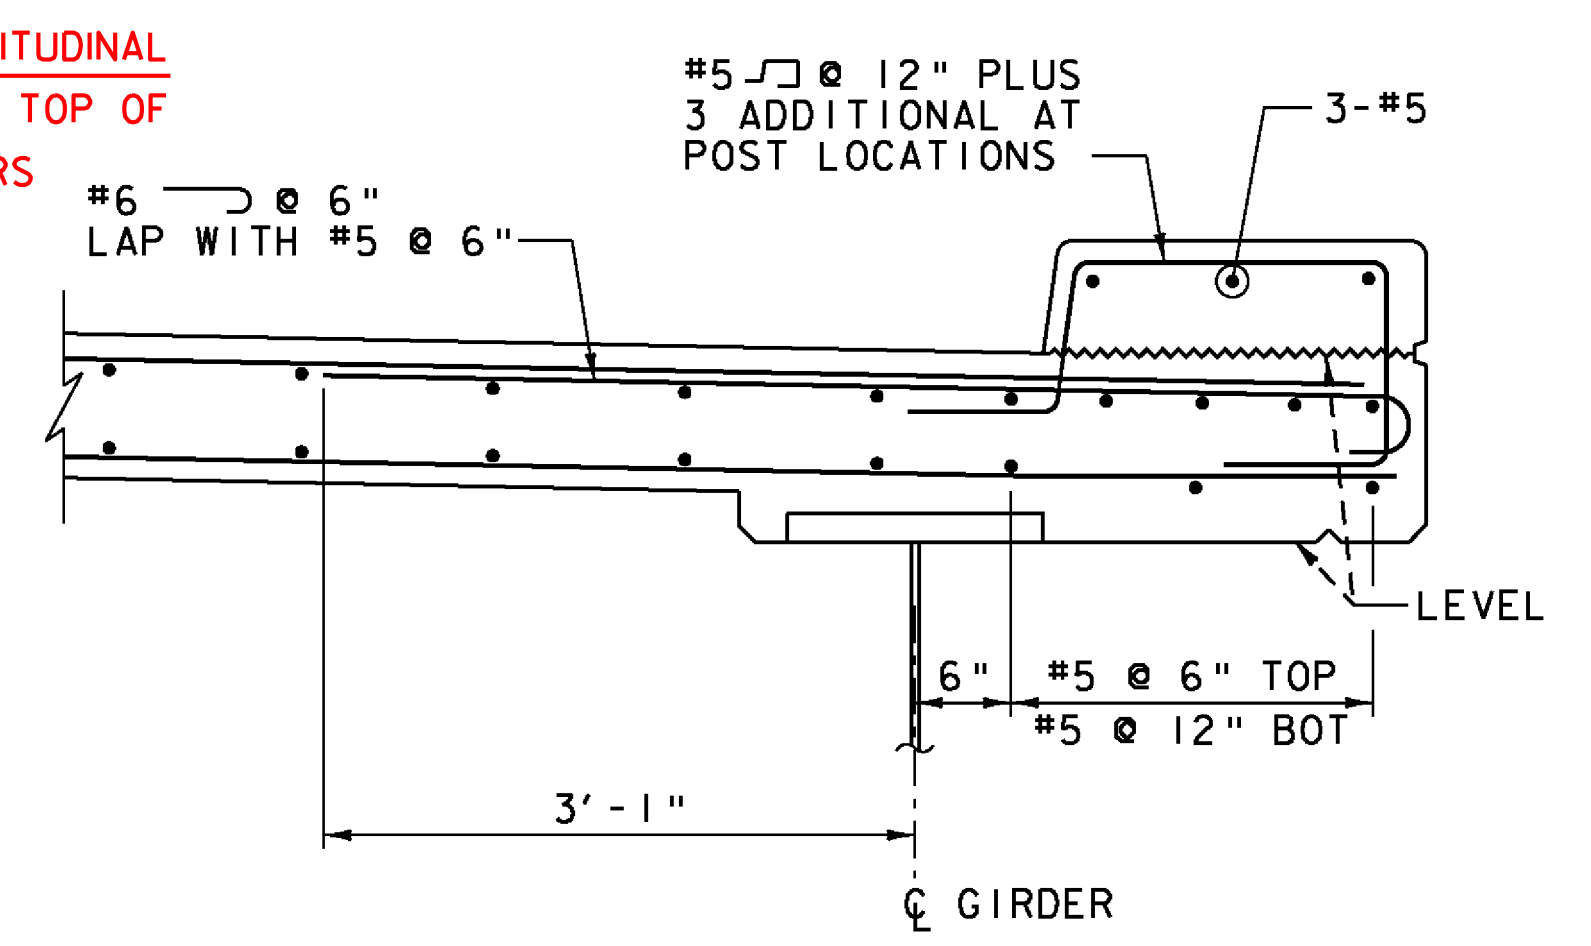

TYPICAL OVERHANG REINFORCEMENT  
SCALE 1" = 1'-0"

PROJECT NAME:	ROCHESTER	PLOT DATE:	8/19/2013
PROJECT NUMBER:	ER BRF 0162(18)	DRAWN BY:	B.J. MASSE
FILE NAME:	zllc332supl.dgn	DESIGNED BY:	E.A. FIALA
PROJECT LEADER:	S.E. BURBANK	CHECKED BY:	L. CHERVINCKY
BR 19 DECK REINFORCING DETAILS		SHEET 204 OF 238	

