




APPROACH SLAB NO 1 PLAN
SCALE 1/4" = 1'-0"

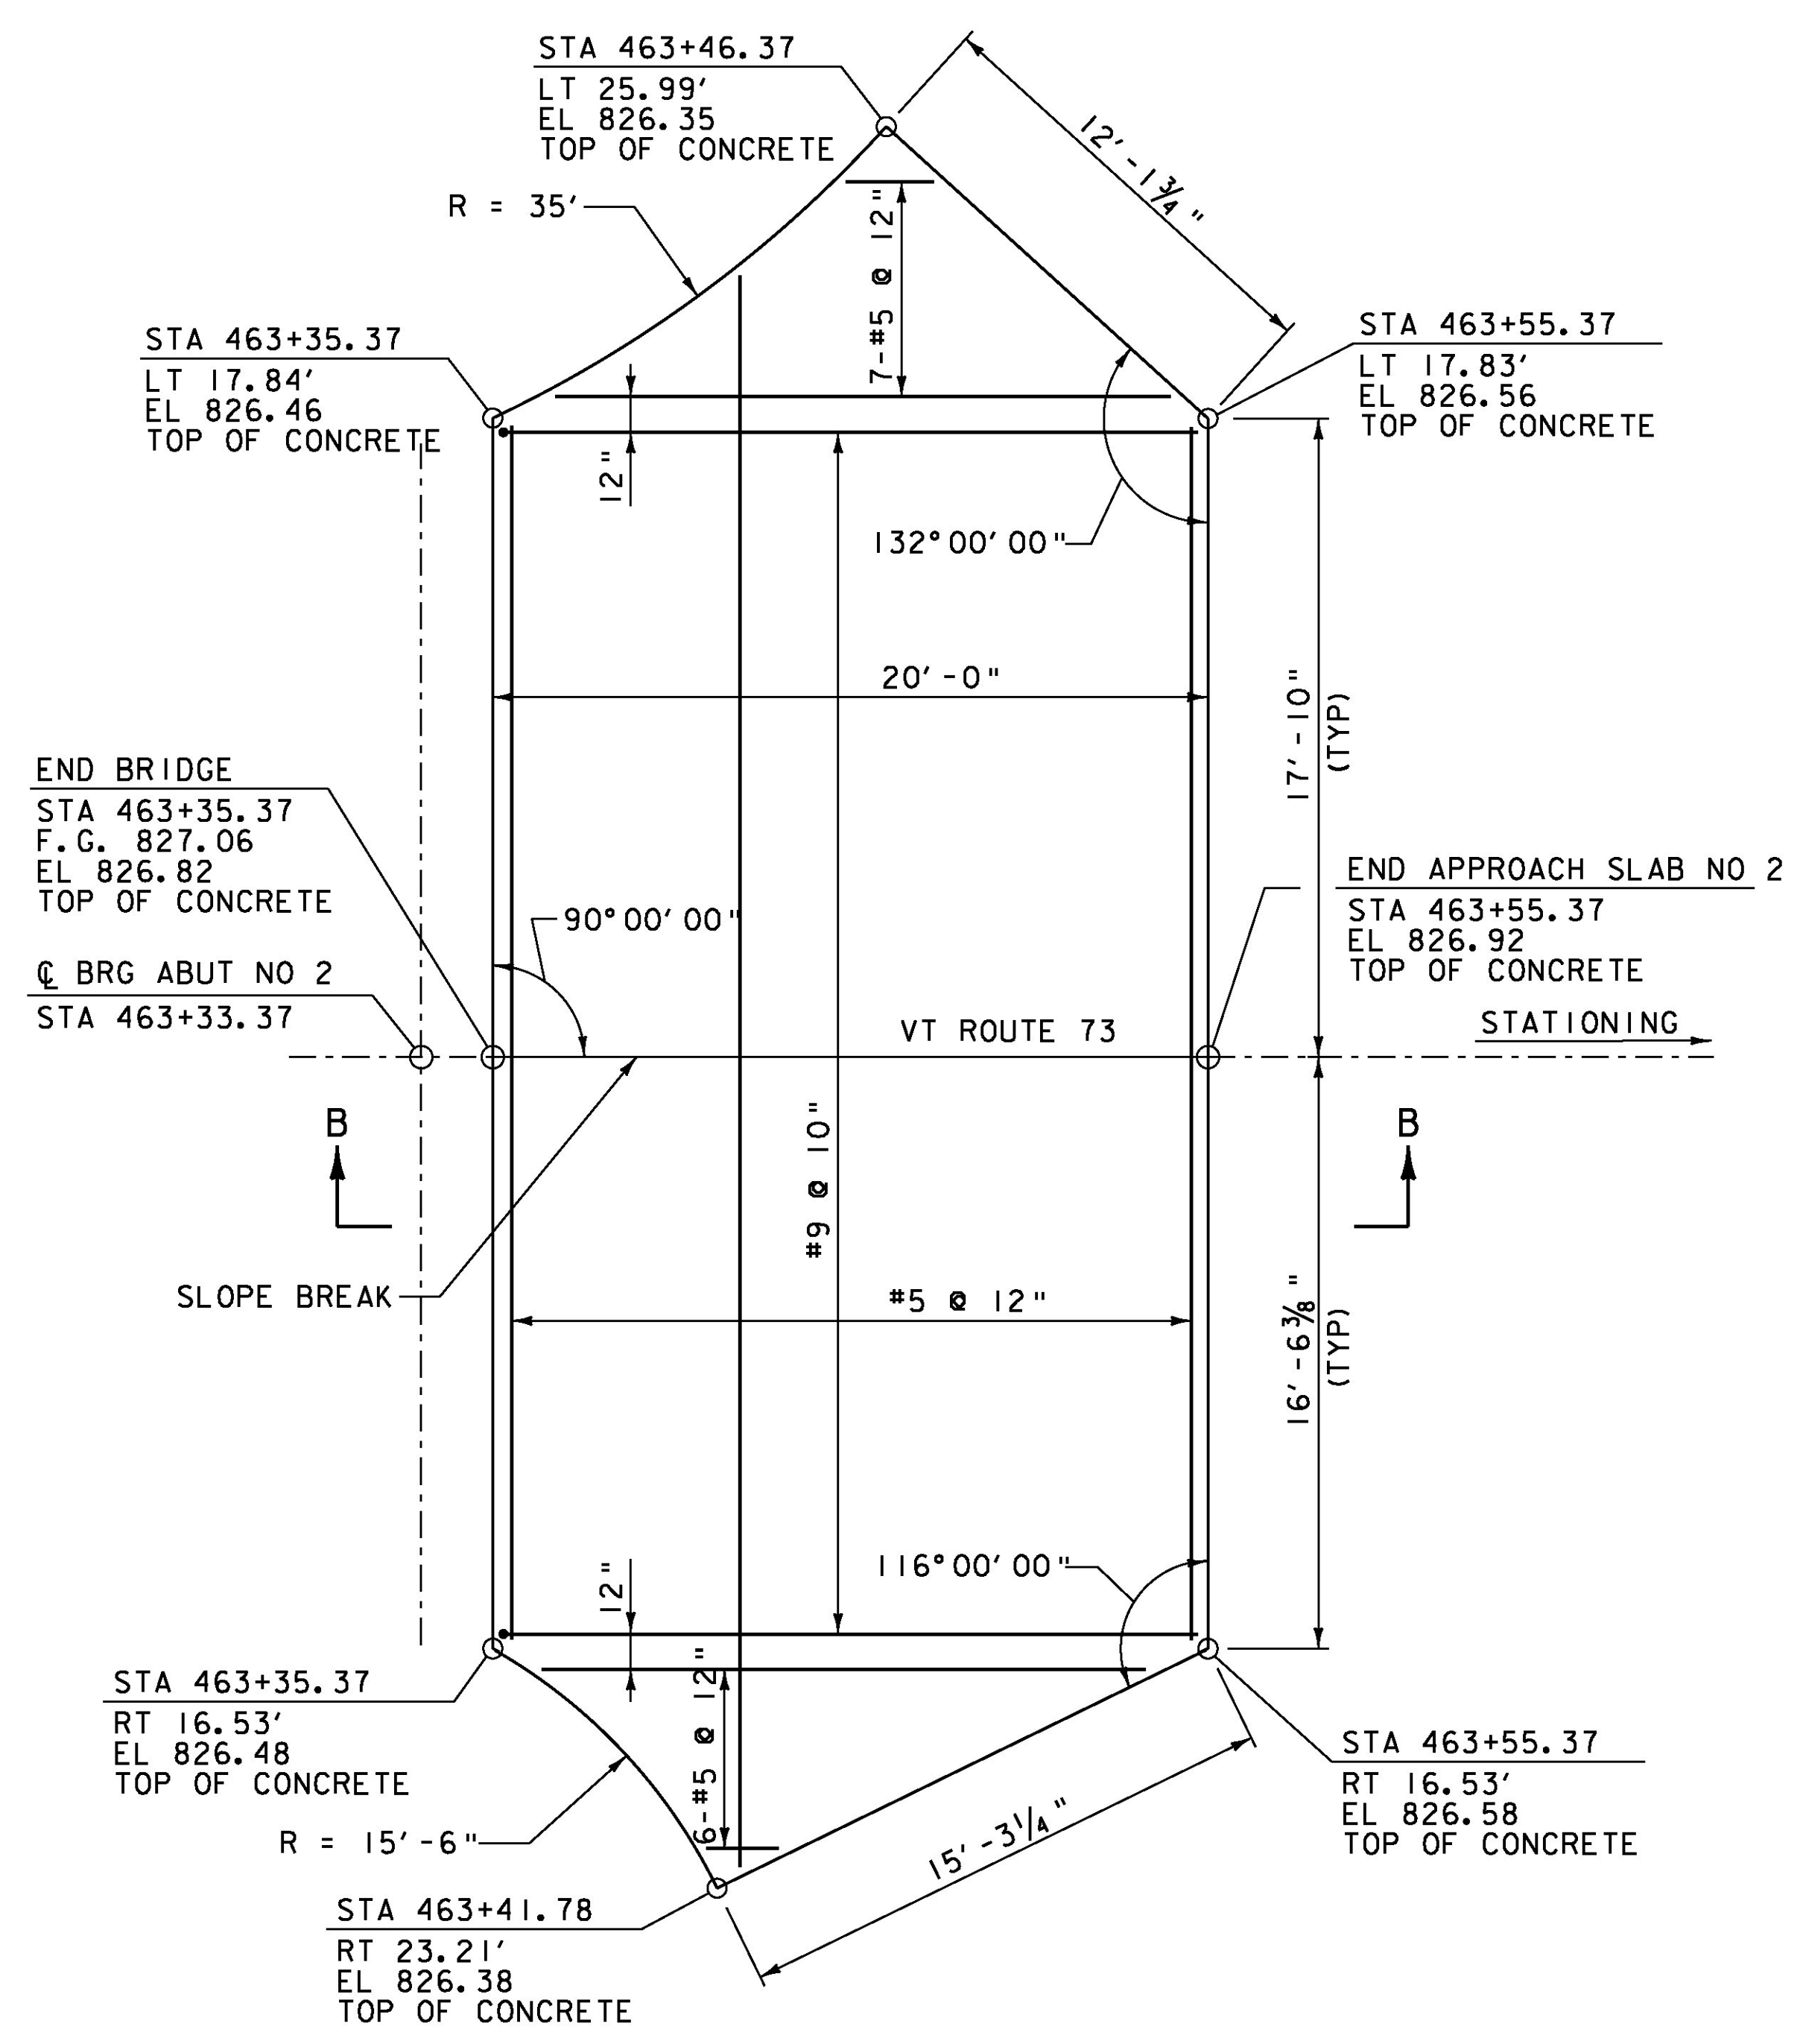

APPROACH SLAB NO 2 PLAN
SCALE 1/4" = 1'-0"

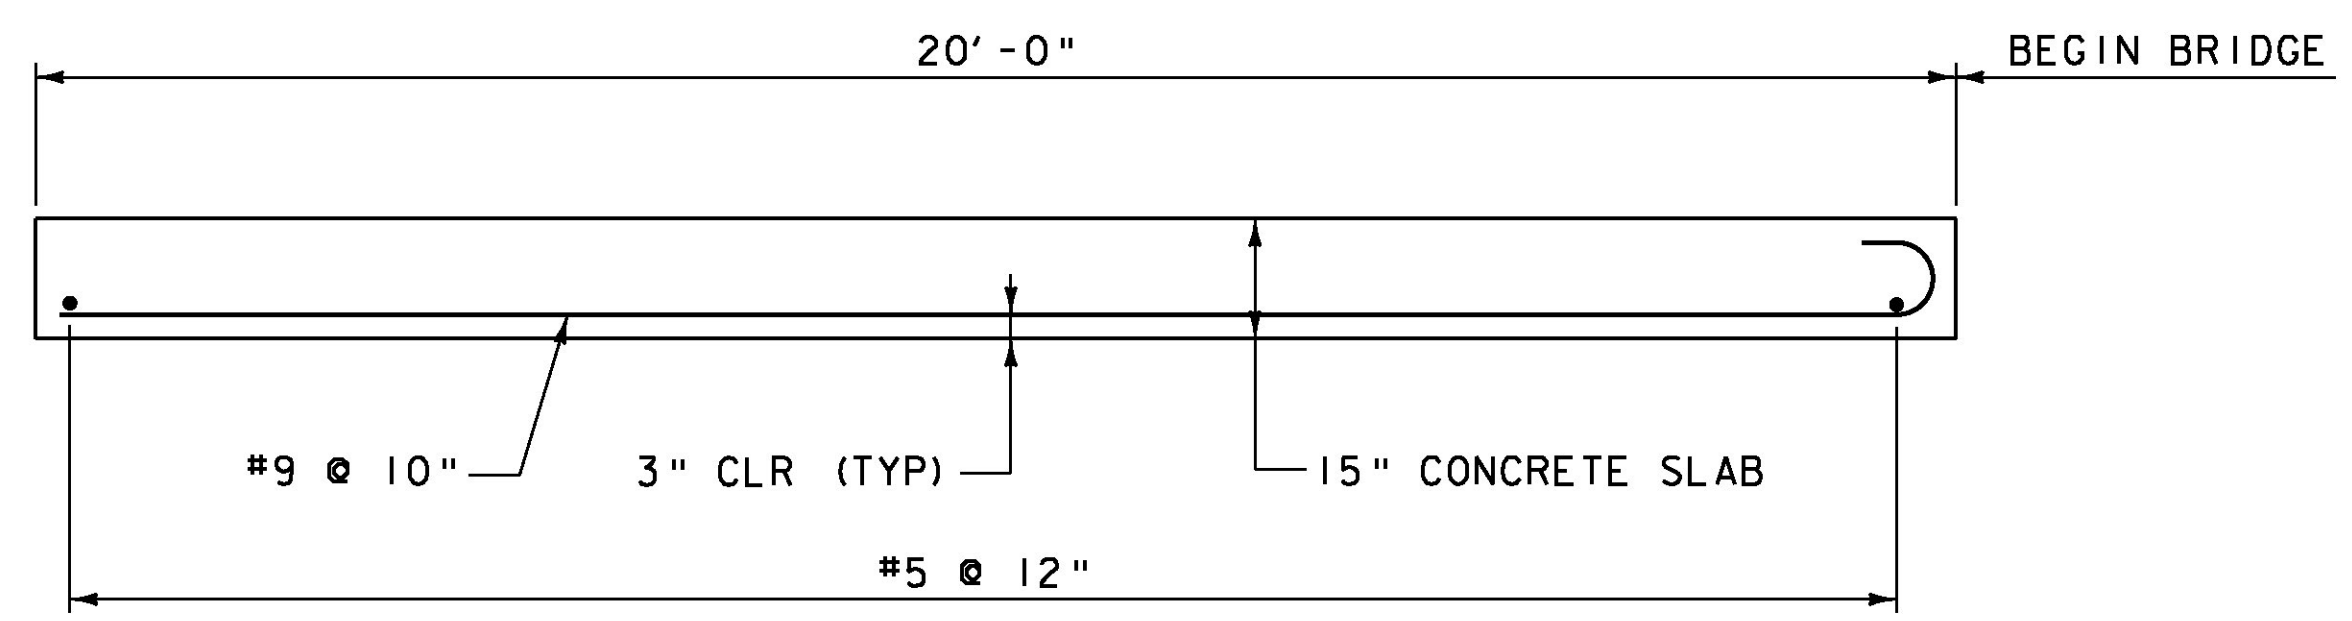

SECTION A-A
SCALE 1/2" = 1'-0"

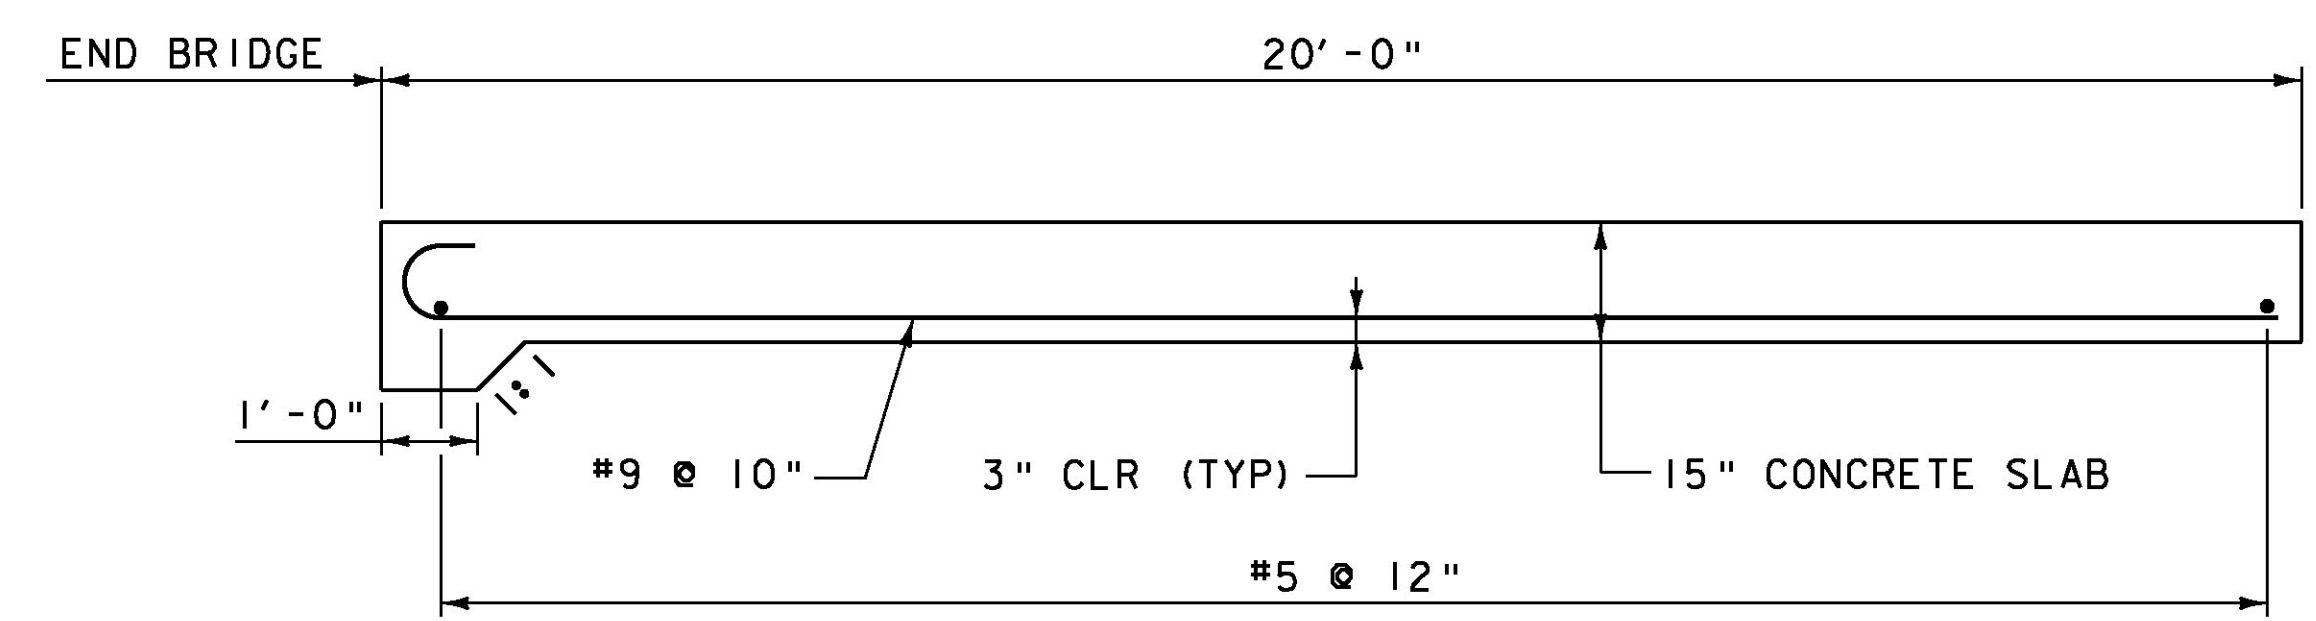

SECTION B-B
SCALE 1/2" = 1'-0"

PROJECT NAME:	ROCHESTER
PROJECT NUMBER:	ER BRF 0162(18)
FILE NAME:	zllc332slab.dgn
PROJECT LEADER:	S.E. BURBANK
DESIGNED BY:	L.S. CHERVINCKY
BR 19 APPROACH SLAB DETAILS	
PLOT DATE:	8/19/2013
DRAWN BY:	B.J. MASSE
CHECKED BY:	G.S. GOODRICH
SHEET	208 OF 238

