



ABUTMENT NO 2 PLAN
SCALE 3/8" = 1'-0"

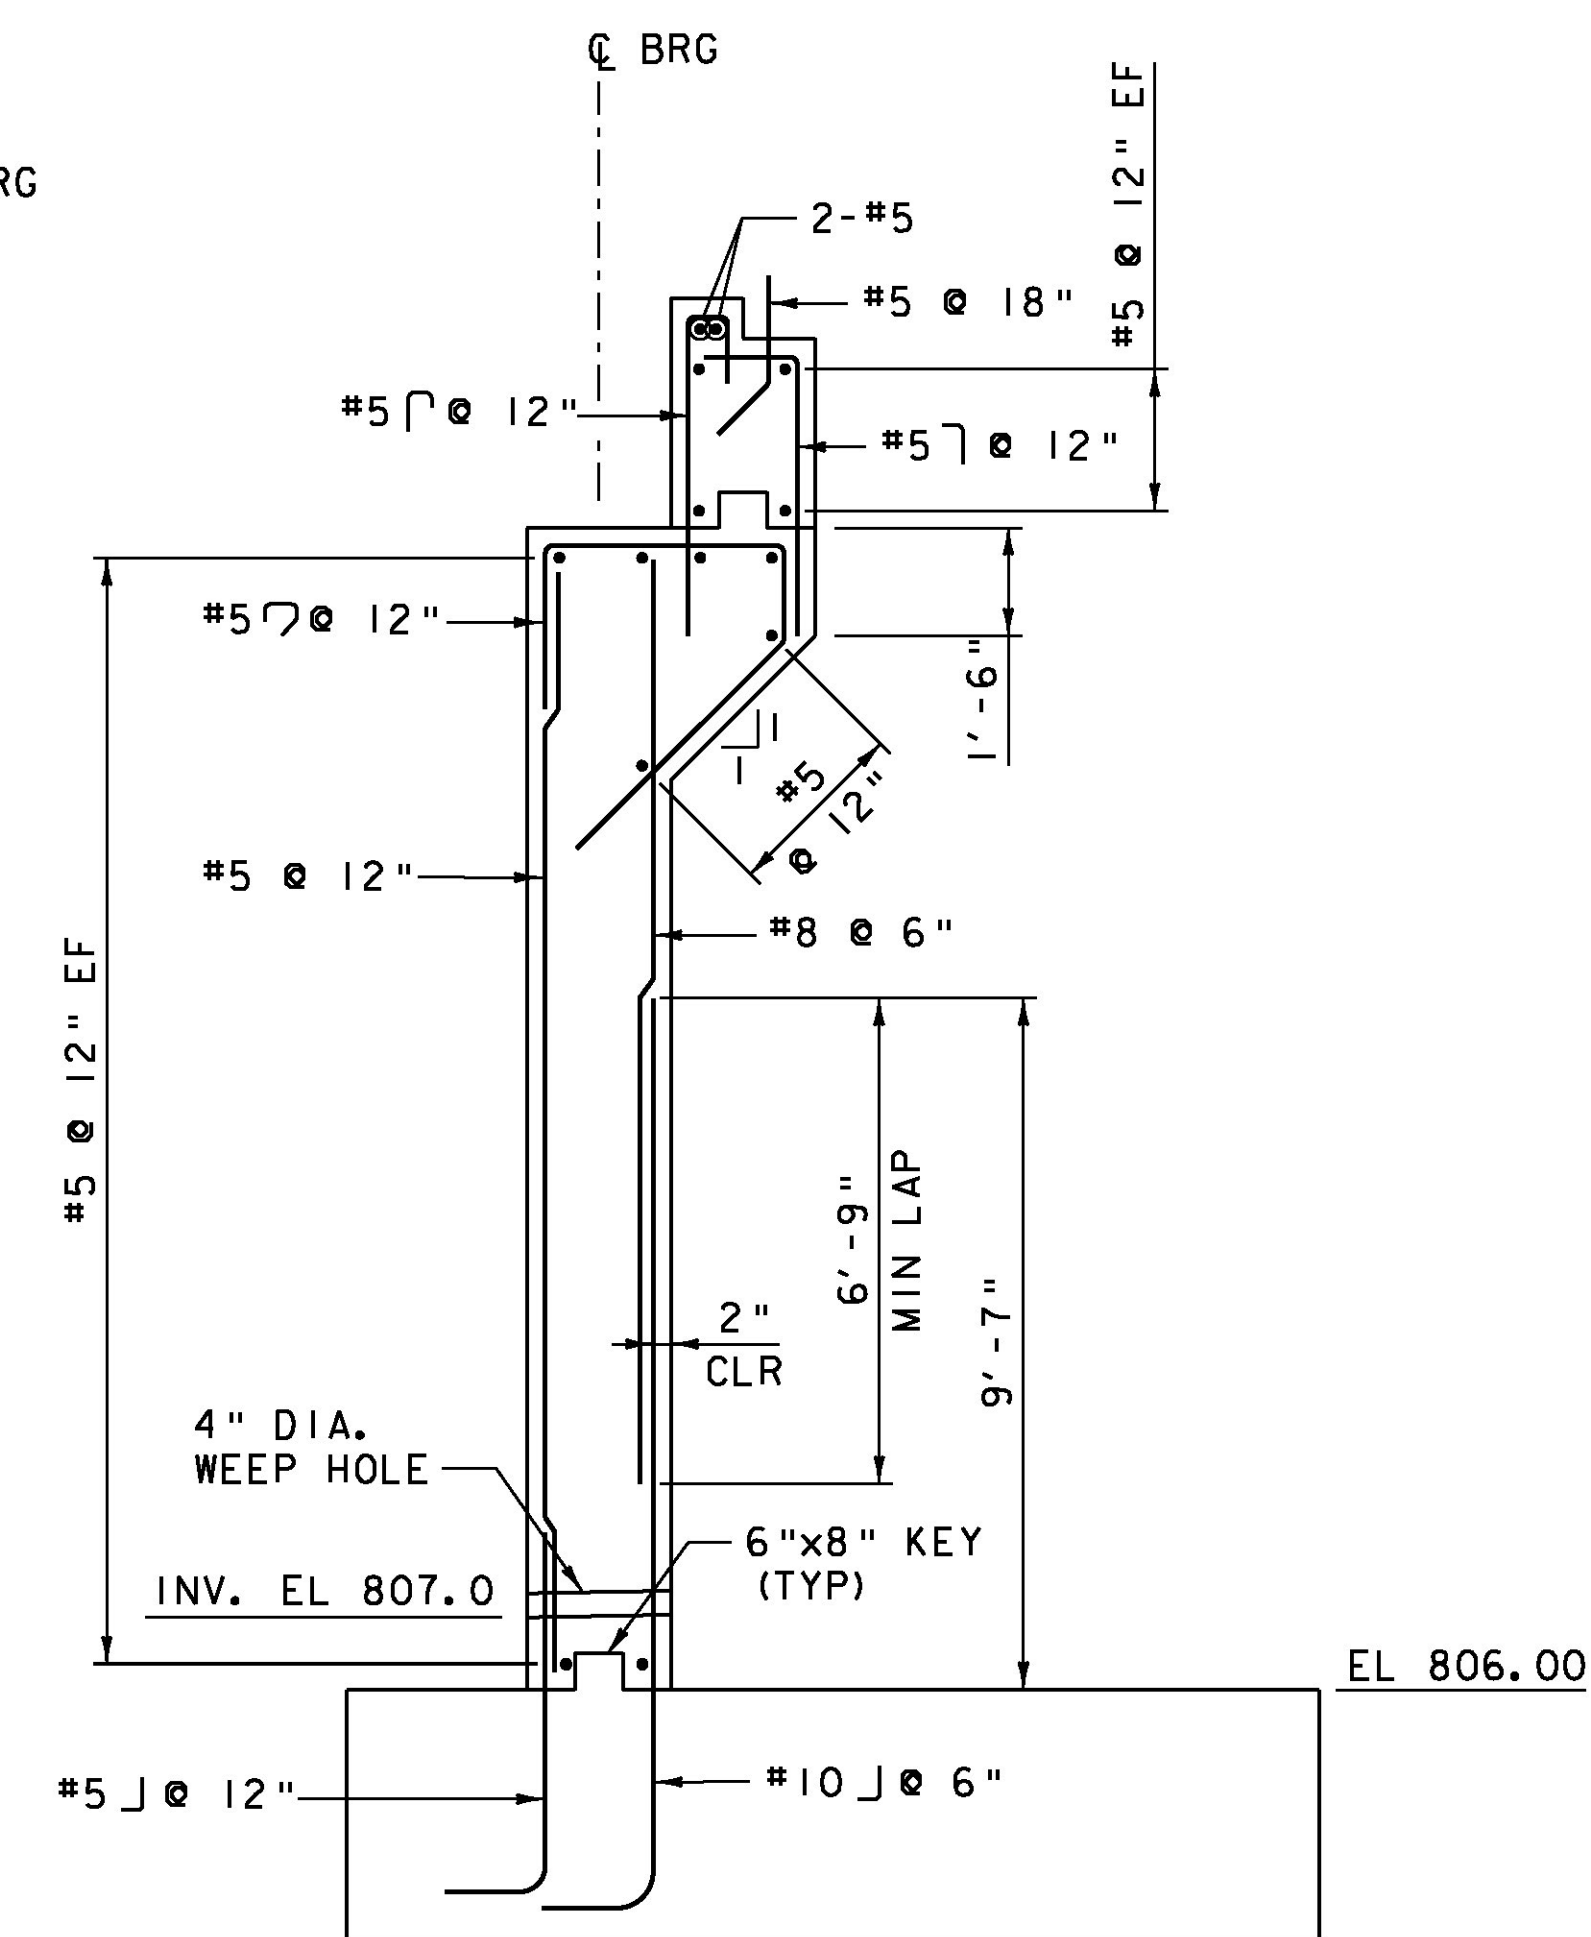

ABUTMENT NO 2 TYPICAL
SCALE 3/8" = 1'-0"

NOTE:
 NF = NEAR FACE
 FF = FAR FACE
 EF = EACH FACE
 ▲ = CUT TO FIT IN FIELD
 3" CLEAR, UNLESS OTHERWISE SPECIFIED ON THE PLANS.
 2'-2" BAR LAP UNLESS OTHERWISE SPECIFIED ON THE PLANS.

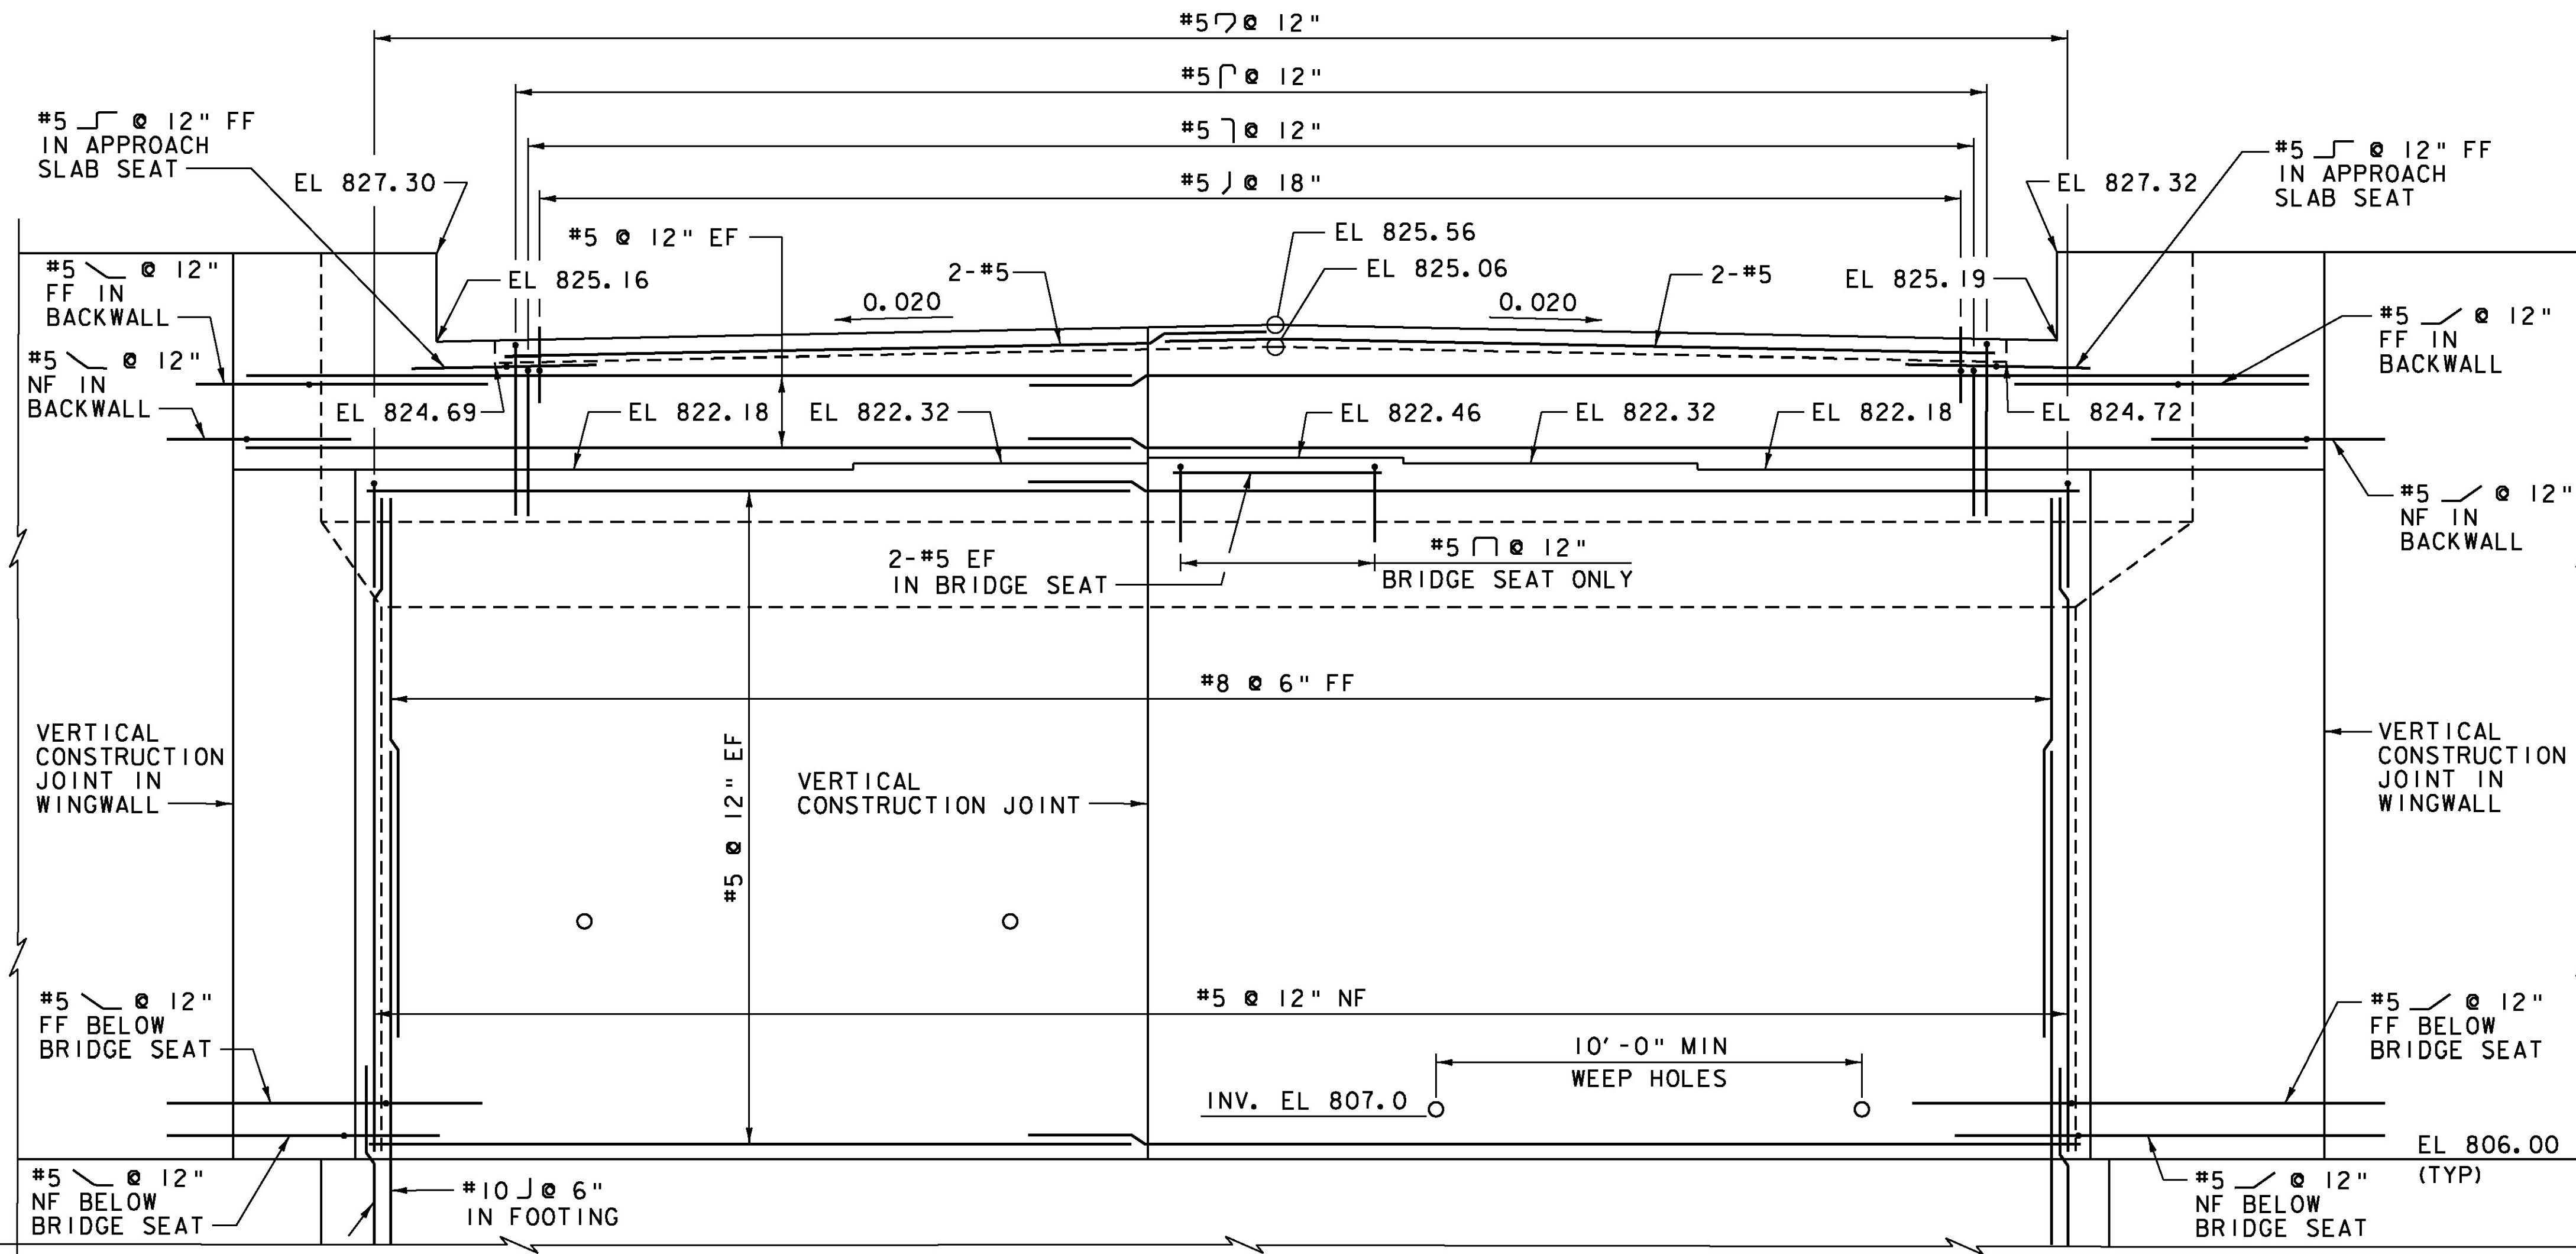

ABUTMENT NO 2 ELEVATION
SCALE 3/8" = 1'-0"



PROJECT NAME:	ROCHESTER	PLOT DATE:	8/19/2013
PROJECT NUMBER:	ER BRF 0162(18)	DRAWN BY:	B.J. MASSE
FILE NAME:	zllc332sub.dgn	DESIGNED BY:	J.T. KLEIN
PROJECT LEADER:	S.E. BURBANK	CHECKED BY:	G.S. GOODRICH
BR 19 ABUTMENT NO 2 PLAN & ELEVATION		SHEET 213 OF 238	