



459+50

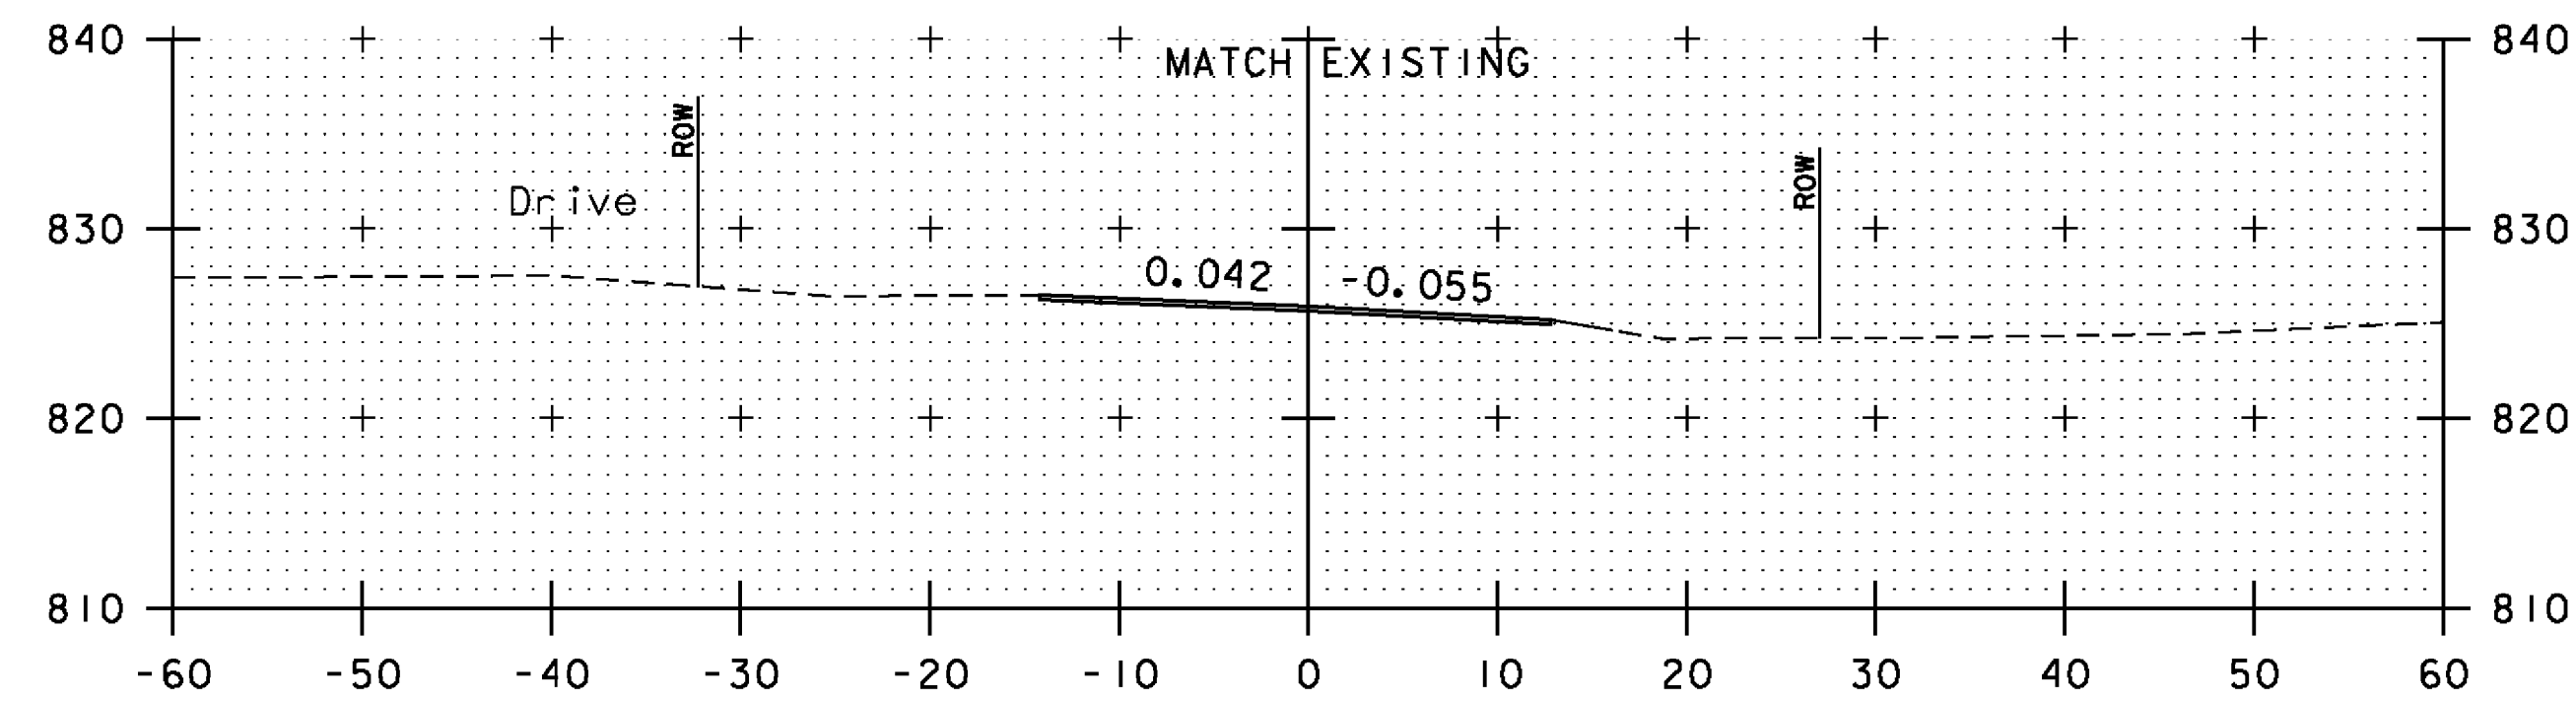


459+00

BEGIN APPROACH
STA 459+00.00

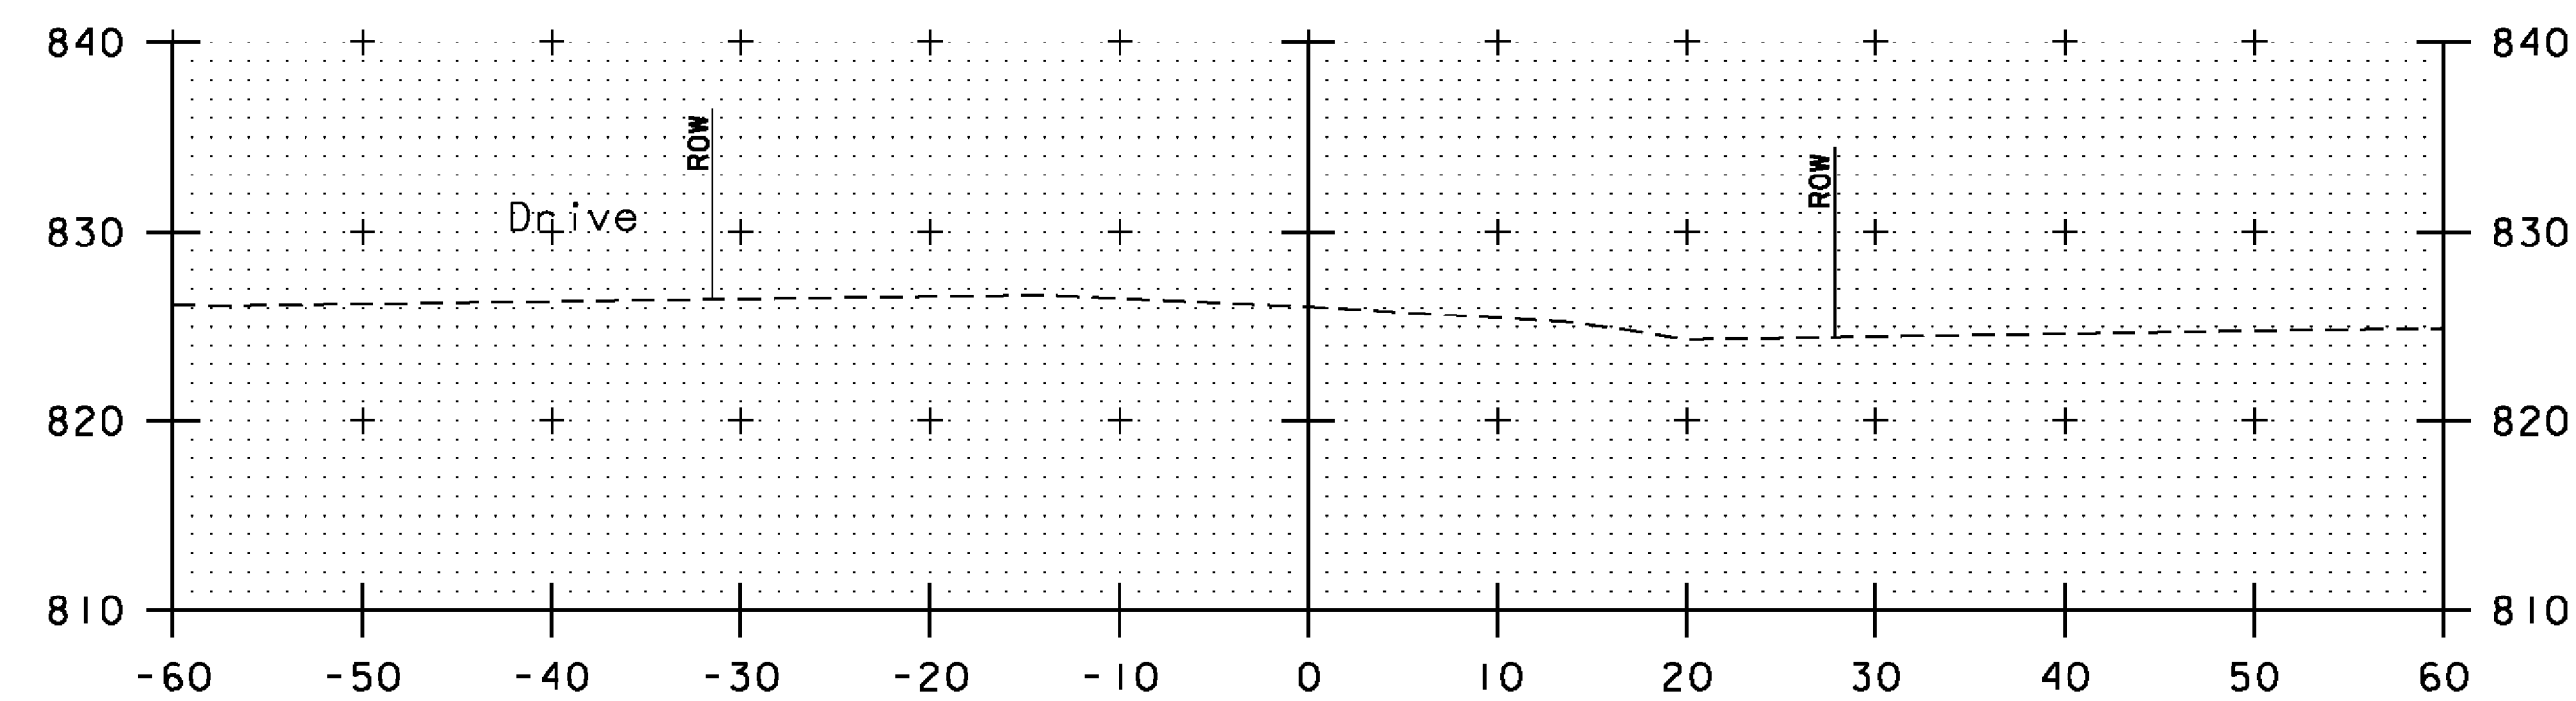


458+50

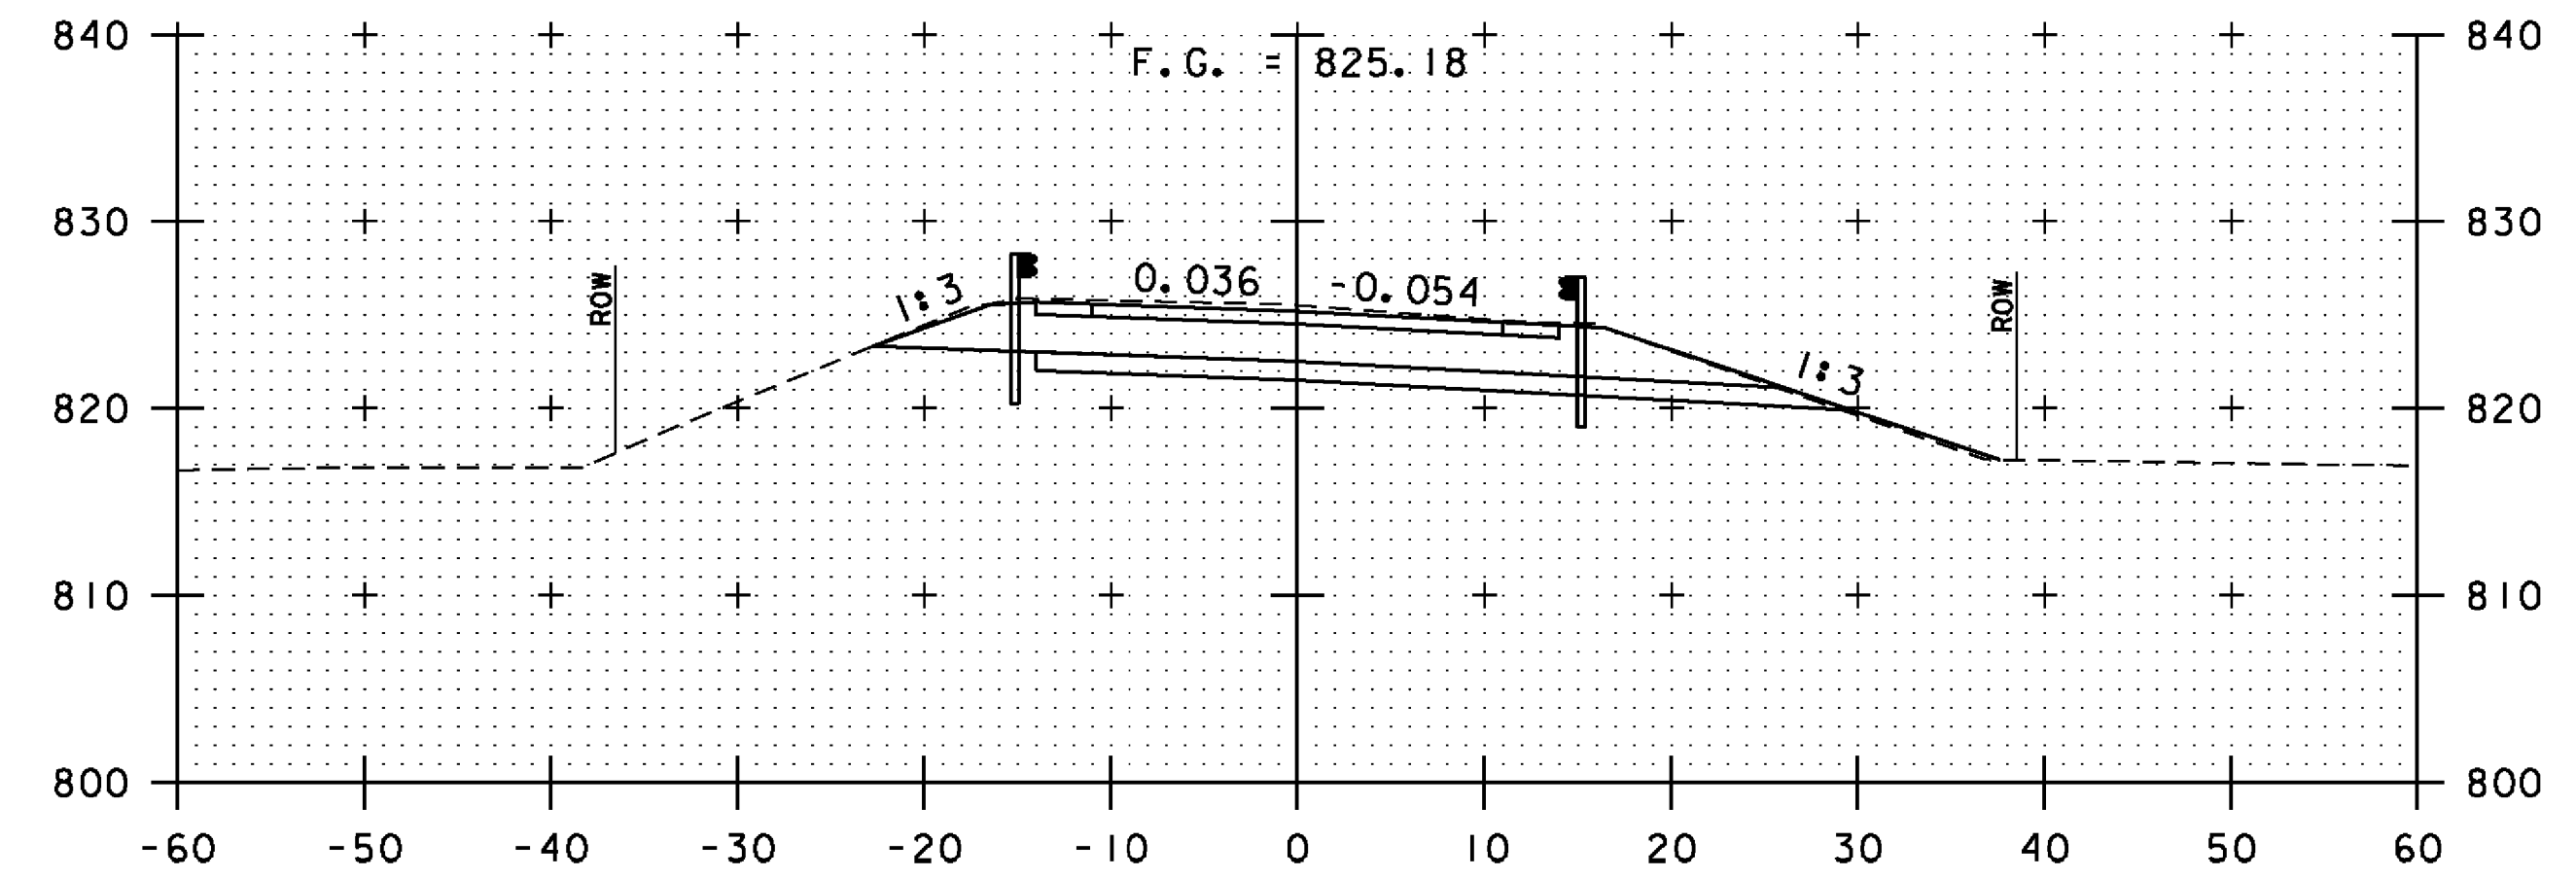


461+00

• ALL SAND BORROW REPLACED
WITH DENSE GRADE CRUSHED STONE

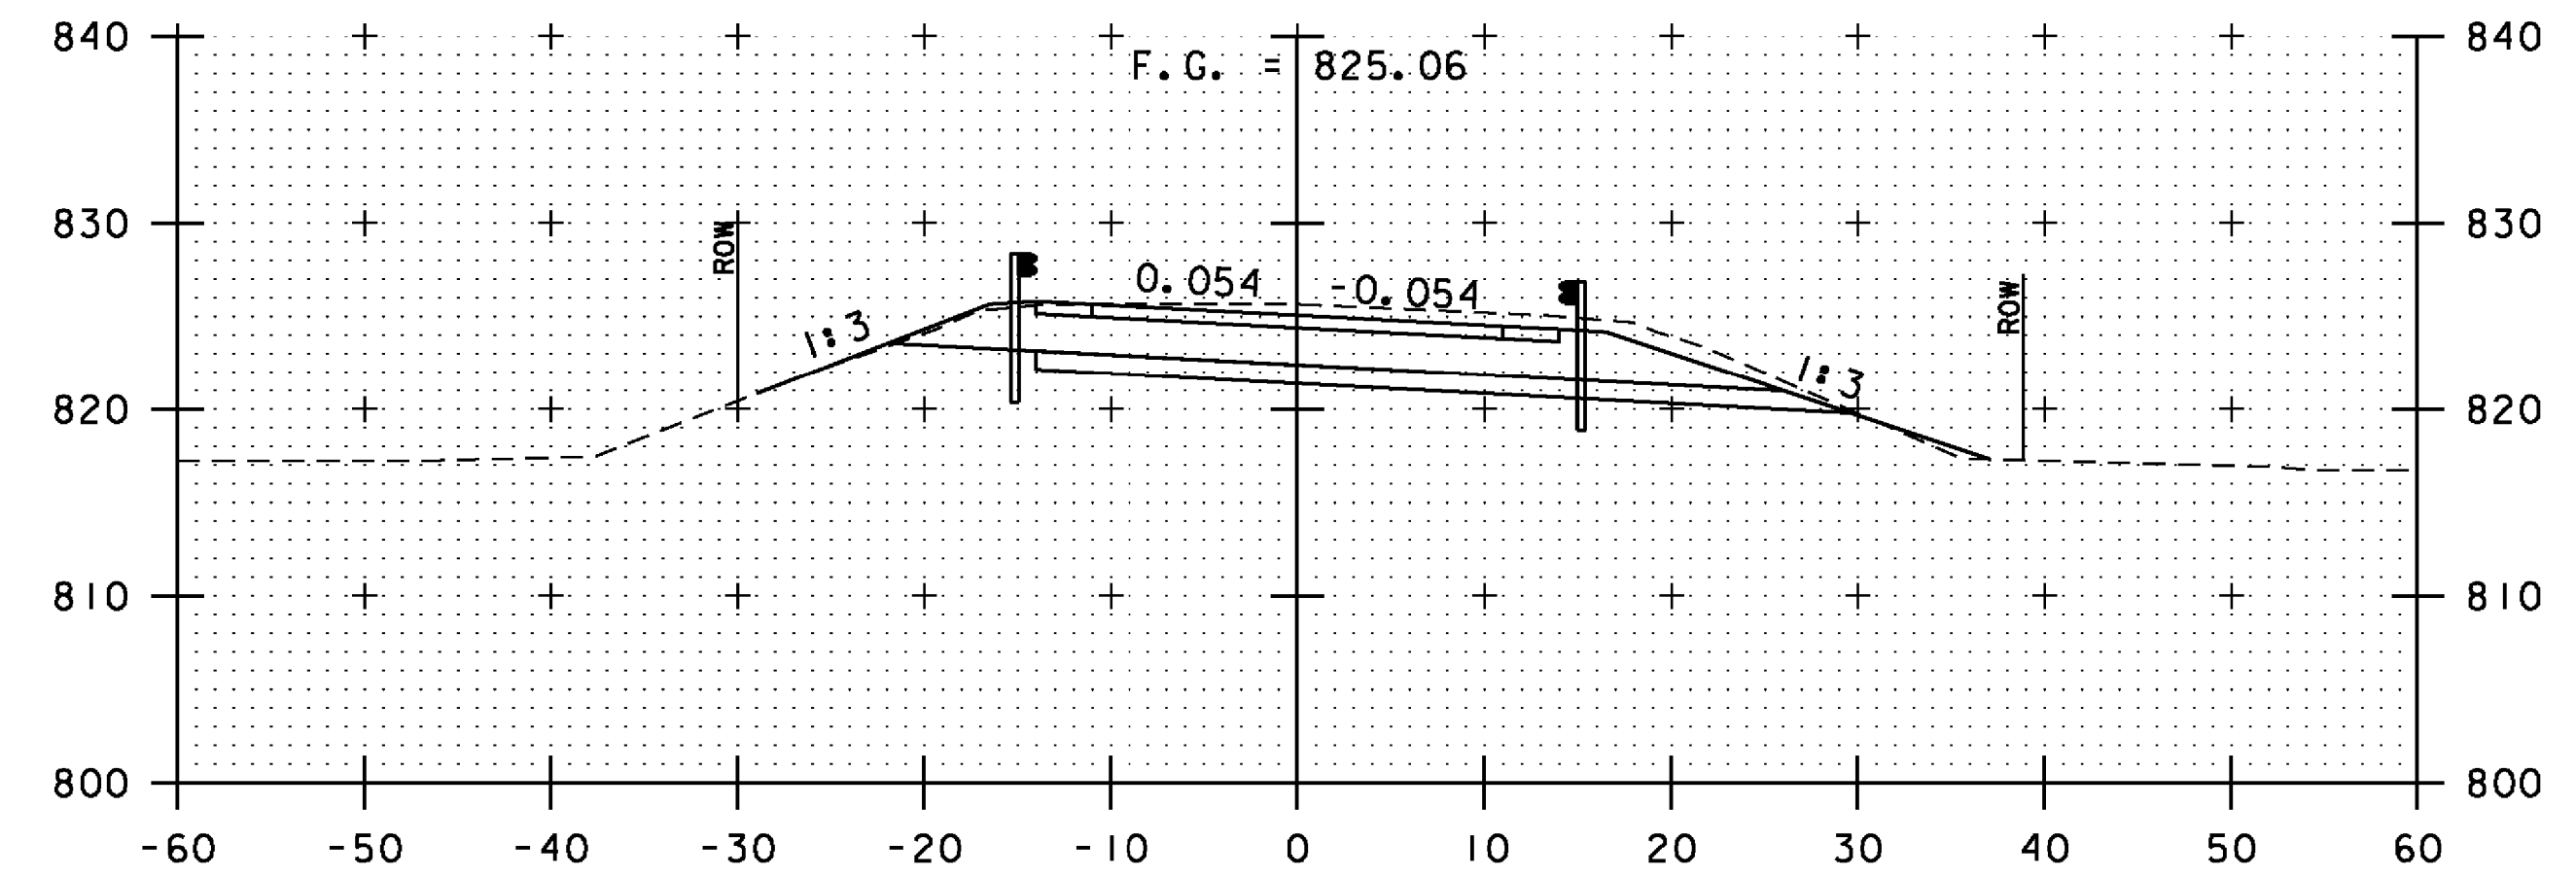

460+50

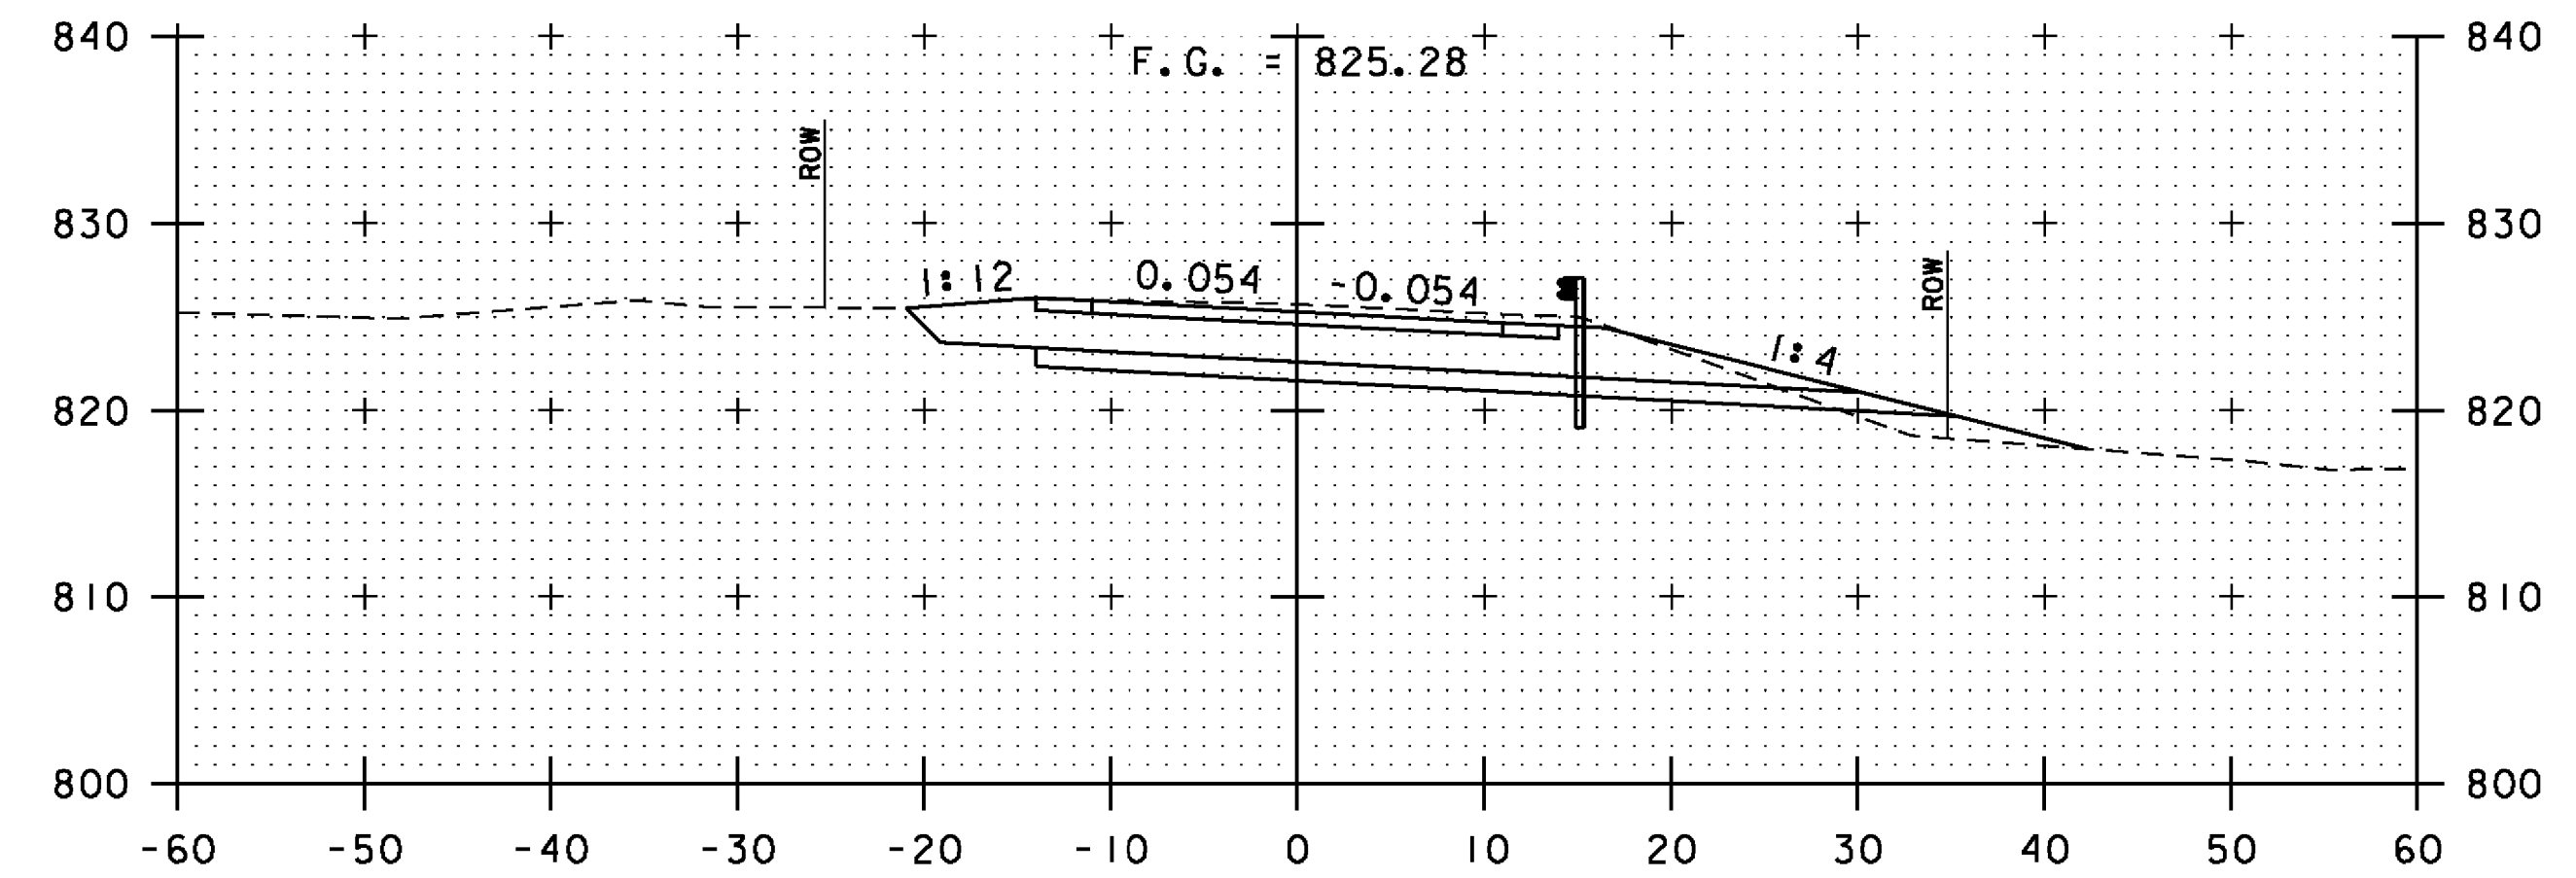

460+00

STA 459+90.00
BEGIN PROJECT

VT 73 CROSS SECTIONS

STA 458+50 TO STA 461+00



PROJECT NAME: ROCHESTER
PROJECT NUMBER: ER BRF 0162(18)

FILE NAME: zllc332xsl.dgn
PROJECT LEADER: S.E. BURBANK
DESIGNED BY: C.L. CILLEY
BR 19 VT 73 CROSS SECTIONS (1 OF 2)

PLOT DATE: 8/19/2013
DRAWN BY: C.L. CILLEY
CHECKED BY: D.M. PECK
SHEET 217 OF 238