




STA 235+50
 BEGIN UNCLASSIFIED CHANNEL EXCAVATION
 GEOTEXTILE UNDER STONE FILL
 STONE FILL, TYPE III
 GRUBBING MATERIAL

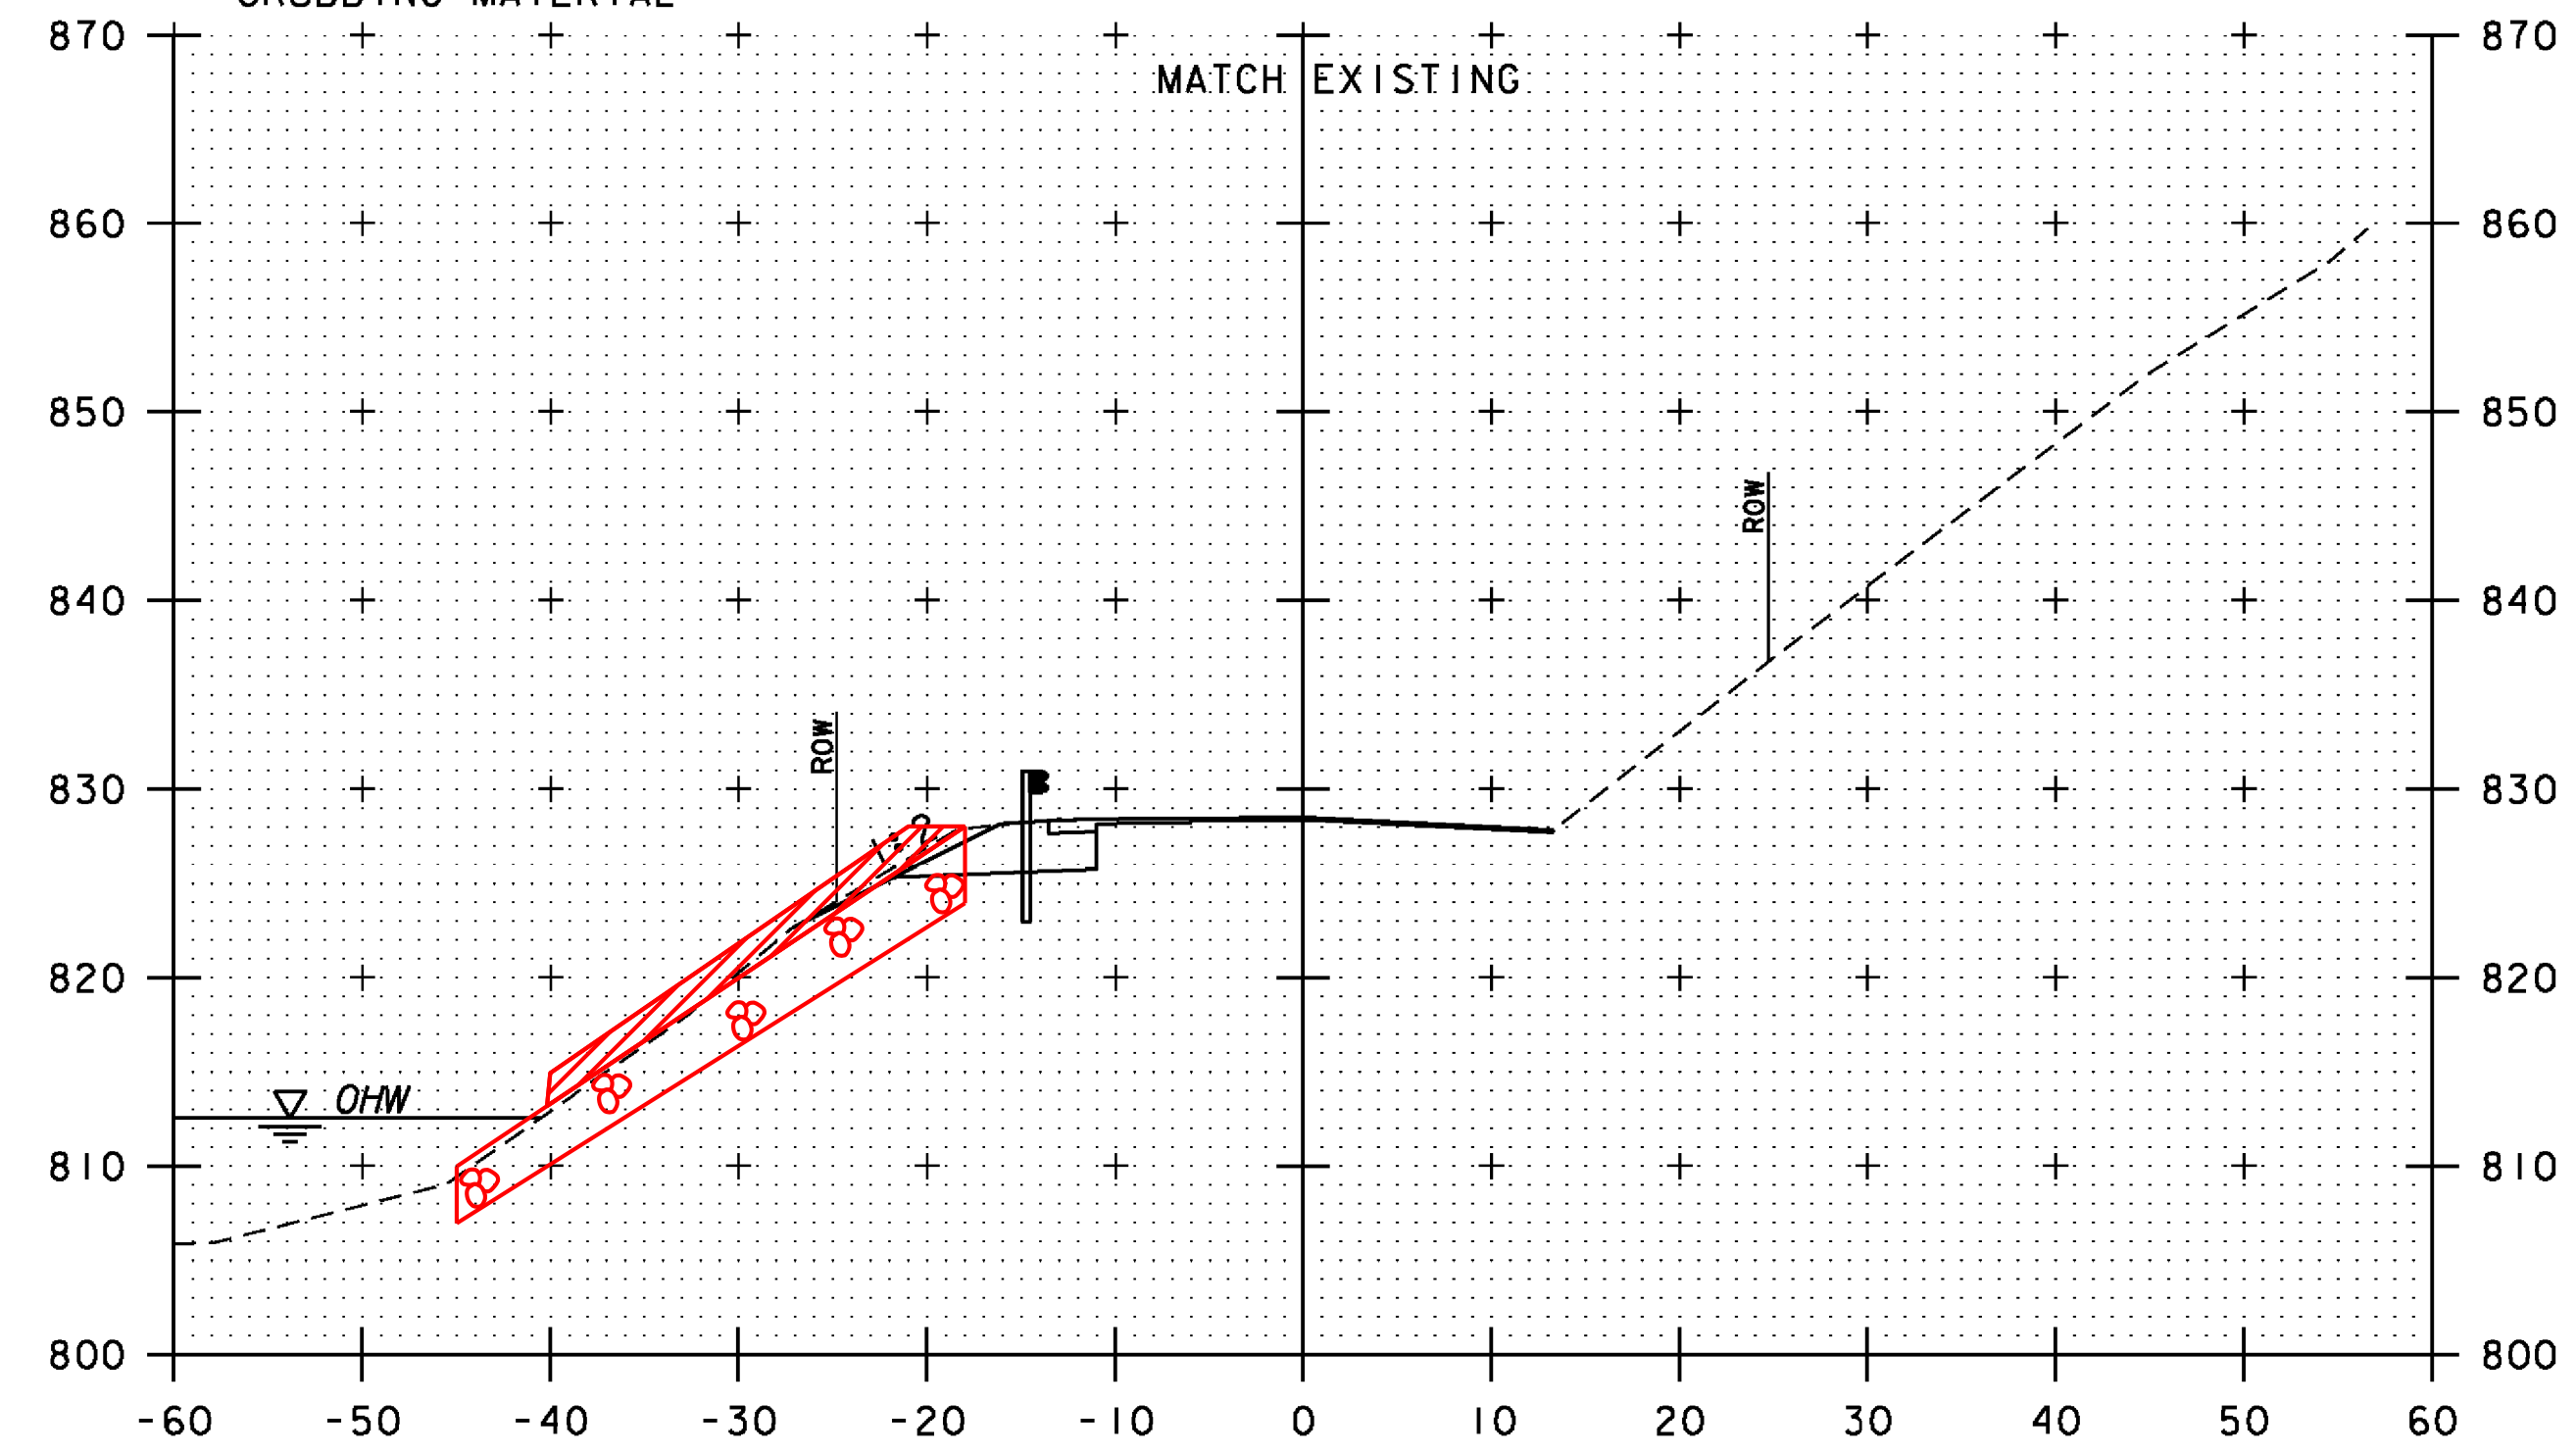


235+25
 BEGIN APPROACH
 STA 235+25

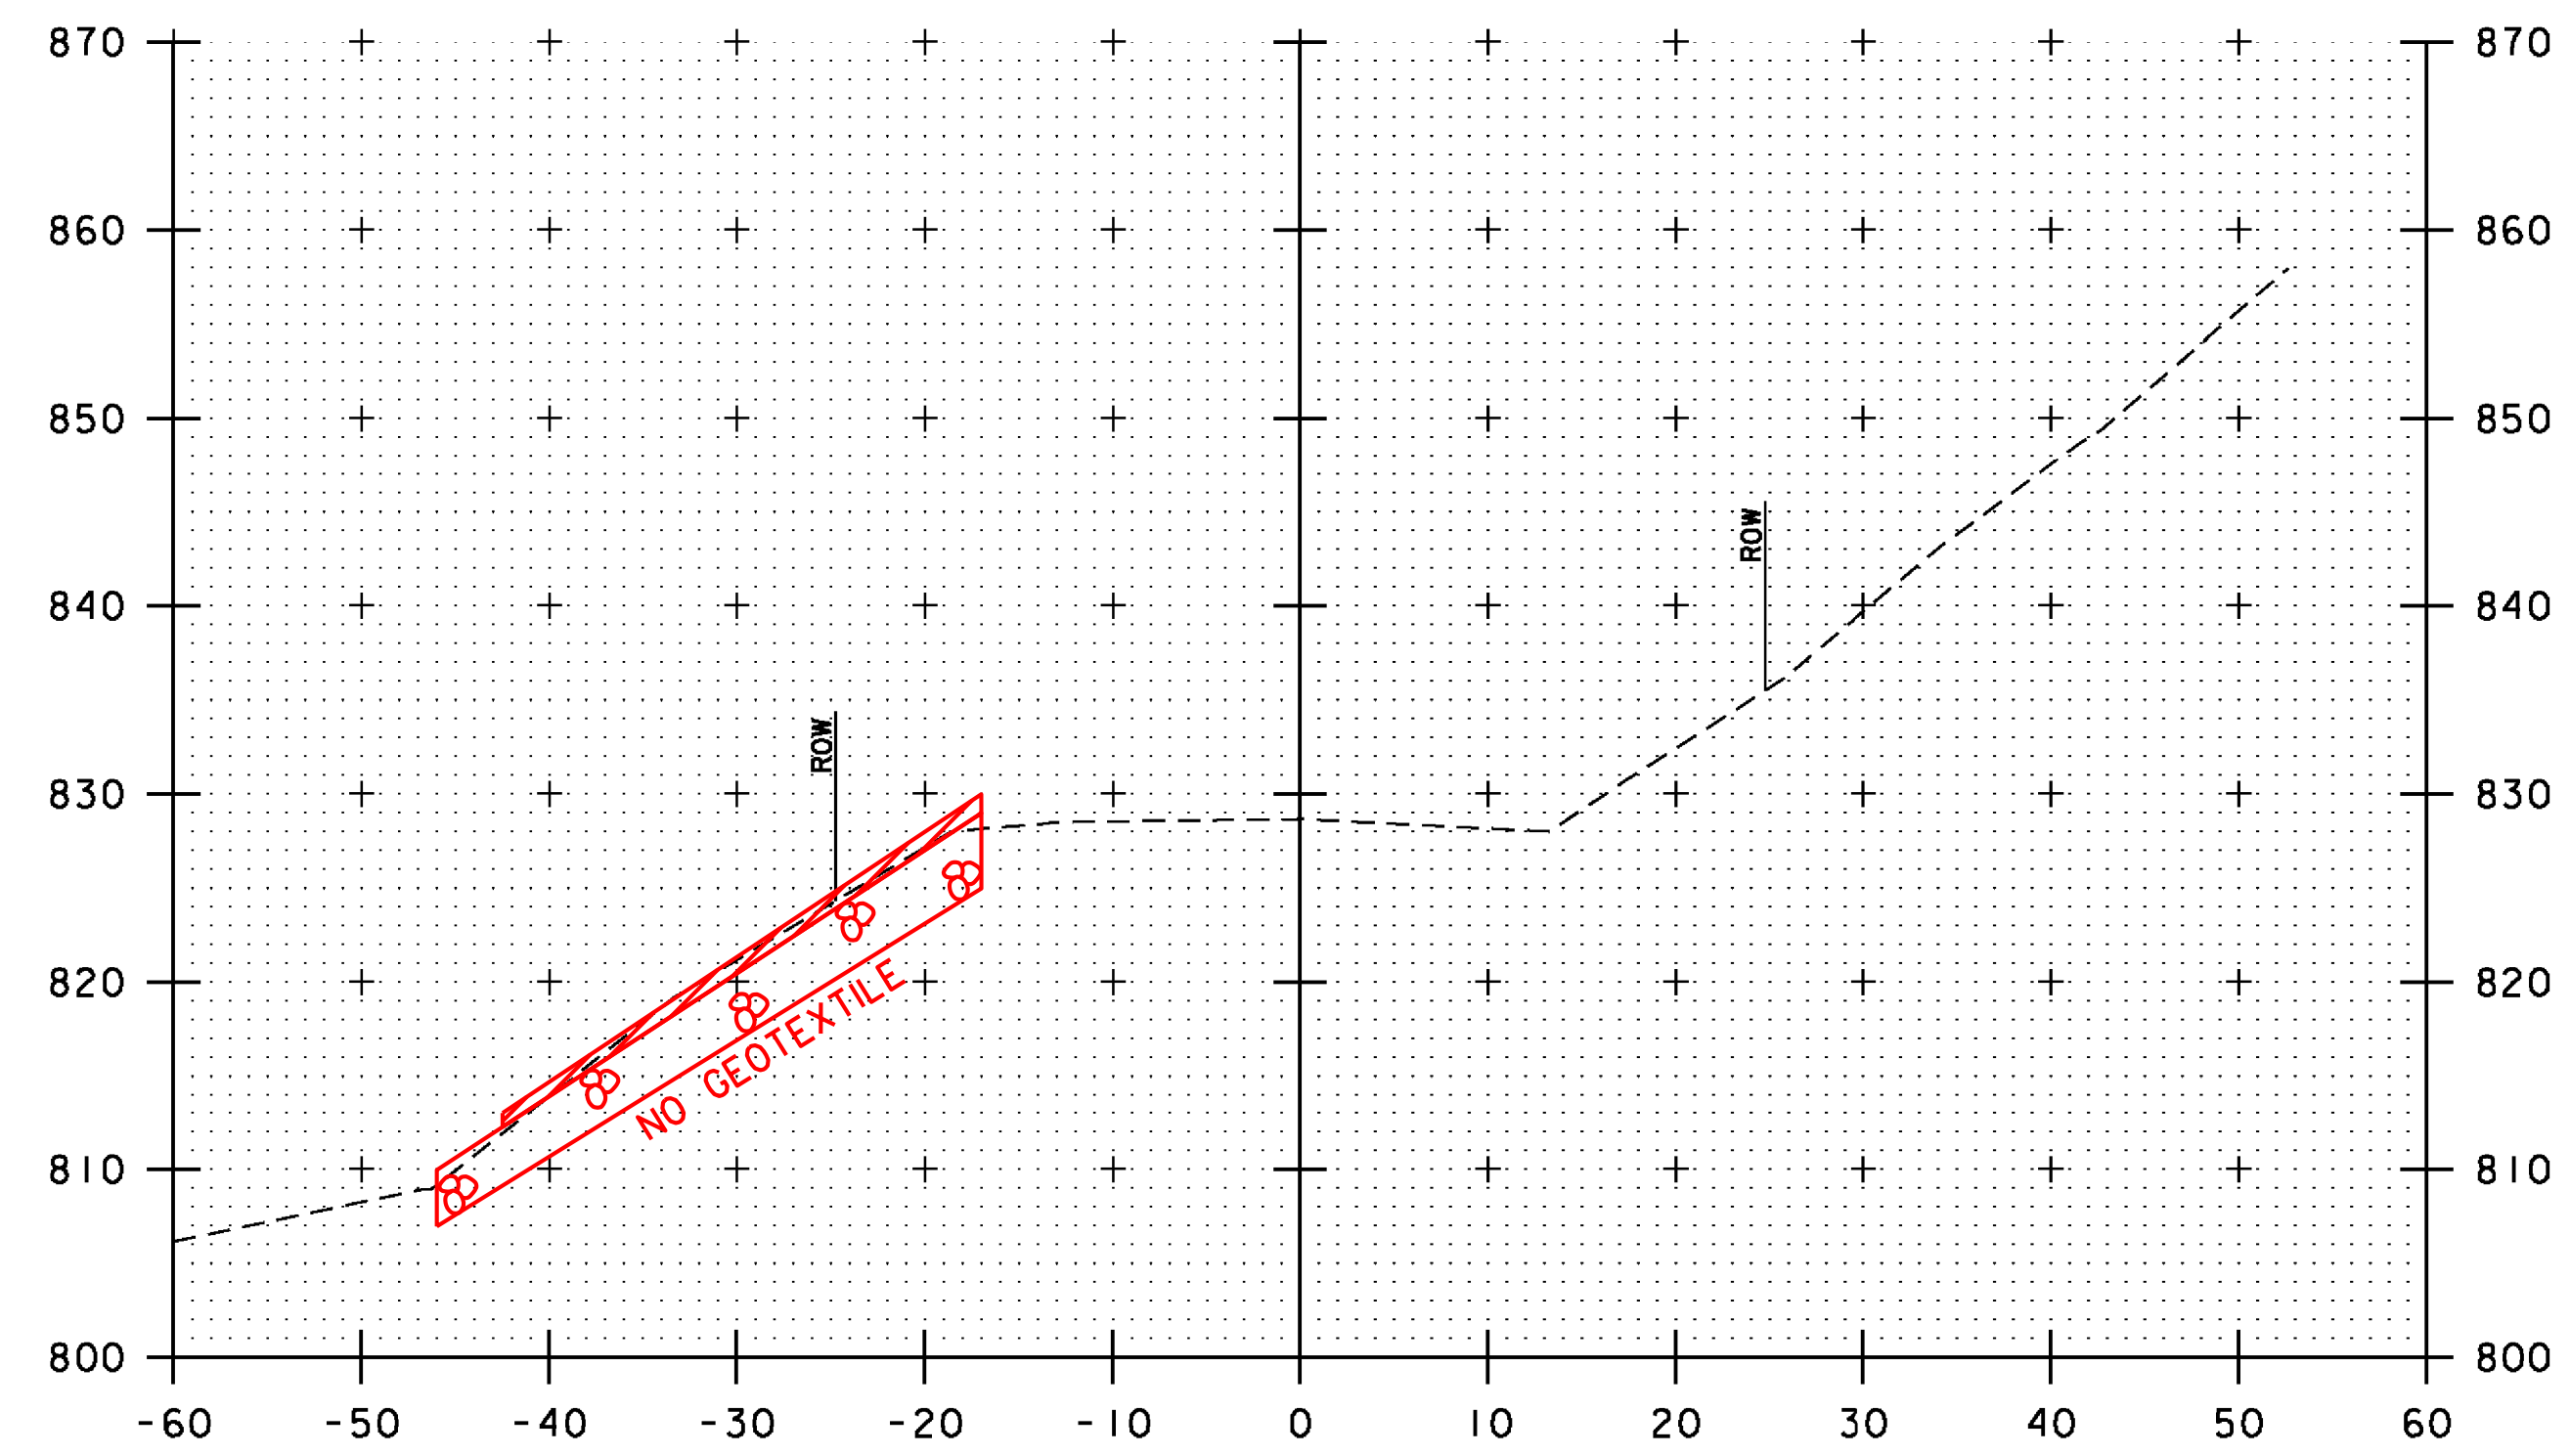

235+00
 BEGIN APPROACH

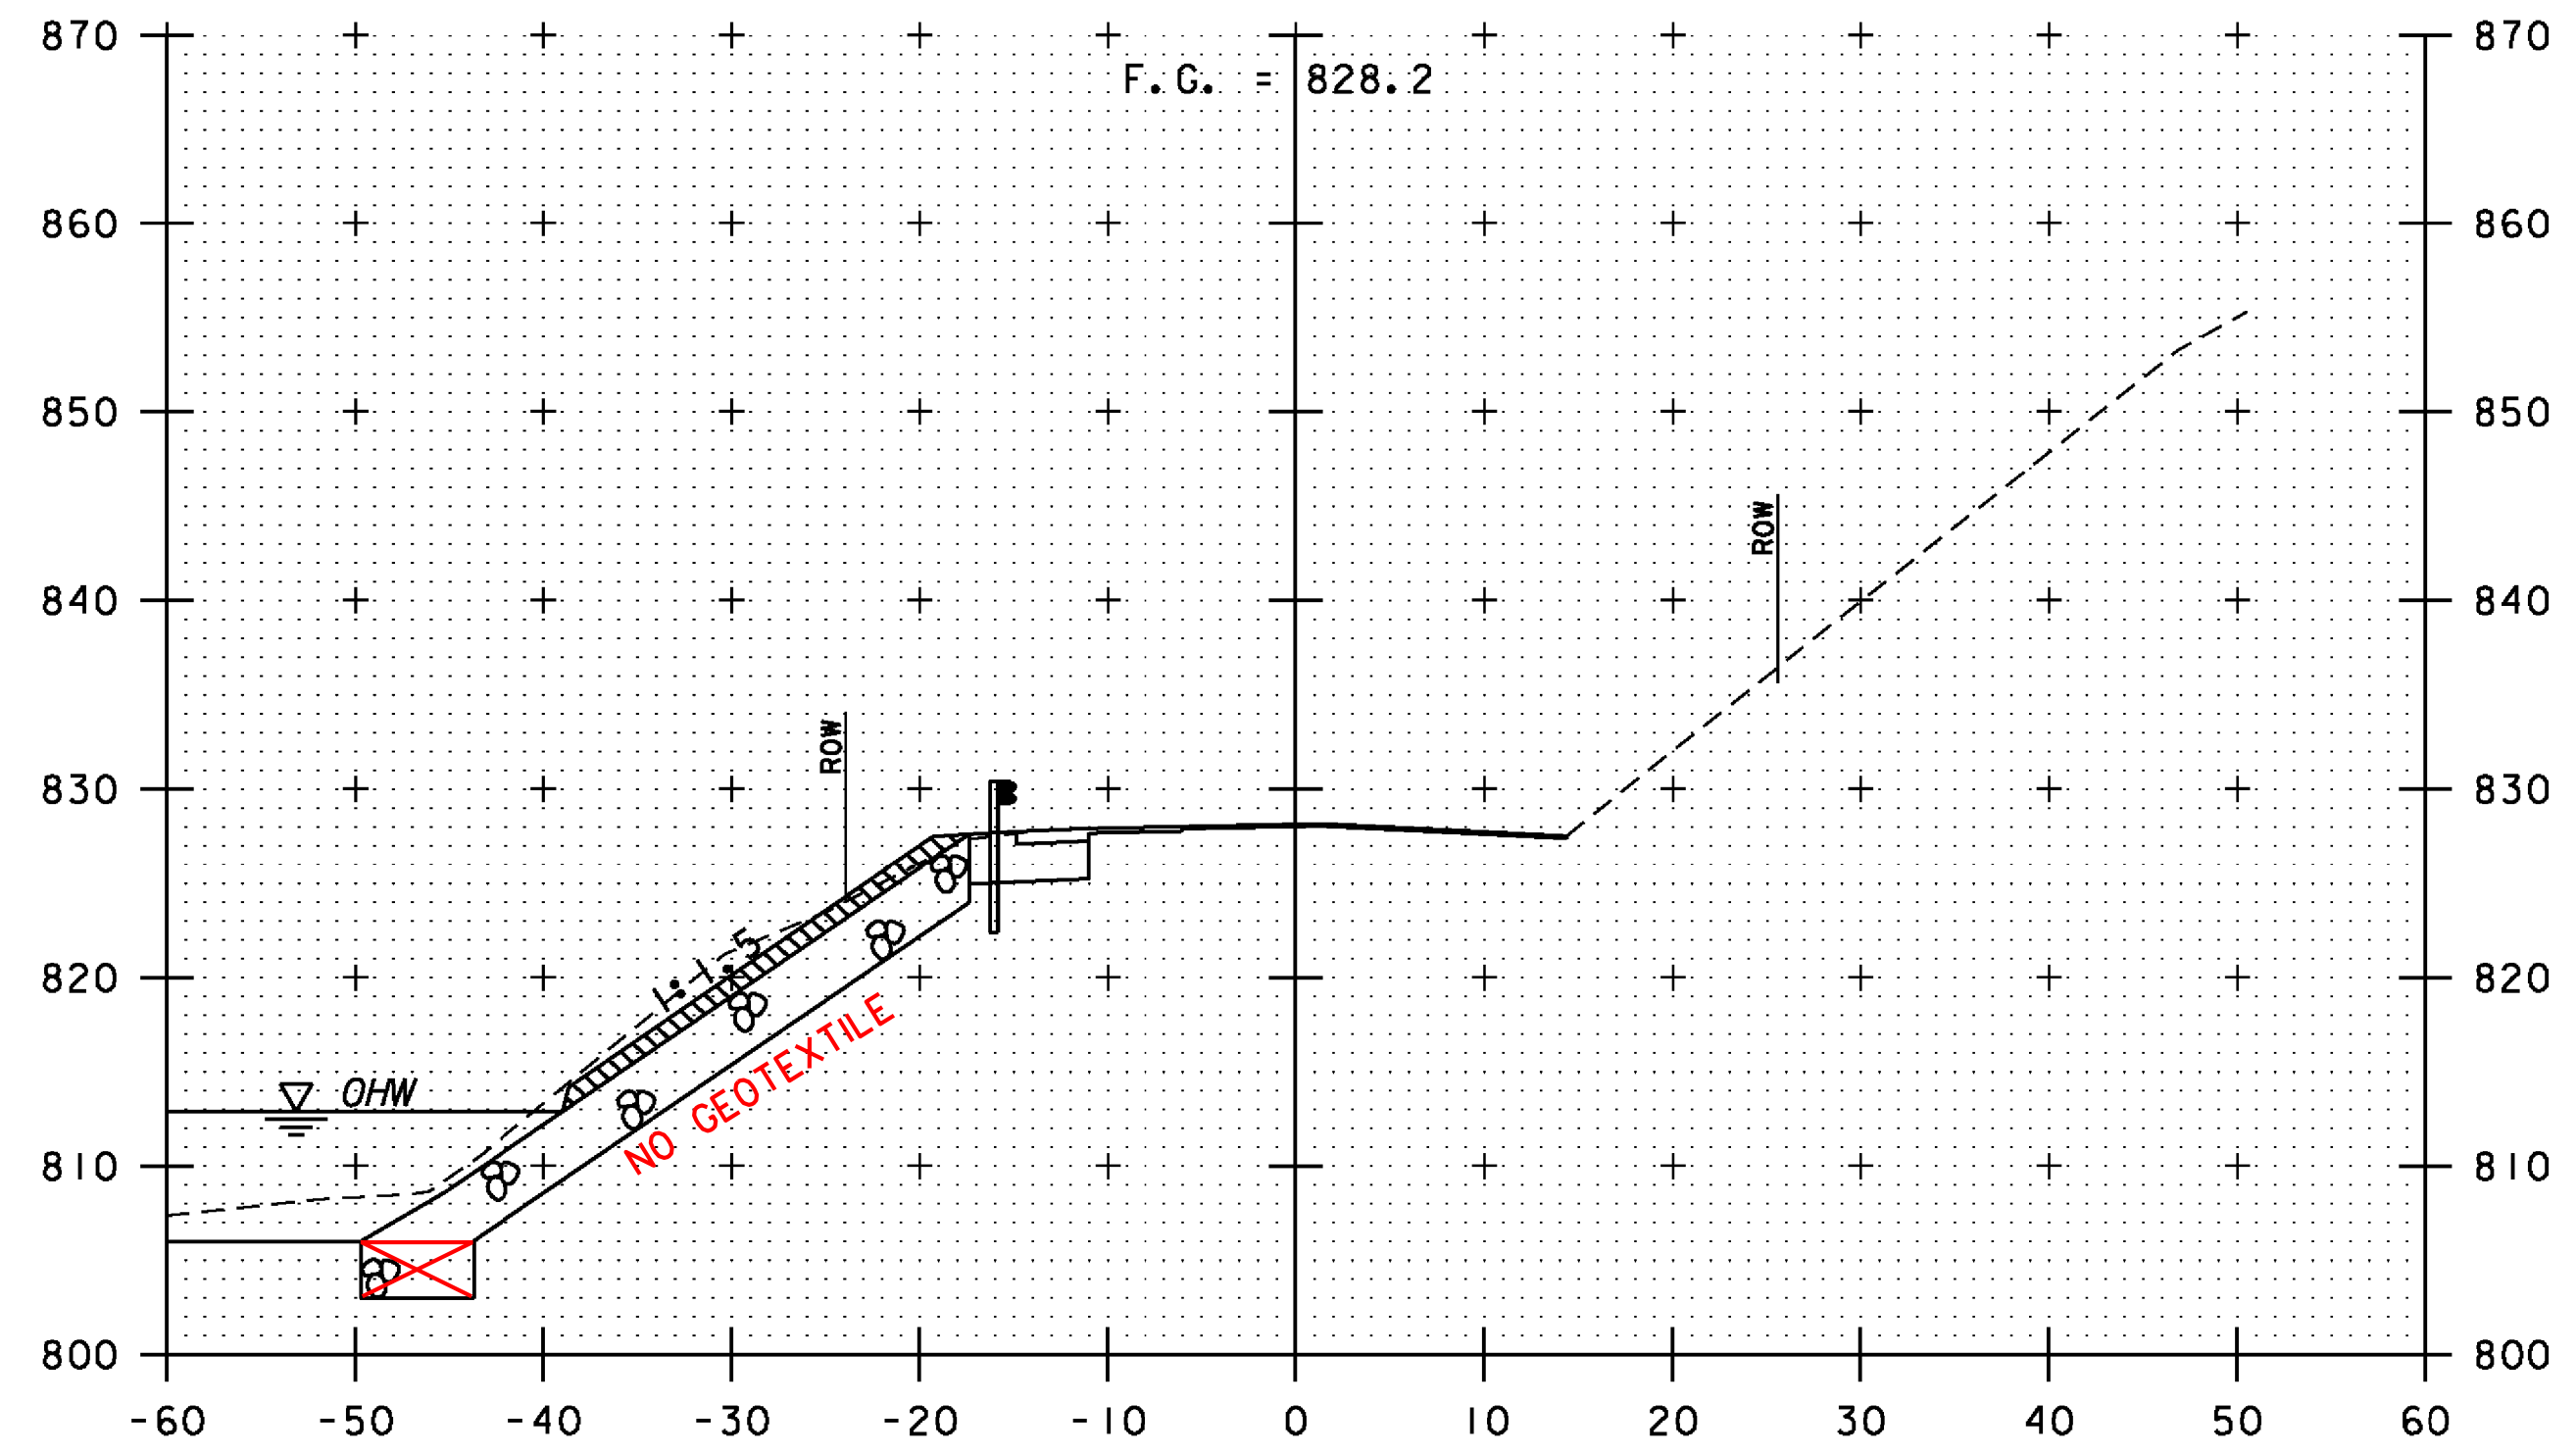

235+75

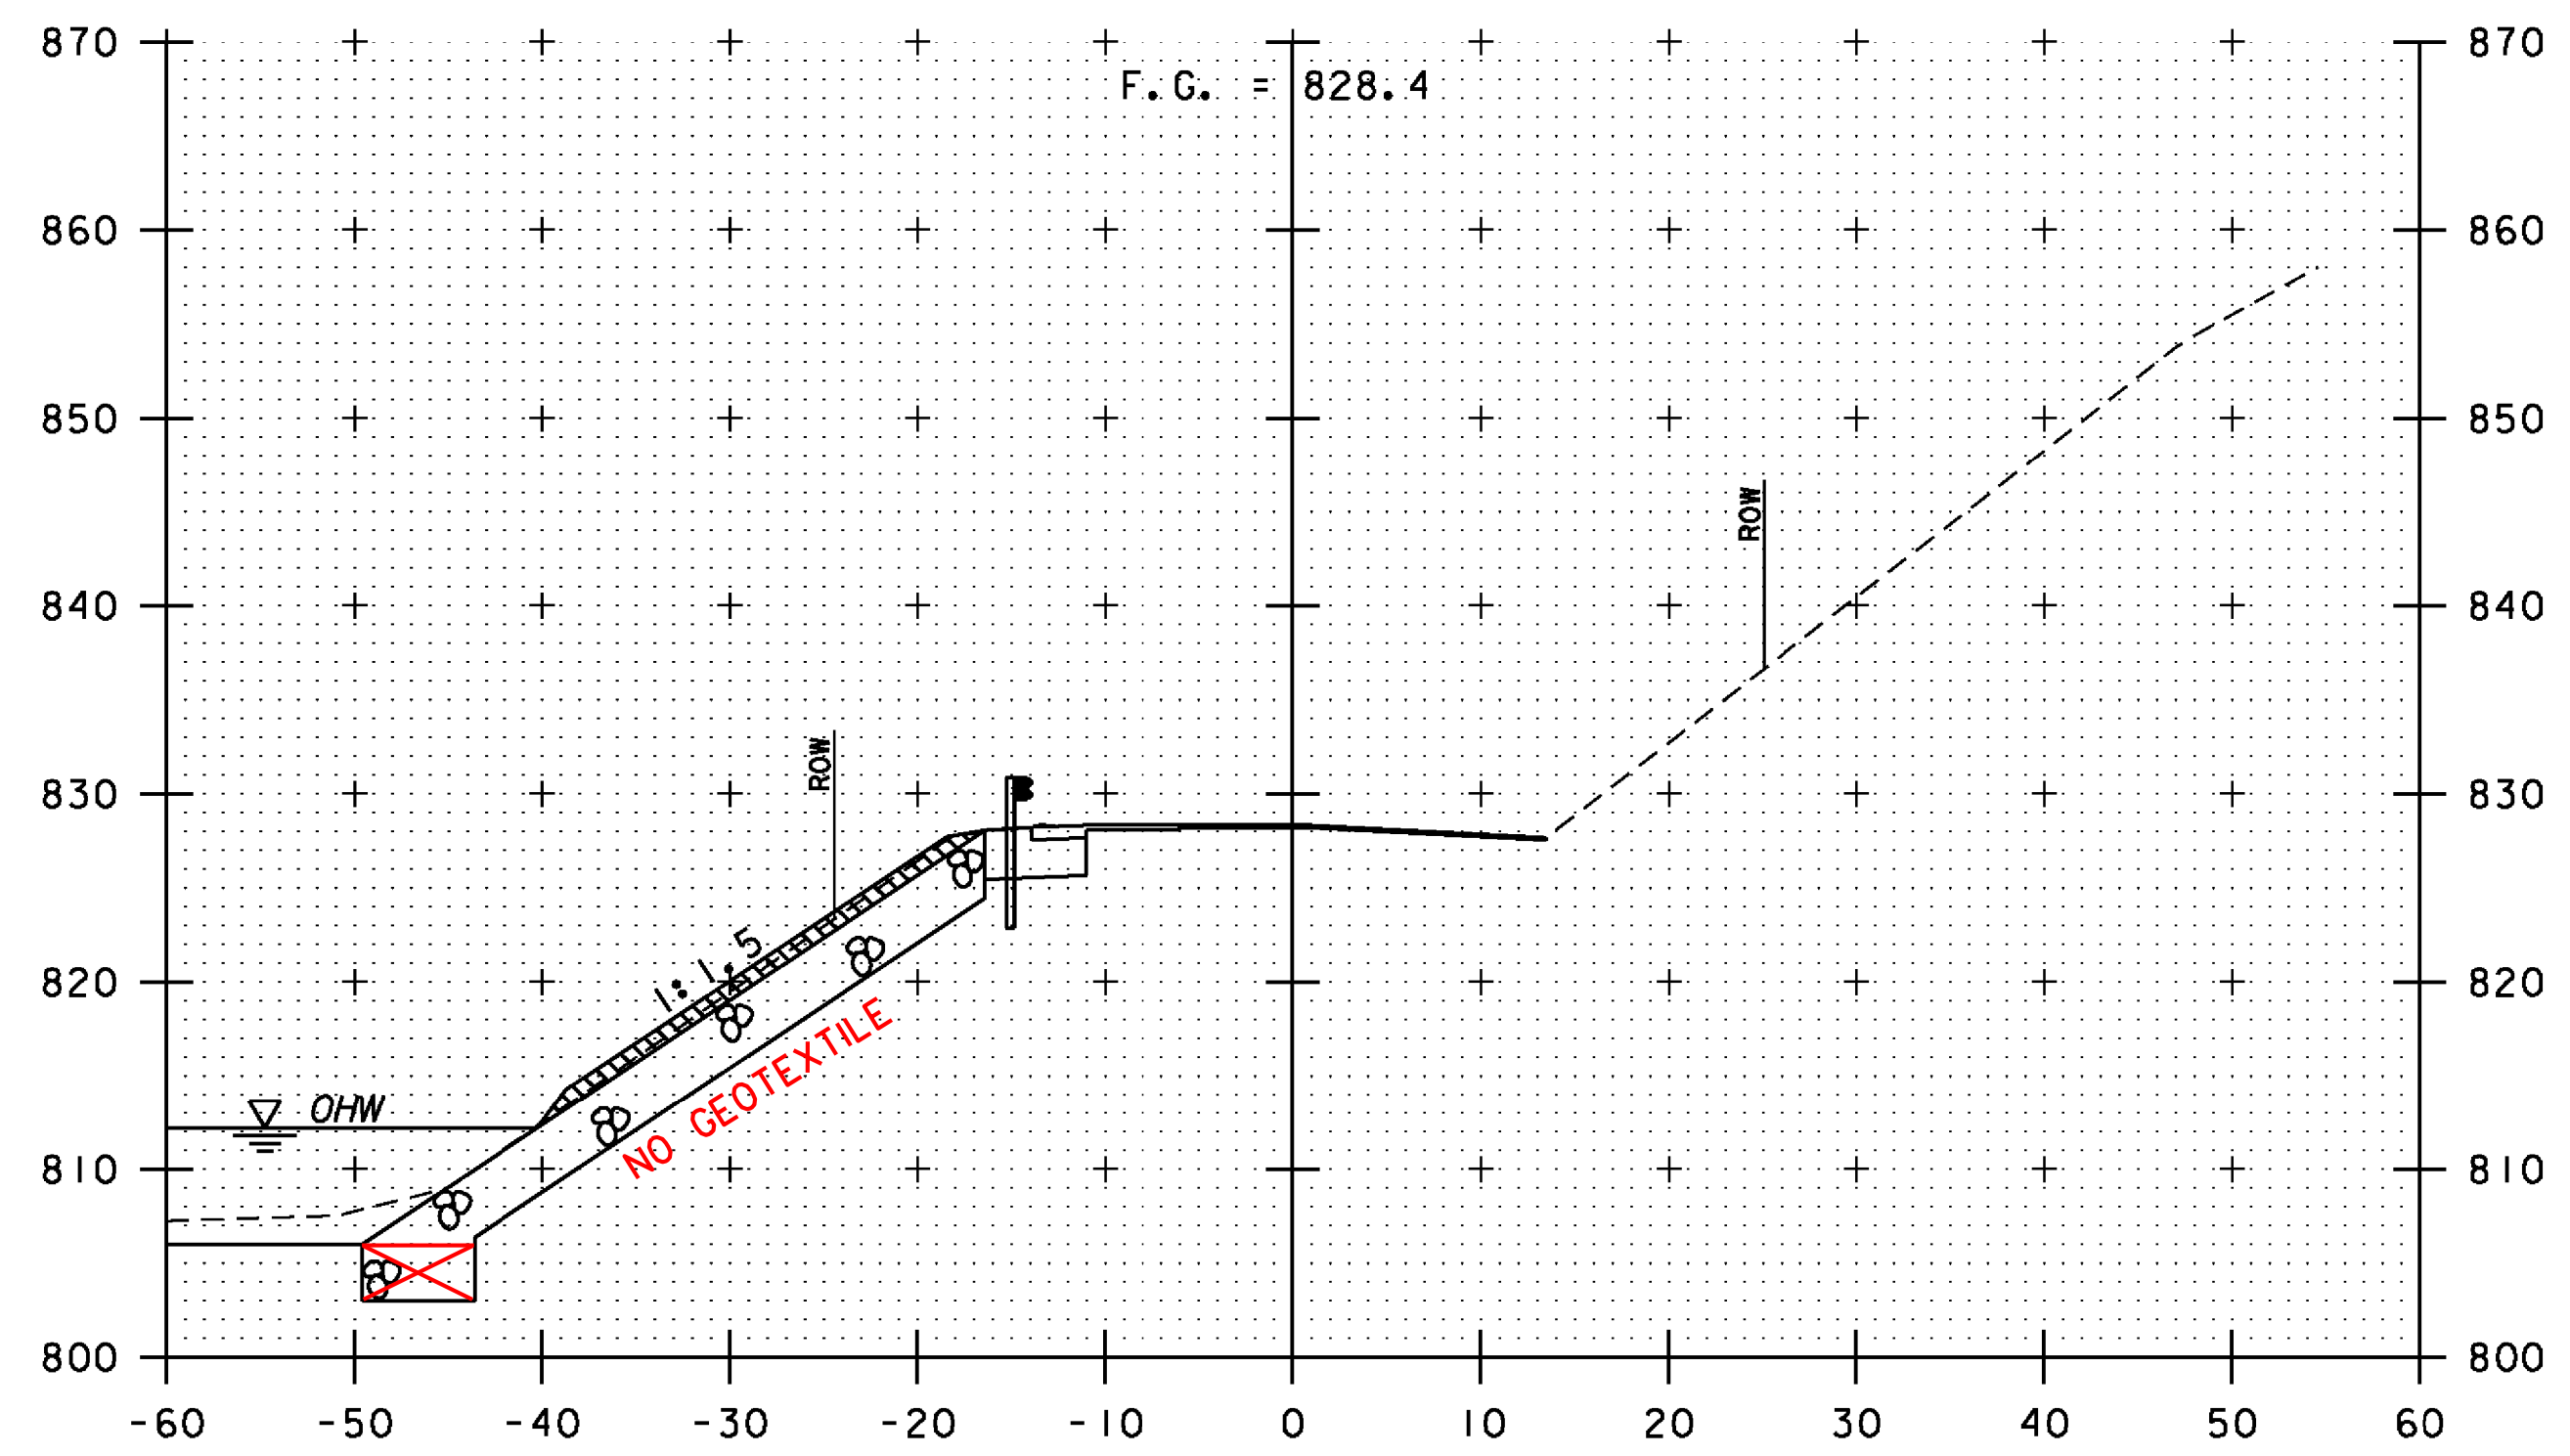

235+50

STA 235+00
 BEGIN UNCLASSIFIED CHANNEL EXCAVATION
 GEOTEXTILE UNDER STONE FILL
 STONE FILL TYPE III
 GRUBBING MATERIAL

VT 100 CROSS SECTIONS
 STA 235+00 TO STA 235+75



PROJECT NAME: ROCHESTER	DRAWN BY: C.L. CILLEY
PROJECT NUMBER: ER BRF 0162(18)	CHECKED BY: D.M. PECK
FILE NAME: zllc332xsl.dgn	SHEET 219 OF 238
DESIGNED BY: C.L. CILLEY	
BR 19 VT 100 CROSS SECTIONS (1 OF 4)	